




1 PLAN: ALIGNMENT B2
SCALE IN FEET

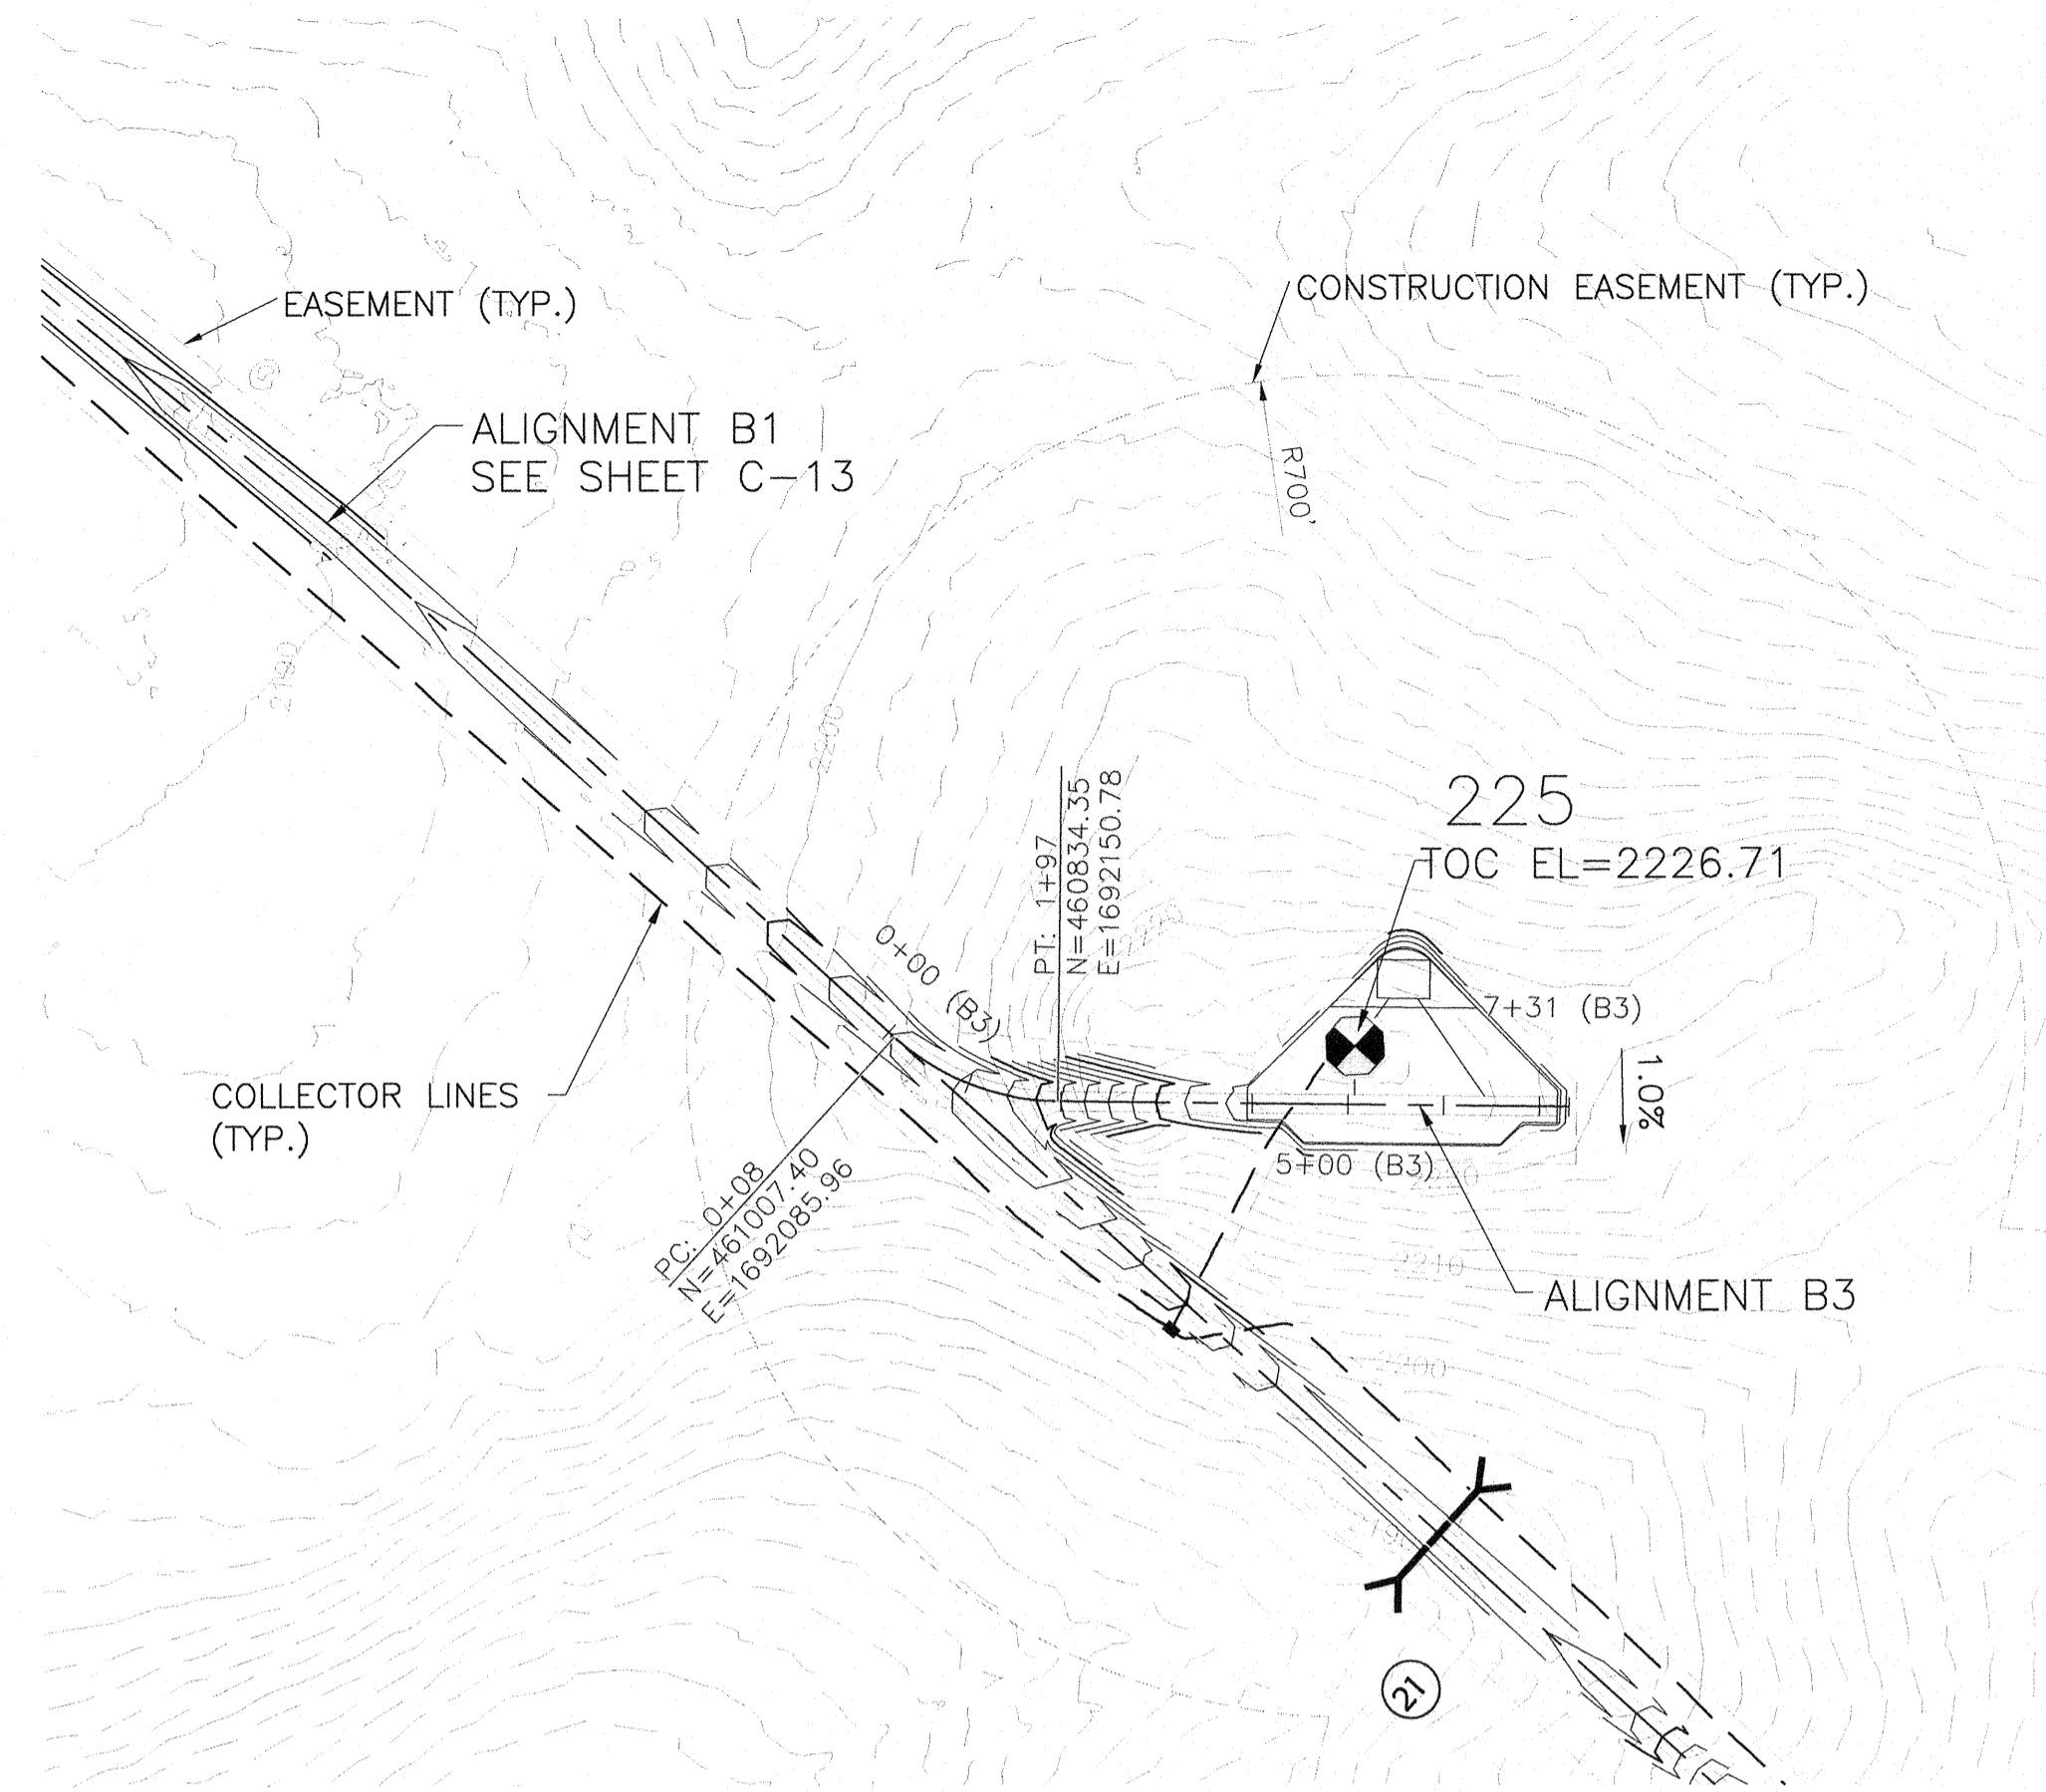

3 PLAN: ALIGNMENT B3
SCALE IN FEET

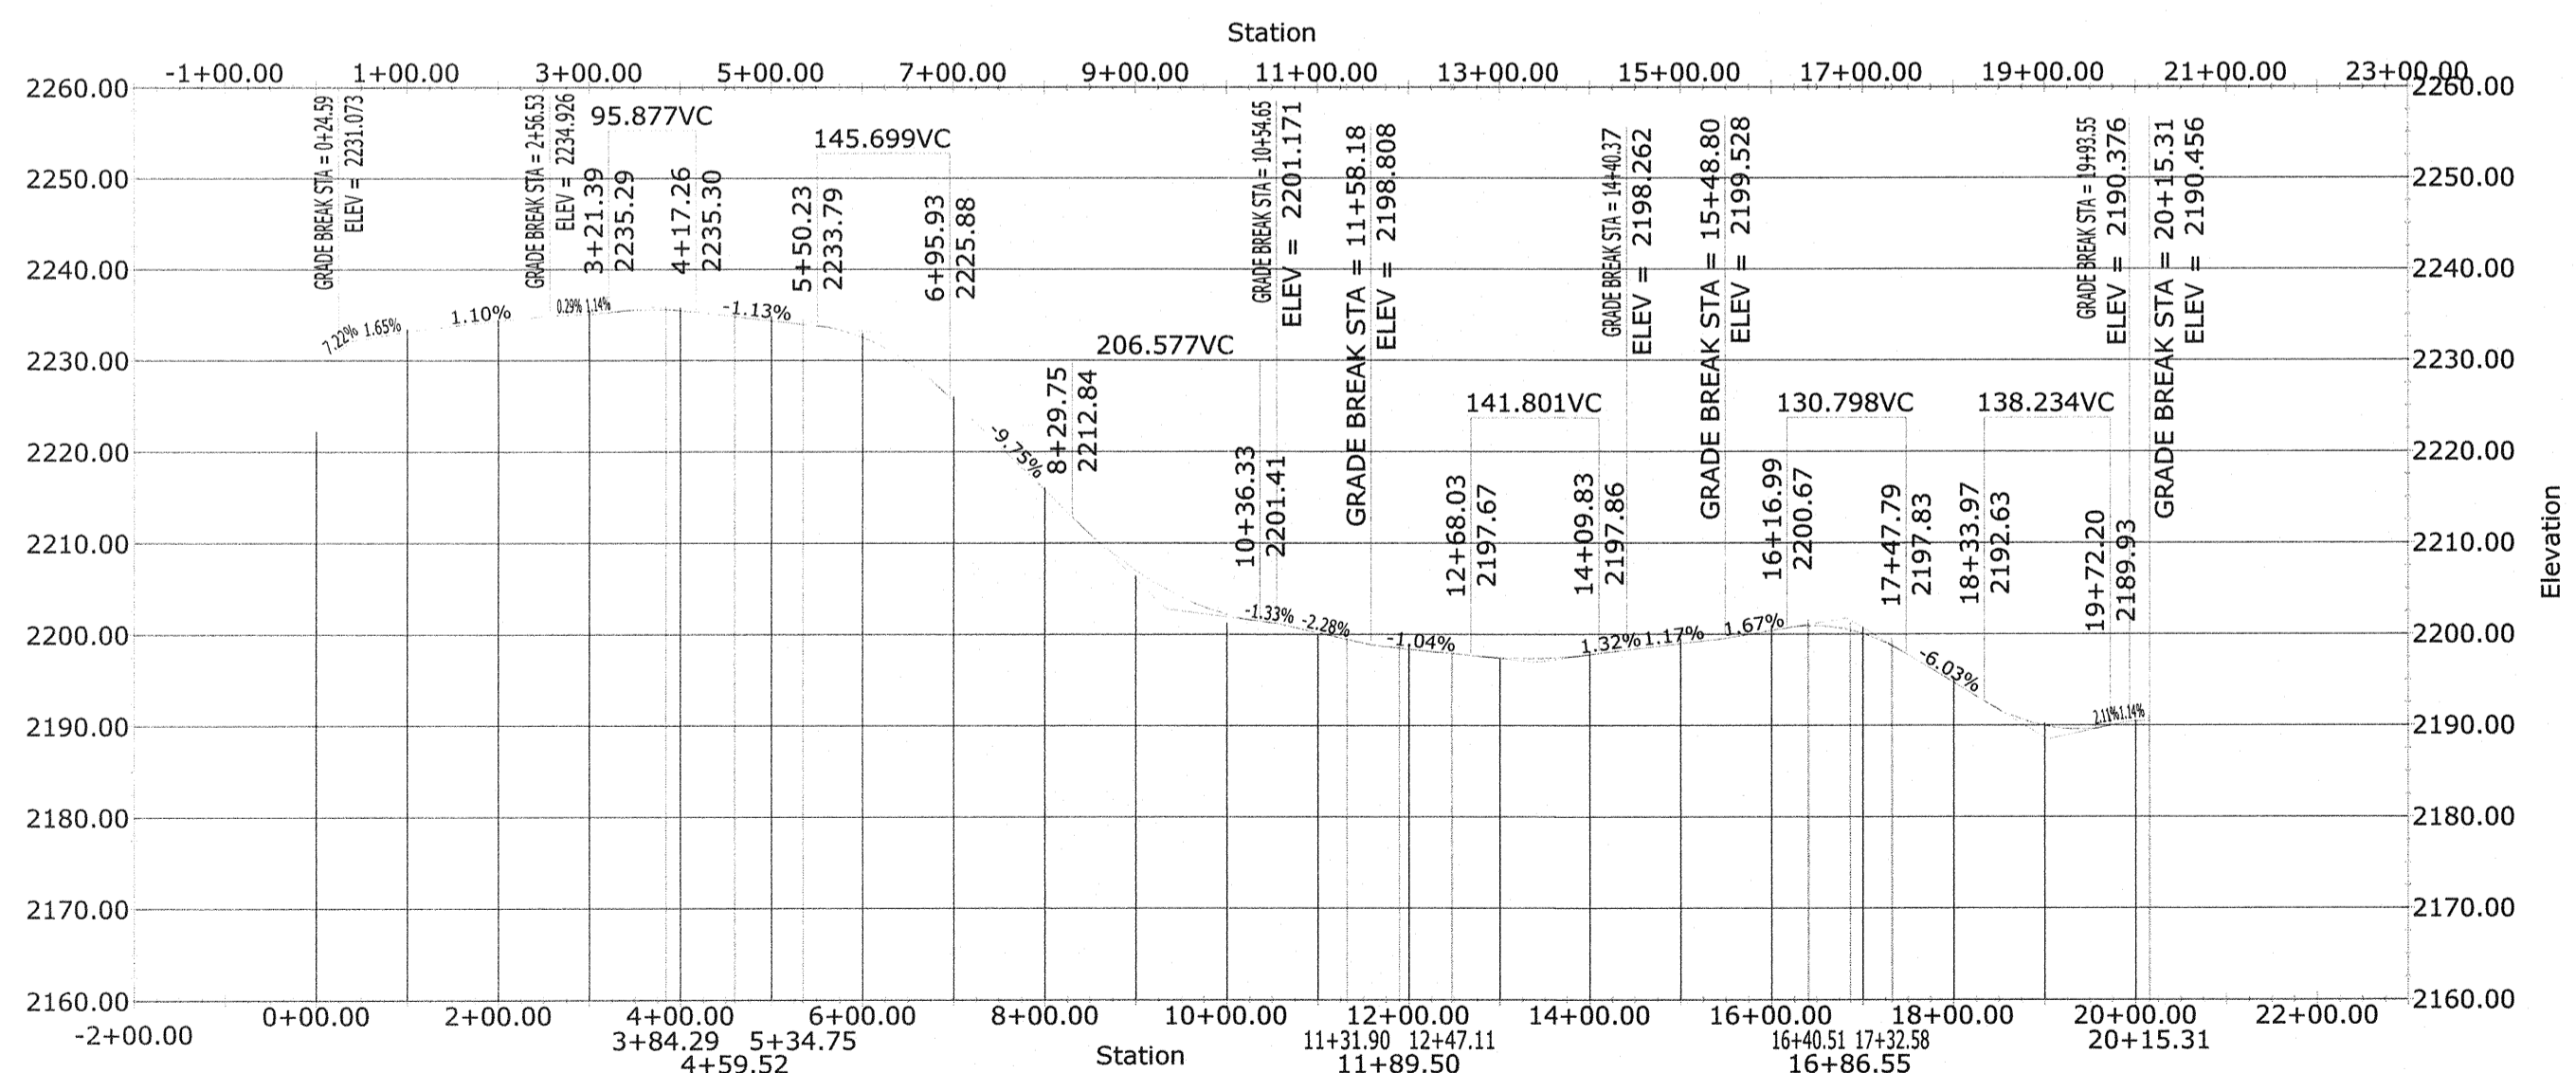


2 PROFILE: ALIGNMENT B2
HORIZONTAL SCALE IN FEET VERTICAL SCALE IN FEET

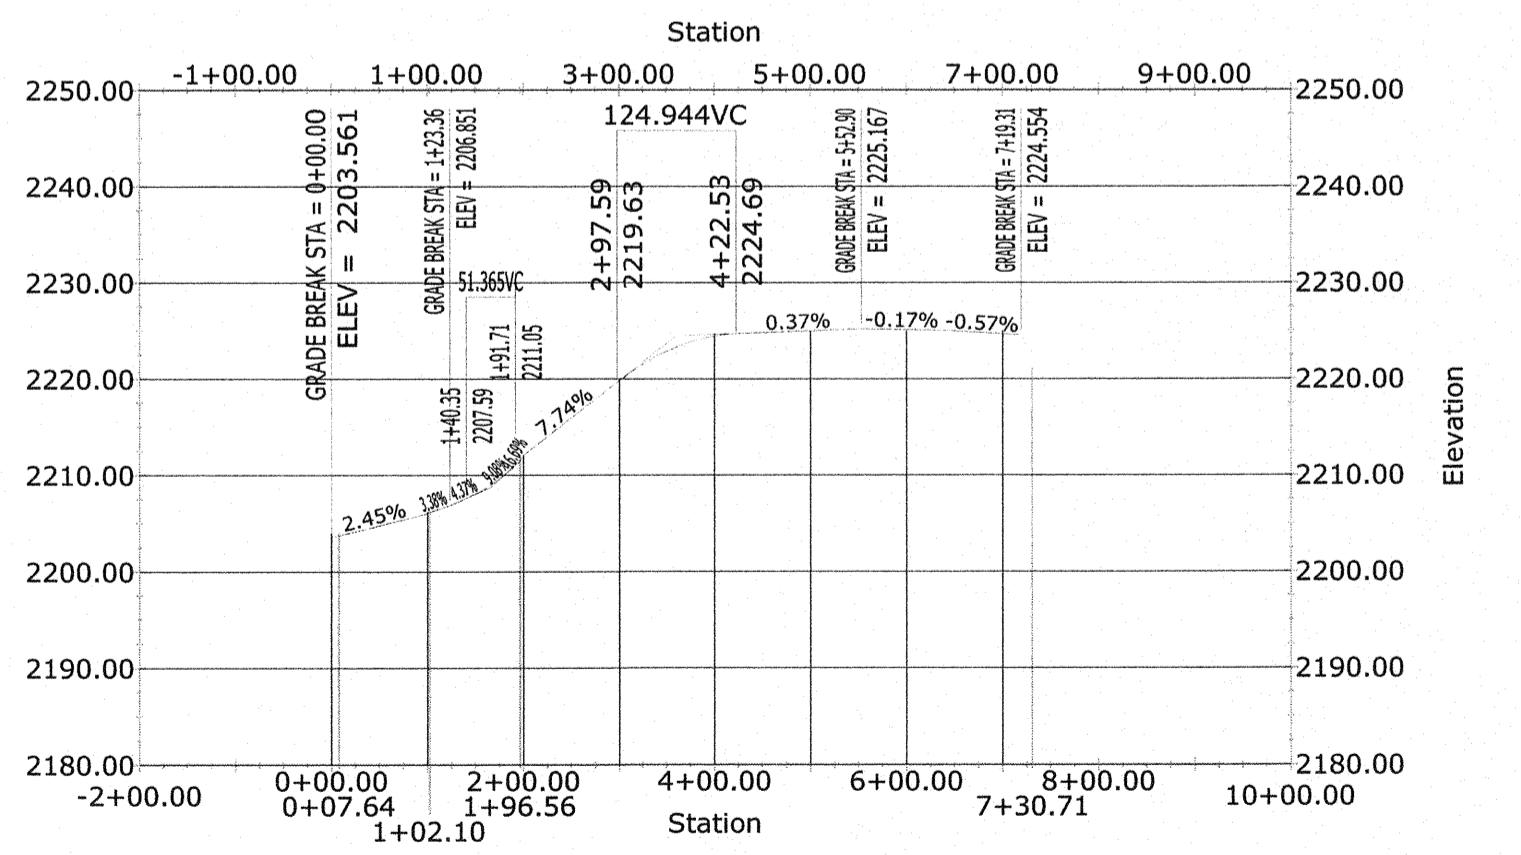

4 PROFILE: ALIGNMENT B3
HORIZONTAL SCALE IN FEET VERTICAL SCALE IN FEET

EXTERNAL REFERENCE:
34331007-BASE-C3D-DESIGN-
ROADS-AS-BUILT.DWG

| | | | | | |
|-----|-----|-----|------|----------|-------------------------|
| A | DMD | CAD | JXB | 05/27/11 | 60 PERCENT SUBMITTAL |
| B | CAD | CAD | JXB | 07/01/11 | 90 PERCENT SUBMITTAL |
| O | DMD | CAD | JXB | 08/12/11 | ISSUED FOR CONSTRUCTION |
| 1 | NJG | | | 2/27/13 | CONSTRUCTION REVISIONS |
| NO. | BY | CHK | APP. | DATE | REVISION DESCRIPTION |

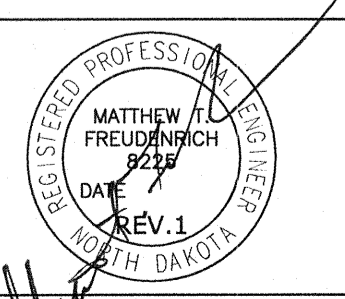

| | | | | | | |
|-----------------|----------|----------|----------|---|---|---|
| CLIENT | 05/27/11 | 07/01/11 | | | | |
| BID | | | | | | |
| CONSTRUCTION | | | 08/12/11 | | | |
| PERMITTING | | | | | | |
| RECORD | | | | | | |
| RELEASED TO/FOR | A | B | C | 0 | 1 | 2 |
| | | | | | | 3 |
| | | | | | | |
| | | | | | | |

Project Office:
BARR ENGINEERING CO.
4700 WEST 77TH STREET
MINNEAPOLIS, MN.
55435-4803

Corporate Headquarters:
Minneapolis, Minnesota
Ph: 1-800-632-2277
Fax: (952) 832-2601
www.barr.com

| | |
|----------|----------|
| Scale | AS SHOWN |
| Date | 05/20/11 |
| Drawn | DMD |
| Checked | JXB |
| Designed | CAD |
| Approved | JXB |



BISON 2 WIND PROJECT
MORTON & OLIVER COUNTIES, NORTH DAKOTA

PLAN AND PROFILE-ALIGNMENTS B2 STA.
0+00 TO 20+15 & B3 STA. 0+00 TO 7+31

| | |
|--------------------|------------|
| BARR PROJECT No. | 34/33-1007 |
| CLIENT PROJECT No. | |
| DWG. No. | C-14 |
| REV. No. | 1 |