




***NOTES**

- ALL CRANE PATHS REMOVED AND RESTORED TO ORIGINAL CONDITION AFTER CONSTRUCTION.
- CRANE PATH INFORMATION REMOVED. BOTTOM OF PAGE LEFT INTENTIONALLY BLANK.

0 200 400 0 20 40
 HORIZONTAL SCALE IN FEET VERTICAL SCALE IN FEET

EXTERNAL REFERENCE:
 34331007-BASE-C3D-DESIGN-
 ROADS-AS-BUILT.DWG

NO.	BY	CHK.	APP.	DATE	REVISION DESCRIPTION
A	DMD	CAD	JXB	05/27/11	60 PERCENT SUBMITTAL
B	CAD	CAD	JXB	07/01/11	90 PERCENT SUBMITTAL
0	DMD	CAD	JXB	05/12/11	ISSUED FOR CONSTRUCTION
1	NJG			2/5/13	CONSTRUCTION REVISIONS

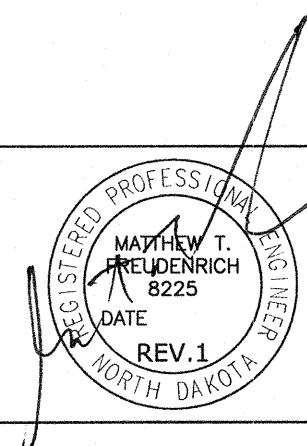


CLIENT	BID	CONSTRUCTION	PERMITTING	RECORD
05/27/11	07/01/11		08/12/11	



Project Office:
BARR ENGINEERING CO.
 4700 WEST 77TH STREET
 MINNEAPOLIS, MN.
 55435-4803
 Corporate Headquarters:
 Minneapolis, Minnesota
 Ph: 1-800-632-2277
 Fax: (952) 832-2601
 www.barr.com

Scale	Date
AS SHOWN	05/20/11
Drawn	DMD
Checked	JXB
Designed	CAD
Approved	JXB

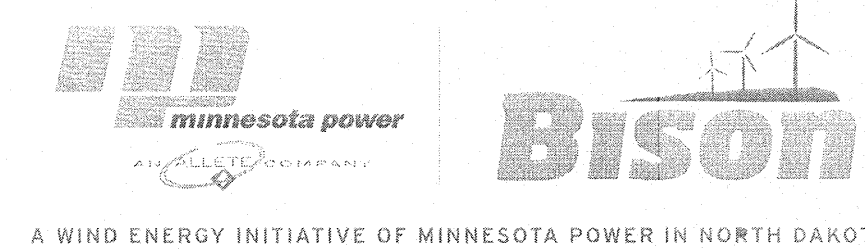

BISON 2 WIND PROJECT
 MORTON & OLIVER COUNTIES, NORTH DAKOTA
 PLAN AND PROFILE
 CRANE PATH FROM ALIGNMENT C TO F

BARR PROJECT No.	REV. No.
34/33-1007	1
DWG. No.	REV. No.
C-17	1