



**\*NOTES**

- ALL CRANE PATHS REMOVED AND RESTORED TO ORIGINAL CONDITION AFTER CONSTRUCTION.
- CRANE PATH INFORMATION REMOVED. BOTTOM OF PAGE LEFT INTENTIONALLY BLANK.

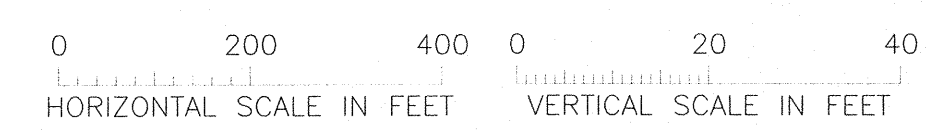

EXTERNAL REFERENCE:  
34331007-BASE-C3D-DESIGN-ROADS-AS-BUILT.DWG


NO.	BY	CHK.	APP.	DATE	REVISION DESCRIPTION
A	DMD	CAD	JXB	05/27/11	60 PERCENT SUBMITTAL
B	CAD	CAD	JXB	07/01/11	90 PERCENT SUBMITTAL
0	DMD	CAD	JXB	08/12/11	ISSUED FOR CONSTRUCTION
1	NJG			2/5/13	CONSTRUCTION REVISIONS

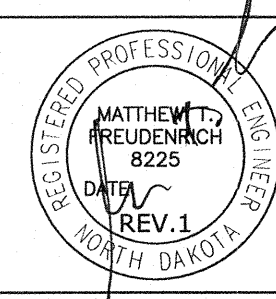

RELEASED TO/FOR	A	B	C	0	1	2	3

**BARR**  
Project Office:  
BARR ENGINEERING CO.  
4700 WEST 77TH STREET  
MINNEAPOLIS, MN.  
55435-4803  
Corporate Headquarters:  
Minneapolis, Minnesota  
Ph: 1-800-632-2277  
www.barr.com

Scale	AS SHOWN
Date	05/20/11
Drawn	DMD
Checked	JXB
Designed	CAD
Approved	JXB

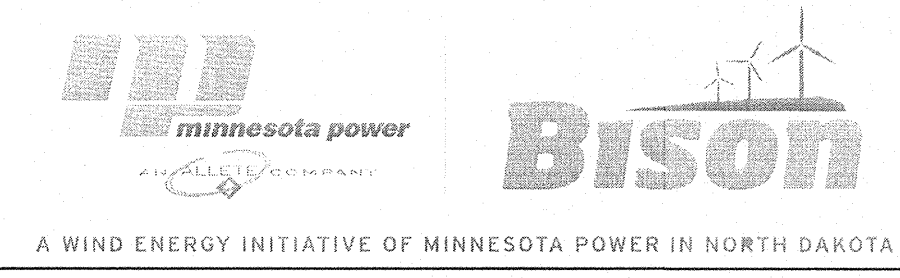

BISON 2 WIND PROJECT  
MORTON & OLIVER COUNTIES, NORTH DAKOTA  
PLAN AND PROFILE  
CRANE PATH FROM ALIGNMENT C TO F

BARR PROJECT No.	
34/33-1007	
CLIENT PROJECT No.	
DWG. No.	REV. No.
C-18	1