



1 PLAN: ALIGNMENTS F AND G
SCALE IN FEET

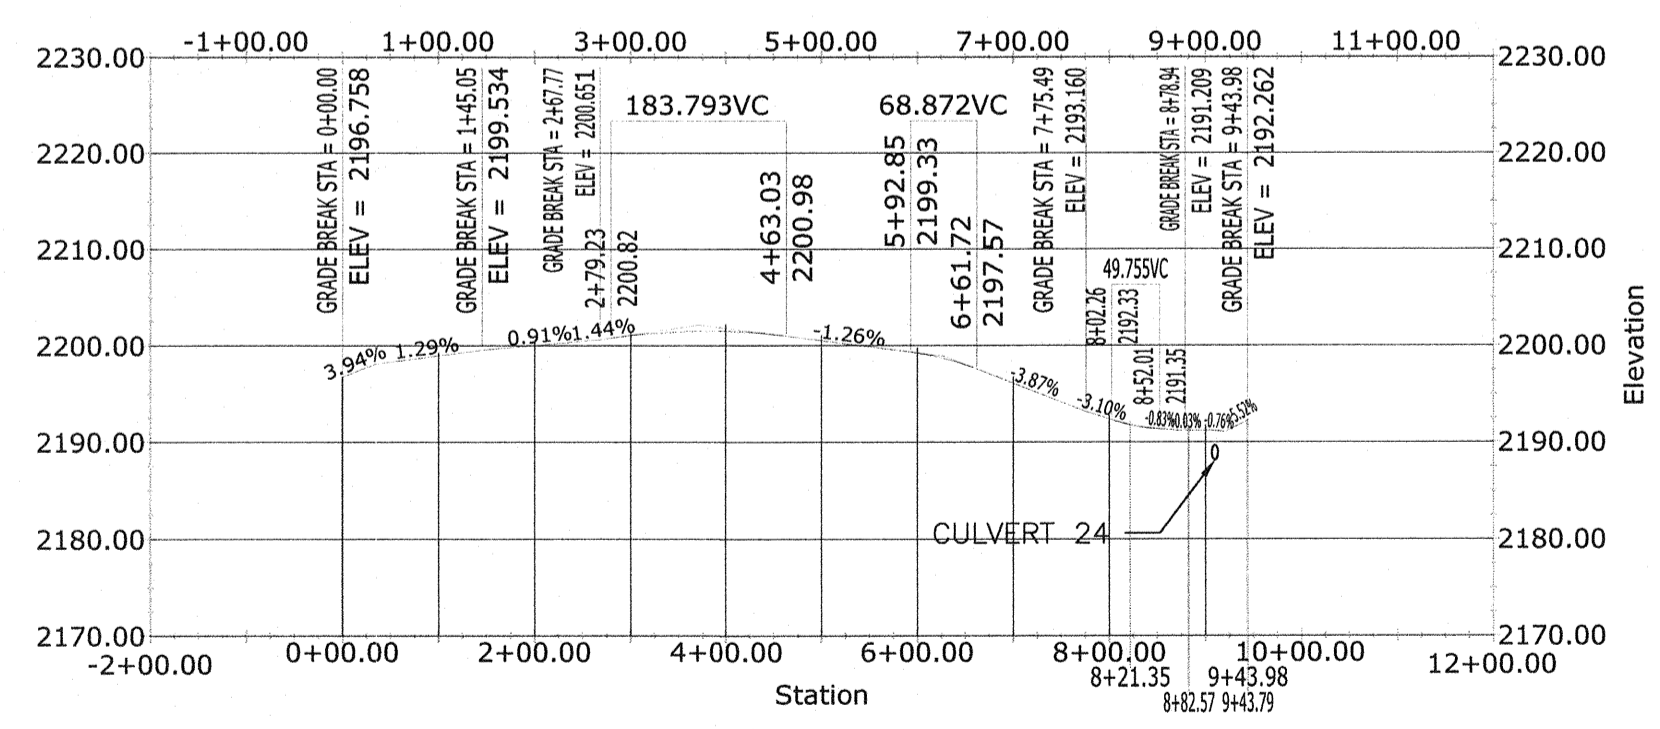


2 PROFILE: ALIGNMENT F
HORIZONTAL SCALE IN FEET VERTICAL SCALE IN FEET

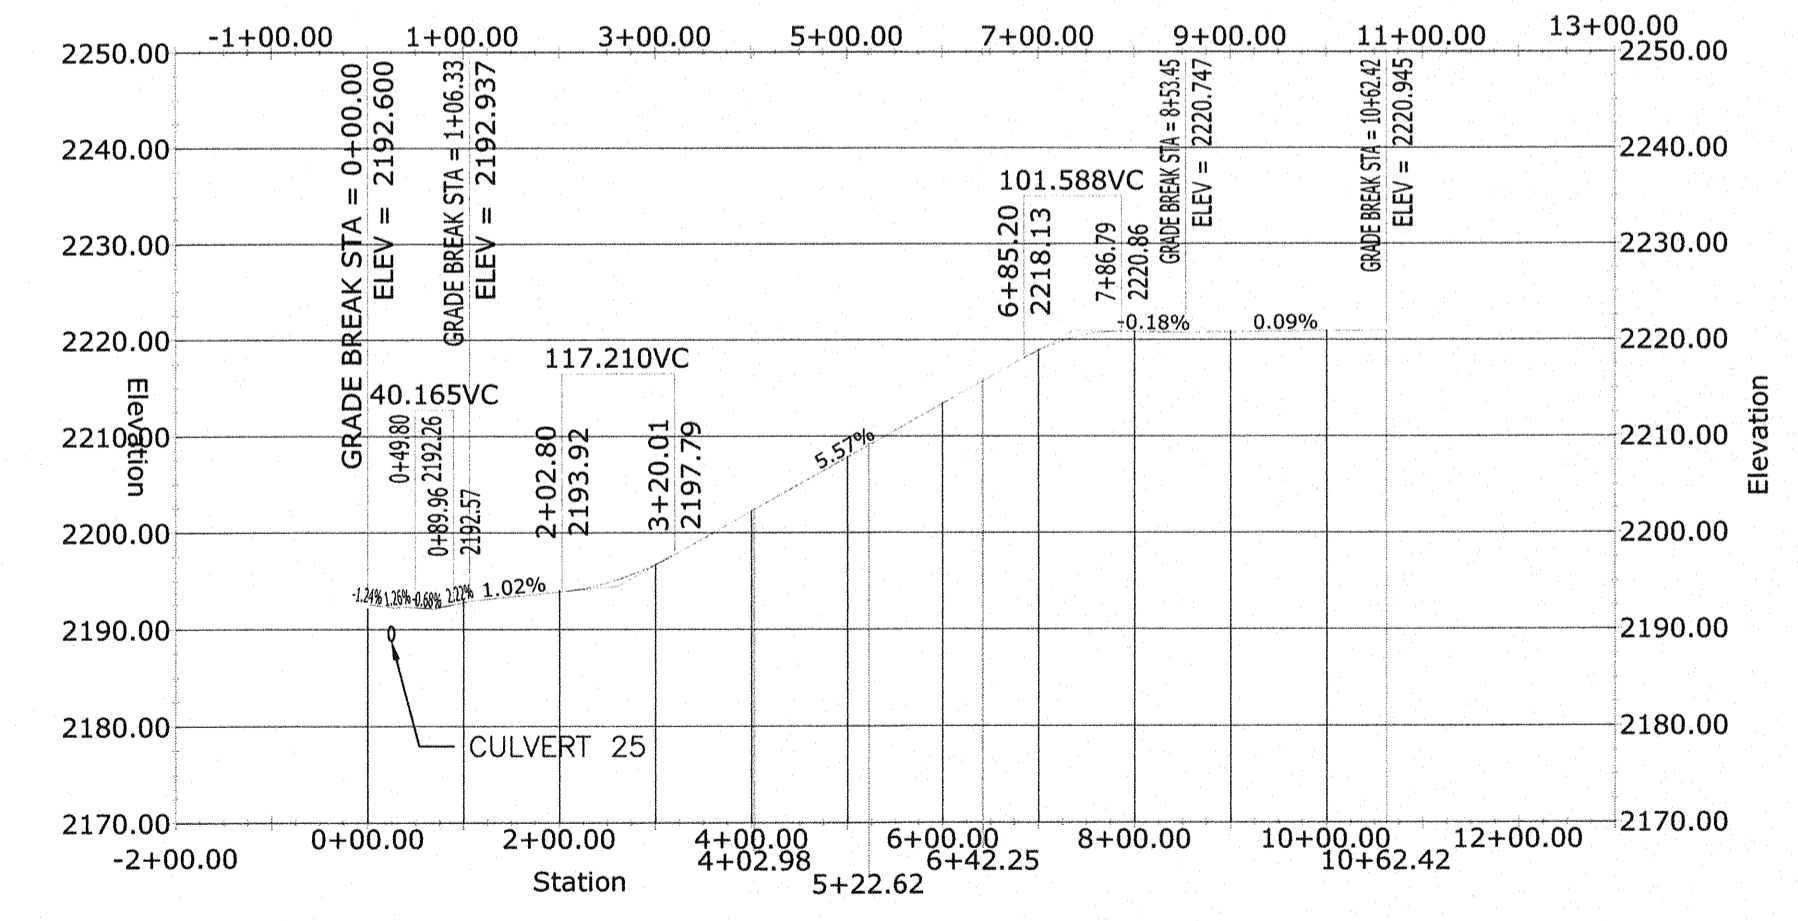

4 PROFILE: ALIGNMENT G

EXTERNAL REFERENCE:
34331007-BASE-C3D-DESIGN-ROADS-AS-BUILT.DWG


NO.	BY	CHK	APP.	DATE	REVISION DESCRIPTION
A	DMD	CAD	JXB	05/27/11	60 PERCENT SUBMITTAL
B	CAD	CAD	JXB	07/01/11	90 PERCENT SUBMITTAL
0	DMD	CAD	JXB	08/12/11	ISSUED FOR CONSTRUCTION
1	NUG			2/27/13	CONSTRUCTION REVISIONS

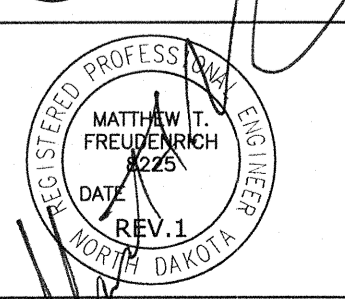

CLIENT	05/27/11	07/01/11				
BID						
CONSTRUCTION			08/12/11			
PERMITTING						
RECORD						
RELEASED TO/FOR	A	B	C	0	1	2
DATE RELEASED						

Project Office:
BARR ENGINEERING CO.
4700 WEST 77TH STREET
MINNEAPOLIS, MN.
55435-4803
Corporate Headquarters:
Minneapolis, Minnesota
Ph: 1-800-632-2277
Fax: (952) 832-2601
www.barr.com

Scale	AS SHOWN
Date	05/20/11
Drawn	DMD
Checked	JXB
Designed	CAD
Approved	JXB

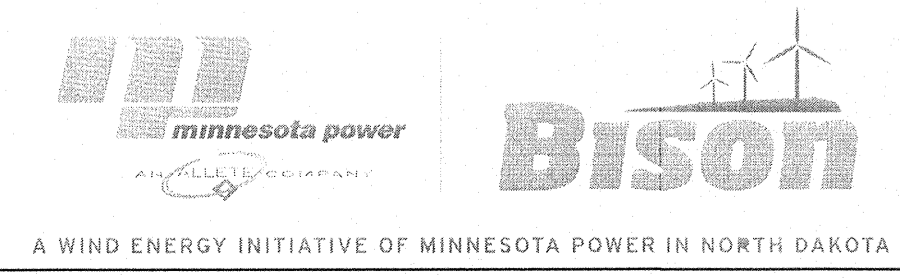

BISON 2 WIND PROJECT
MORTON & OLIVER COUNTIES, NORTH DAKOTA
PLAN AND PROFILE ALIGNMENTS F STA.
0+00 TO 9+44 & G STA. 0+00 TO 10+62

BARR PROJECT No.	34/33-1007
CLIENT PROJECT No.	
DWG. No.	C-19
REV. No.	1