



1 PLAN: ALIGNMENT H  
SCALE IN FEET

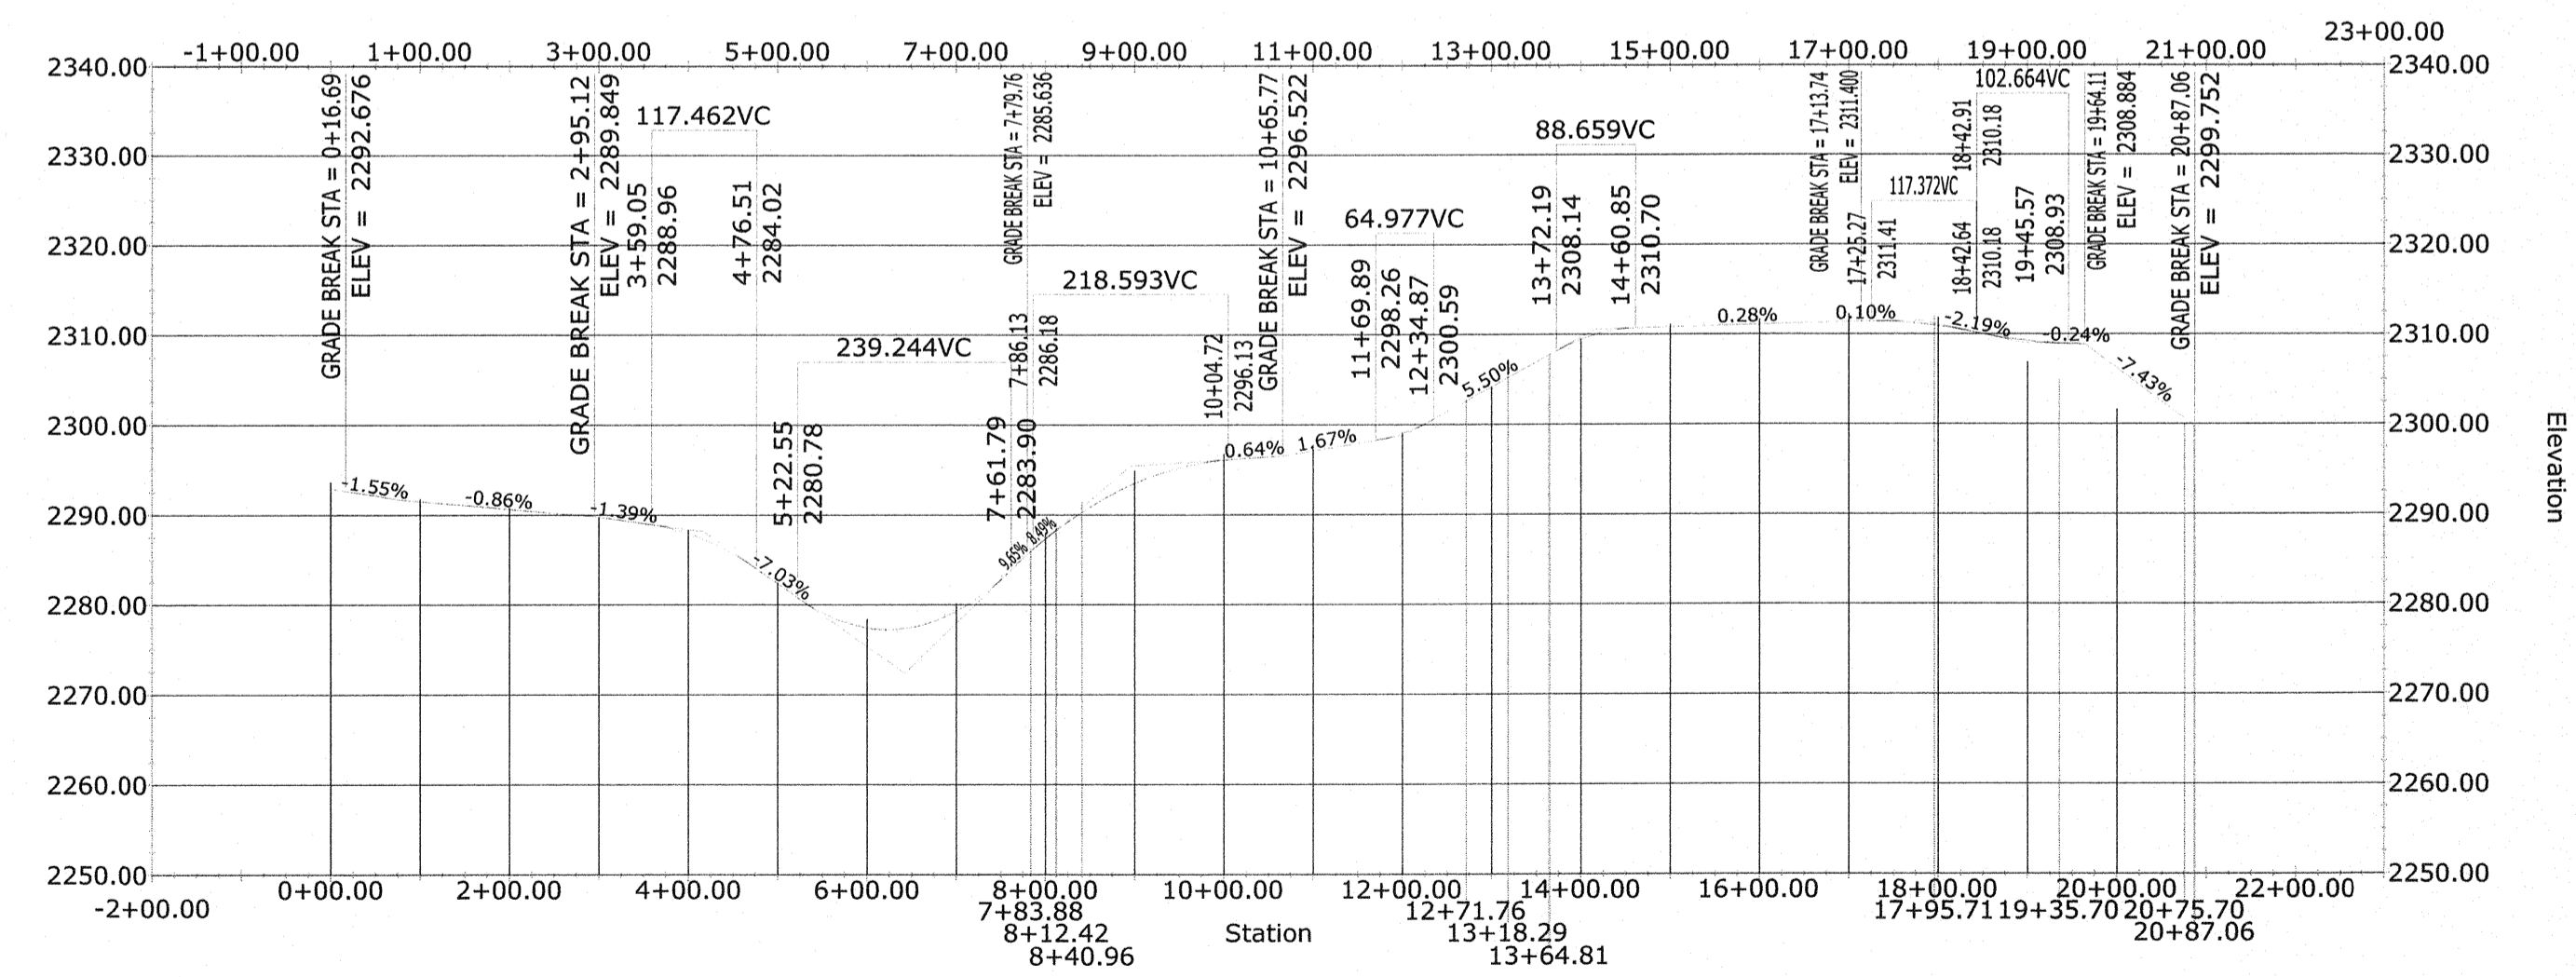

2 PROFILE: ALIGNMENT H  
HORIZONTAL SCALE IN FEET VERTICAL SCALE IN FEET

EXTERNAL REFERENCE:  
34331007-BASE-C3D-DESIGN-  
ROADS-AS-BUILT.DWG


A	DMD	CAD	JXB	05/27/11	60 PERCENT SUBMITTAL
B	CAD	CAD	JXB	07/01/11	90 PERCENT SUBMITTAL
O	DMD	CAD	JXB	08/12/11	ISSUED FOR CONSTRUCTION
1	NJG			2/21/13	CONSTRUCTION REVISIONS
NO.	BY	CHK.	APP.	DATE	REVISION DESCRIPTION

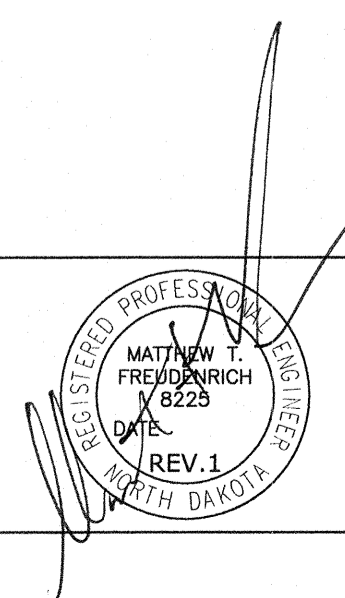

CLIENT	05/27/11	07/01/11				
BID						
CONSTRUCTION			08/12/11			
PERMITTING						
RECORD						
RELEASED TO/FOR	A	B	C	O	1	2
					3	
	DATE RELEASED					

Project Office:  
BARR ENGINEERING CO.  
4700 WEST 77TH STREET  
MINNEAPOLIS, MN.  
55435-4803  
Corporate Headquarters:  
Minneapolis, Minnesota  
Ph: 1-800-632-2277  
Fax: (952) 832-2601  
www.barr.com

Scale	AS SHOWN
Date	05/20/11
Drawn	DMD
Checked	JXB
Designed	CAD
Approved	JXB

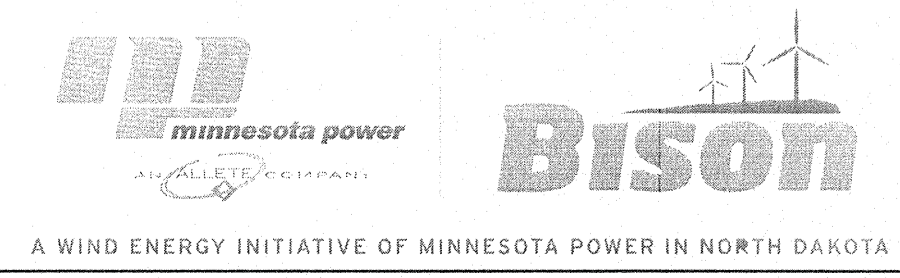

BISON 2 WIND PROJECT  
MORTON & OLIVER COUNTIES, NORTH DAKOTA  
PLAN AND PROFILE  
ALIGNMENT H - STA. 0+00 TO 20+87

BARR PROJECT No.	34/33-1007
CLIENT PROJECT No.	
DWG. No.	C-20
REV. No.	1