



1 PLAN: ALIGNMENT 11  
 0 200 400  
 SCALE IN FEET

3 PLAN: ALIGNMENT 12  
 0 200 400  
 SCALE IN FEET

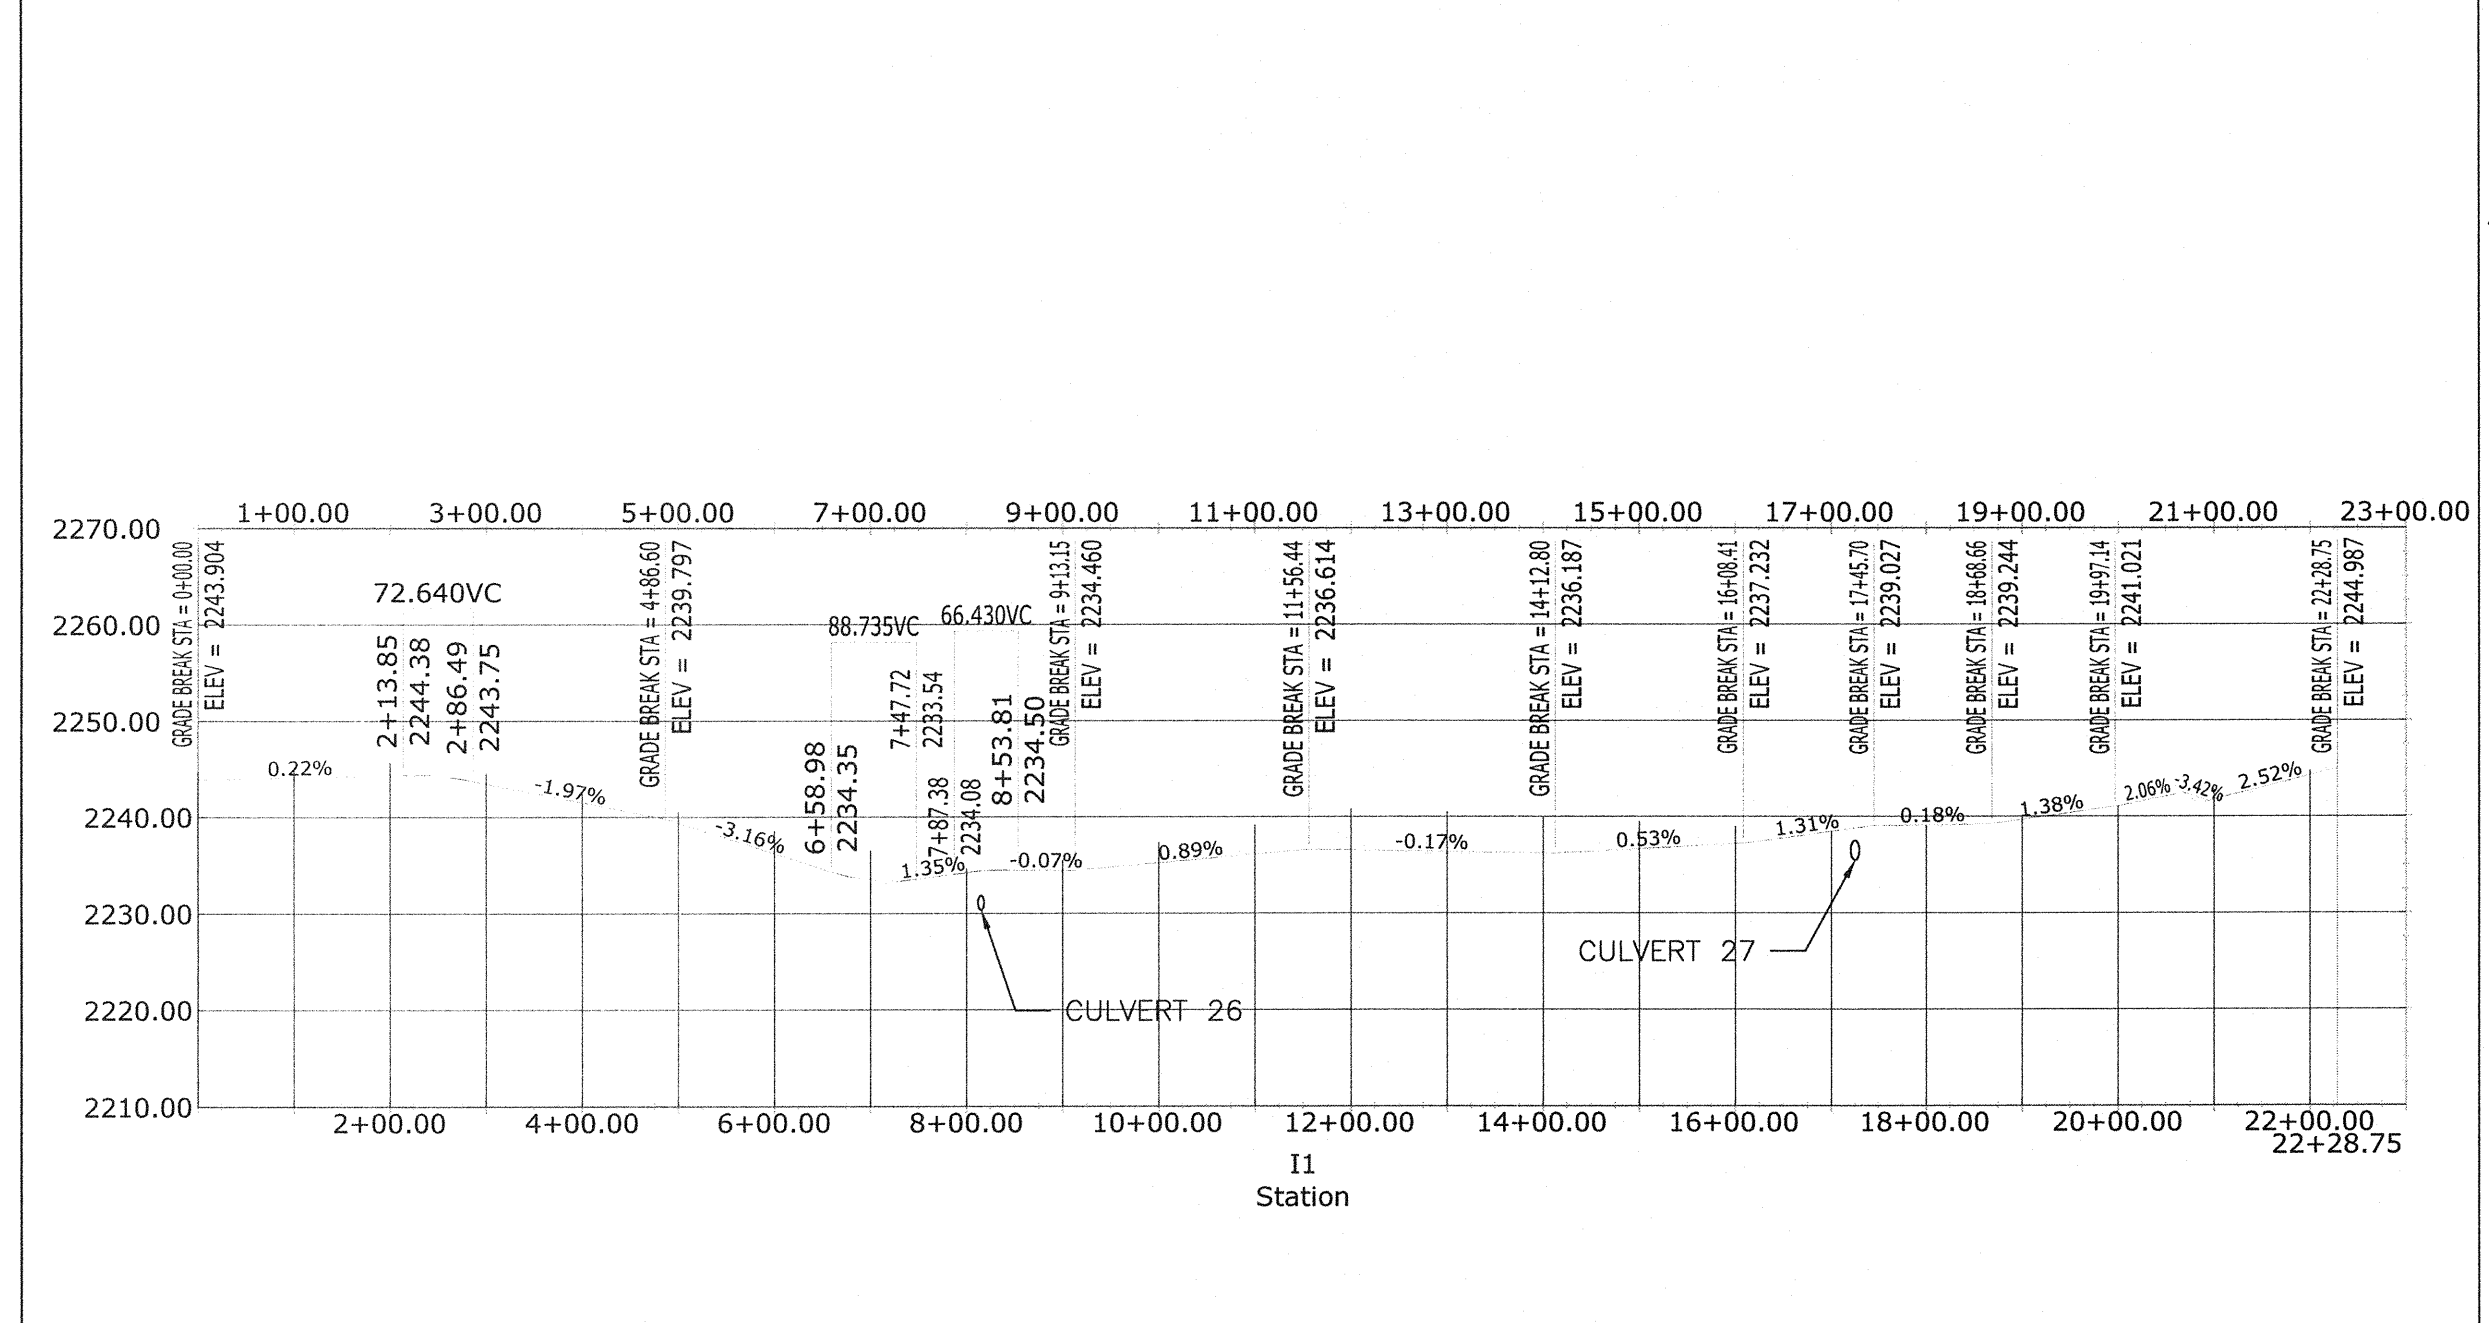

2 PROFILE: ALIGNMENT 11  
 0 200 400 0 20 40  
 HORIZONTAL SCALE IN FEET VERTICAL SCALE IN FEET

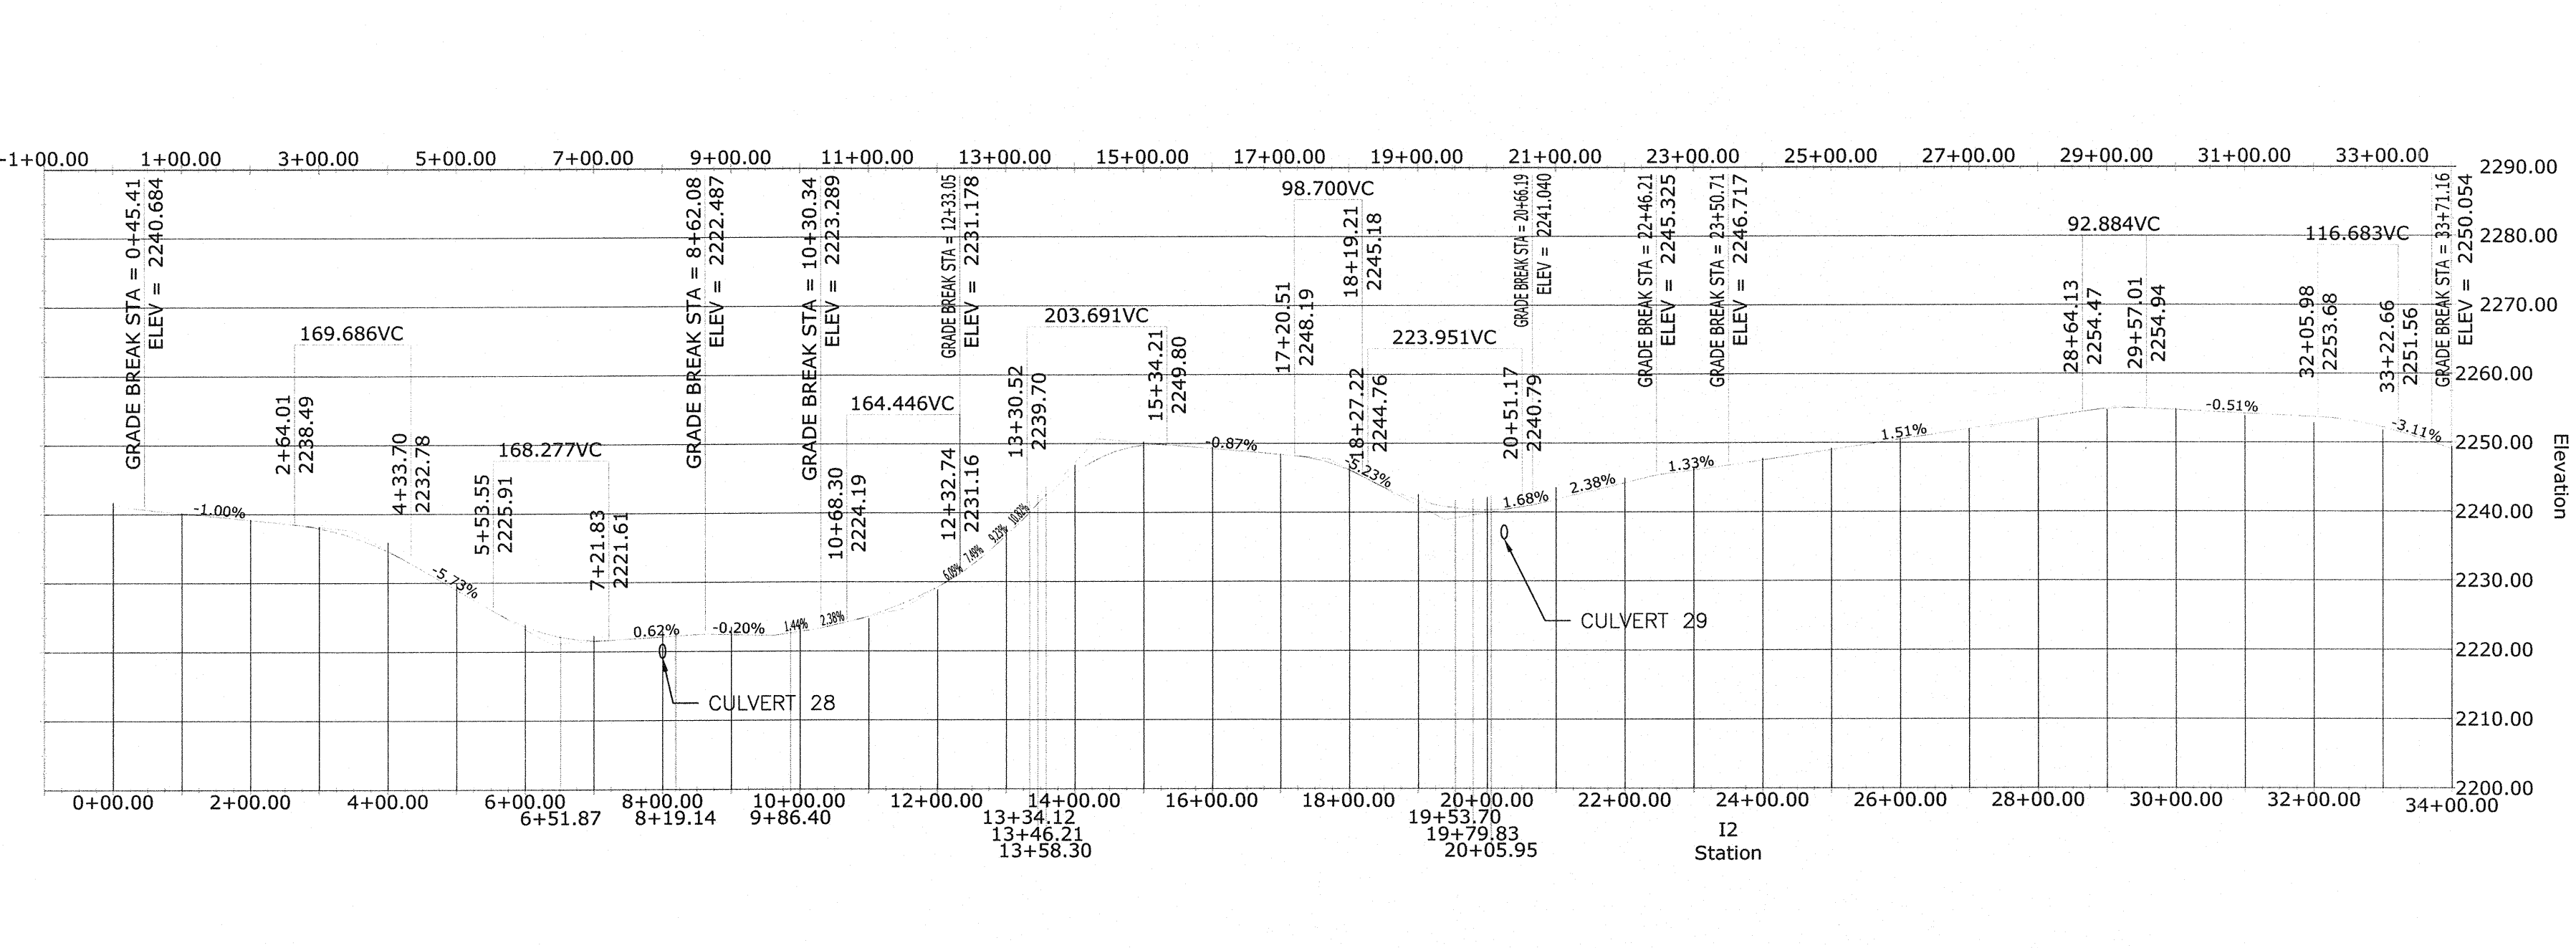

4 PROFILE: ALIGNMENT 12  
 0 200 400 0 20 40  
 HORIZONTAL SCALE IN FEET VERTICAL SCALE IN FEET

NO.	BY	CHK.	APP.	DATE	REVISION DESCRIPTION
A	DMD	CAD	JXB	05/27/11	60 PERCENT SUBMITTAL
B	CAD	CAD	JXB	07/01/11	90 PERCENT SUBMITTAL
0	DMD	CAD	JXB	08/12/11	ISSUED FOR CONSTRUCTION
1	NUJ			2/27/13	CONSTRUCTION REVISIONS

REGISTERED PROFESSIONAL ENGINEER  
 MATTHEW T. FREUDENBERG  
 DATE: 8/27/13  
 REV. 1

CLIENT	05/27/11	07/01/11				
BID						
CONSTRUCTION						
PERMITTING						
RECORD						
RELEASED TO/FOR	A	B	C	0	1	2
DATE RELEASED						

Project Office:  
 BARR ENGINEERING CO.  
 4700 WEST 77TH STREET  
 MINNEAPOLIS, MN.  
 55435-4803  
 Corporate Headquarters:  
 Minneapolis, Minnesota  
 Ph: 1-800-632-2277  
 Fax: (952) 832-2601  
 www.barr.com

Scale	AS SHOWN
Date	05/20/11
Drawn	DMD
Checked	JXB
Designed	CAD
Approved	JXB



BISON 2 WIND PROJECT  
 MORTON & OLIVER COUNTIES, NORTH DAKOTA  
 PLAN AND PROFILE - ALIGNMENTS 11 STA.  
 0+00 TO 22+29 & STA. 12 0+00 TO 34+00

BARR PROJECT No.	34/33-1007
CLIENT PROJECT No.	
DWG. No.	C-22
REV. No.	1

EXTERNAL REFERENCE:  
 34331007-BASE-C3D-DESIGN-  
 ROADS-AS-BUILT.DWG