



1 PLAN: ALIGNMENT 12  
SCALE IN FEET

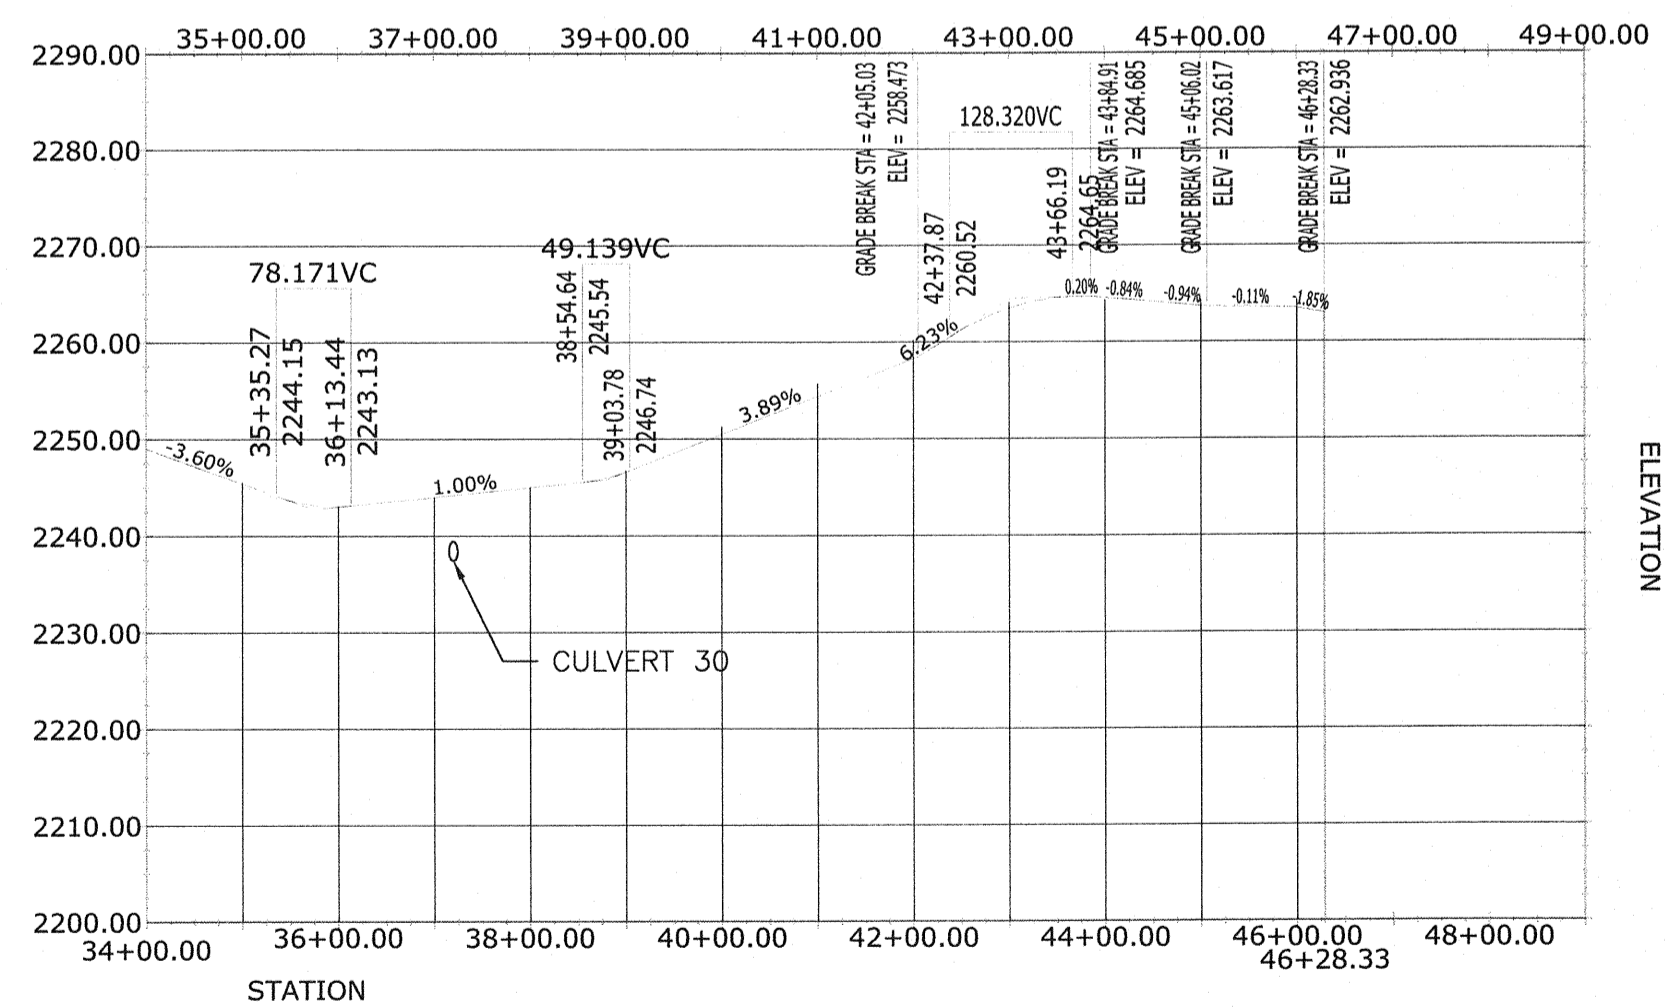

2 PROFILE: ALIGNMENT 12  
HORIZONTAL SCALE IN FEET VERTICAL SCALE IN FEET

EXTERNAL REFERENCE:  
34331007-BASE-C3D-DESIGN-  
ROADS-AS-BUILT.DWG


NO.	BY	CHK	APP.	DATE	REVISION DESCRIPTION
A	DMD	CAD	JXB	05/27/11	60 PERCENT SUBMITTAL
B	CAD	CAD	JXB	07/01/11	90 PERCENT SUBMITTAL
0	DMD	CAD	JXB	08/12/11	ISSUED FOR CONSTRUCTION
1	NJG			2/27/13	CONSTRUCTION REVISIONS

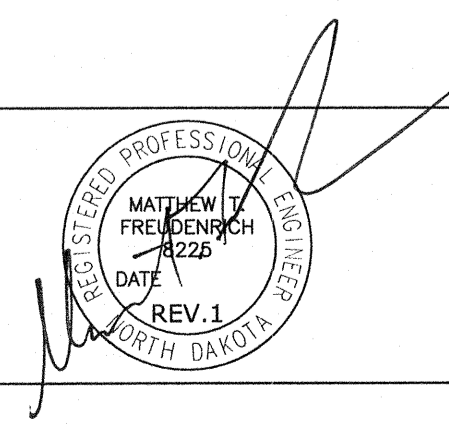

CLIENT	BID	CONSTRUCTION	PERMITTING	RECORD	RELEASED TO/FOR	DATE RELEASED
					A B C 0 1 2 3	

Project Office:  
**BARR ENGINEERING CO.**  
4700 WEST 77TH STREET  
MINNEAPOLIS, MN.  
55435-4803  
Corporate Headquarters:  
Minneapolis, Minnesota  
Ph: 1-800-632-2277  
Ph: (952) 832-2601  
Fax: (952) 832-2601  
www.barr.com

Scale	AS SHOWN
Date	05/20/11
Drawn	DMD
Checked	JXB
Designed	CAD
Approved	JXB

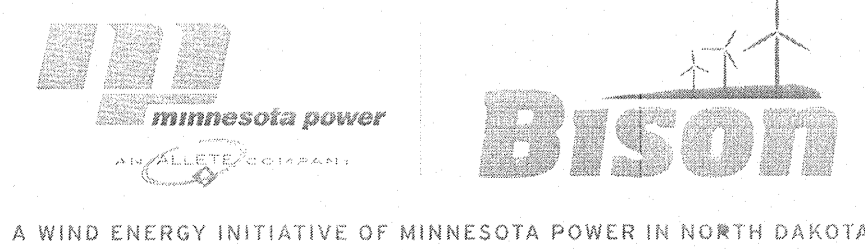

**BISON 2 WIND PROJECT**  
MORTON & OLIVER COUNTIES, NORTH DAKOTA  
PLAN AND PROFILE  
ALIGNMENT 1 - STA. 34+00 TO 46+28

BARR PROJECT No.	CLIENT PROJECT No.	DWG. No.	REV. No.
34/33-1007		C-23	1