



1 PLAN: ALIGNMENT J1 AND J2
SCALE IN FEET

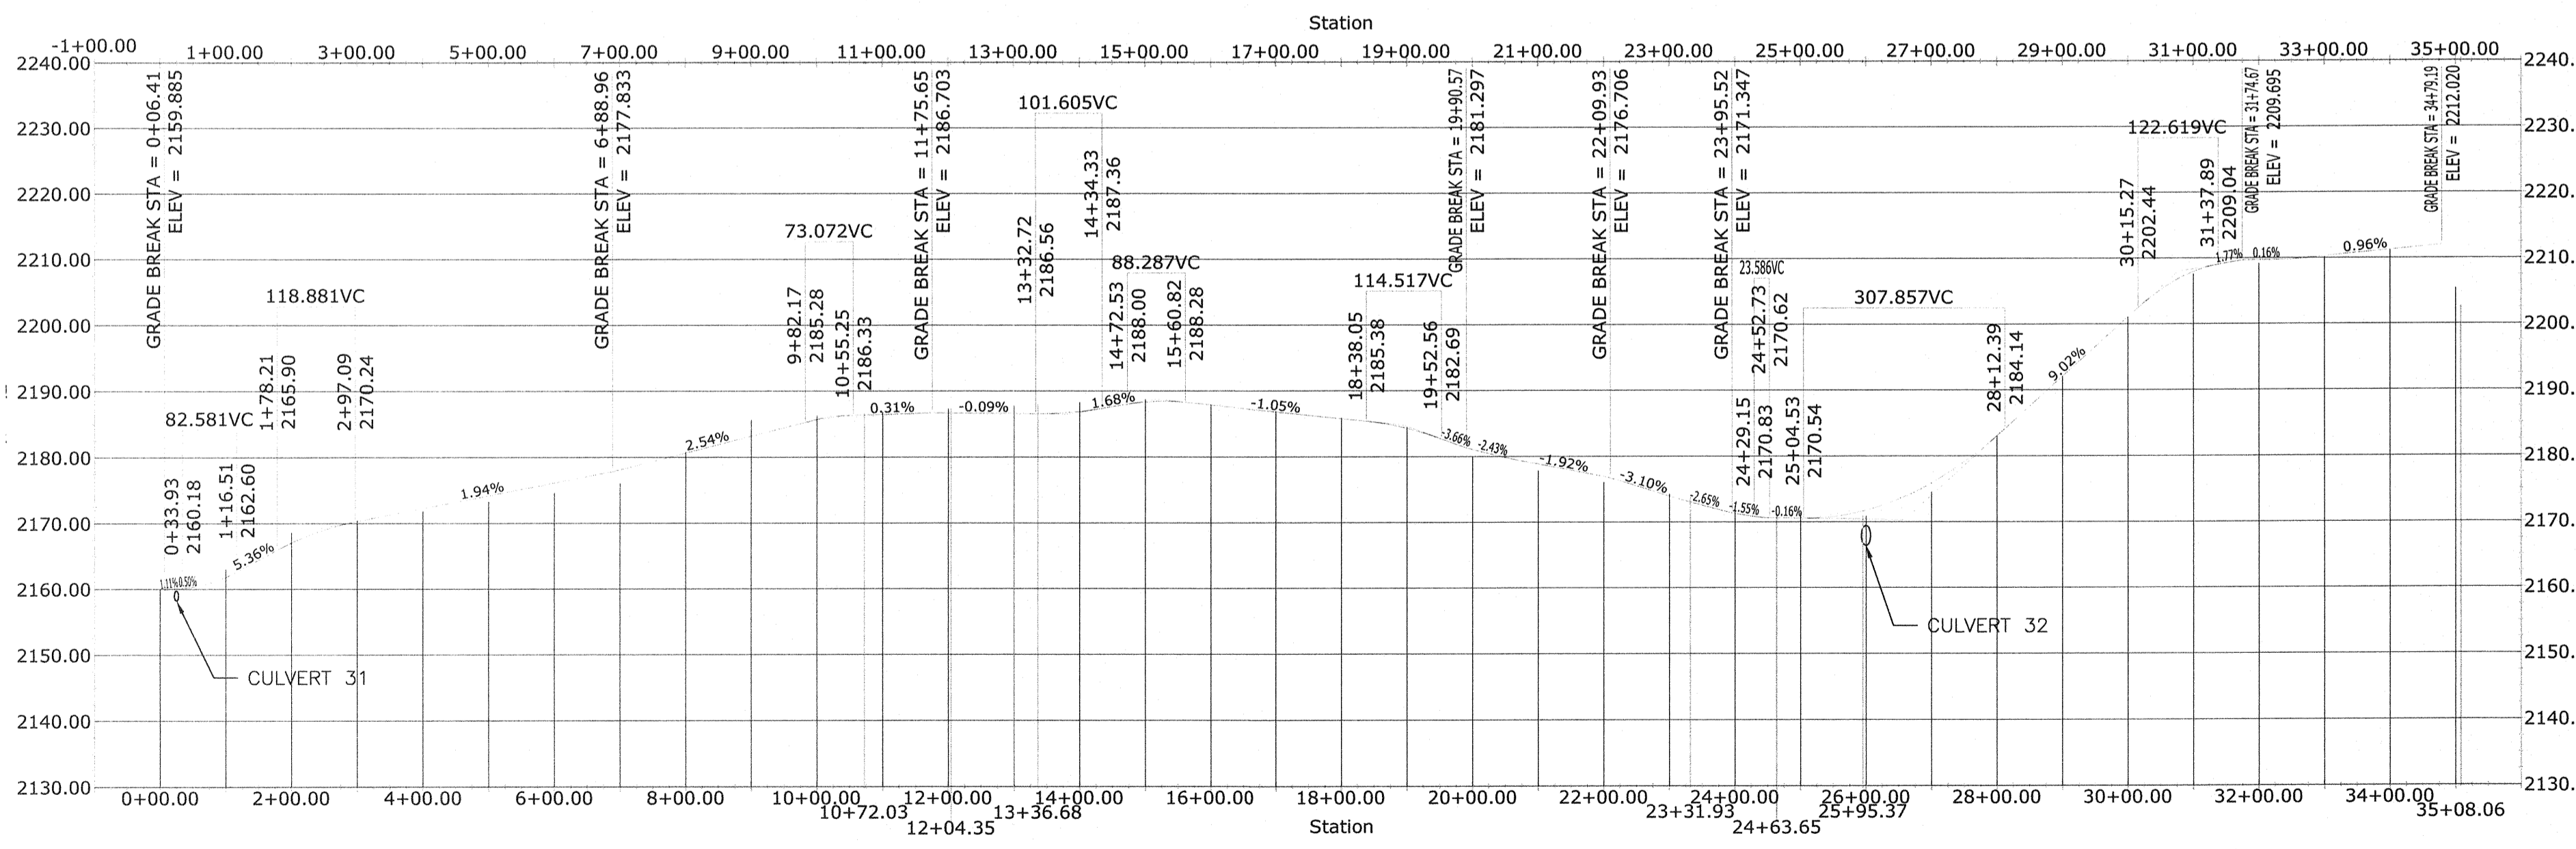


2 PROFILE: ALIGNMENT J1
HORIZONTAL SCALE IN FEET VERTICAL SCALE IN FEET

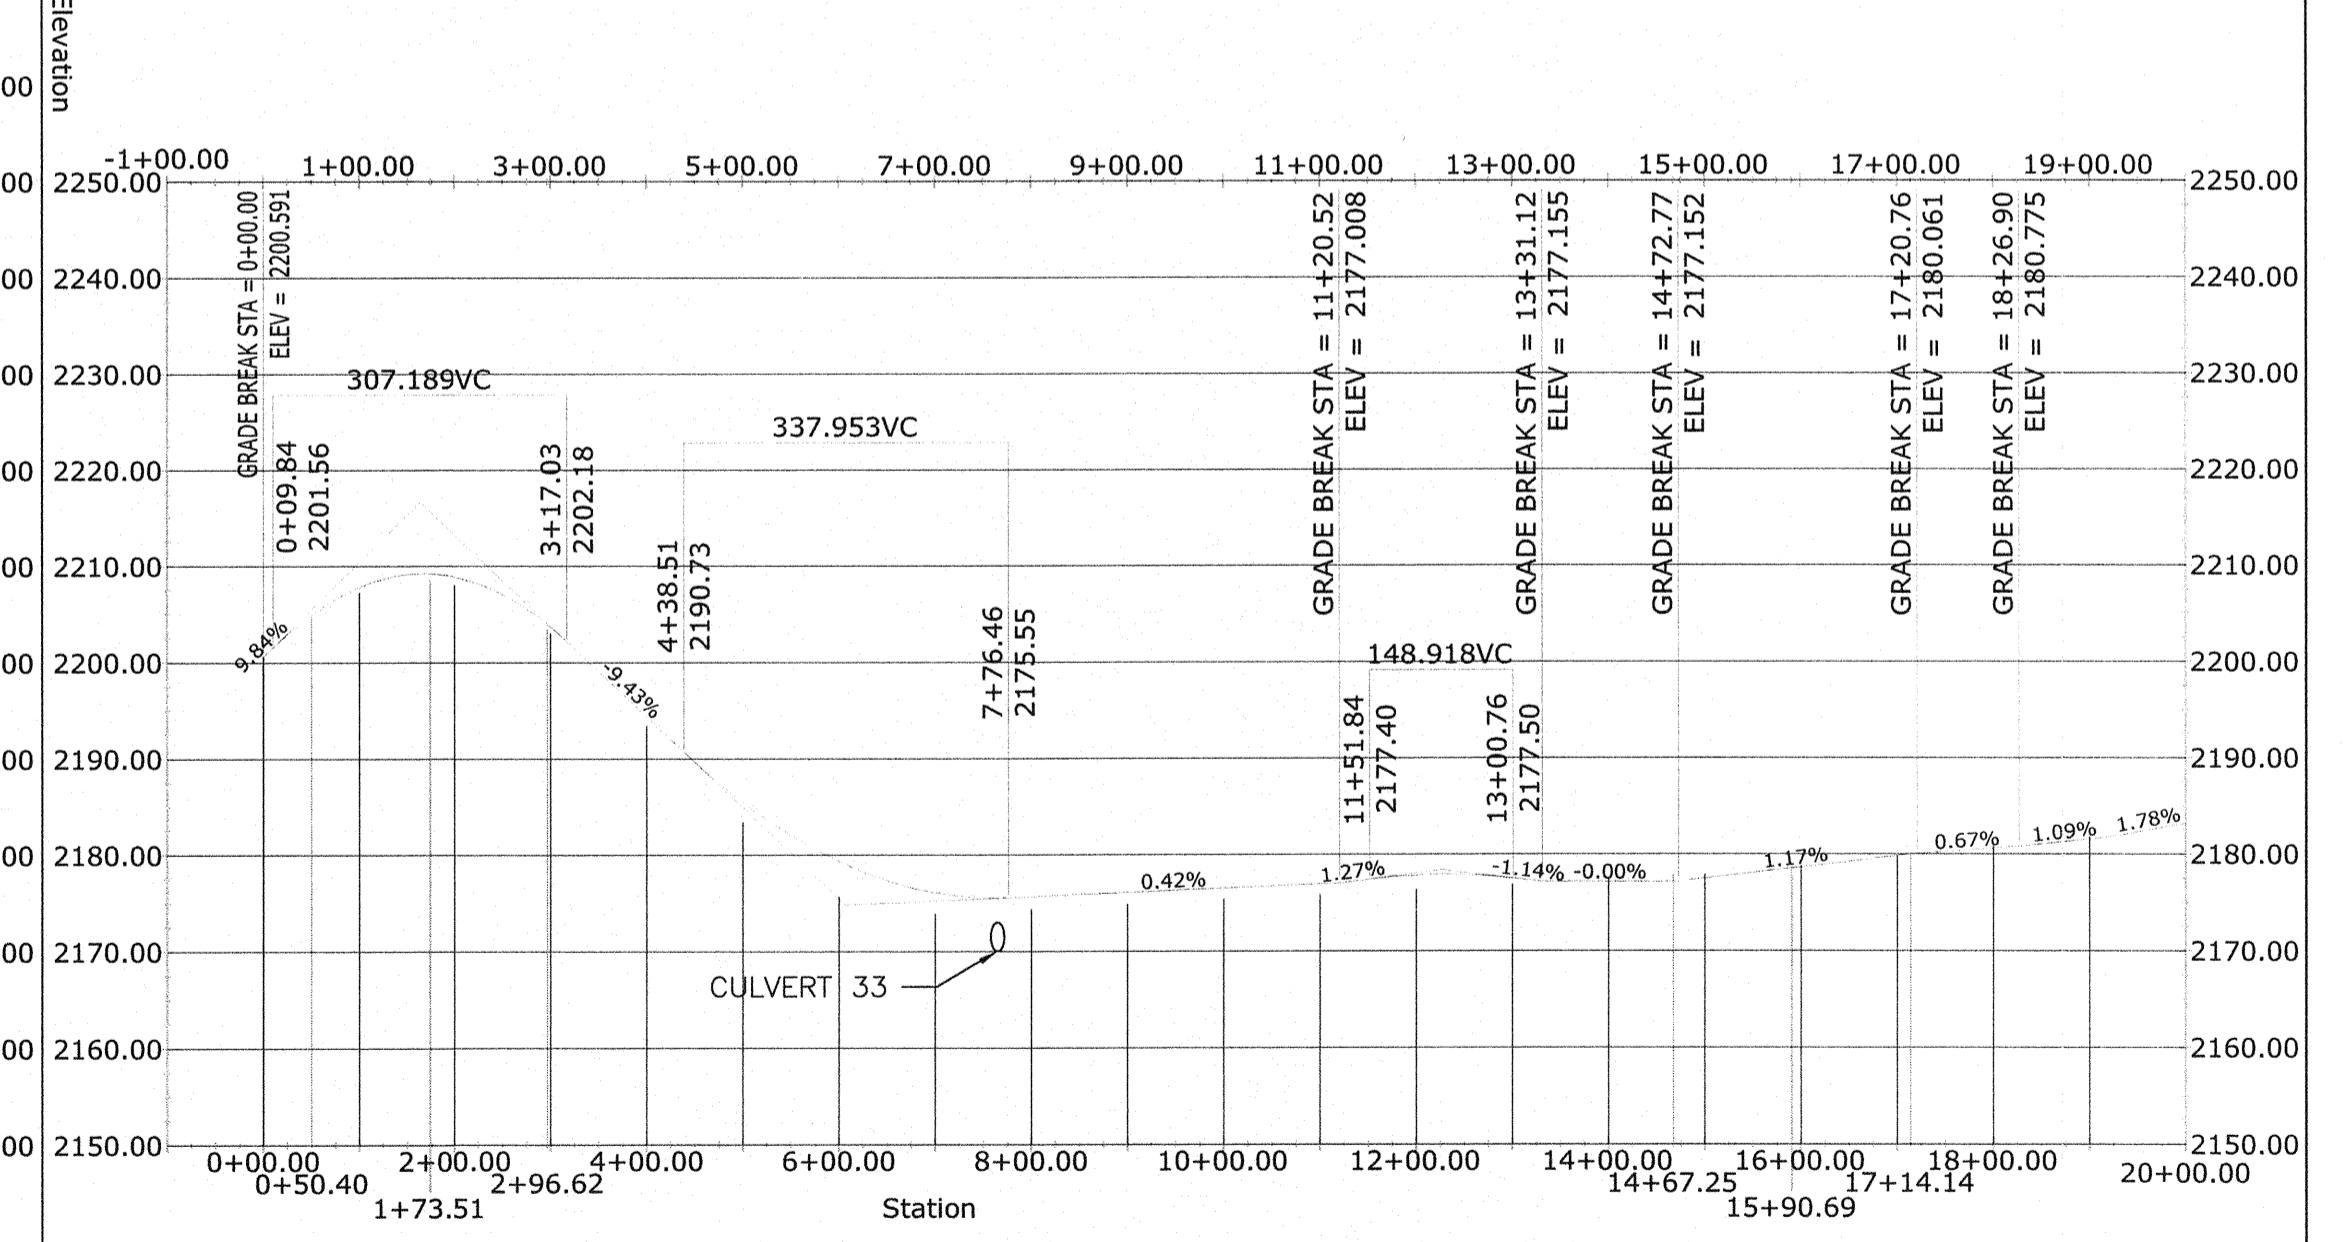

2 PROFILE: ALIGNMENT J2
HORIZONTAL SCALE IN FEET VERTICAL SCALE IN FEET

EXTERNAL REFERENCE:
34331007-BASE-C3D-DESIGN-ROADS-AS-BUILT.DWG


NO.	BY	CHK	APP.	DATE	REVISION DESCRIPTION
A	DMD	CAD	JXB	05/27/11	60 PERCENT SUBMITTAL
B	CAD	CAD	JXB	07/01/11	90 PERCENT SUBMITTAL
0	DMD	CAD	JXB	08/12/11	ISSUED FOR CONSTRUCTION
1	NJC			2/27/13	CONSTRUCTION REVISIONS

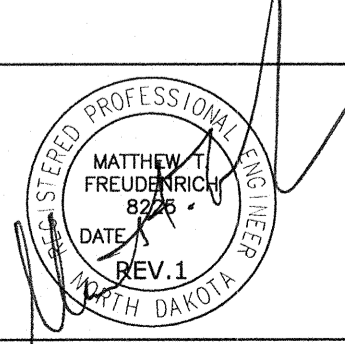

CLIENT	05/27/10/01/11				
BID					
CONSTRUCTION			08/12/11		
PERMITTING					
RECORD					
RELEASED TO/FOR	A	B	C	0	1
				2	3

BARR
Project Office:
BARR ENGINEERING CO.
4700 WEST 77TH STREET
MINNEAPOLIS, MN.
55435-4803
Corporate Headquarters:
Minneapolis, Minnesota
Ph: 1-800-632-2277
www.barr.com

Scale	AS SHOWN
Date	05/20/11
Drawn	DMD
Checked	JXB
Designed	CAD
Approved	JXB

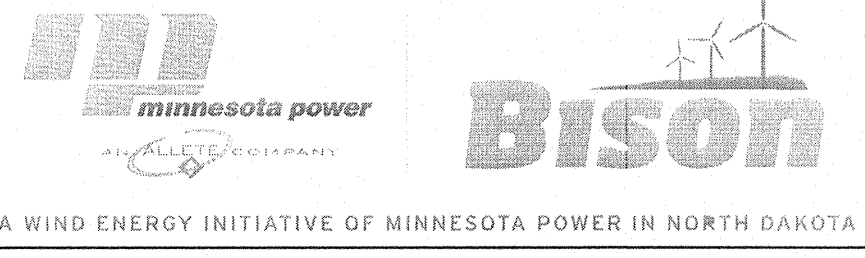

BISON 2I WIND PROJECT
MORTON & OLIVER COUNTIES, NORTH DAKOTA
PLAN AND PROFILE - ALIGNMENTS J1 STA. 0+00 TO 35+23 & STA. J2 0+00 TO 20+00

BARR PROJECT No.	34/33-1007
CLIENT PROJECT No.	
DWG. No.	C-24
REV. No.	1