



1 PLAN: ALIGNMENT L1 AND L2
 SCALE IN FEET

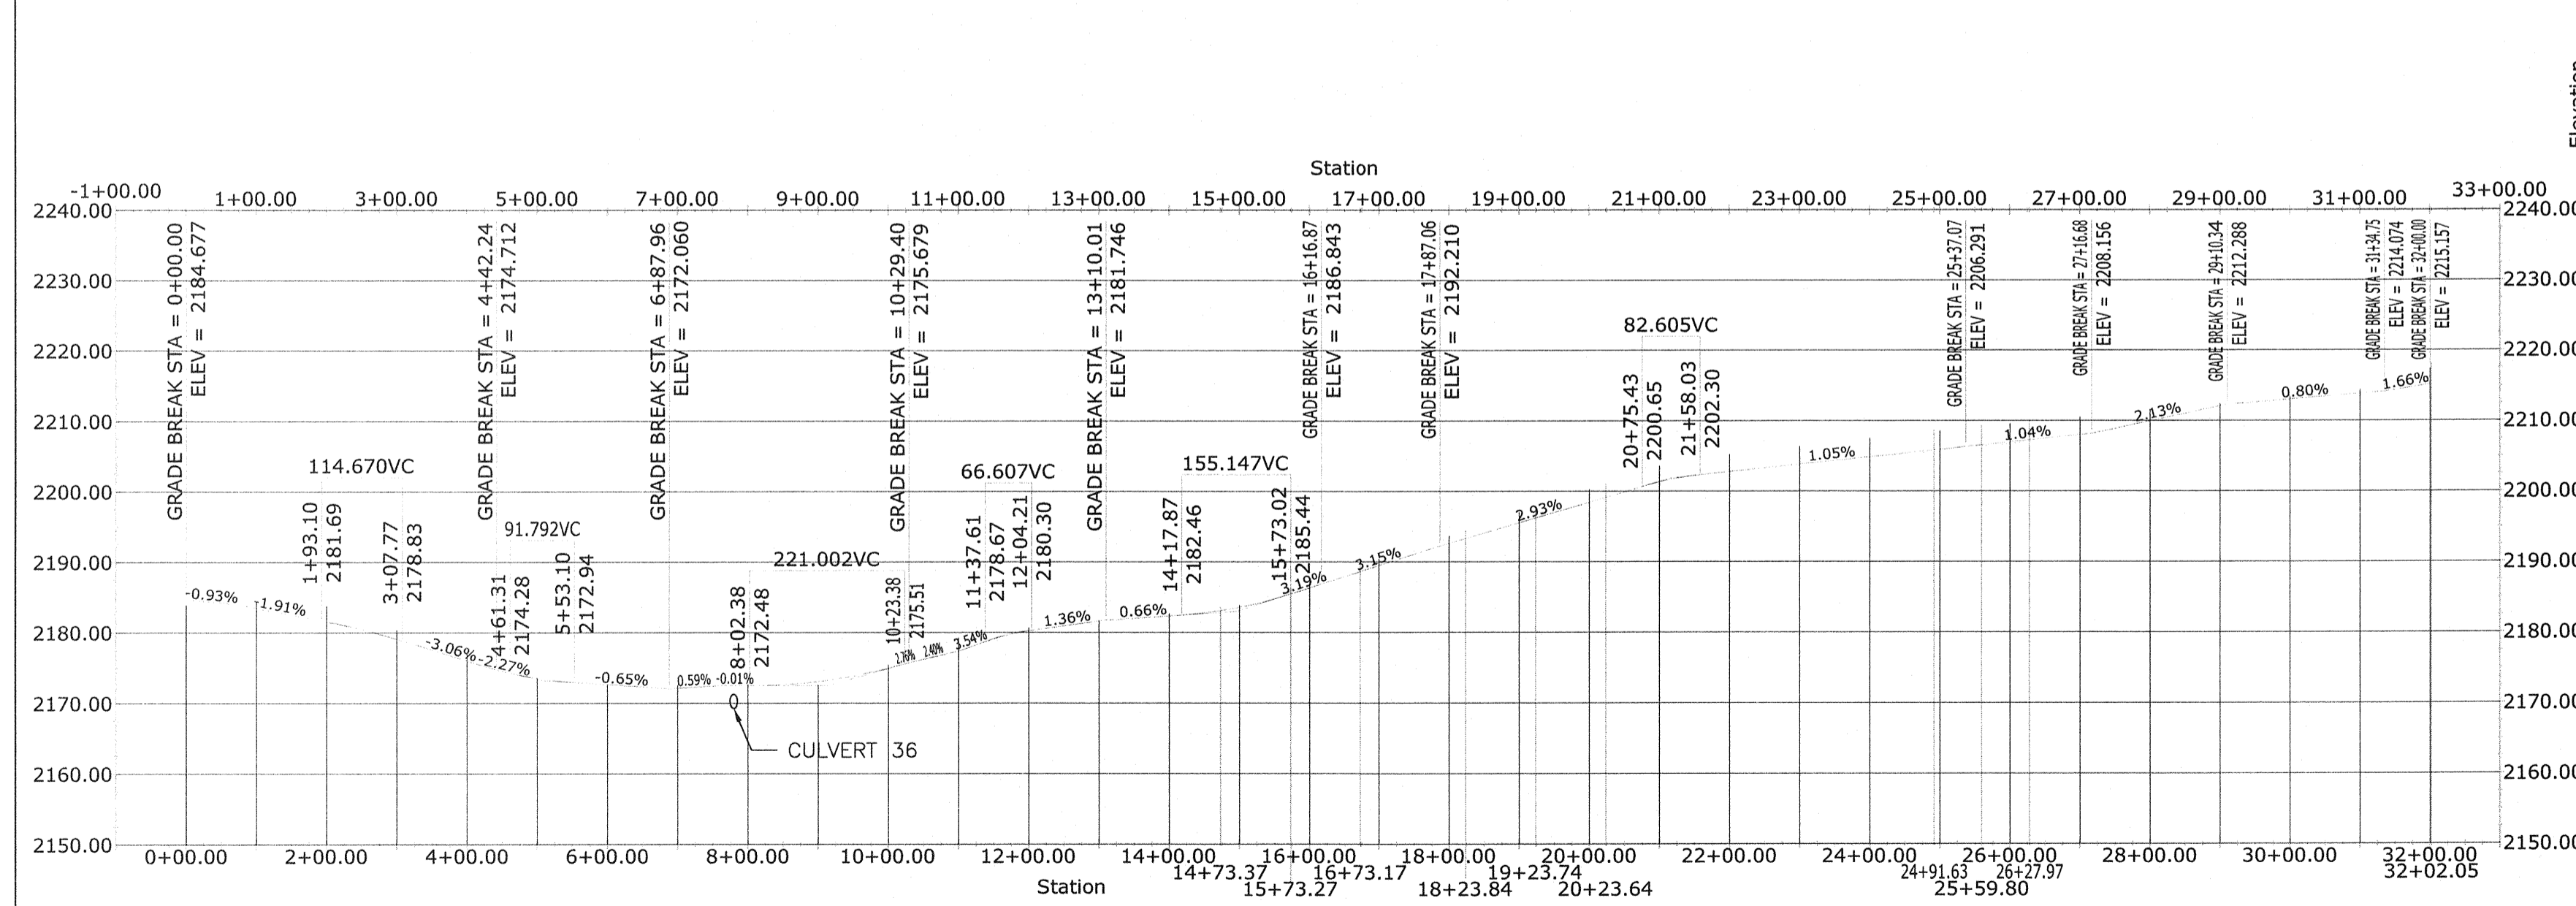


2 PROFILE: ALIGNMENT L1
 HORIZONTAL SCALE IN FEET VERTICAL SCALE IN FEET

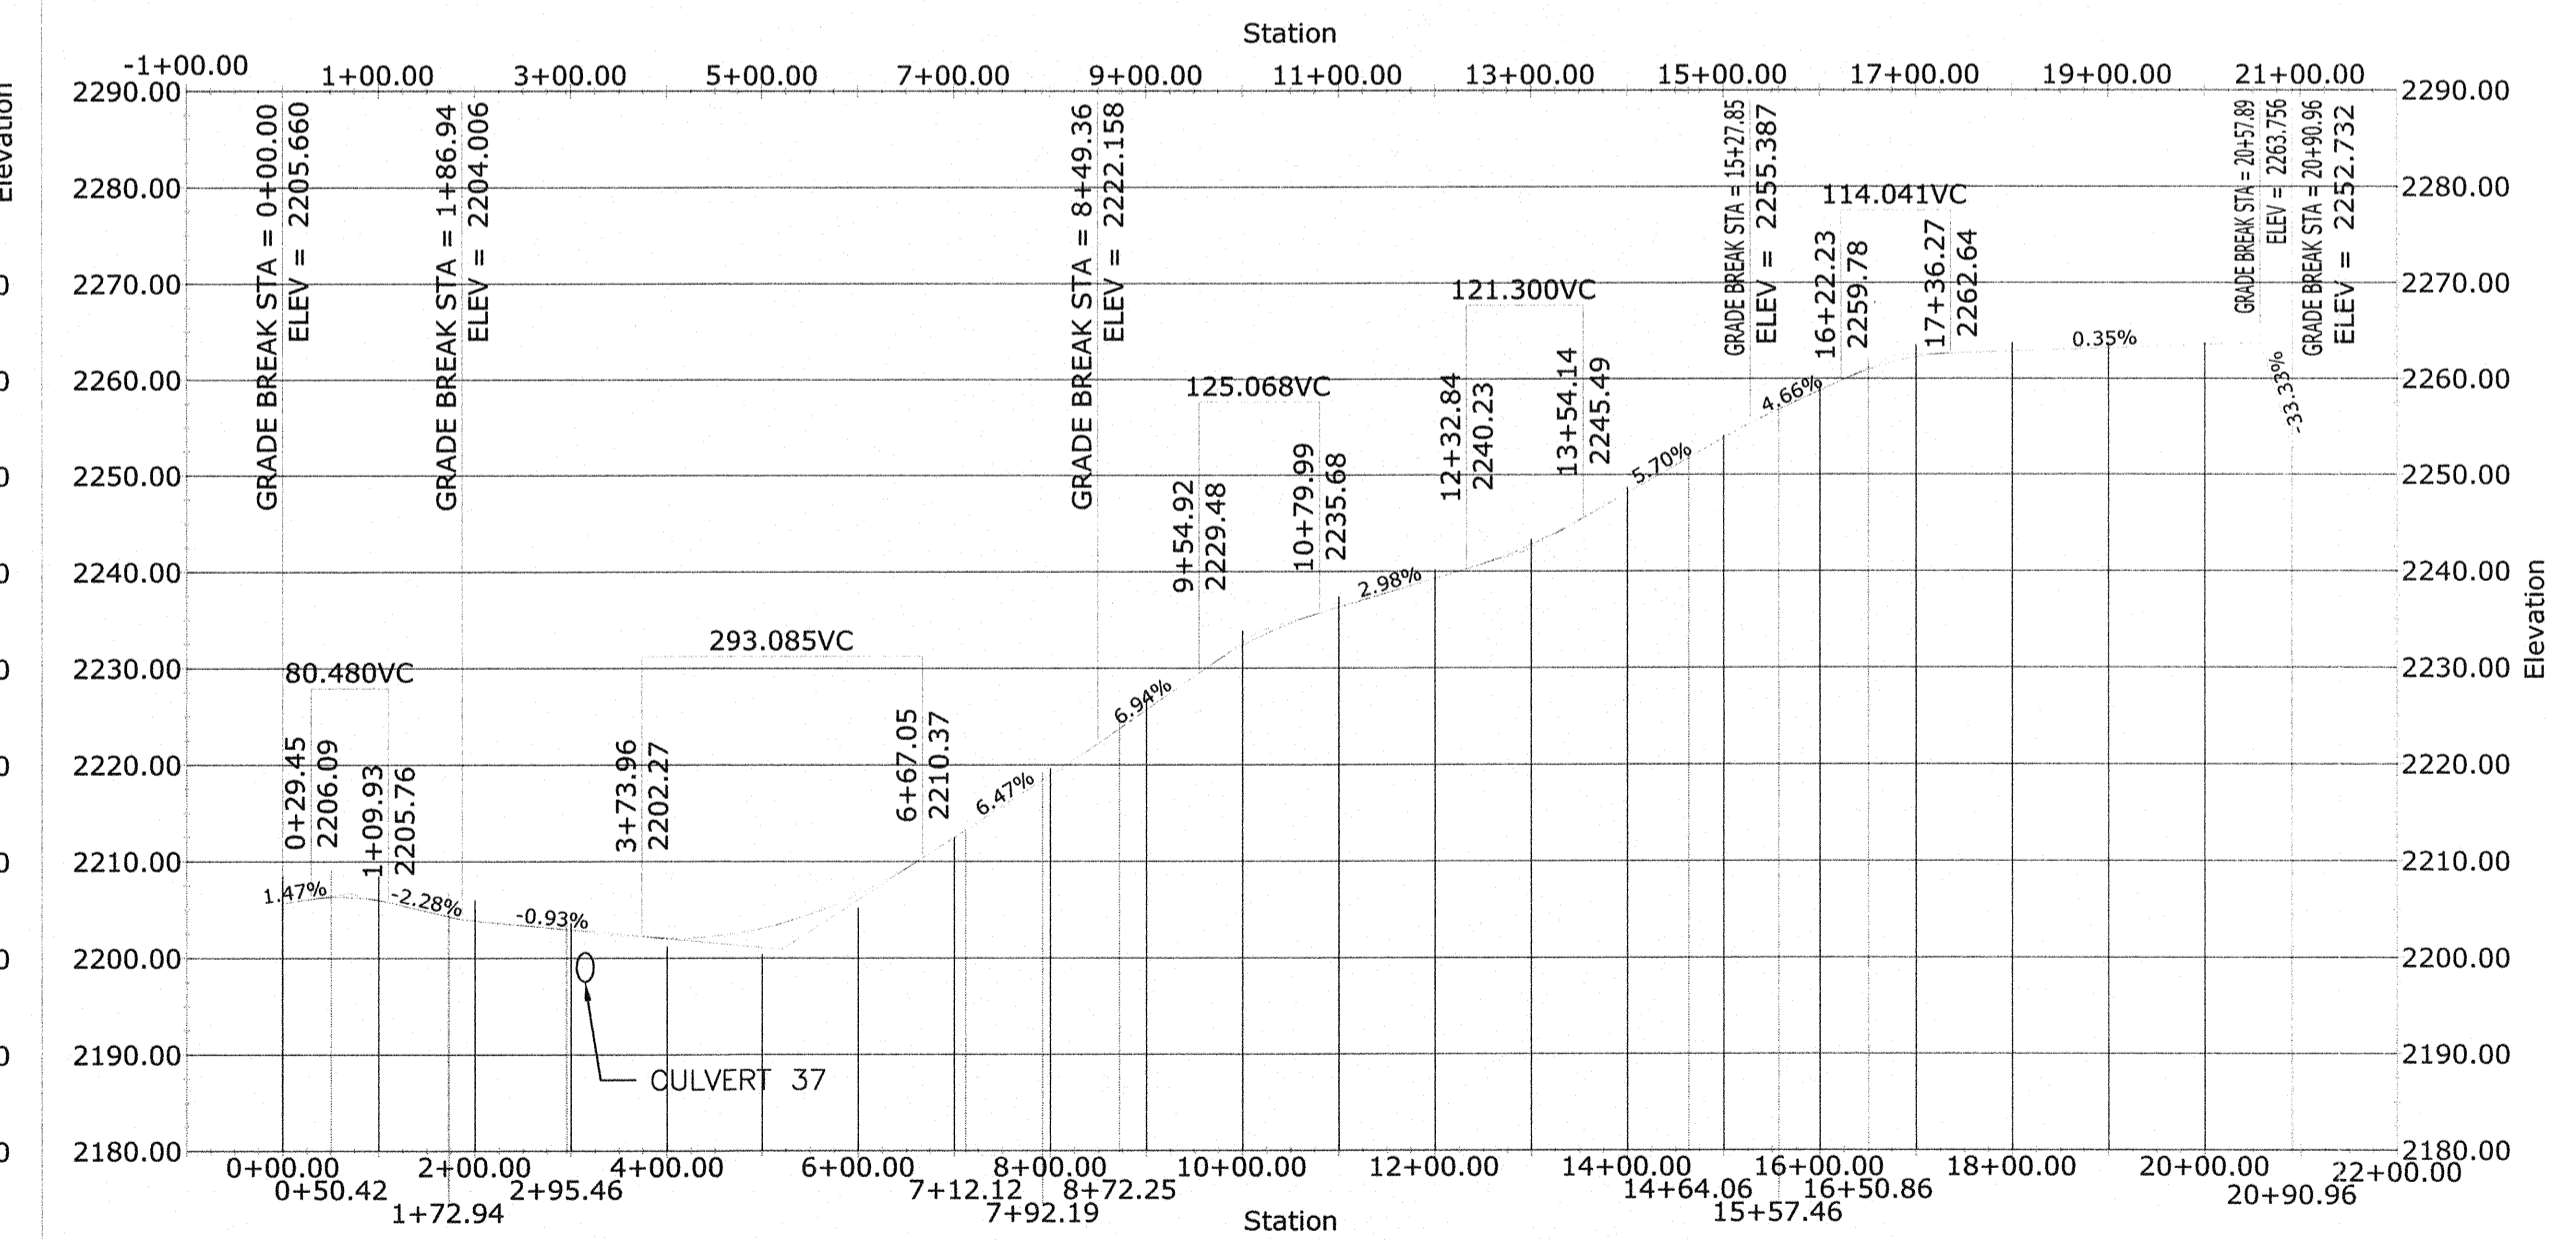

3 PROFILE: ALIGNMENT L2
 HORIZONTAL SCALE IN FEET VERTICAL SCALE IN FEET

EXTERNAL REFERENCE:
 34331007-BASE-C3D-DESIGN-ROADS-AS-BUILT.DWG


NO.	BY	CHK	APP.	DATE	REVISION DESCRIPTION
A	DMD	CAD	JXB	05/27/11	60 PERCENT SUBMITTAL
B	CAD	CAD	JXB	07/01/11	90 PERCENT SUBMITTAL
0	DMD	CAD	JXB	08/12/11	ISSUED FOR CONSTRUCTION
1	NJC			2/21/13	CONSTRUCTION REVISIONS

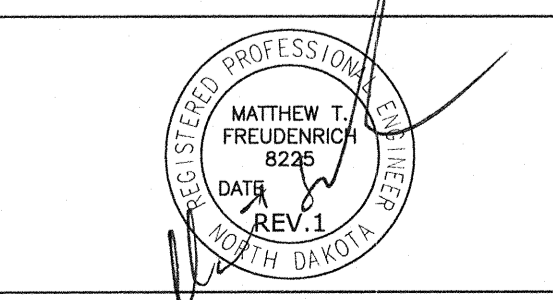

CLIENT	DATE
BARR ENGINEERING CO.	05/27/11
CONSTRUCTION	08/12/11
PERMITTING	
RECORD	
RELEASED TO/FOR	A B C 0 1 2 3
DATE RELEASED	

BARR ENGINEERING CO.
 4700 WEST 77TH STREET
 MINNEAPOLIS, MN.
 55435-4803
 Ph: 1-800-632-2277
 Fax: (612) 832-2601
 www.barr.com

Scale	AS SHOWN
Date	05/20/11
Drawn	DMD
Checked	JXB
Designed	CAD
Approved	JXB

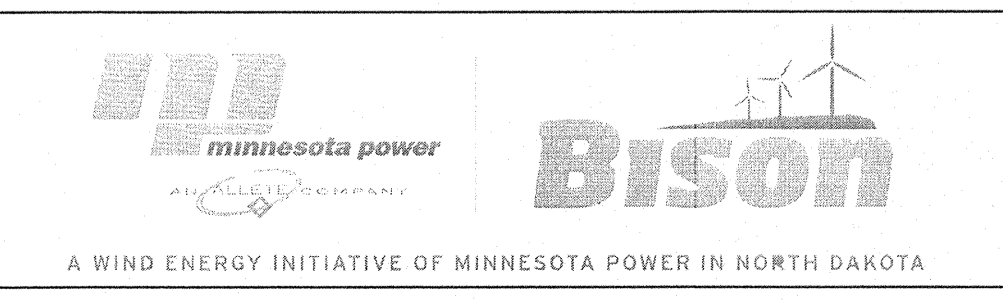

BISON 2 WIND PROJECT
 MORTON & OLIVER COUNTIES, NORTH DAKOTA
 PLAN AND PROFILE ALIGNMENTS L1 STA.
 0+00 TO 32+02 & L2 STA. 0+00 TO 20+91

BARR PROJECT No.	34/33-1007
CLIENT PROJECT No.	
DWG. No.	C-28
REV. No.	1