


**\*NOTES**

- ALL CRANE PATHS REMOVED AND RESTORED TO ORIGINAL CONDITION AFTER CONSTRUCTION.
- CRANE PATH INFORMATION REMOVED. BOTTOM OF PAGE LEFT INTENTIONALLY BLANK.


NO.	BY	CHK.	APP.	DATE	REVISION DESCRIPTION
A	DMD	CAD	JXB	05/27/11	60 PERCENT SUBMITTAL
B	CAD	CAD	JXB	07/01/11	90 PERCENT SUBMITTAL
O	DMD	CAD	JXB	08/12/11	ISSUED FOR CONSTRUCTION
1	NJG			2/6/13	CONSTRUCTION REVISIONS

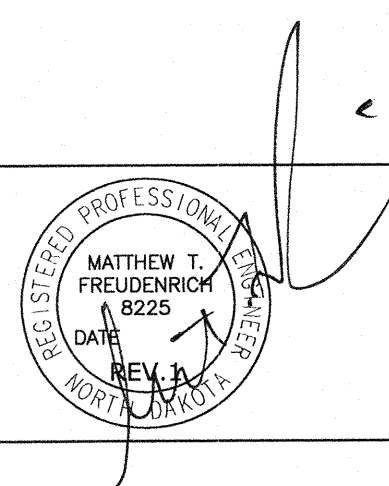

RELEASED TO/FOR	A	B	C	0	1	2	3

**BARR**  
 Project Office:  
 BARR ENGINEERING CO.  
 4700 WEST 77TH STREET  
 MINNEAPOLIS, MN.  
 55435-4803  
 Corporate Headquarters:  
 Minneapolis, Minnesota  
 Ph: 1-800-632-2277  
 Fax: (952) 832-2601  
 www.barr.com

Scale	AS SHOWN
Date	05/20/11
Drawn	DMD
Checked	JXB
Designed	CAD
Approved	JXB

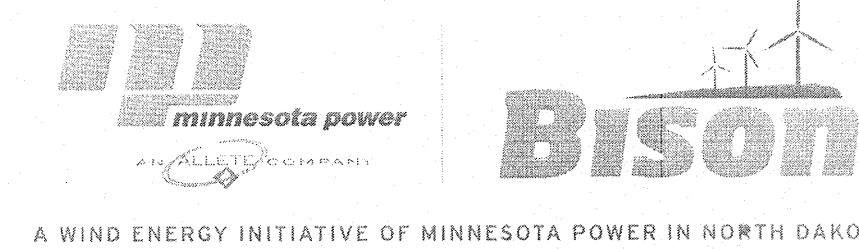

BISON 2 WIND PROJECT  
 MORTON & OLIVER COUNTIES, NORTH DAKOTA  
 PLAN AND PROFILE  
 CRANE PATH FROM ALIGNMENT L1 TO M

EXTERNAL REFERENCE: 34331007-BASE-C3D-DESIGN-ROADS-AS-BUILT.DWG	
BARR PROJECT No.	34/33-1007
CLIENT PROJECT No.	
DWG. No.	C-30
REV. No.	1