


BISON 3 WIND PROJECT

MORTON AND OLIVER COUNTIES, NORTH DAKOTA

SHEET INDEX

SHEET NO.	TITLE
C-01.....	Project Location and Sheet Index
C-02.....	Overall Site Plan
C-03.....	Access Roads and Turbine Layout Sections and Details
C-04.....	Miscellaneous Sections and Details
C-05.....	Erosion Control Sections and Details
C-06.....	Specifications
C-07.....	Plan and Profile Alignment A Sta. 0+00 to 6+15 Plan and Profile Alignment MET Sta. 0+00 to 3+67 Plan and Profile Crane Path From A to B1
C-08.....	Plan and Profile Alignment B1 Sta. 0+00 to 52+94 Plan and Profile Crane Path From C1 to B2
C-09.....	Plan and Profile Alignment B2 Sta. 0+00 to 49+00 Plan and Profile Alignment B3 Sta. 0+00 to 6+71
C-10.....	Plan and Profile Alignment C1 Sta. 0+00 to 38+00 Plan and Profile Alignment C5 Sta. 0+00 to 6+06
C-11.....	Plan and Profile Alignment C1 Sta. 38+00 to 84+86 Plan and Profile Alignment C4 Sta. 0+00 to 12+80
C-12.....	Plan and Profile Alignment C2 Sta. 0+00 to 31+50 Plan and Profile Alignment C3 Sta. 0+00 to 6+43
C-13.....	Plan and Profile Alignment D1 Sta. 0+00 to 30+00 Plan and Profile Alignment D4 Sta. 0+00 to 6+32
C-14.....	Plan and Profile Alignment D1 Sta. 30+00 to 75+99 Plan and Profile Alignment D2 Sta. 0+00 to 30+17 Plan and Profile Alignment D3 Sta. 0+00 to 6+38
C-15.....	Plan and Profile Alignment E1 Sta. 0+00 to 20+00
C-16.....	Plan and Profile Crane Path From C1 to E1 Plan and Profile Alignment E1 Sta. 0+00 to 50+56 Plan and Profile Alignment E2 Sta. 0+00 to 10+33
C-17.....	Plan and Profile Alignment F1 Sta. 0+00 to 35+81 Plan and Profile Alignment F2 Sta. 0+00 to 13+00
C-18.....	Plan and Profile Crane Path From J1 to F1 Plan and Profile Alignment F3 Sta. 0+00 to 5+27 Plan and Profile Alignment K Sta. 0+00 to 4+32 Plan and Profile Crane Path From F3 to K
C-19.....	Plan and Profile Alignment G Sta. 0+00 to 8+94 Plan and Profile Crane Path From H to J1
C-20.....	Plan and Profile Alignment H Sta. 0+00 to 8+52 Plan and Profile Alignment I Sta. 0+00 to 6+60 Plan and Profile Alignment J2 Sta. 0+00 to 7+55 Plan and Profile Crane Path From H to I
C-21.....	Plan and Profile Crane Path From G to H
C-22.....	Plan and Profile Alignment J1 Sta. 0+00 to 58+20 Plan and Profile Alignment L1 Sta. 0+00 to 56+00
C-23.....	Plan and Profile Alignment L1 Sta. 56+00 to 69+05 Plan and Profile Alignment L2 Sta. 0+00 to 11+34 Plan and Profile Alignment L5 Sta. 0+00 to 20+41
C-24.....	Plan and Profile Alignment L3 Sta. 0+00 to 19+60 Plan and Profile Alignment L4 Sta. 0+00 to 7+29
C-25.....	Plan and Profile Alignment M1 Sta. 0+00 to 38+17 Plan and Profile Crane Path From M1 to L1
C-26.....	Plan and Profile Crane Path From M1 to L1
C-27.....	Plan and Profile Crane Path From M1 to L1
C-28.....	Plan and Profile Crane Path From M1 to L1
C-29.....	Plan and Profile Crane Path From M1 to L1
C-30.....	Plan and Profile Crane Path From M1 to L1
C-31.....	Plan and Profile Crane Path From M1 to L1

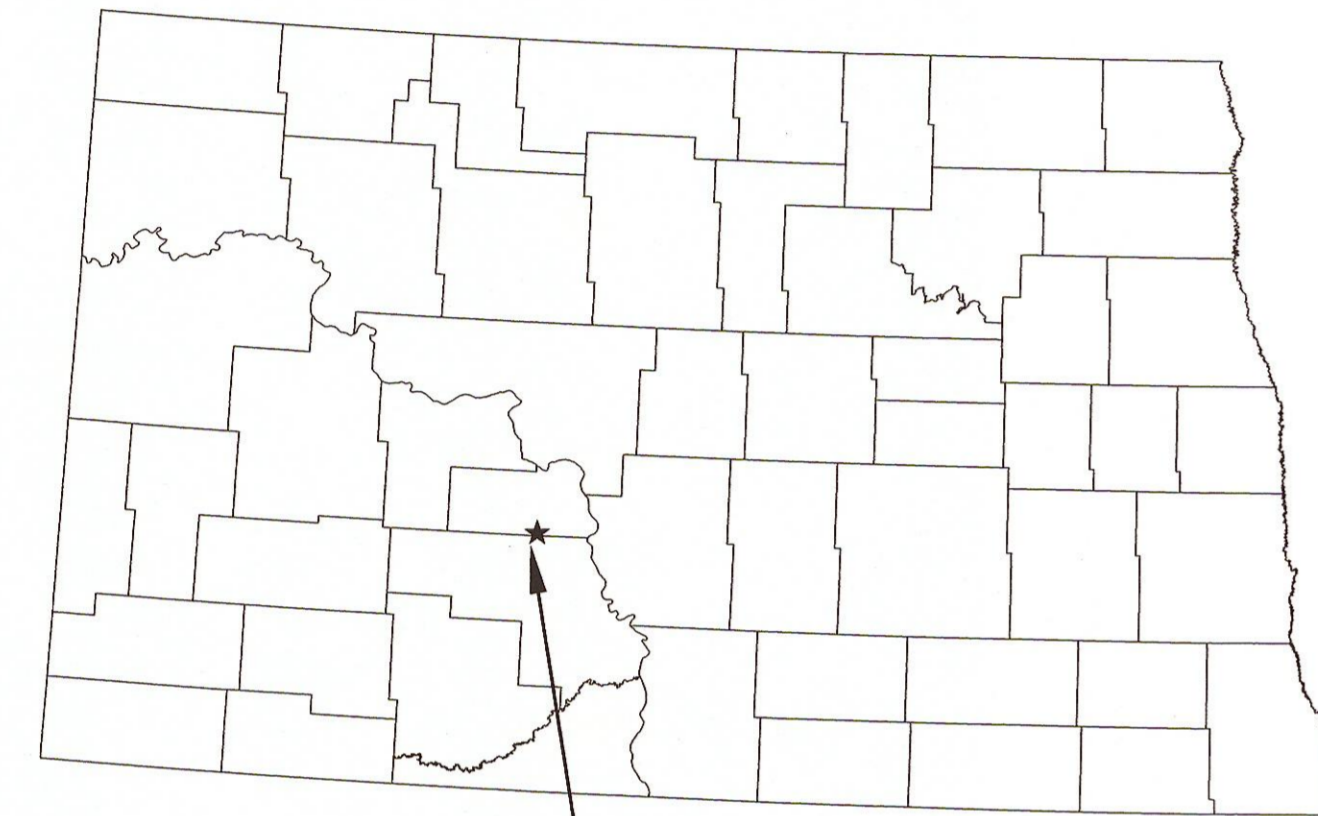


PROJECT LOCATION

LOCATION MAP

LEGEND

TURBINE ACCESS ROAD	
CRANE PATH	
TURBINE NUMBER AND LOCATION	
CULVERT NUMBER AND LOCATION	
SECTION LINE	
QUARTER SECTION LINE	
LOT LINE	
EASEMENT	
CONSTRUCTION EASEMENT	
OVERHEAD ELECTRIC	
EXISTING 10ft MAJOR CONTOURS	
EXISTING 2ft MINOR CONTOURS	
PROPOSED 10ft MAJOR CONTOURS	
PROPOSED 2ft MINOR CONTOURS	
COLLECTION LINE	
JUNCTION BOX	

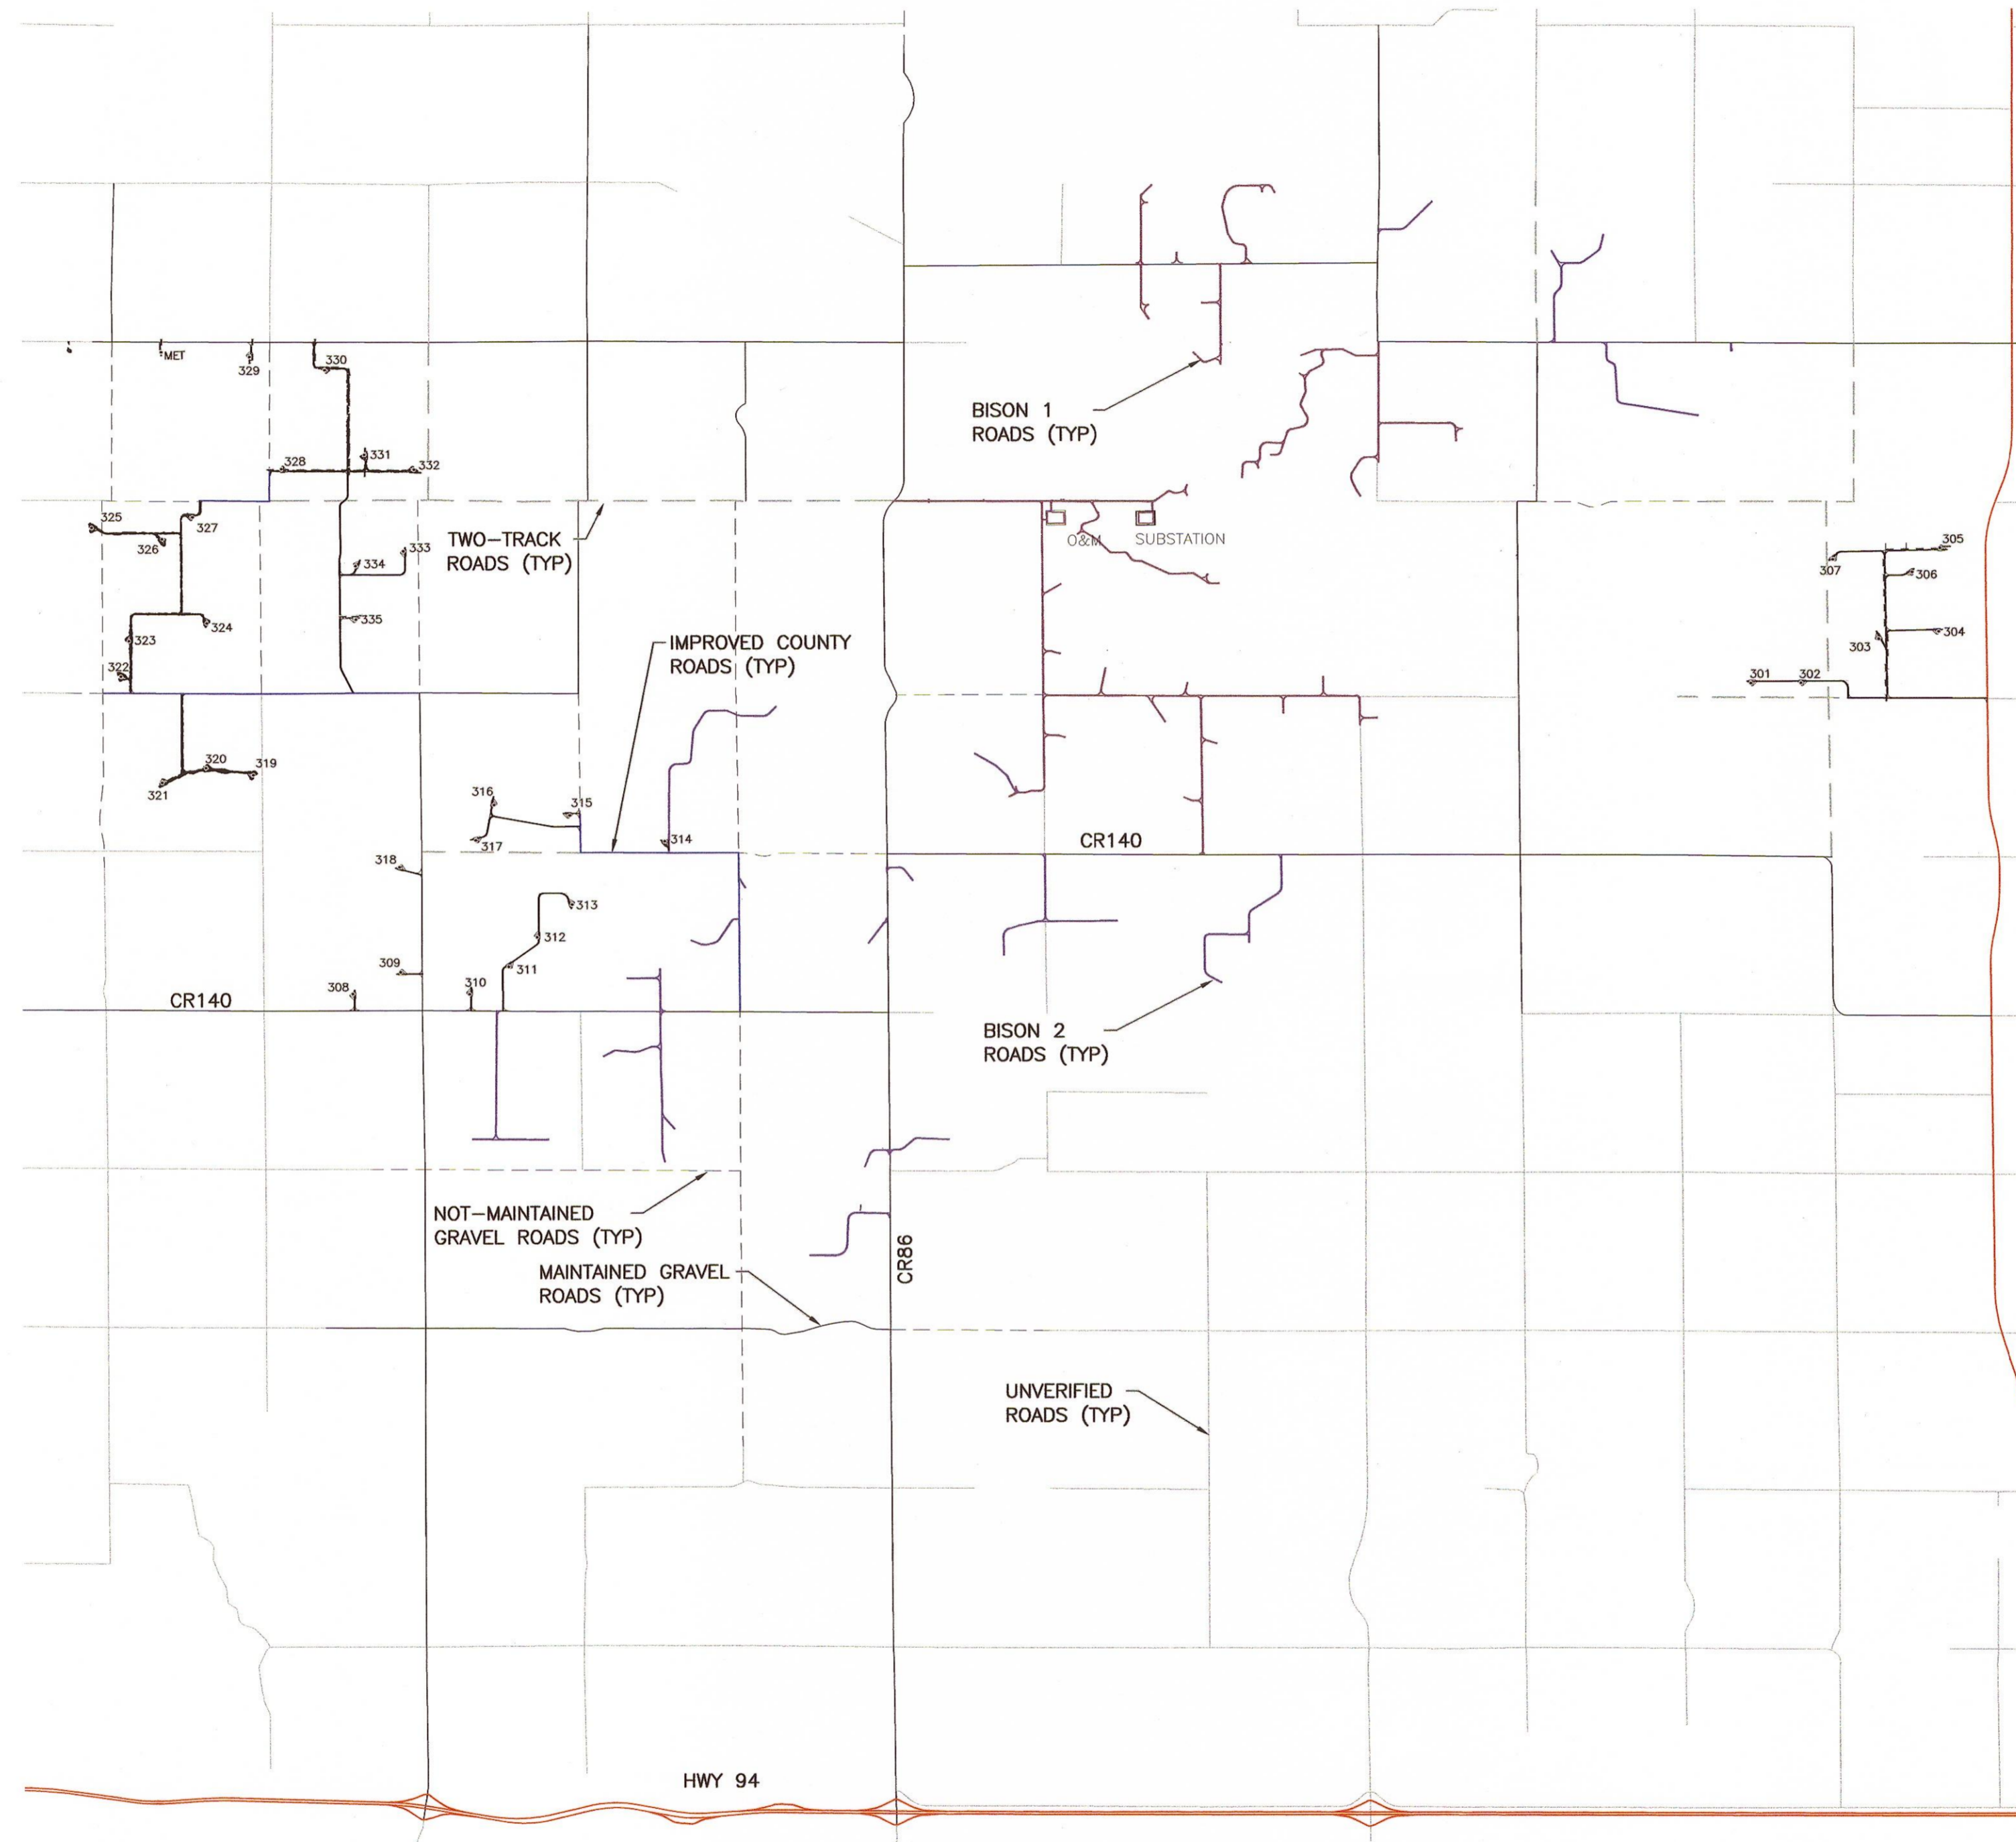


VICINITY MAP

EXTERNAL REFERENCE:

- 34301006-BASE-C3D-DESIGN-ROADS-BISON 3-AS BUILT.DWG

NO.	BY	CHK.	APP.	DATE	REVISION DESCRIPTION
A	KKB	CAD	JXB	07/15/11	60 PERCENT SUBMITTAL
B	CAD	CAD	JXB	09/02/11	90 PERCENT SUBMITTAL
0	CAD	CAD	JXB	09/30/11	ISSUED FOR CONSTRUCTION
1	NJG			12/13/12	CONSTRUCTION REVISIONS, NO CHANGES

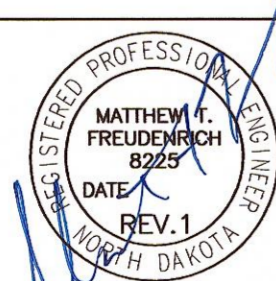

CLIENT	07/15/11	09/02/11					
BID							
CONSTRUCTION							
PERMITTING							
RECORD							
RELEASED TO/FOR	A	B	C	0	1	2	3
	DATE RELEASED						

BARR
Corporate Headquarters:
Minneapolis, Minnesota
Ph: 1-800-632-2277
Ph: (952) 832-2601
www.barr.com

Project Office:
BARR ENGINEERING CO.
4700 WEST 77TH STREET
MINNEAPOLIS, MN.
55435-4803
Ph: 1-800-632-2277
Fax: (952) 832-2601
www.barr.com

Scale	AS SHOWN
Date	07/05/11
Drawn	KKB
Checked	JXB
Designed	CAD
Approved	JXB

A WIND ENERGY INITIATIVE OF MINNESOTA POWER IN NORTH DAKOTA

BISON 3 WIND PROJECT
MORTON & OLIVER COUNTIES, NORTH DAKOTA

PROJECT LOCATION AND
SHEET INDEX

BARR PROJECT No.	34/30-1006
CLIENT PROJECT No.	
DWG. No.	C-01
REV. No.	1