
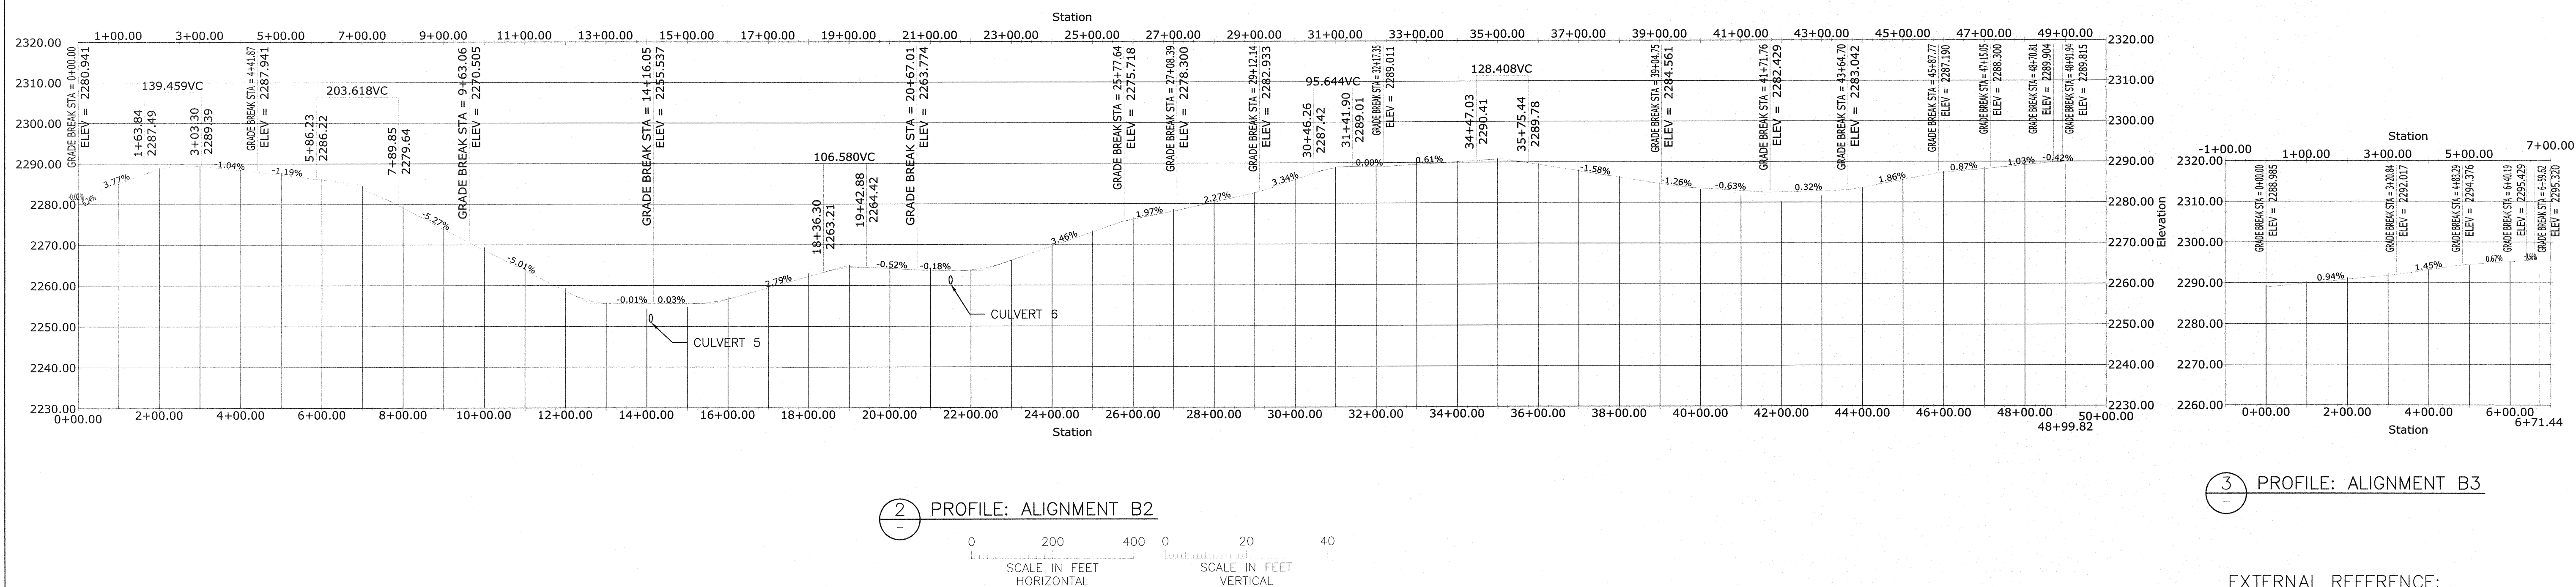


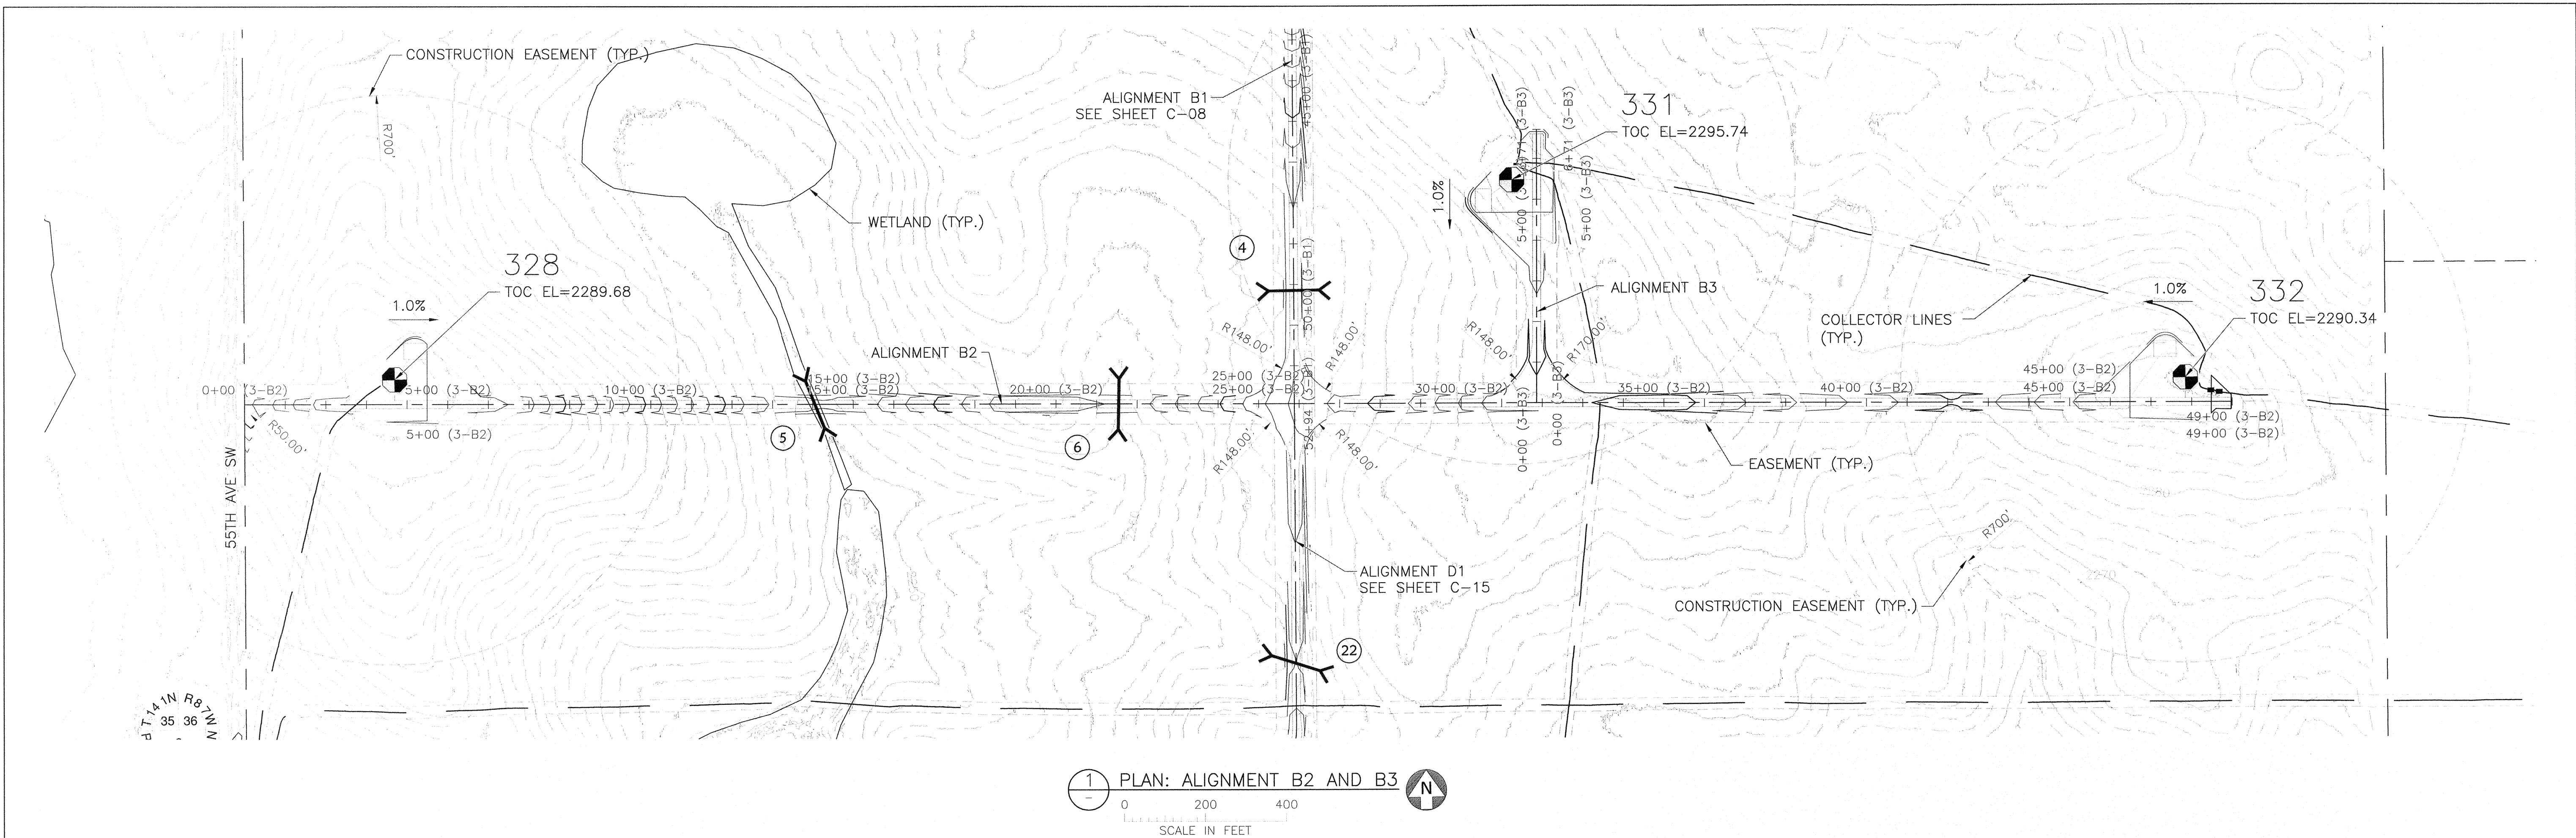

EXTERNAL REFERENCE:

- 34301006-BASE-C3D-DESIGN-ROADS-BISON 3-AS BUILT.DWG

A KKB CAD JXB 07/15/11 60 PERCENT SUBMITTAL				CLIENT 07/15/1109/02/11				Project Office: BARR ENGINEERING CO. 4700 WEST 77TH STREET MINNEAPOLIS, MN. 55435-4803				Scale AS SHOWN				BISON 3 WIND PROJECT				BARR PROJECT No. 34/30-1006			
B CAD CAD JXB 09/02/11 90 PERCENT SUBMITTAL								Corporate Headquarters: Minneapolis, Minnesota Ph: 1-800-632-2277 Fax: (652) 832-2601 www.barr.com				Date 07/05/11				MORTON & OLIVER COUNTIES, NORTH DAKOTA				CLIENT PROJECT No.			
0 CAD CAD JXB 09/30/11 ISSUED FOR CONSTRUCTION												Checked JXB				PLAN AND PROFILE - ALIGNMENTS B2 STA. 0+00 TO 49+00 - B3 STA. 0+00 TO 6+71				DWG. No. C-10			
1 NJG 2/27/13 CONSTRUCTION REVISIONS												Designed CAD								REV. No. 1			
NO. BY CHK APP. DATE REVISION DESCRIPTION				RELEASED TO/FOR A B C 0 1 2 3				DATE RELEASED				Approved JXB											