




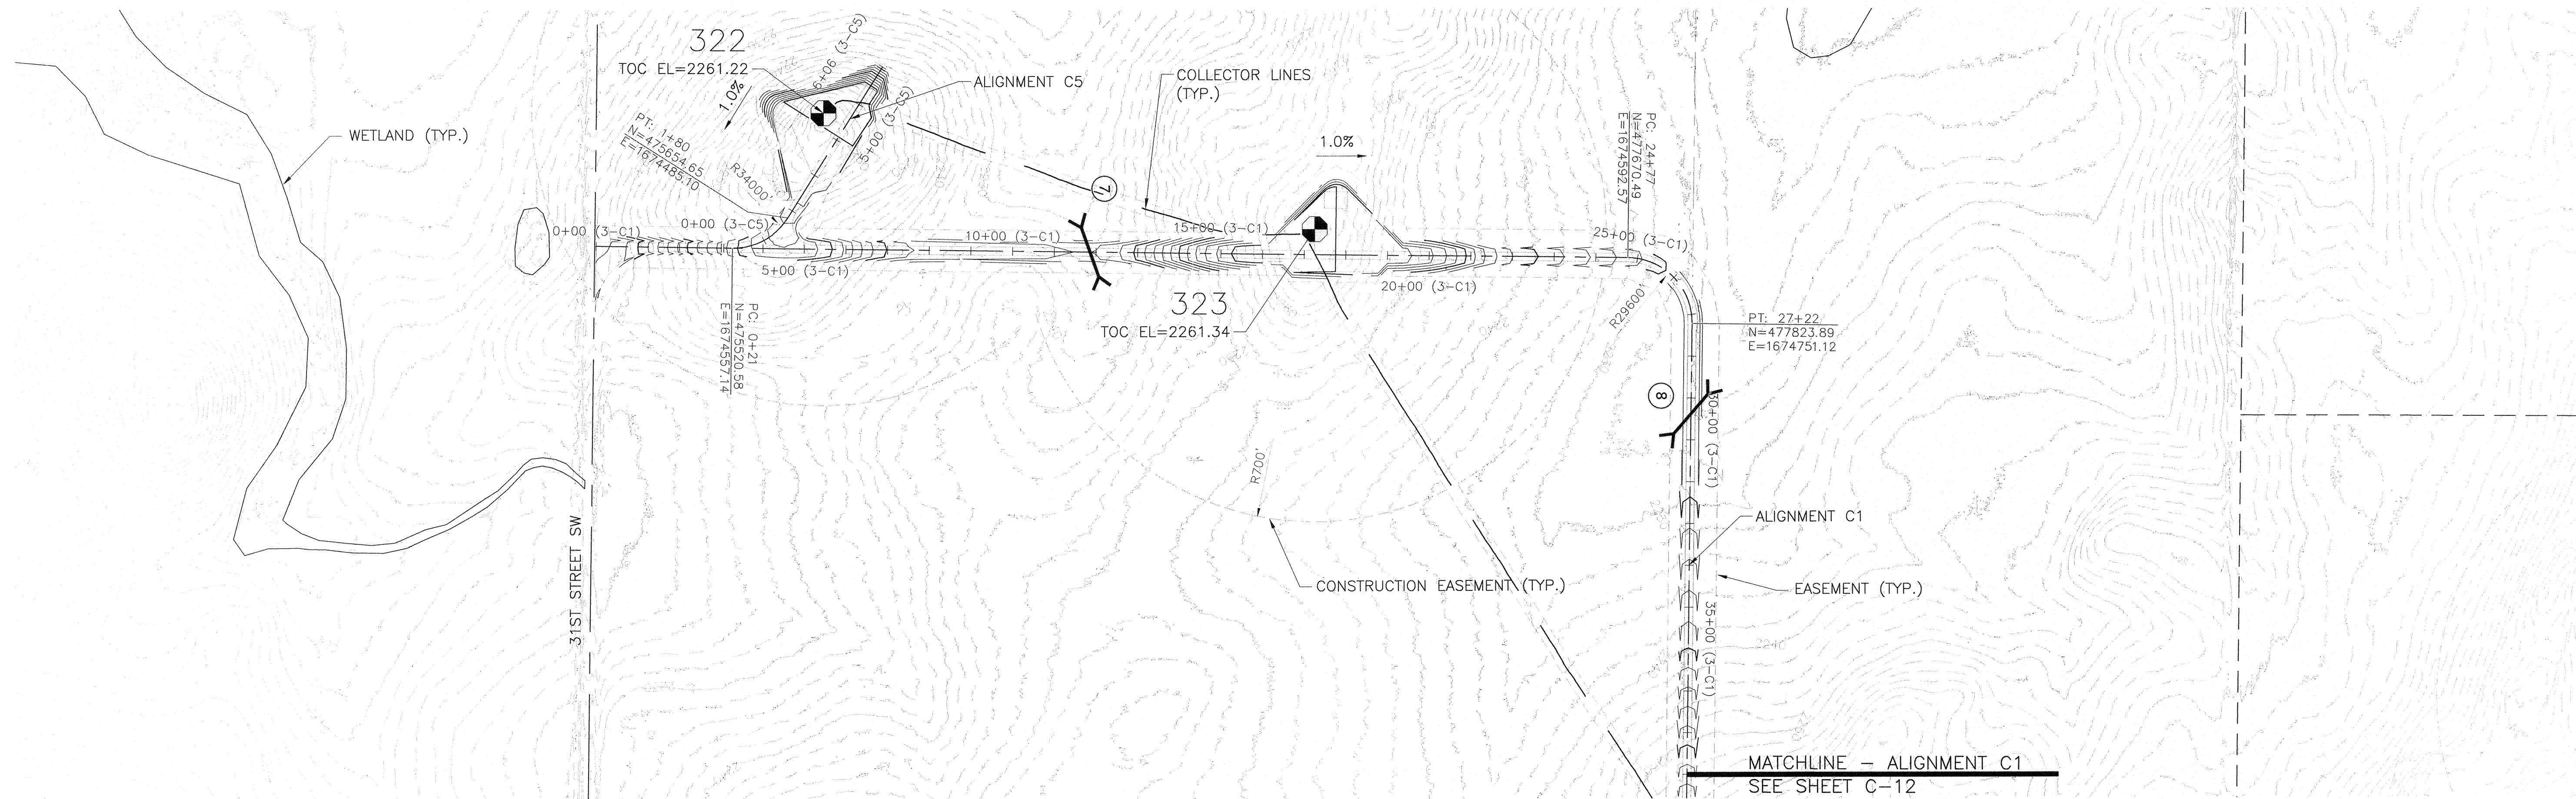

1 PLAN: ALIGNMENT C1 AND C5

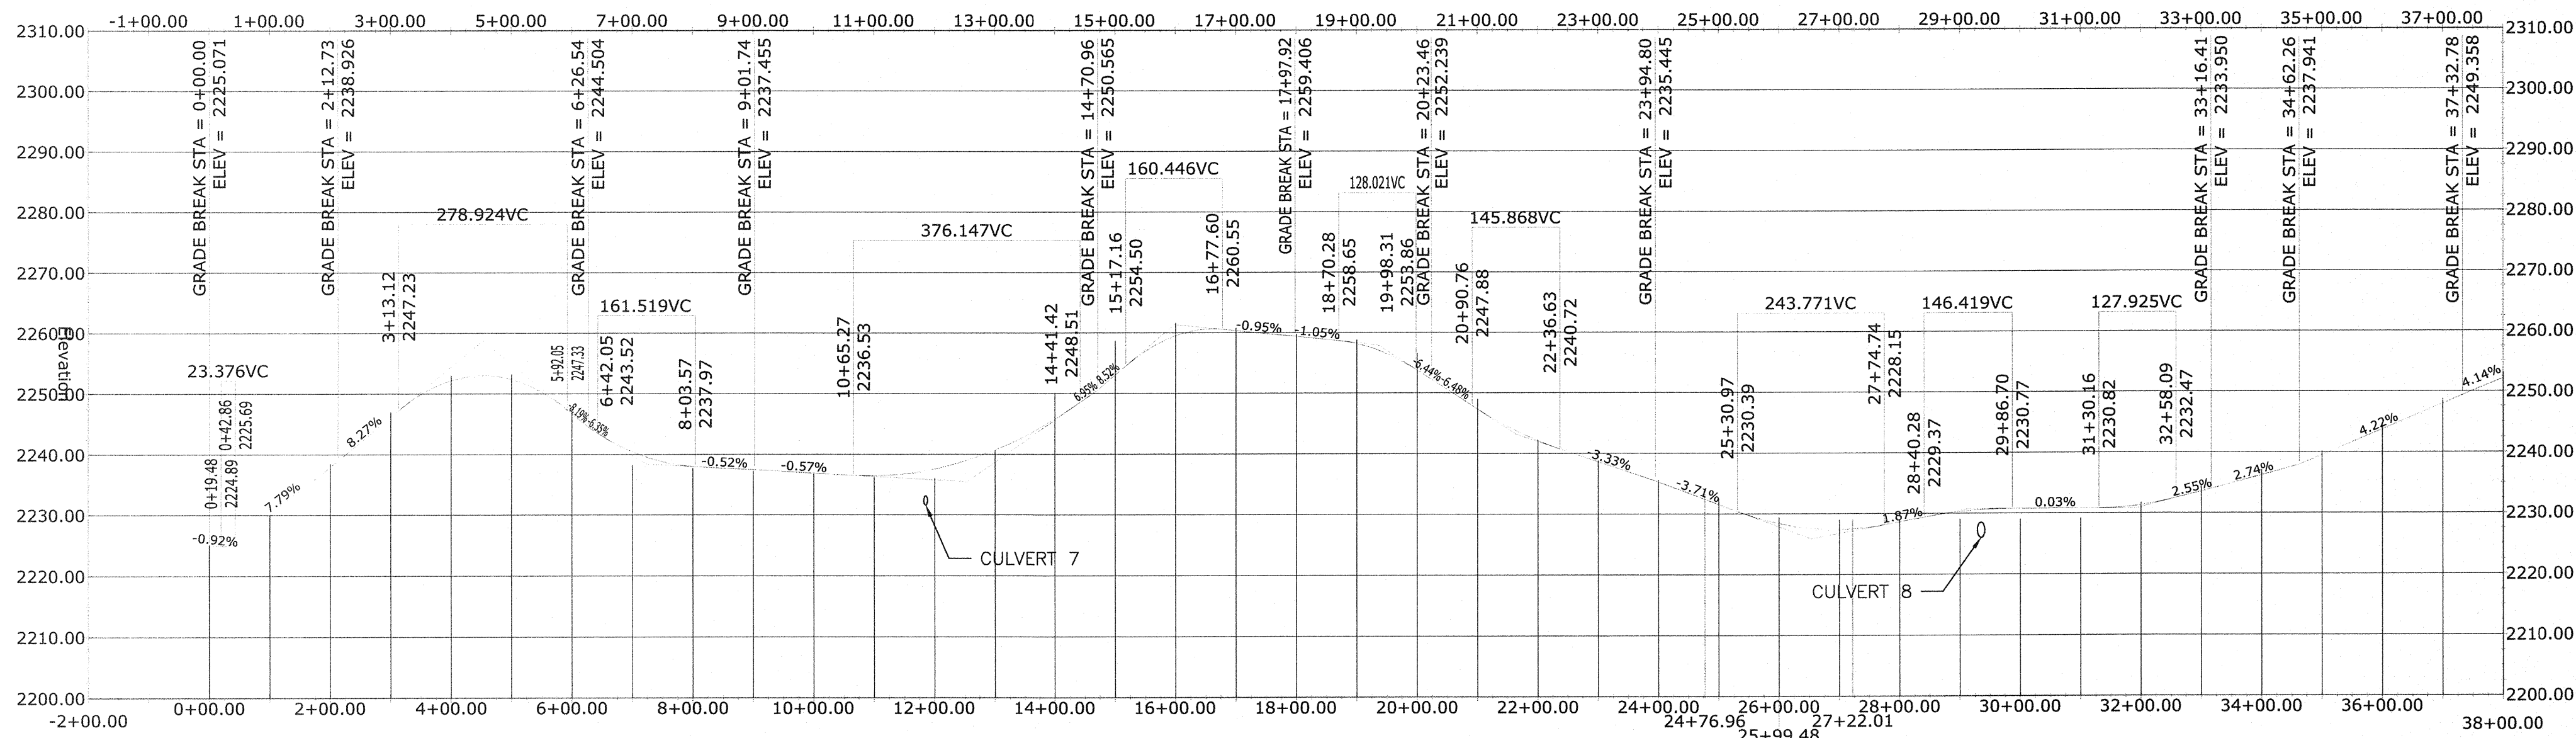


2 PROFILE: ALIGNMENT C1

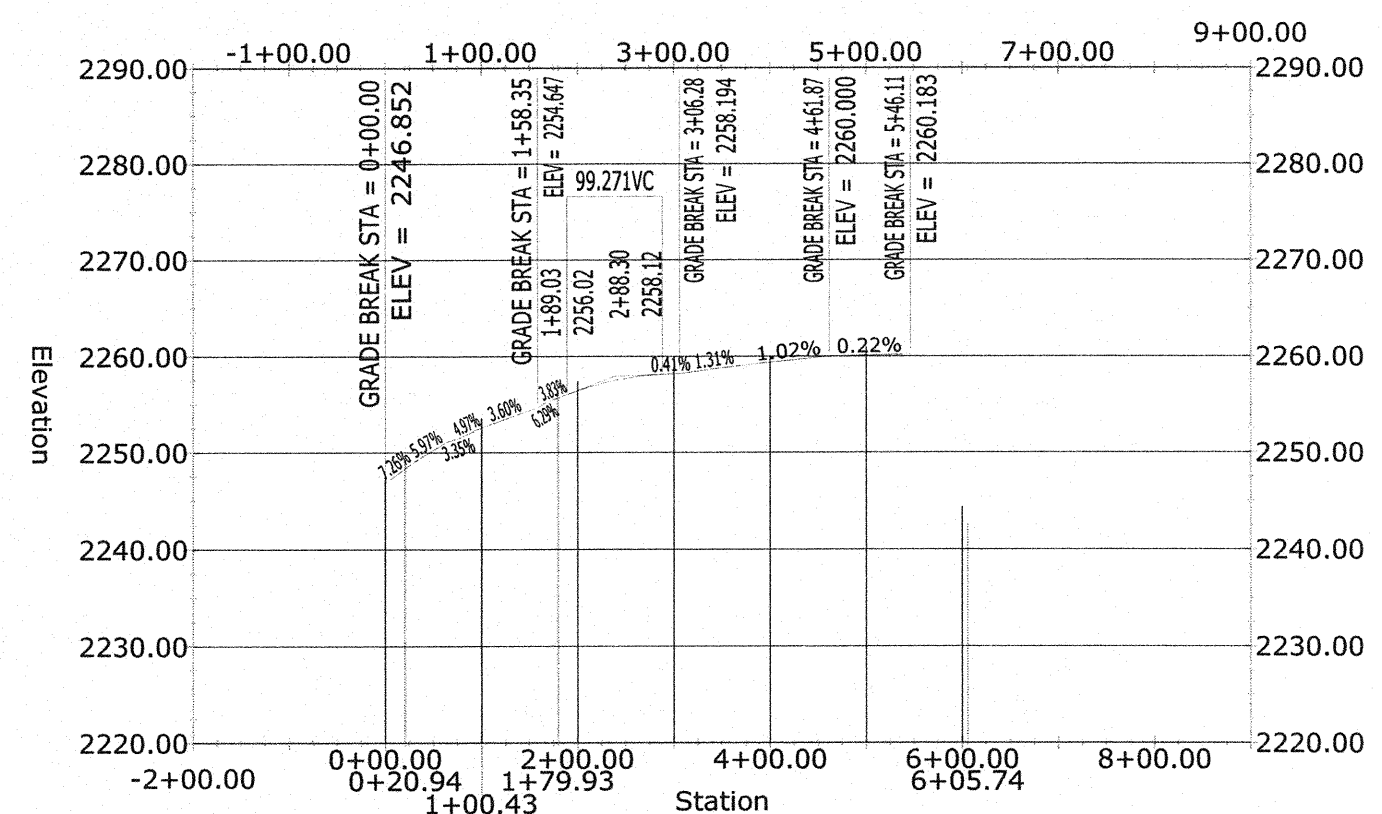

3 PROFILE: ALIGNMENT C5

EXTERNAL REFERENCE:
• 34301006-BASE-C3D-DESIGN-ROADS-BISON 3-AS BUILT.DWG


A	KKB	CAD	JXB	07/15/11	60 PERCENT SUBMITTAL
B	CAD	CAD	JXB	09/02/11	90 PERCENT SUBMITTAL
0	CAD	CAD	JXB	09/30/11	ISSUED FOR CONSTRUCTION
1	NJC			2/27/13	CONSTRUCTION REVISIONS
REVISION DESCRIPTION					
NO.	BY	CHK	APP.	DATE	REVISION DESCRIPTION

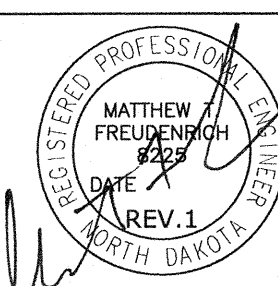

CLIENT	07/15/11	09/02/11			
BID					
CONSTRUCTION			09/30/11		
PERMITTING					
RECORD					
RELEASED TO/FOR	A	B	C	0	1 2 3
DATE RELEASED					

Project Office:
BARR ENGINEERING CO.
4700 WEST 77TH STREET
MINNEAPOLIS, MN.
55435-4803
Ph: 1-800-632-2277
Fax: (952) 632-2601
www.barr.com

Scale	AS SHOWN
Date	07/05/11
Drawn	KKB
Checked	JXB
Designed	CAD
Approved	JXB

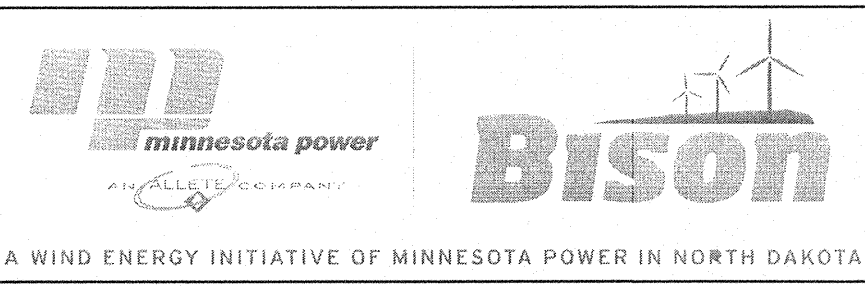

BISON 3 WIND PROJECT
MORTON & OLIVER COUNTIES, NORTH DAKOTA
PLAN AND PROFILE - ALIGNMENT C1 STA.
0+00 TO 38+00 - C5 STA. 0+00 TO 6+06

BARR PROJECT No.	34/30-1006
CLIENT PROJECT No.	
DWG. No.	C-11
REV. No.	0