



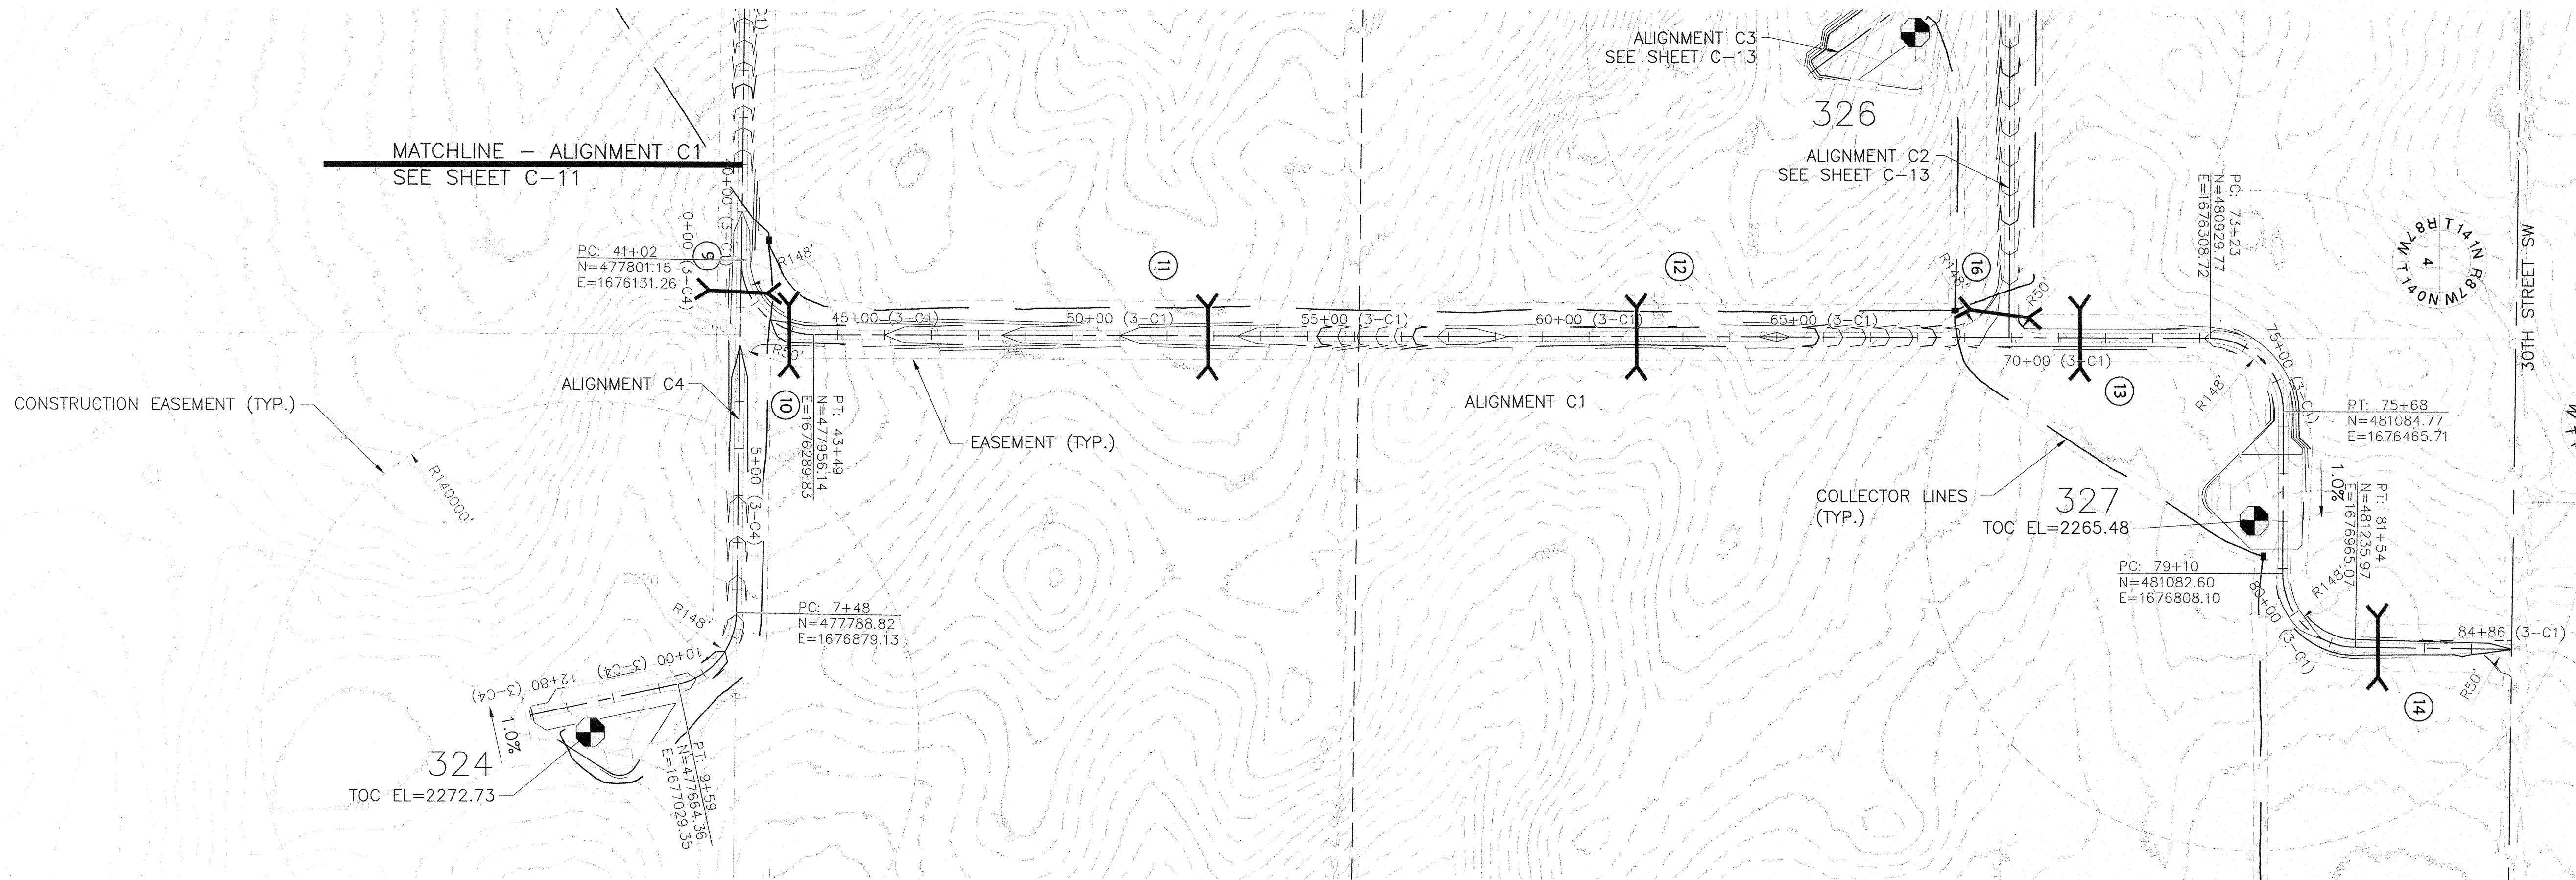

1 PLAN: ALIGNMENT C1 AND C4

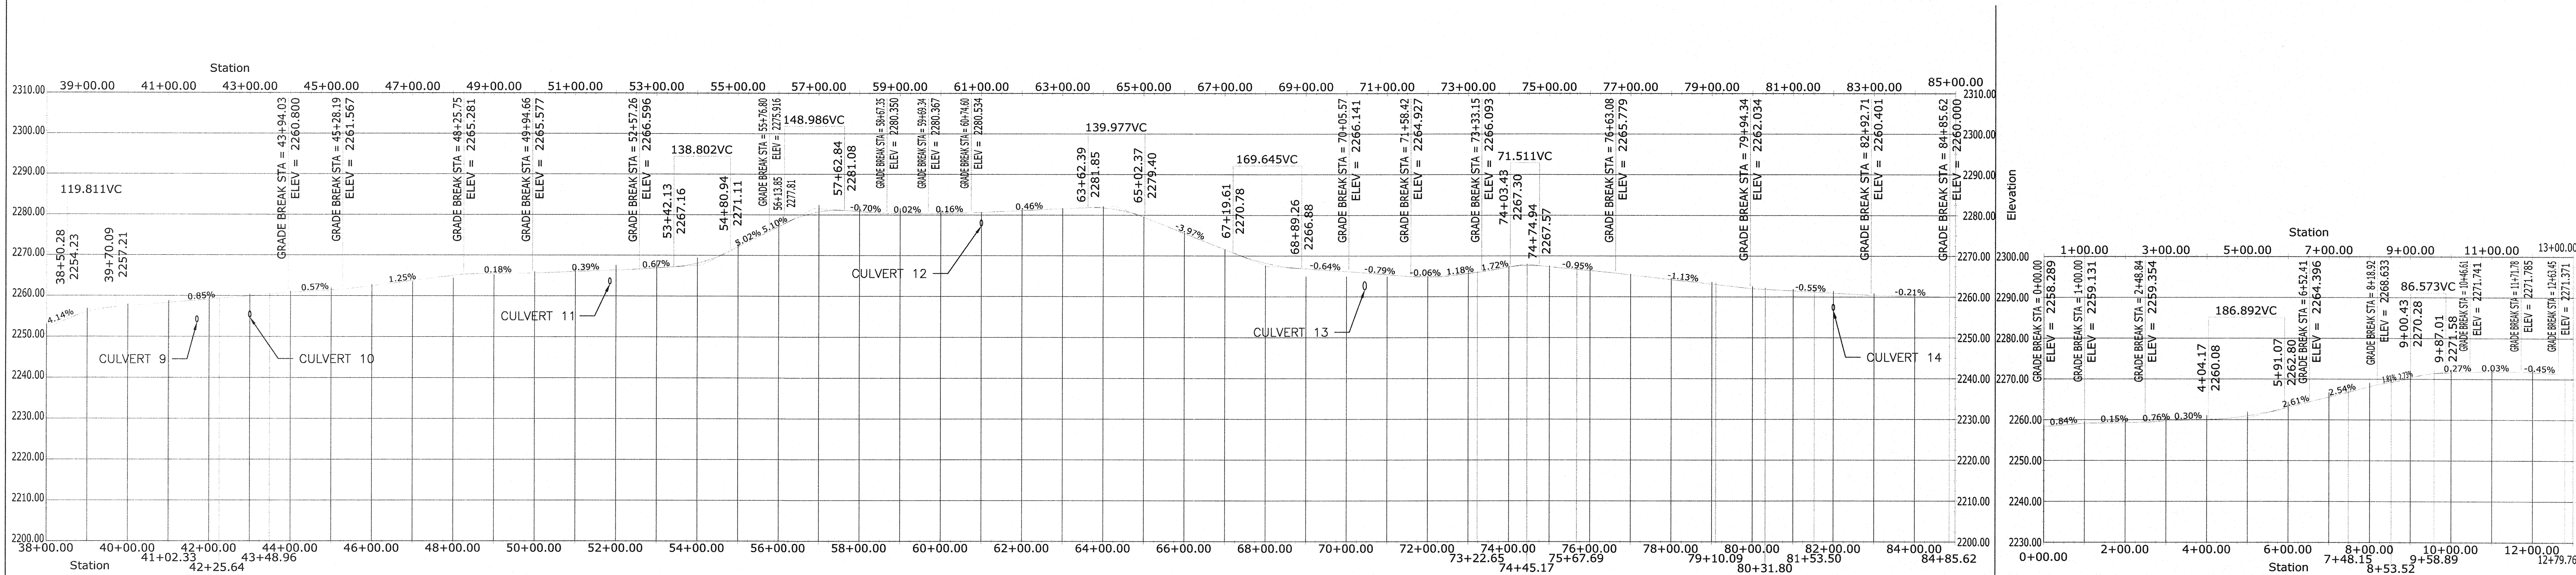


2 PROFILE: ALIGNMENT C1

3 PROFILE: ALIGNMENT C4

EXTERNAL REFERENCE:
• 34301006-BASE-C3D-DESIGN-ROADS-BISON 3-AS BUILT.DWG

A	KKK	CAD	JXB	07/15/11	60 PERCENT SUBMITTAL
B	CAD	CAD	JXB	09/02/11	90 PERCENT SUBMITTAL
C	CAD	CAD	JXB	09/30/11	ISSUED FOR CONSTRUCTION
1	NUG			2/27/13	CONSTRUCTION REVISIONS
REVISION DESCRIPTION					
NO.	BY	CHK.	APP.	DATE	REVISION DESCRIPTION

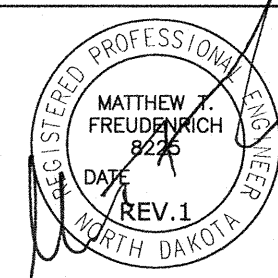

CLIENT	07/15/11	09/02/11					
BID							
CONSTRUCTION							
PERMITTING							
RECORD							
RELEASED TO/FOR	A	B	C	0	1	2	3
DATE RELEASED							

Project Office:
BARR ENGINEERING CO.
4700 WEST 77TH STREET
MINNEAPOLIS, MN.
55435-4803
Ph: 1-800-632-2277
Fax: (952) 632-2601
www.barr.com

Scale	AS SHOWN
Date	07/05/11
Drawn	KKK
Checked	JXB
Designed	CAD
Approved	JXB



A WIND ENERGY INITIATIVE OF MINNESOTA POWER IN NORTH DAKOTA

BISON 3 WIND PROJECT
MORTON & OLIVER COUNTIES, NORTH DAKOTA
PLAN AND PROFILE - ALIGNMENTS C1 STA.
38+00 TO 84+86 - C4 STA 0+00 TO 12+80

BARR PROJECT No.	34/30-1006
CLIENT PROJECT No.	
DWG. No.	C-12
REV. No.	1