
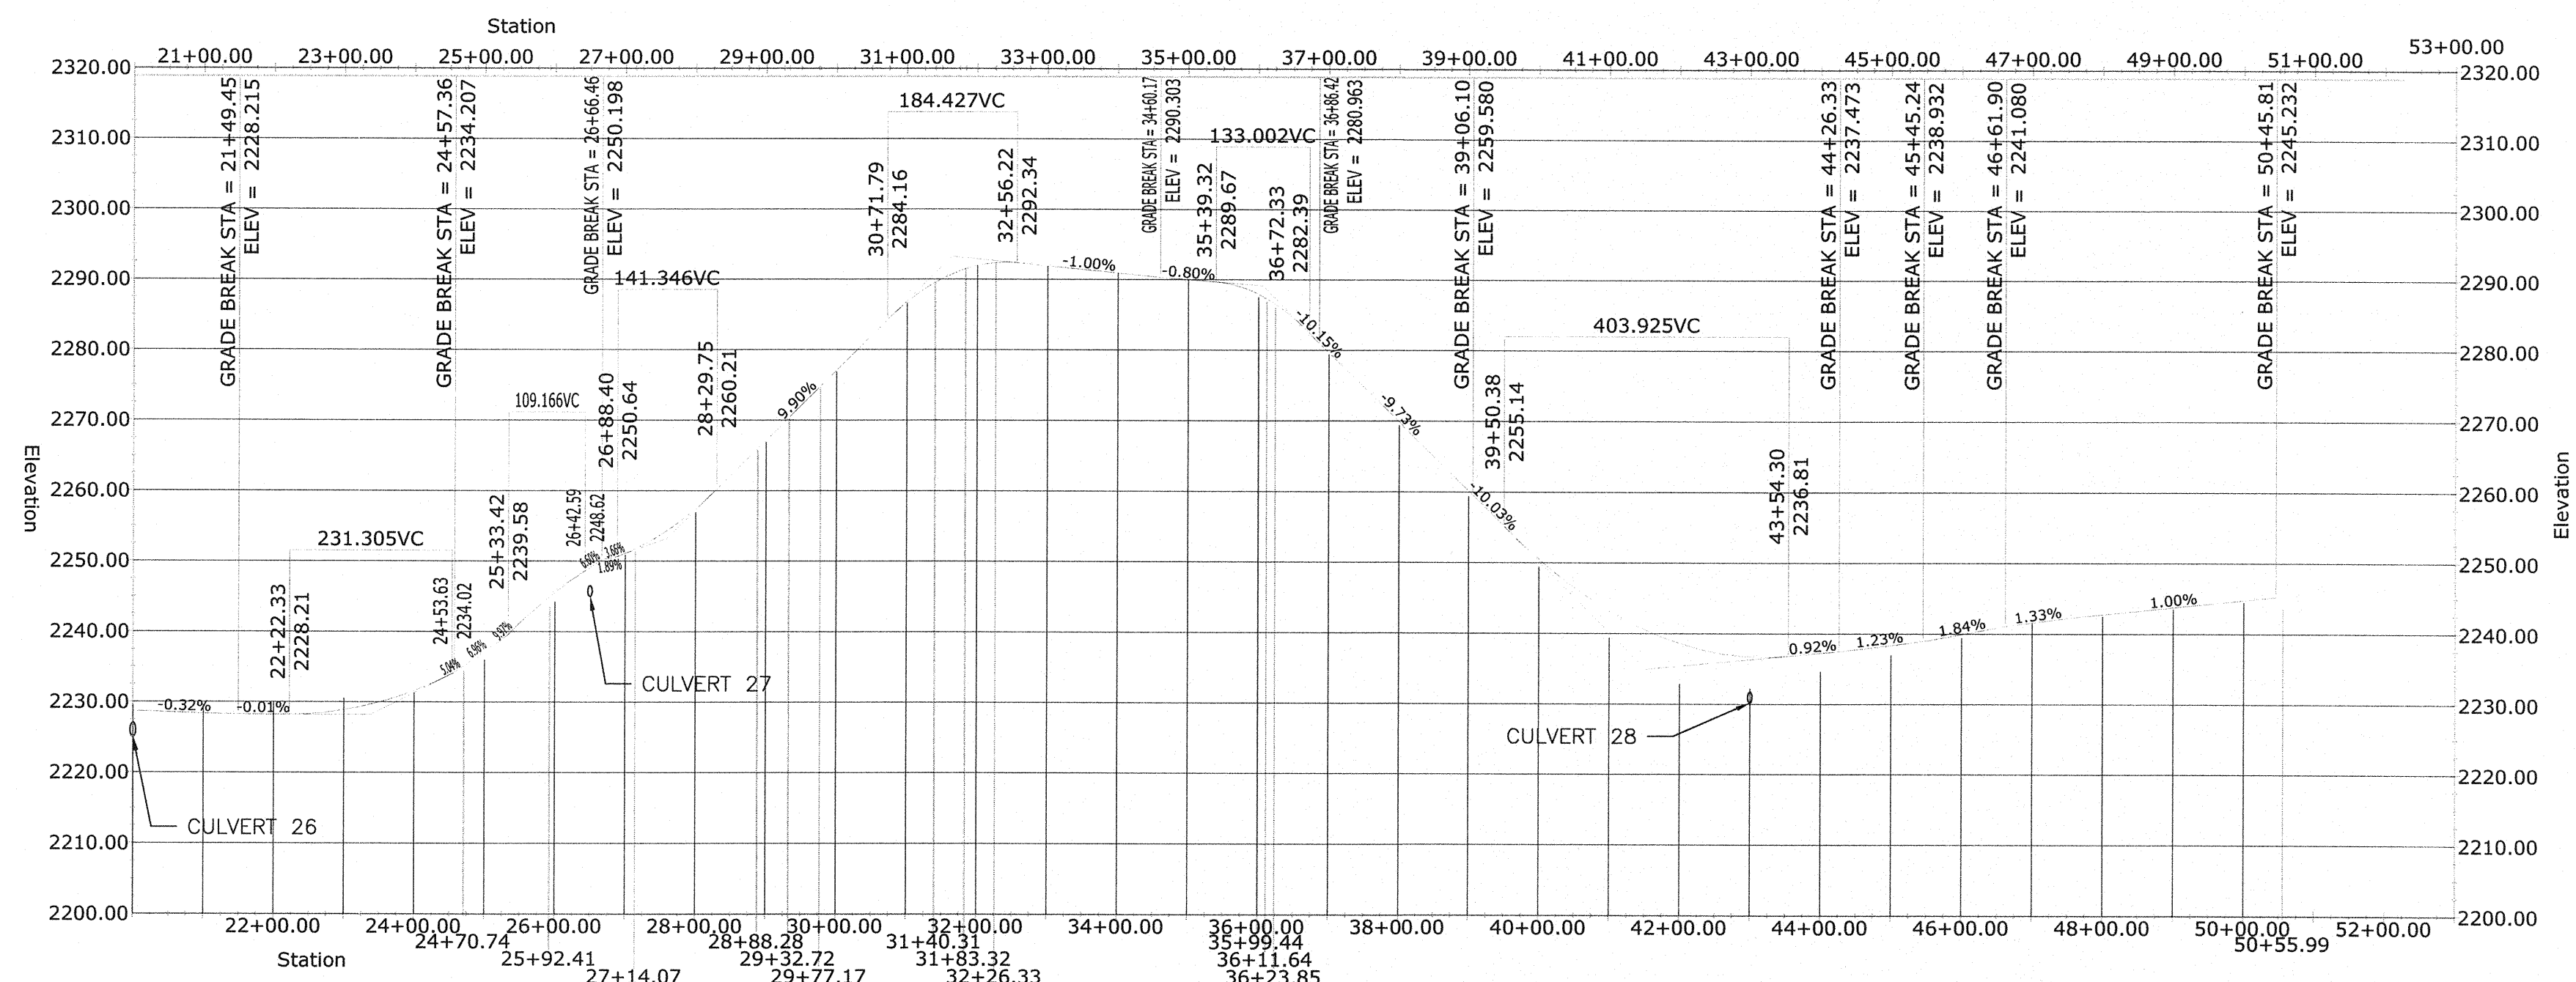
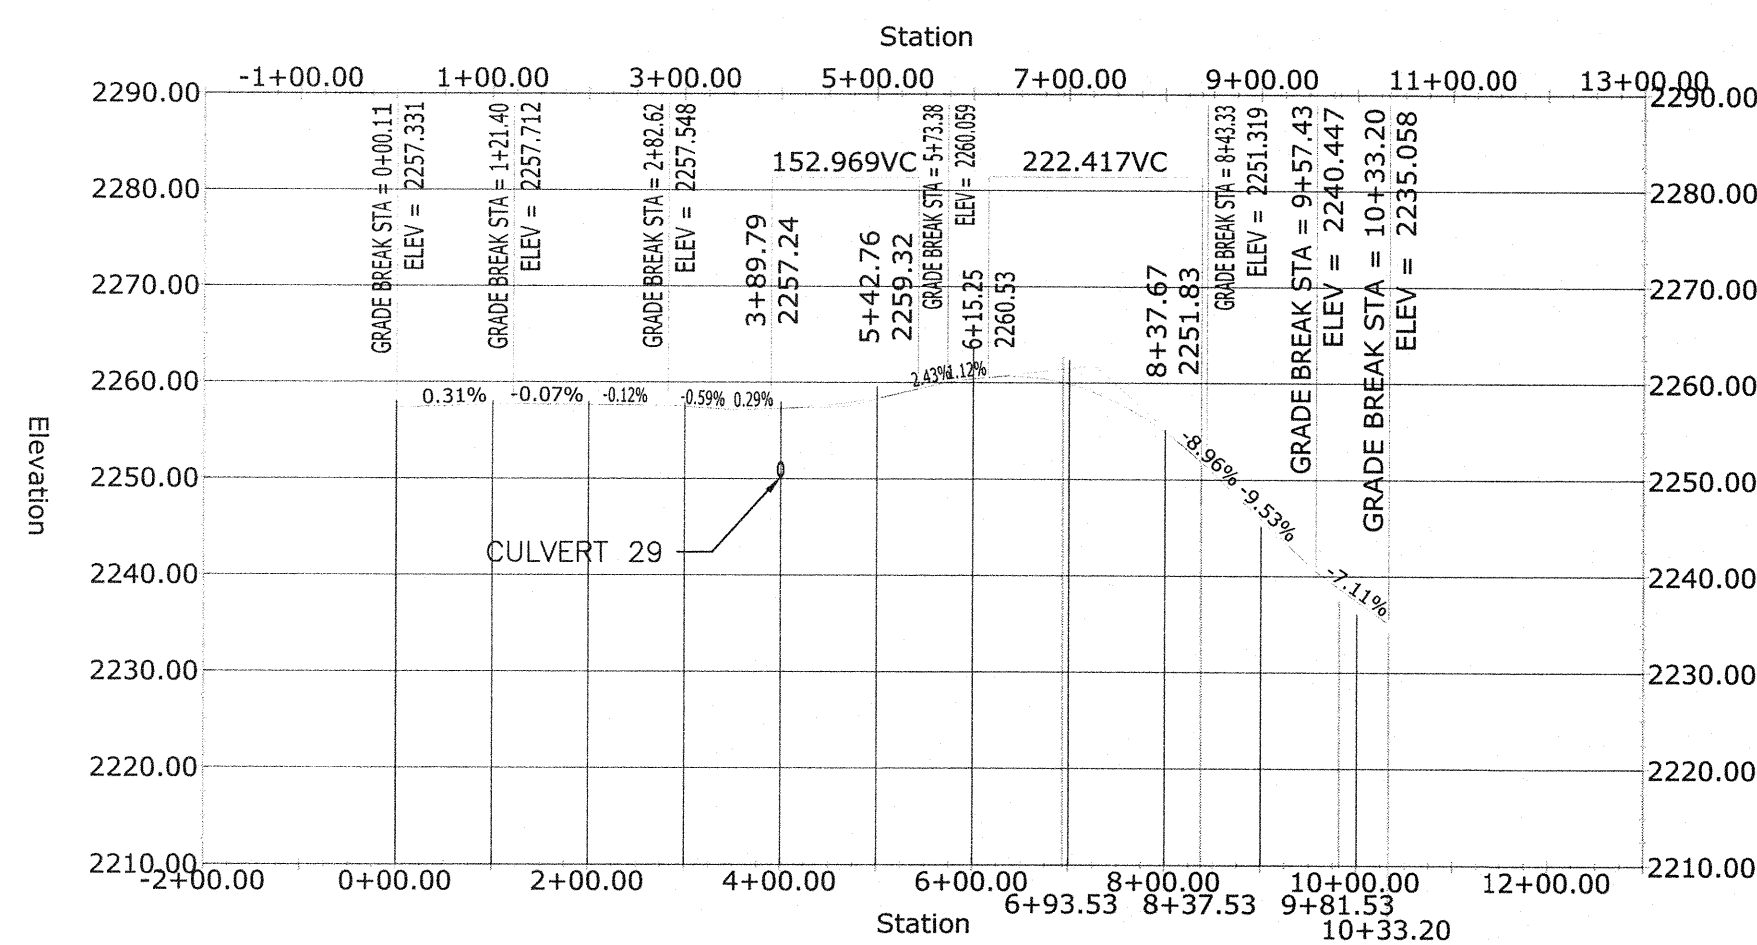


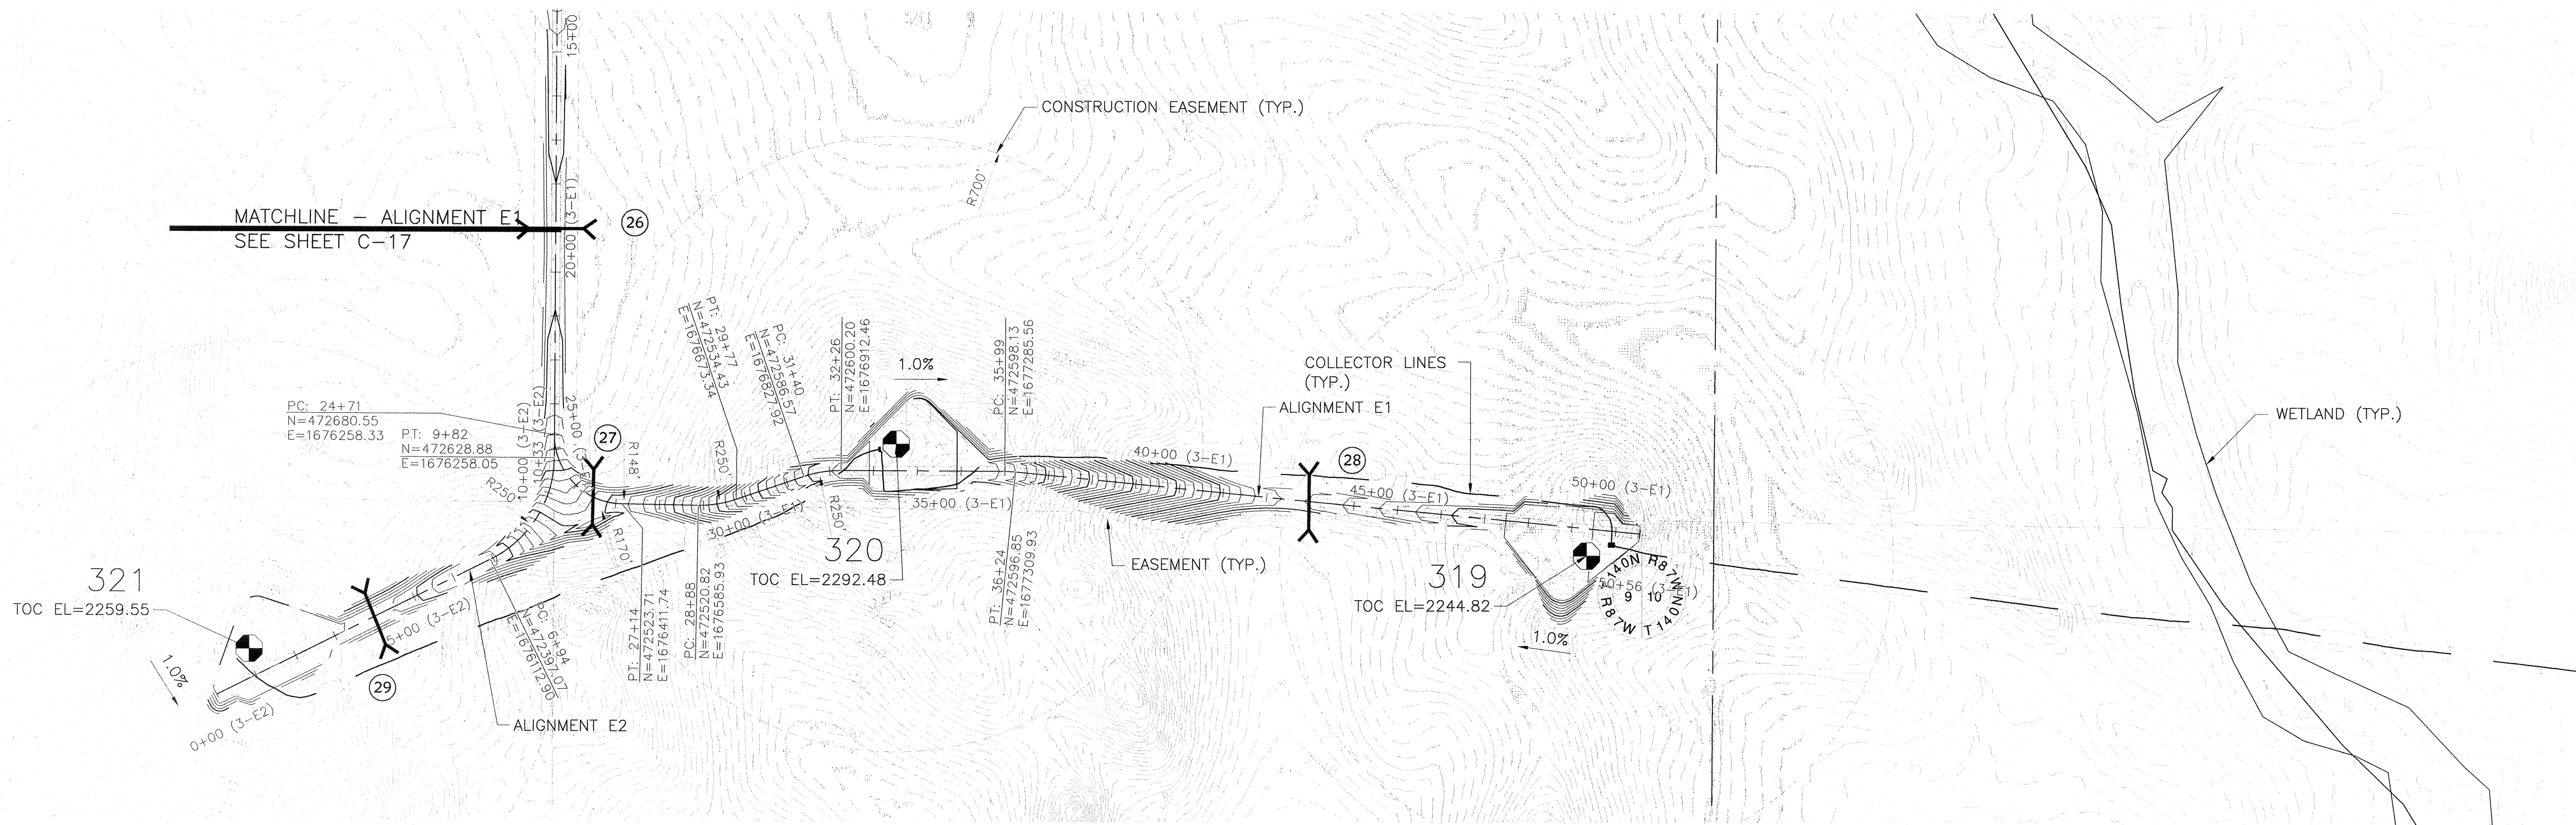

EXTERNAL REFERENCE:

- 34301006-BASE-C3D-DESIGN-ROADS-BISON 3-AS BUILT.DWG

NO.	BY	CHK	APP.	DATE	REVISION DESCRIPTION
1	KKB	CAD	JXB	07/15/11	60 PERCENT SUBMITTAL
2	CAD	CAD	JXB	09/02/11	90 PERCENT SUBMITTAL
3	CAD	CAD	JXB	09/30/11	ISSUED FOR CONSTRUCTION
4	NUJ			2/27/13	CONSTRUCTION REVISIONS

REGISTERED PROFESSIONAL ENGINEER
MATTHEW T. FREUDENBERG
STATE OF NORTH DAKOTA
DATE: 08/05/11
REV. 1

CLIENT	07/15/11	09/02/11					
BID							
CONSTRUCTION				08/30/11			
PERMITTING							
RECORD							
RELEASED TO/FOR	A	B	C	0	1	2	3
DATE RELEASED							

BARR
Corporate Headquarters:
Minneapolis, Minnesota
Ph: 1-800-632-2277

Project Office:
BARR ENGINEERING CO.
4700 WEST 77TH STREET
MINNEAPOLIS, MN.
55435-4803
Ph: 1-800-632-2277
Fax: (952) 832-2601
www.barr.com

Scale	AS SHOWN
Date	07/05/11
Drawn	KKB
Checked	JXB
Designed	CAD
Approved	JXB

minnesota power
A WIND ENERGY INITIATIVE OF MINNESOTA POWER IN NORTH DAKOTA

Bison

BISON 3 WIND PROJECT
MORTON & OLIVER COUNTIES, NORTH DAKOTA
PLAN AND PROFILE - ALIGNMENTS E1 STA. 20+00 TO 50+56 - E2 STA. 0+00 TO 10+33

BARR PROJECT No.	34/30-1006
CLIENT PROJECT No.	
DWG. No.	C-19
REV. No.	1