




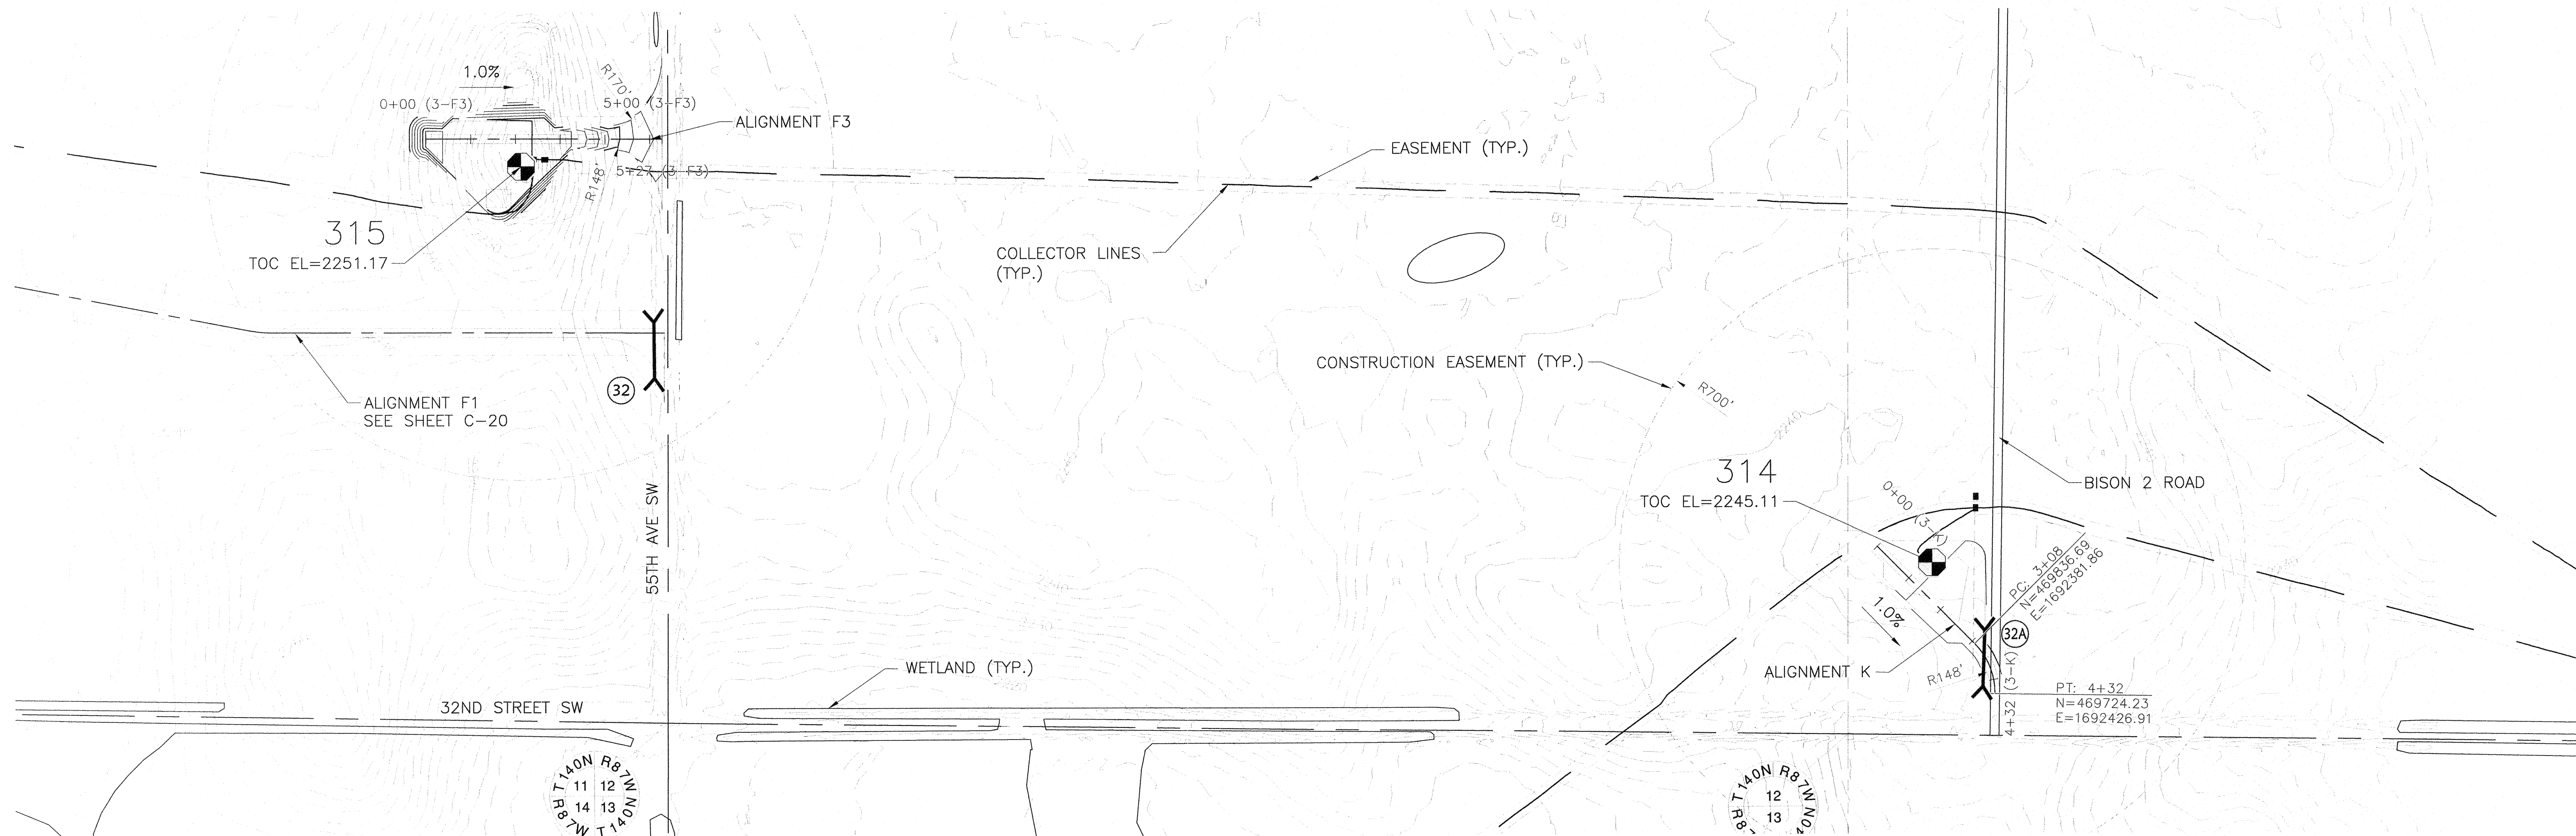

1 PLAN: ALIGNMENT F3 AND K

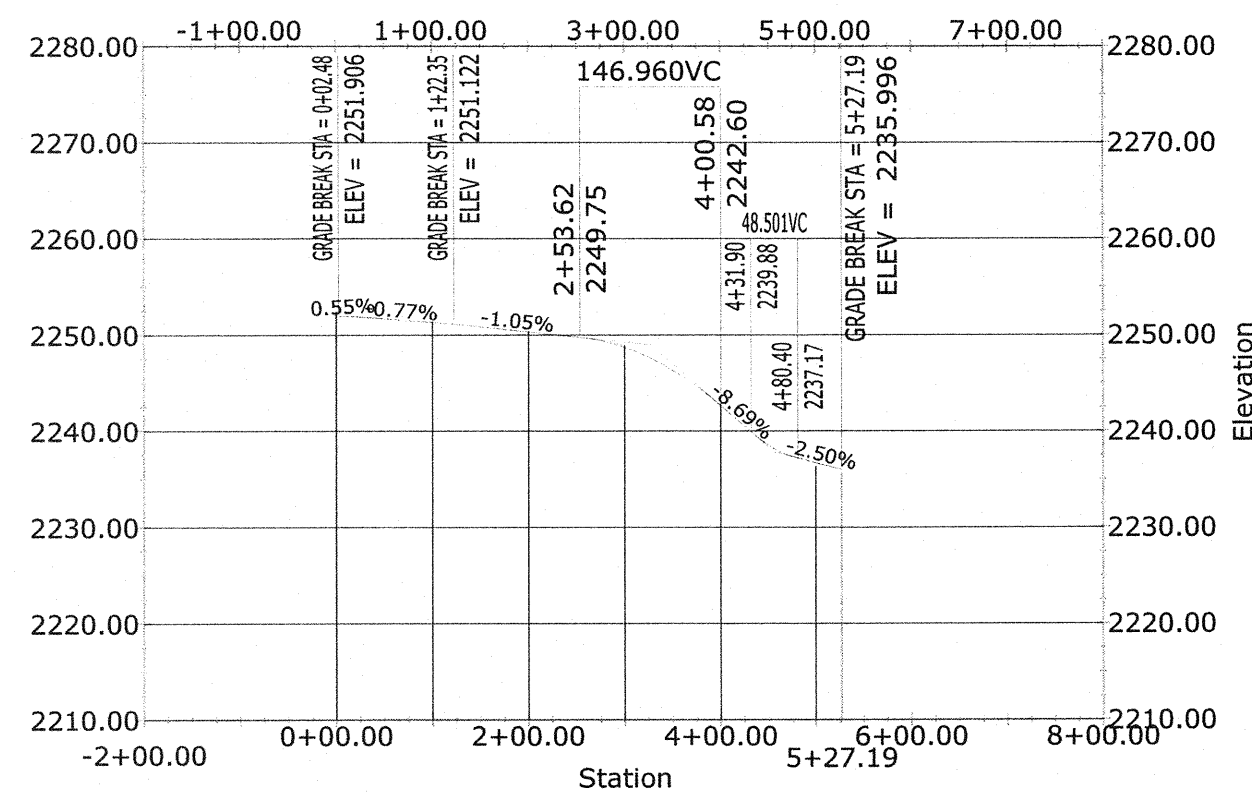


2 PROFILE: ALIGNMENT F3

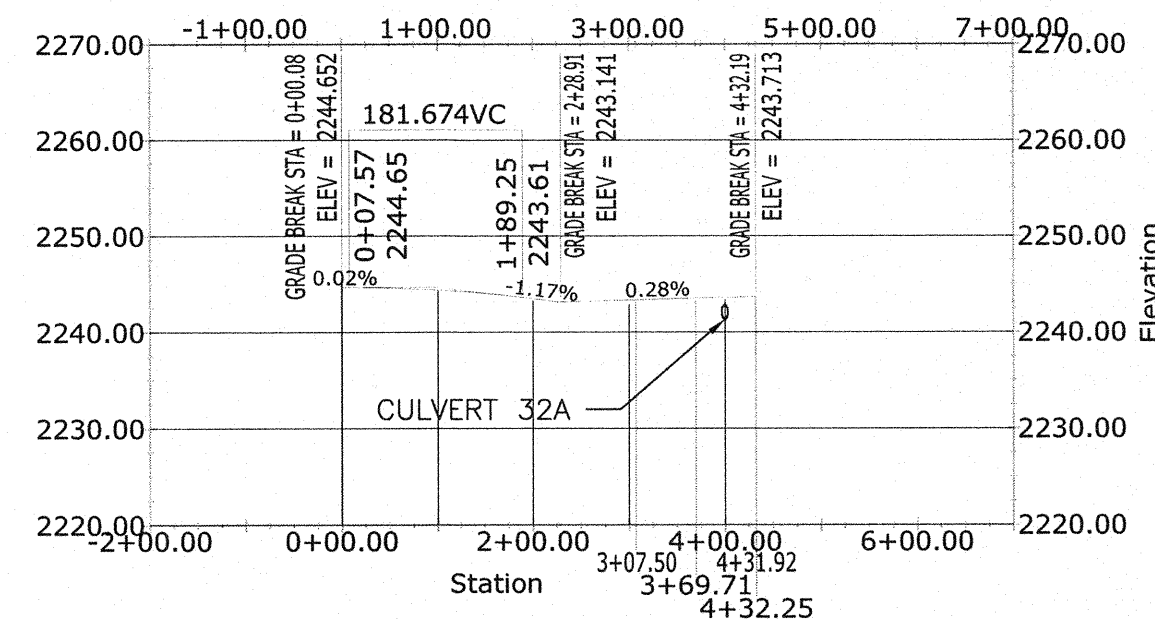

4 PROFILE: ALIGNMENT K

EXTERNAL REFERENCE:
• 34301006-BASE-C3D-DESIGN-ROADS-BISON 3-AS BUILT.DWG

A	KKB	CAD	JXB	07/15/11	60 PERCENT SUBMITTAL
B	CAD	CAD	JXB	09/02/11	90 PERCENT SUBMITTAL
C	CAD	CAD	JXB	09/30/11	ISSUED FOR CONSTRUCTION
1	NJG			2/27/13	CONSTRUCTION REVISIONS
NO.	BY	CHK	APP.	DATE	REVISION DESCRIPTION

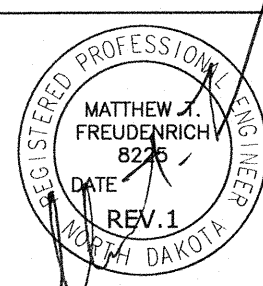


CLIENT	07/15/11	09/02/11							
BID									
CONSTRUCTION				09/30/11					
PERMITTING									
RECORD									
RELEASED TO/FOR	A	B	C	0	1	2	3		

BARR
Corporate Headquarters:
Minneapolis, Minnesota
Ph: 1-800-632-2277

Project Office:
BARR ENGINEERING CO.
4700 WEST 77TH STREET
MINNEAPOLIS, MN.
55435-4803
Ph: 1-800-632-2277
Fax: (952) 832-2601
www.barr.com

Scale	AS SHOWN
Date	07/05/11
Drawn	KKB
Checked	JXB
Designed	CAD
Approved	JXB

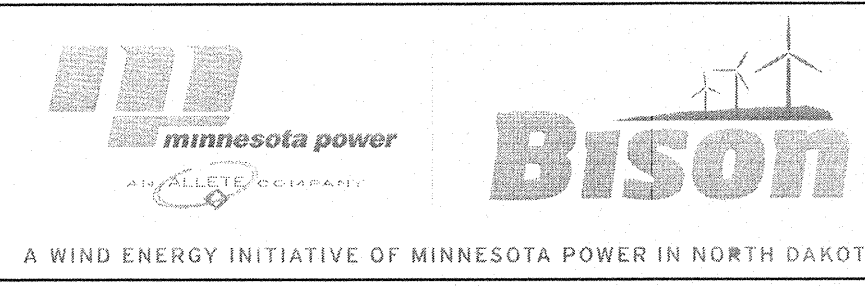

BISON 3 WIND PROJECT
MORTON & OLIVER COUNTIES, NORTH DAKOTA
PLAN AND PROFILE - ALIGNMENTS F3
0+00 TO 5+27 - K STA. 0+00 TO 4+32

BARR PROJECT No.	34/30-1006
CLIENT PROJECT No.	
DWG. No.	C-22
REV. No.	1