

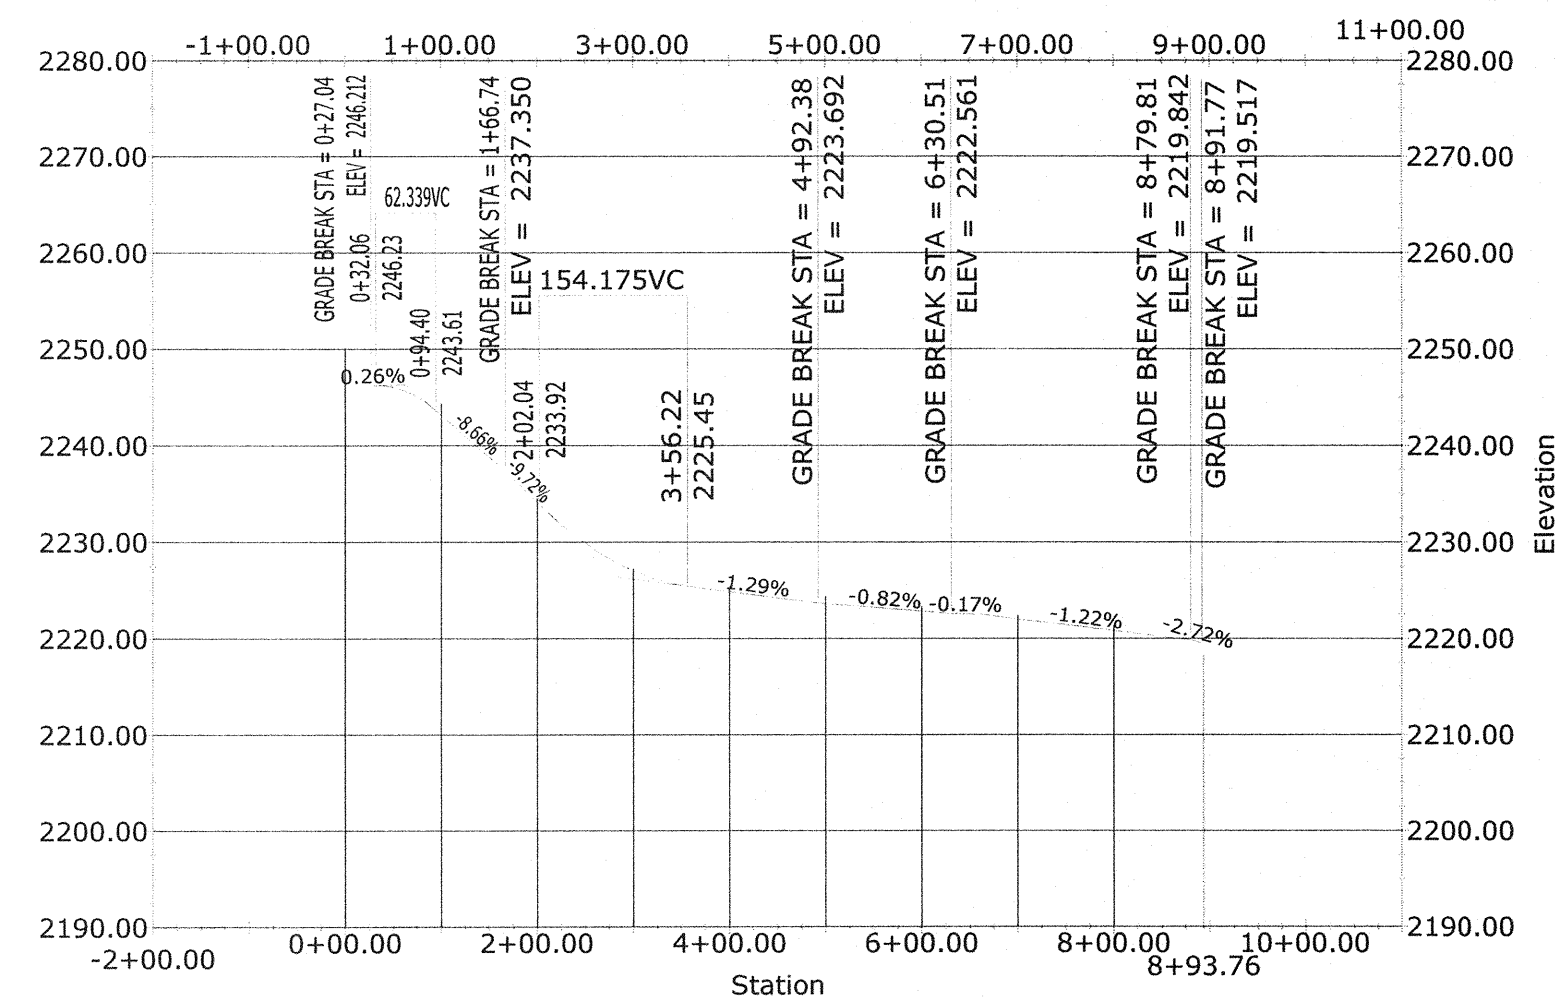


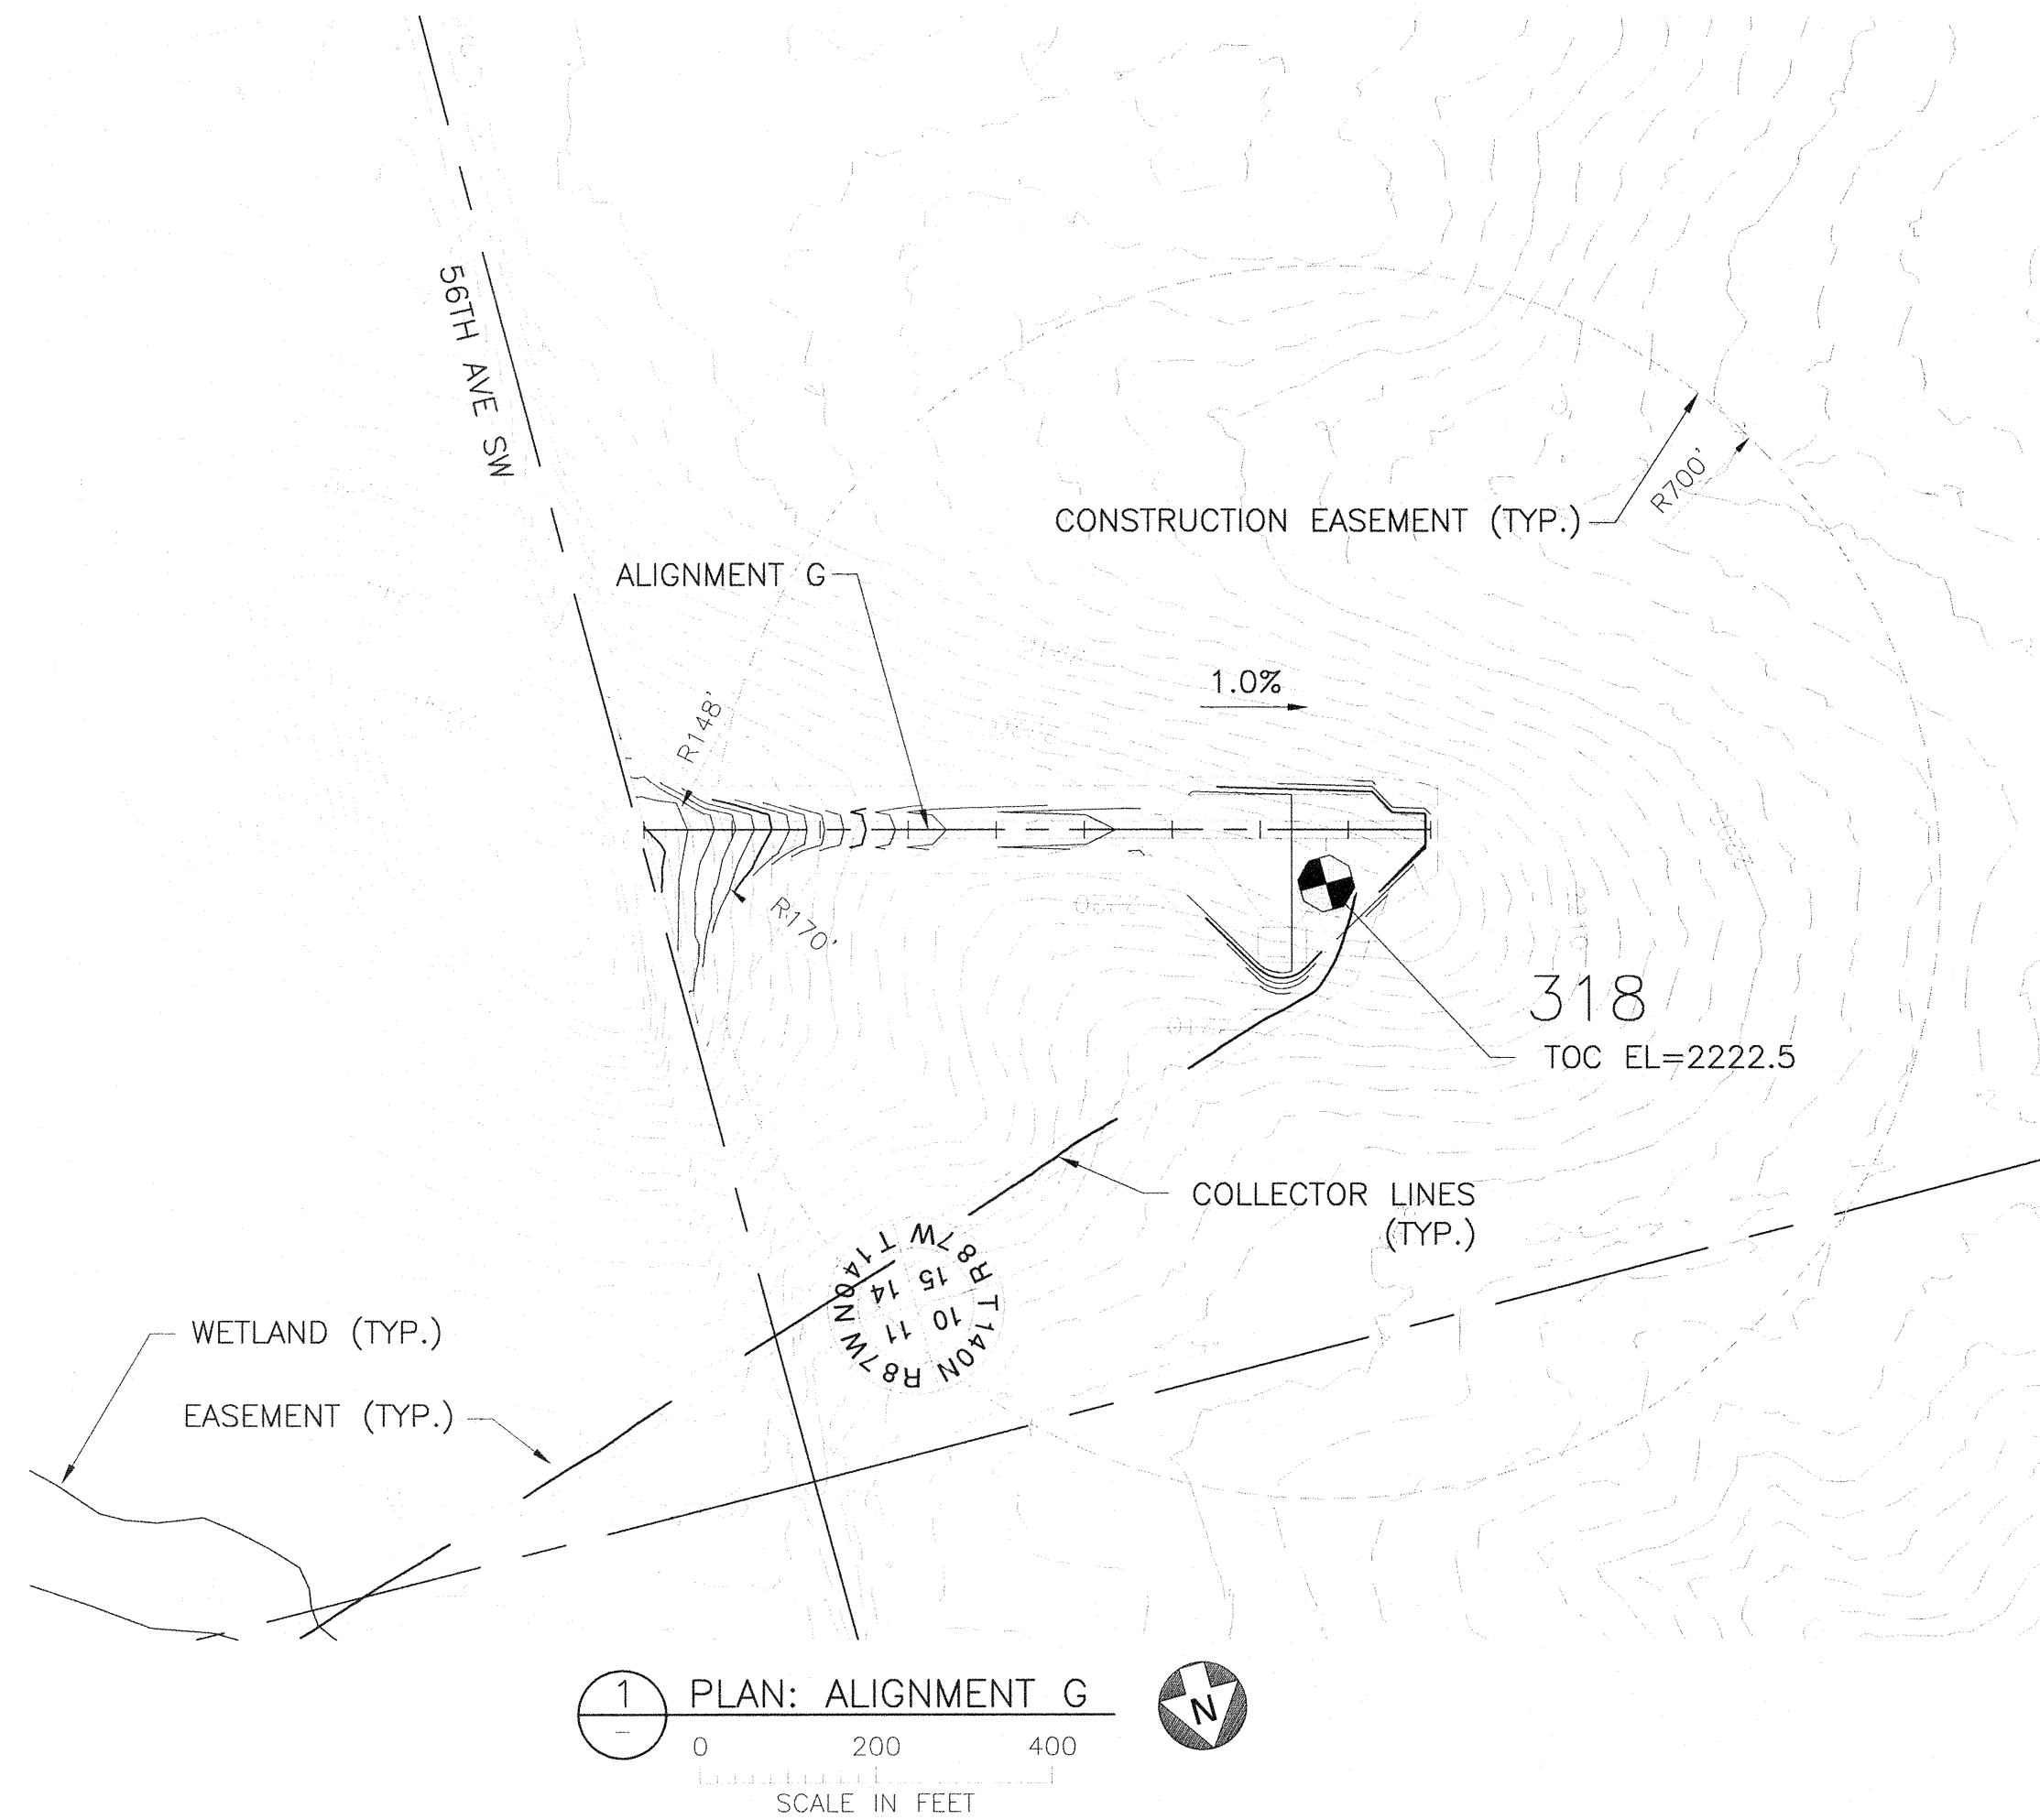

2 PROFILE: ALIGNMENT G

EXTERNAL REFERENCE:
• 34301006-BASE-C3D-DESIGN-ROADS-BISON 3-AS BUILT.DWG



NO.	BY	CHK	APP	DATE	REVISION DESCRIPTION
A	KKB	CAD	JXB	07/15/11	60 PERCENT SUBMITTAL
B	CAD	CAD	JXB	09/02/11	90 PERCENT SUBMITTAL
C	CAD	CAD	JXB	09/30/11	ISSUED FOR CONSTRUCTION
1	NJG			2/27/13	CONSTRUCTION REVISIONS

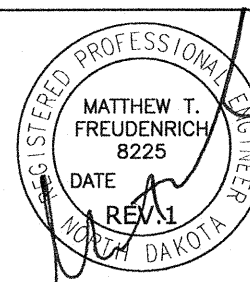

CLIENT	DATE	RELEASED TO/FOR
BARR ENGINEERING CO.	07/15/11	
CONSTRUCTION	09/30/11	
PERMITTING		
RECORD		



Scale	AS SHOWN
Date	07/05/11
Drawn	KKB
Checked	JXB
Designed	CAD
Approved	JXB

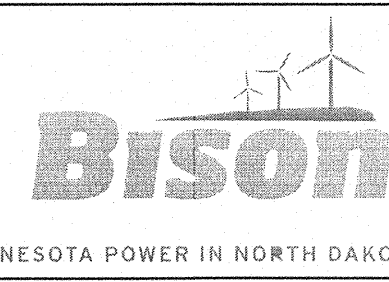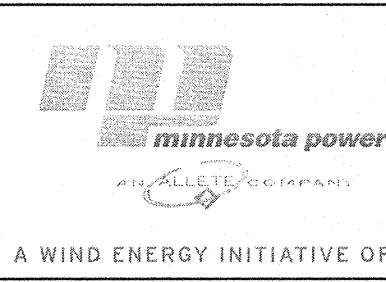

BARR PROJECT No.	34/30-1006
CLIENT PROJECT No.	
DWG. No.	C-23
REV. No.	1