



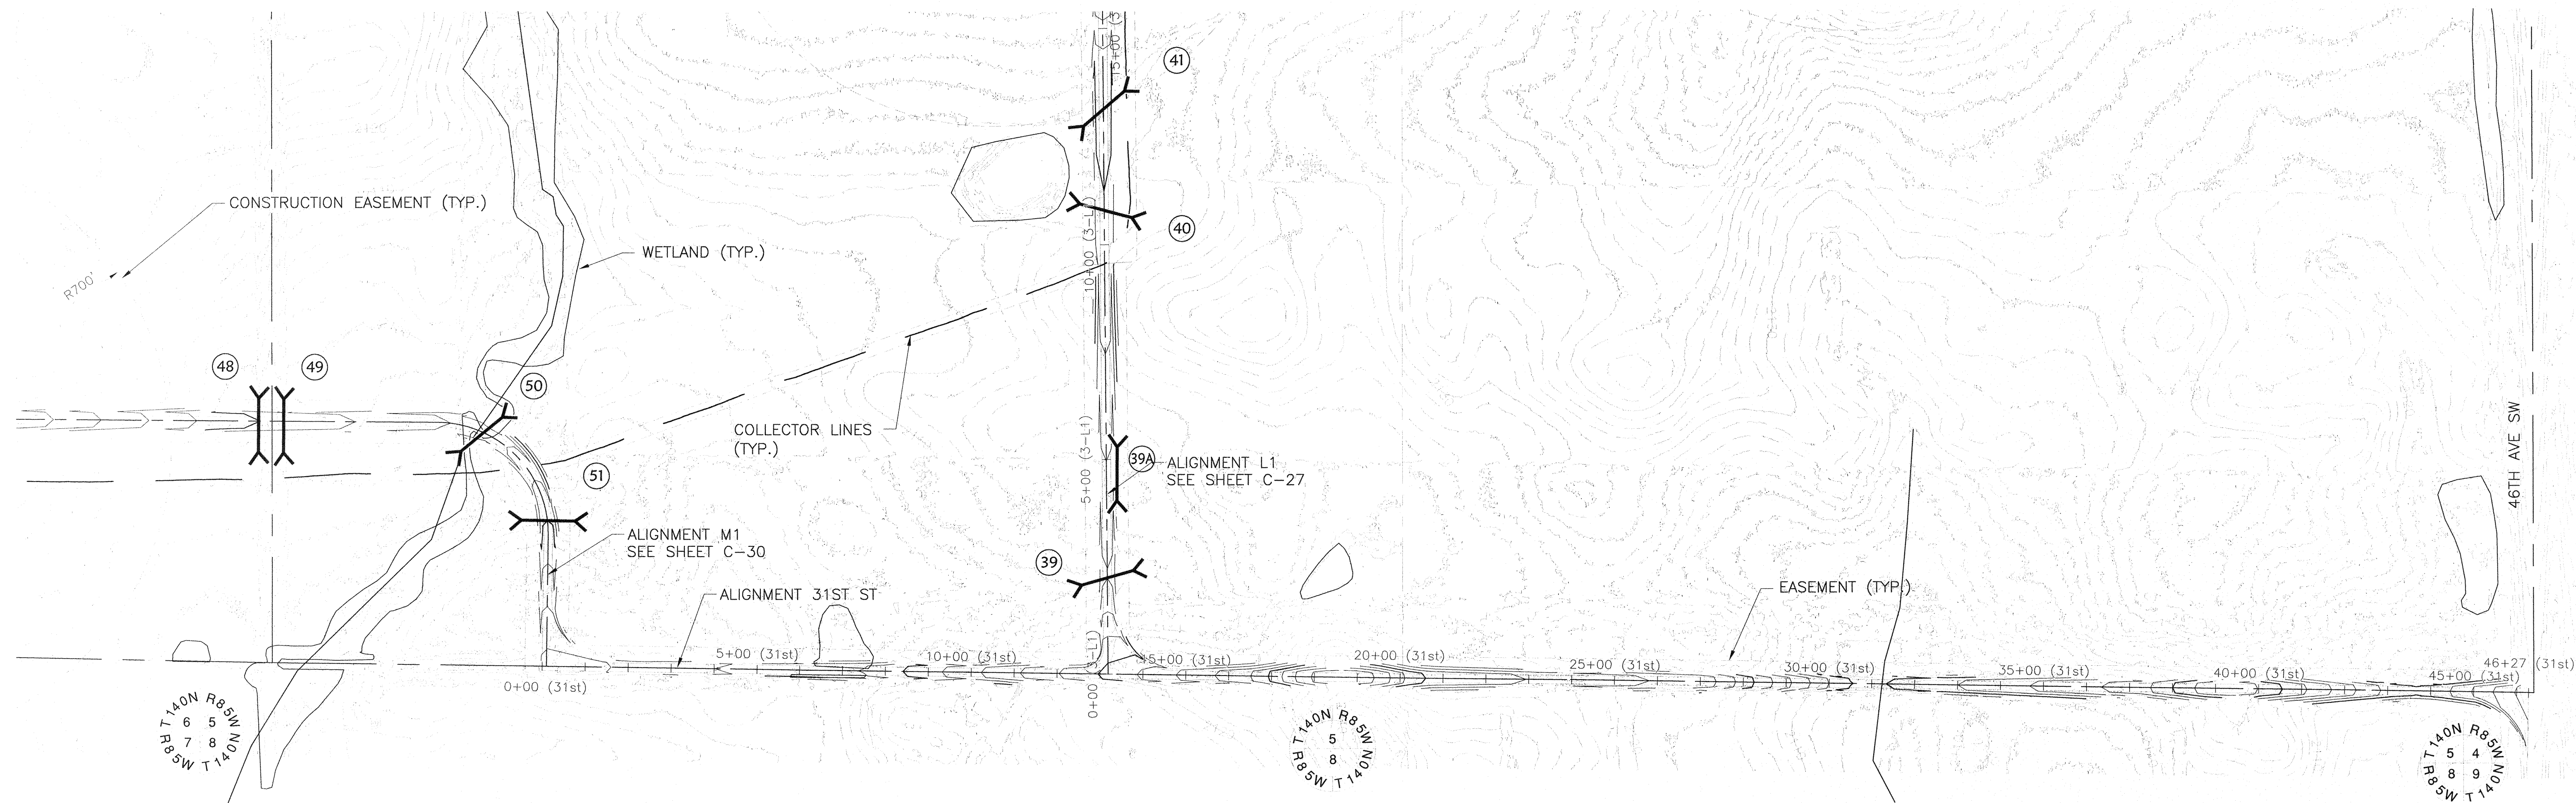


1 PLAN: ALIGNMENT 31ST ST

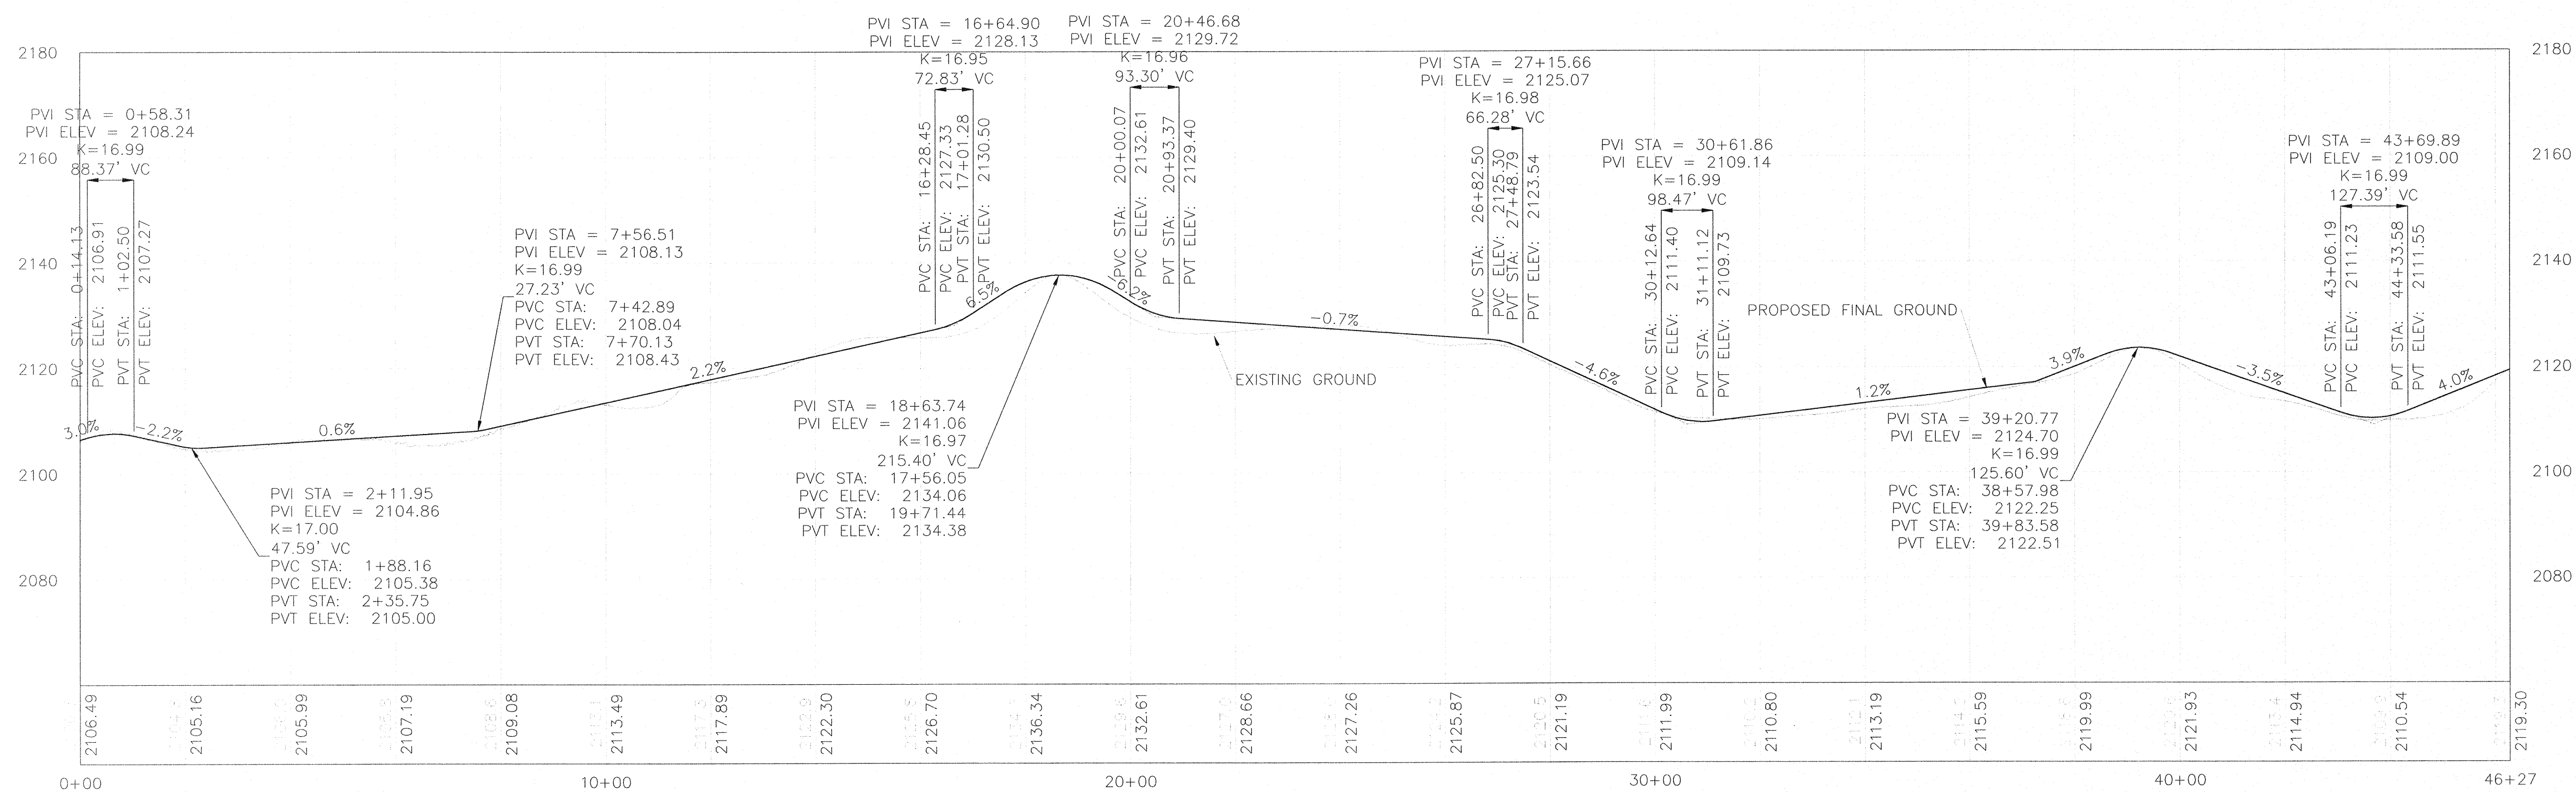

2 PROFILE: ALIGNMENT 31ST ST

EXTERNAL REFERENCE:
• 34301006-BASE-C3D-DESIGN-ROADS-BISON 3-AS BUILT.DWG


NO.	BY	CHK	APP	DATE	REVISION DESCRIPTION
A	KKB	CAD	JXB	07/15/11	60 PERCENT SUBMITTAL
B	CAD	CAD	JXB	09/02/11	90 PERCENT SUBMITTAL
C	CAD	CAD	JXB	09/30/11	ISSUED FOR CONSTRUCTION
1	NJG			2/27/13	CONSTRUCTION REVISIONS

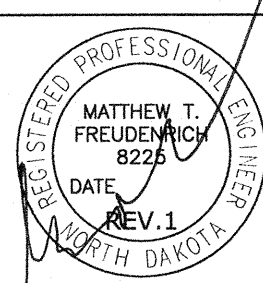

CLIENT	07/15/11	09/02/11					
BID							
CONSTRUCTION			09/30/11				
PERMITTING							
RECORD							
RELEASED TO/FOR	A	B	C	0	1	2	3
DATE RELEASED							



Scale	AS SHOWN
Date	07/05/11
Drawn	KKB
Checked	JXB
Designed	CAD
Approved	JXB

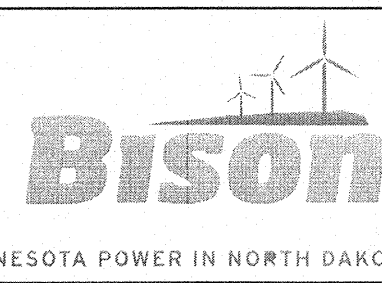

BISON 3 WIND PROJECT
MORTON & OLIVER COUNTIES, NORTH DAKOTA
PLAN AND PROFILE
ALIGNMENT 31ST ST STA. 0+00 TO 46+27

BARR PROJECT No.	34/30-1006
CLIENT PROJECT No.	
DWG. No.	C-31
REV. No.	1