
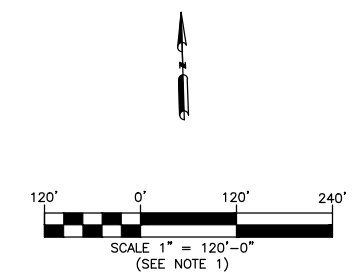


J:\02747 - Beaver Lodge Manifold & Piping Upgrades\CAD\As-Built\SHIS\Pip\2747-BA-P-0000.dwg Tonyf Sat, 03/17/12 12:17 PM

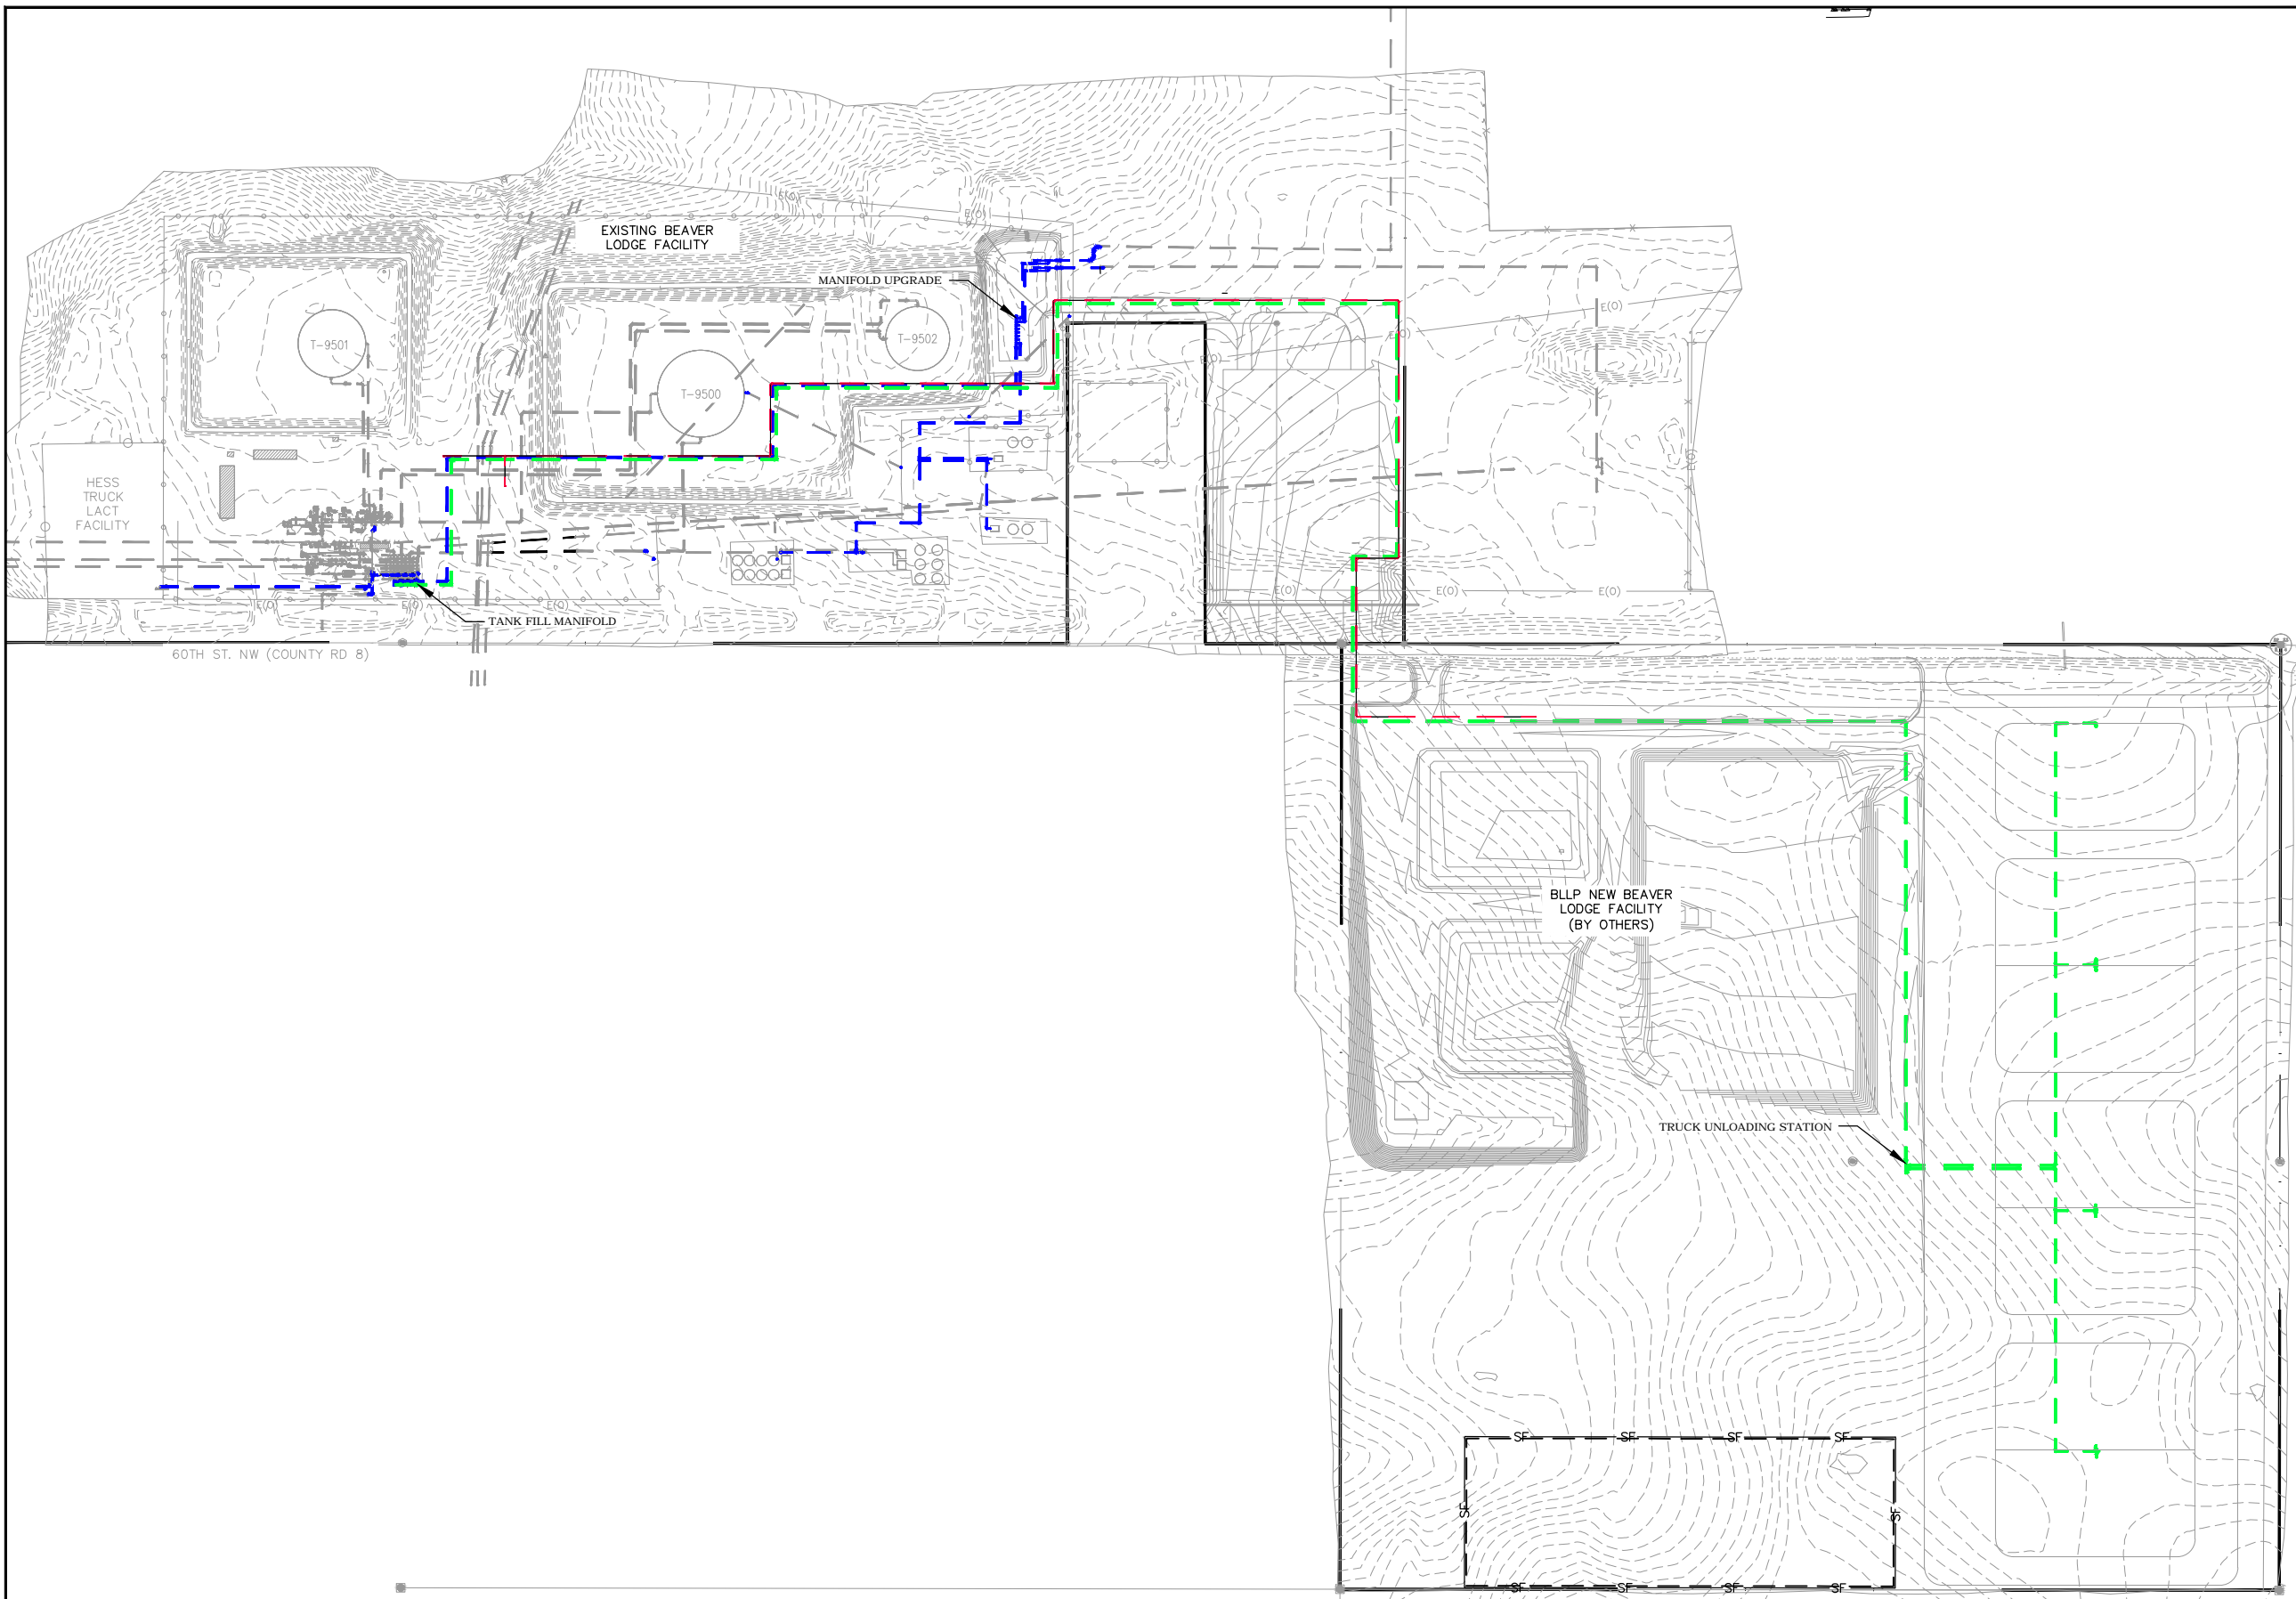

NO	REVISION	DATE	APPR	BY
1	ISSUED FOR AS-BUILTS	2/10/12	JH	ALF
0	ISSUED FOR CONSTRUCTION	6/1/11	JH	SM

ENBRIDGE PIPELINES (NORTH DAKOTA) LLC


BEAVER LODGE (ND) STATION

PLOT PLAN
MANIFOLD UPGRADE/TRUCK LACT/BLL

PROJECT: 2747	SCALE: AS SHOWN	DATE: 2/1/12	DRAWN: SM
CHECK: JH	APPR: JH	DATE: 4/29/11	

DWG. NO. 2747-BA-P-0000 REV 1

- LEGEND**
- MANIFOLD UPGRADE
 - BEAVER LODGE LOOP (BLL)
 - TRUCK LACT
 - EXISTING



Rooney Engineering, Inc.
12201 E. Arapahoe Rd.
Centennial, CO 80112
(303) 792-5911

NOTES:
1. LISTED SCALE IS FOR 22"x34" ("D" SIZE) DRAWINGS.