



LEGEND

- PIPING UPGRADE
- TRUCK UNLOADING
- EXISTING

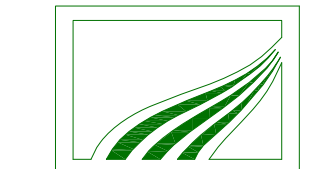

Rooney Engineering, Inc.
 12201 E. Arapahoe Rd.
 Centennial, CO 80112
 (303) 792-5911

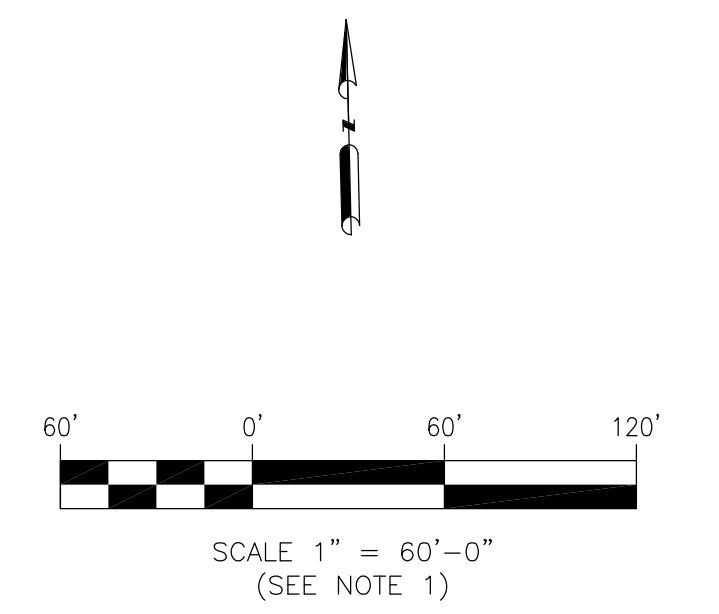

NOTES:
 1. LISTED SCALE IS FOR 22"x34" ("D" SIZE) DRAWINGS.

NO	REVISION	DATE	APPR	BY
1	ISSUED FOR AS-BUILT	06/22/12	GR	LLC
0	ISSUED FOR CONSTRUCTION	6/1/11	DL	LC

ENBRIDGE PIPELINES (NORTH DAKOTA) LLC
STANLEY (ND) STATION
 PIPING UPGRADE & TRUCK UNLOADING
 PLOT PLAN
 NEW

PROJECT: 2789	SCALE: AS NOTED	DATE: 4/19/11	DRAWN: LC
CHECK: DL	APPR: DL	DATE: 4/29/11	

DWG. NO. 2789-SY-P-0000 REV-1