
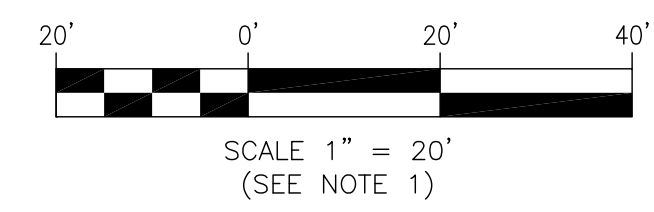


C:\pwworking\rei\dms01653\2851-EF-P-001.dwg Larry.cher 9/16/2013 10:56:37 AM

NOTE:  
1. LISTED SCALE IS FOR 22"x34" ("D" SIZE) DRAWINGS.

CIVIL GRADING HAS NOT BEEN AS-BUILT OR ADJUSTED FROM ORIGINAL DESIGN. STRUCTURAL COMPONENTS HAVE BEEN MODIFIED PER THE MECHANICAL SURVEY, OR SHOWN AS DESIGNED. ALL CIVIL/STRUCTURAL IS SHOWN FOR REFERENCE ONLY.  
ROONEY ENGINEERING MAKES NO WARRANTY OR GUARANTEE AS TO THE ACCURACY OF THE AS-BUILT INFORMATION.

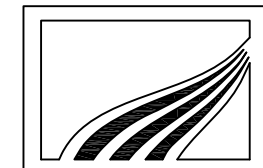

  
**Rooney Engineering, Inc.**  
12201 E. Arapahoe Rd.  
Centennial, CO 80112  
(303) 792-5911

NO	REVISION	DATE	APPR	BY
5	AS-BUILT	09/18/13	JEL	LYC
4	REVISED PIPING	08/27/12	GR	LC
3	REVISED RECEIVER	07/06/12	JH	LC
2	REVISED RECEIVER	06/15/12	GR	LC

**ENBRIDGE PIPELINES (NORTH DAKOTA) LLC**

**EAST FORK (ND) STATION**  
LITTLE MUDDY PROJECT  
EAST FORK OVERALL PLOT PLAN

PROJECT: 02851 - LITTLE MUDDY PROJECT EXECUTION

SCALE: AS NOTED	DATE: 01/16/12	DRAWN: LC
CHECK: JH	APPR: GR	DATE: 09/02/13

**DWG. NO. 2851-EF-P-001 REV 5**