






Path: P:\SWCA\Nelson\_Ross\Post\_Const\_Filing\MXDs\PCS\_PostConst\_Filing\_Alignment.mxd


Source: Esri, i-cubed, USDA, USGS, AEX, GeoEye, Getmapping, Aerogrid, IGN, IGP, and the GIS User Community

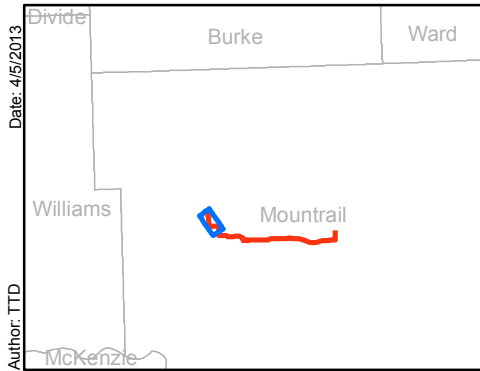


Date: 4/5/2013  
Author: TTD  
McKenzie

 Nelson to Ross As-Built Alignment



 Enhancing Execution with Experience

 **PLAINS**  
ALL AMERICAN  
PIPELINE, L.P.

0 750 1,500 3,000 Feet

1:12,000

**Nelson to Ross**  
PCS Post Construction Filing  
As-Built Alignment


Docket No. PU-12-040  
Route Permit No. 143

Map 1 of 7  
Mountrail County, ND



Path: P:\SWCA\Nelson\_Ross\Post\_Const\_Filing\MXDs\PCS\_PostConst\_Filing\_Alignment.mxd

Source: Esri, I-cubed, USDA, USGS, AEX, GeoEye, Getmapping, Aerogrid, IGN, IGP, and the GIS User Community

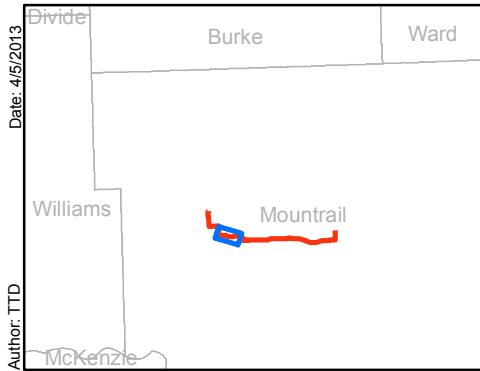


**Nelson to Ross As-Built Alignment**

**Nelson to Ross**  
 PCS Post Construction Filing  
 As-Built Alignment

Docket No. PU-12-040  
 Route Permit No. 143

Map 2 of 7  
 Mountrail County, ND

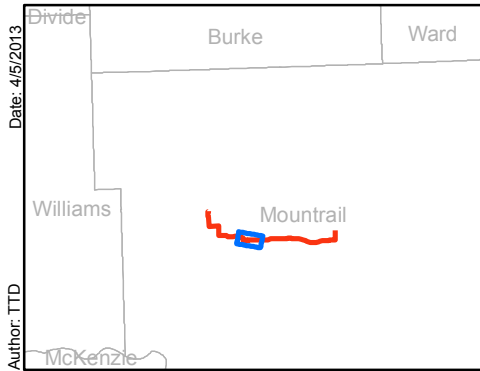

Nelson to Ross As-Built Alignment

0 750 1,500 3,000 Feet

1:12,000

**Nelson to Ross**  
 PCS Post Construction Filing  
 As-Built Alignment


Docket No. PU-12-040  
 Route Permit No. 143

Map 3 of 7  
 Mountrail County, ND


Path: P:\SWCA\Nelson\_Ross\Post\_Const\_Filing\MXDs\PCS\_PostConst\_Filing\_Alignment.mxd





Source: Esri, i-cubed, USDA, USGS, AEX, GeoEye, Getmapping, Aerogrid, IGN, IGP, and the GIS User Community

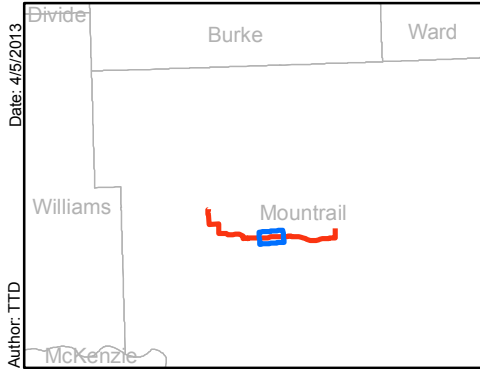



Author: TTD  
McKenzie

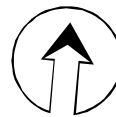 Nelson to Ross As-Built Alignment

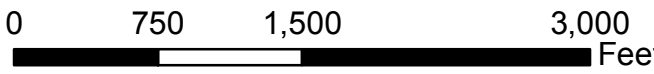

  
1:12,000





**Nelson to Ross**  
PCS Post Construction Filing  
As-Built Alignment


Docket No. PU-12-040  
Route Permit No. 143

Map 4 of 7  
Mountrail County, ND



Path: P:\SWCA\Nelson\_Ross\Post\_Const\_Filing\MXDs\PCS\_PostConst\_Filing\_Alignment.mxd

Source: Esri, i-cubed, USDA, USGS, AEX, GeoEye, Getmapping, Aerogrid, IGN, IGP, and the GIS User Community

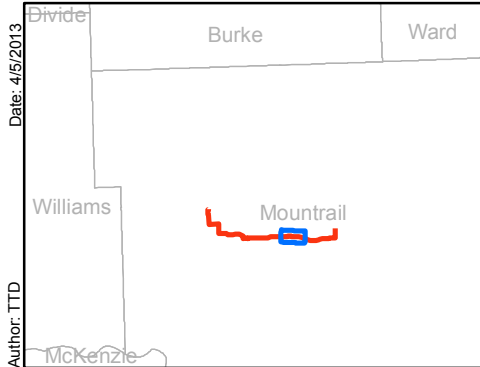

Author: TTD  
McKenzie

**Nelson to Ross As-Built Alignment**

1:12,000

**Nelson to Ross**  
 PCS Post Construction Filing  
 As-Built Alignment


Docket No. PU-12-040  
 Route Permit No. 143

Map 5 of 7  
 Mountrail County, ND



Path: P:\SWCA\Nelson\_Ross\Post\_Const\_Filing\MXDs\PCS\_PostConst\_Filing\_Alignment.mxd

Source: Esri, i-cubed, USDA, USGS, AEX, GeoEye, Getmapping, Aerogrid, IGN, IGP, and the GIS User Community

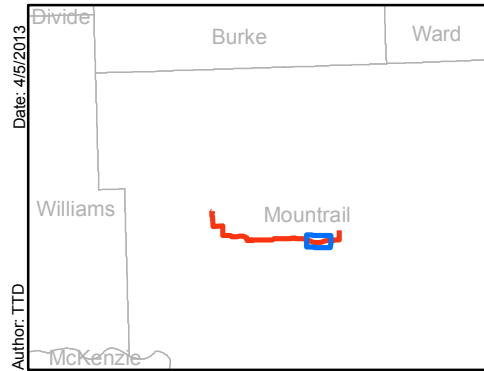

Date: 4/5/2013  
Author: TTD

**Nelson to Ross As-Built Alignment**


**Nelson to Ross**  
 PCS Post Construction Filing  
 As-Built Alignment

Docket No. PU-12-040  
 Route Permit No. 143

Map 6 of 7  
 Mountrail County, ND



Path: P:\SWCA\Nelson\_Ross\Post\_Const\_Filing\MXDs\PCS\_PostConst\_Filing\_Alignment.mxd

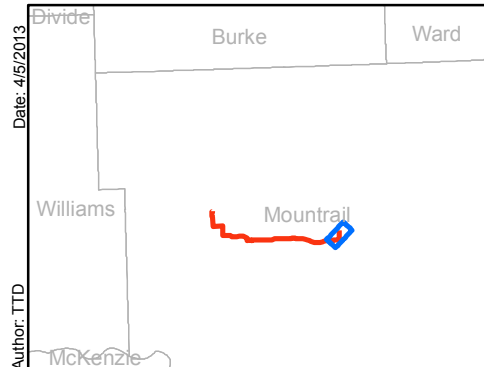

Author: TTD

**Nelson to Ross As-Built Alignment**

**Nelson to Ross**  
 PCS Post Construction Filing  
 As-Built Alignment

Docket No. PU-12-040  
 Route Permit No. 143

Map 7 of 7  
 Mountrail County, ND