


PLAN VIEW  
SCALE: 1" = 100'

LEGEND


- AS BUILT ALIGNMENT
- SECTION LINE
- QUARTER SECTION LINE
- QUARTER-QUARTER SECTION LINE
- OVERHEAD/UNDERGROUND ELECTRIC LINE
- CO2 GAS LINE
- WEST RIVER TELEPHONE/ FIBER OPTIC LINE
- 345kv OVERHEAD POWER
- FENCE LINE
- 2' CONTOURS
- CATHODIC PROTECTION TEST LOCATION

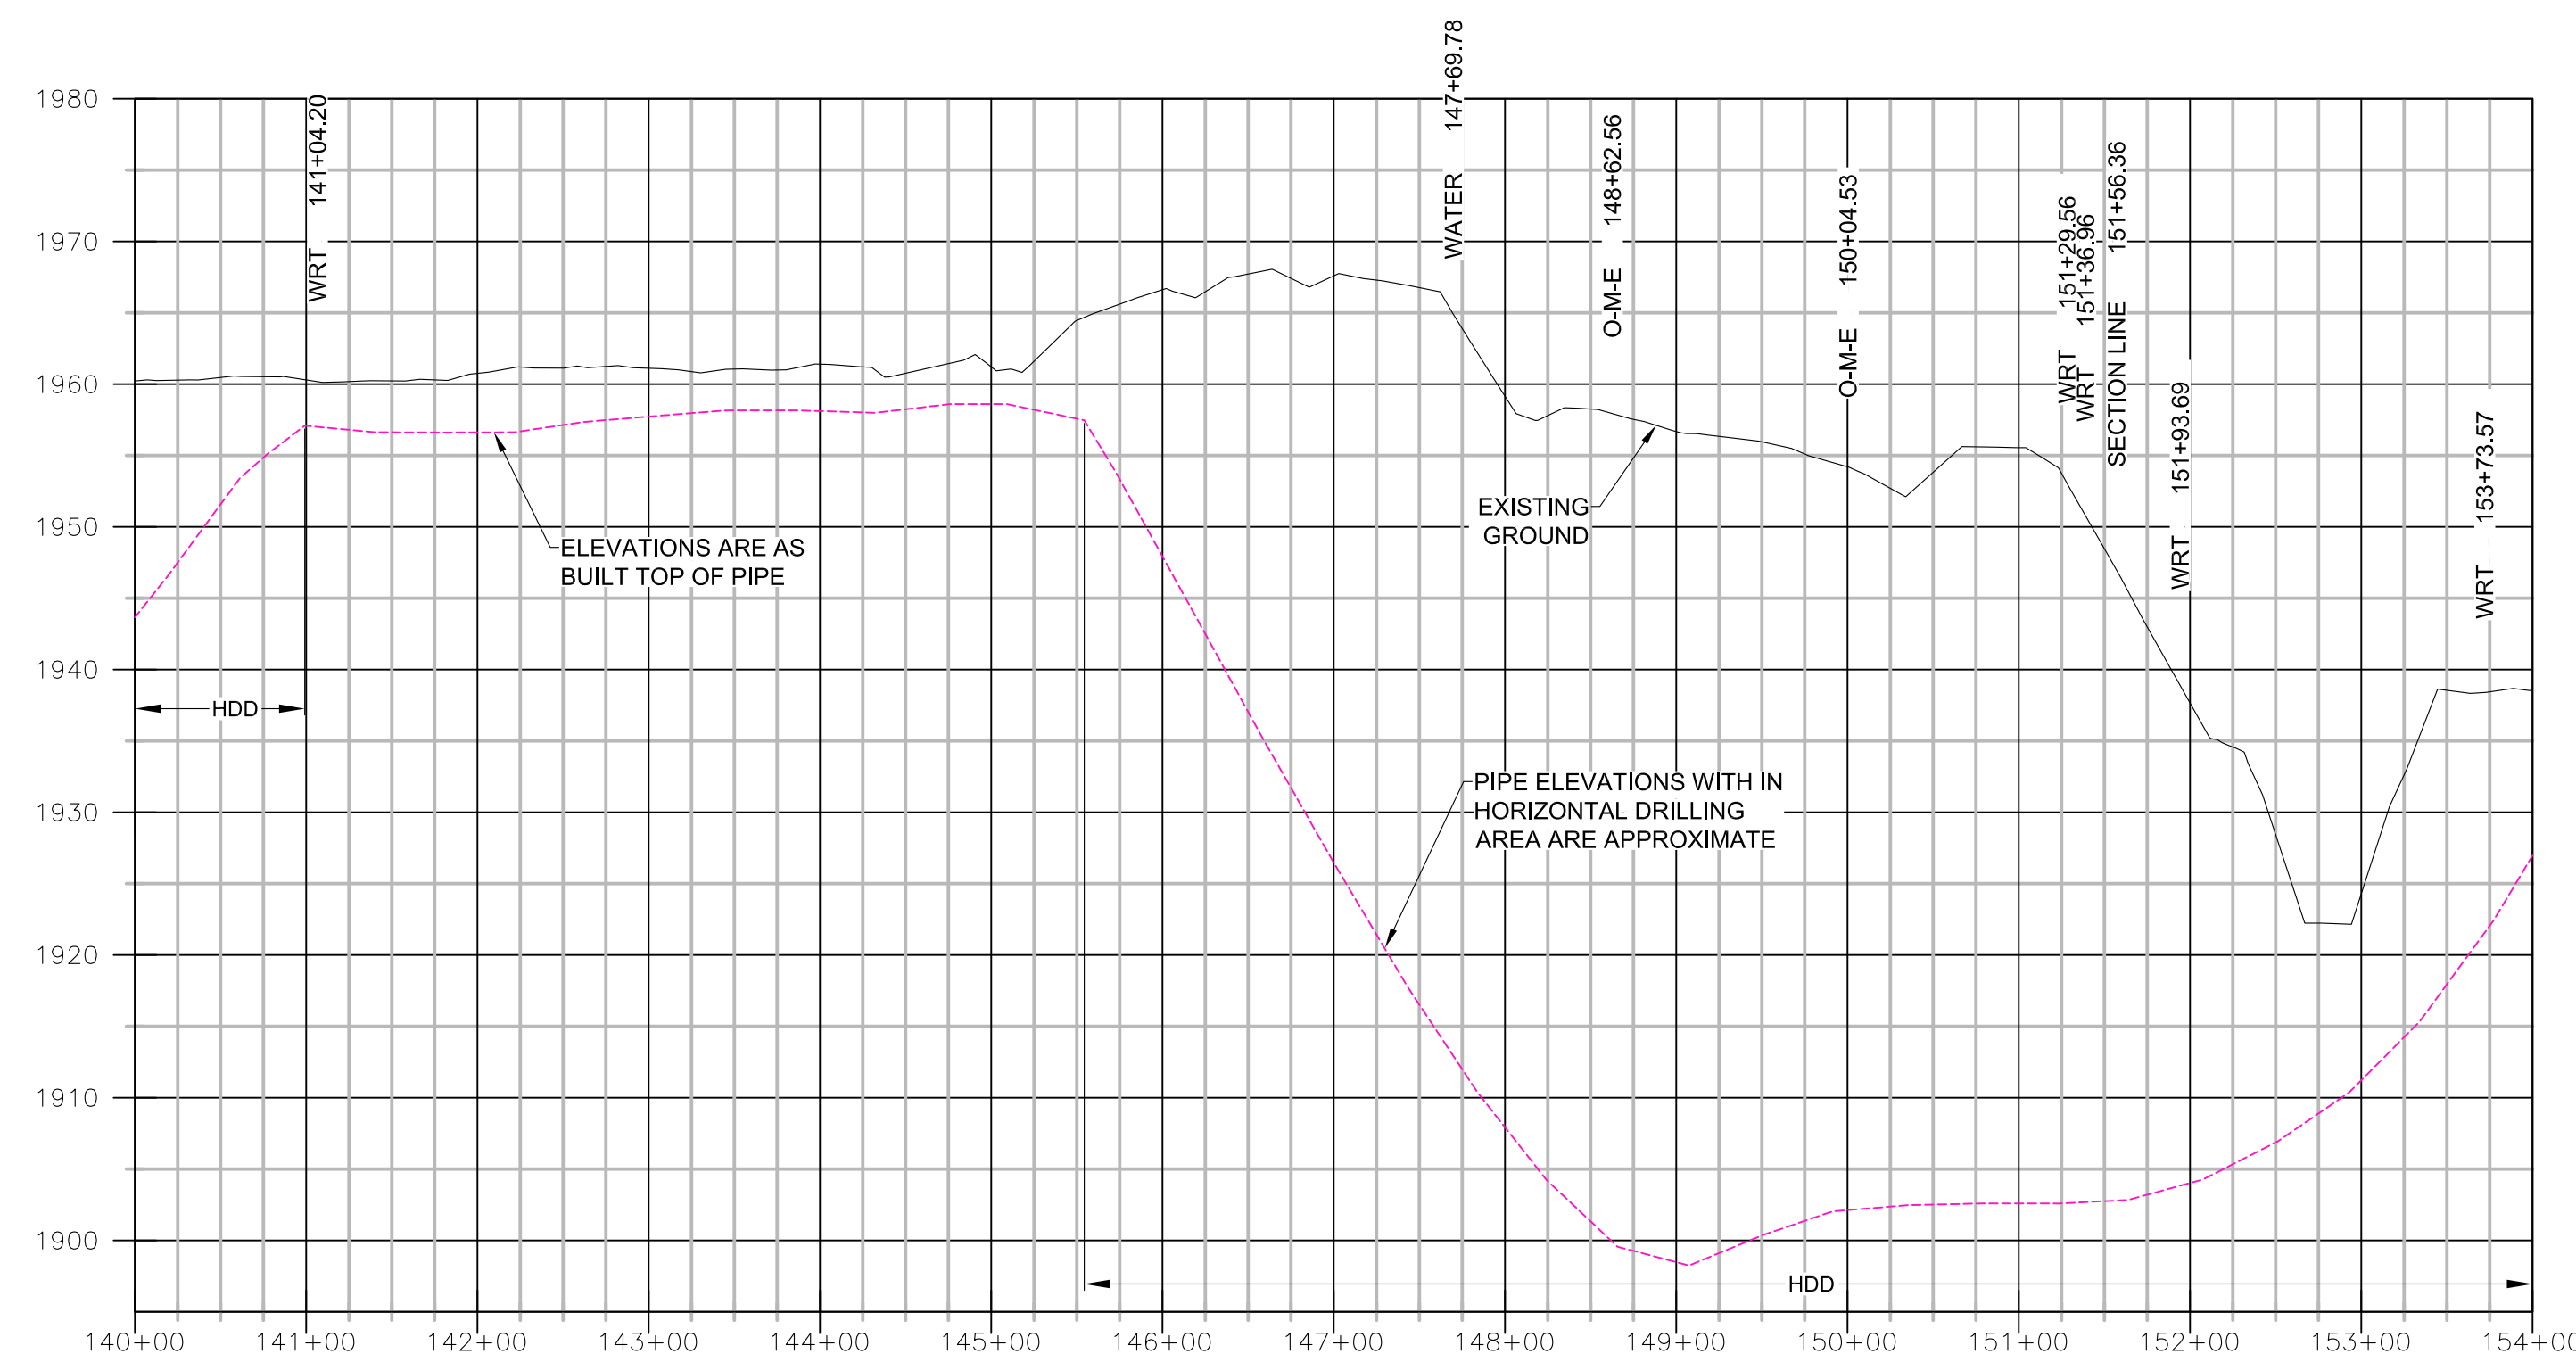

PROFILE VIEW  
SCALE: 1" = 100' HORIZ  
1" = 10' VERT.

CERTIFICATE OF ENGINEER

I, Maria Barnhardt, hereby certify that this drawing was prepared by me or under my direct supervision. That is a compilation of various drawings and the best available information supplied by others. This information has not been verified for accuracy and/or completeness and there for the engineer shall not be responsible for any error or omissions which may be incorporated as a result

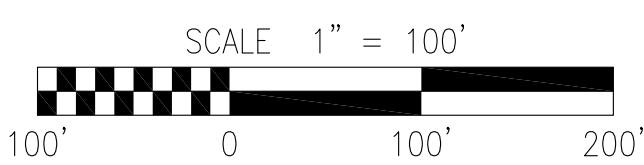

BASIS OF BEARING IS NAD27 ND STATE PLANE SOUTH ZONE. ALL DISTANCES ARE GRID DISTANCE.

REFERENCE DRAWINGS						
DESCRIPTION	DRAWING NO.					
ALIGNMENT DRAWING SHEET 5 & 7	7350-005C & 007C					
WELD DESIGNATION TABLE	7350-008C					
WELD DESIGNATION TABLE	7350-009C					
REV.	ISSUE DATE	DESCRIPTION	DWN	CHK	APP	APP
0	7/8/15	AS BUILT	W.D.#40850210			

THIS DRAWING IS THE PROPERTY OF THE DAKOTA GASIFICATION COMPANY AND MAY NOT BE COPIED OR USED WITHOUT PRIOR AUTHORIZATION.	
<b>DAKOTA GASIFICATION COMPANY</b> 420 COUNTY ROAD 26 BEULAH, ND 58523-9400	
7350 AREA DGC TO AVS 10" SNG PIPELINE ALIGNMENT DRAWING SHEET 6	
DWG. NO:	7350-006C SCALE: AS SHOWN
LDC. NO:	D00043063
REV. NO:	0

D00043063