



Serving: Grant • Mercer • Morton • Oliver • Sioux Counties
www.custerhealth.com

403 Burlington St SE
Mandan, North Dakota 58554
701-667-3370 • Fax: 701-667-3371
1-888-667-3370

**ONSITE SEWAGE TREATMENT SYSTEM
PERMIT FOR CONSTRUCTION/USE**

Custer Health requires an inspection of the open system before it is covered. Please call 24-48 hours in advance of system completion to set up inspection.

DATE OF ISSUANCE: 10/27/2015

PERMIT NUMBER: 2015150

APPLICANT INFORMATION

Sunflower Wind Farm
7687 40th St
Hebron, ND 58638

PROPERTY INFORMATION

7687 40th St
Hebron, ND 58638

COUNTY: Morton **TOWNSHIP:** 139 **RANGE:** 90 **SECTION:** 20 **LOT: #** **BLOCK: #**

NUMBER OF BEDROOMS: NA **WORK TYPE:** NEW

LICENSED INSTALLER: Glaser Welding and Excavation

SYSTEM DESIGN REQUIREMENTS:

1250 working capacity septic tank and 1960 square feet of drain field approved. For worksite shop and office area. (rewrite of permit issued in October 2015) Due to ND regulations an oil interceptor with separate holding must be installed to handle truck shop/wash area. The holding can be a tank within the oil interceptor, an outside holding tank OR an outside berm.

Permission is hereby granted to the above applicant to install, alter, or replace the onsite sewage treatment system on the above property. The system must be installed in compliance with ND State Plumbing Code Chapter 62-03.1-03 and the regulations of Custer Health. This permit does not carry any warrantee or guarantee, stated or implied, that the system will function but certifies the system meets prescriptive standards contained in the aforementioned code and regulations for construction parameters.

ISSUED BY: Lana Schmidt **DATE:** 7/15/2016

SIGNATURE: Lana Schmidt

134 PU-14-105 Filed 12/22/2016 Pages: 75
Final septic permit and the project operational SPCC plan
Sunflower Wind Project, LLC
Aaron Anderson

INSPECTION NOTES

INSPECTION DATE: 11/10/16 **APPROVED FOR USE:** YES NO

INSPECTION NOTES: 1250 gal working capacity tank installed to 2 distribution boxes - 5 runs of bio-dome: 4@120' & 1@150' see as built for details of layout - inspection ports on end of 3 trenches

INSPECTOR SIGNATURE: Lana Schmidt

Modification of system fully complies with Custer Health Code.

Custer Health

403 Burlington St SE • Mandan, ND 58554
Phone: 701-667-3370 • Fax: 701-667-3371

Serving: Grant • Mercer • Morton • Oliver • Sioux Counties
www.custerhealth.com

OSTS AS BUILT

PERMIT NUMBER

2015150

DATE OF INSTALLATION

11/10/16

TOWNSHIP, RANGE, SECTION

139, 90, 20

OWNER

Sunflower Wind Farm

PROPERTY ADDRESS


7687 40th St. Hebron ND

INSTALLER

Glaser Welding & Excavation

In the space below, draw the system layout, include depth to bottom of treatment area, length, distances in detail.

(see back for format required)

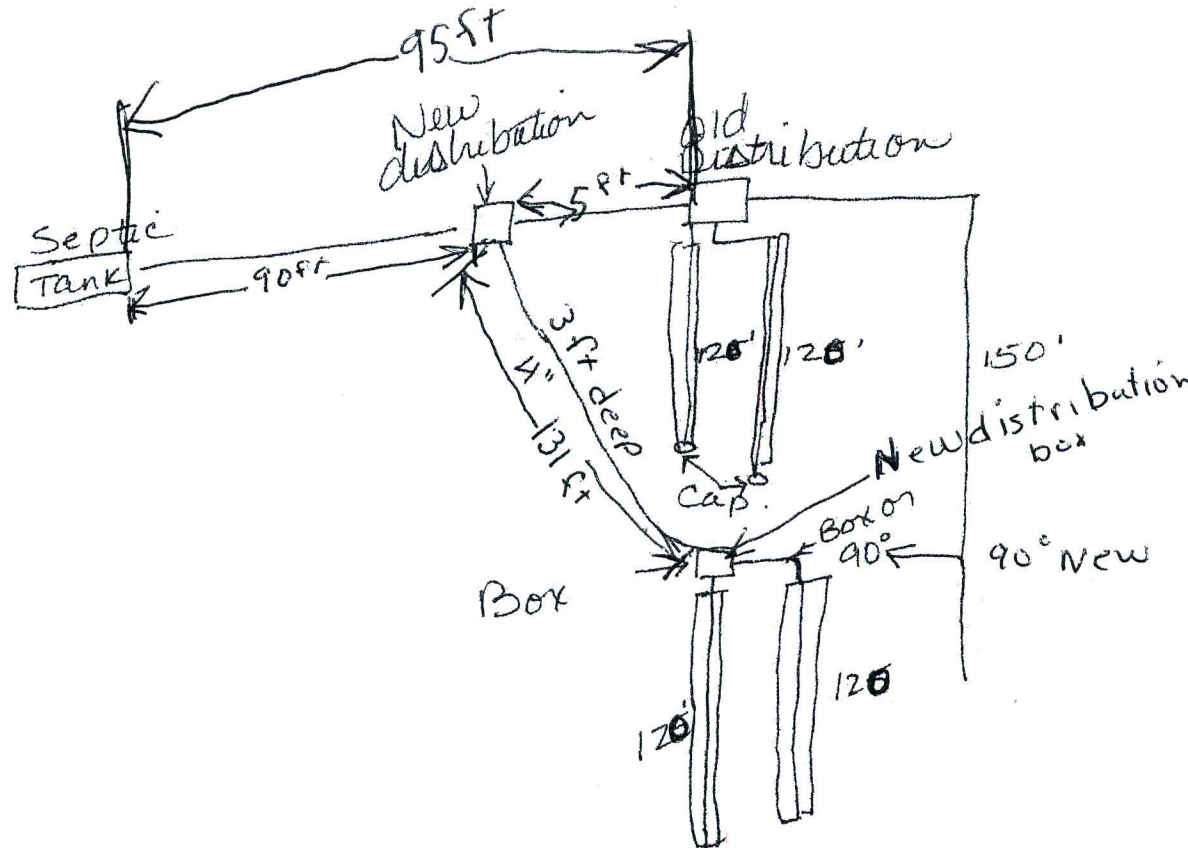

Send to Custer Health with 30 days of completion of system installation.