


Brian R. Bjella
100 West Broadway, Suite 250
P.O. Box 2798
Bismarck, ND 58502-2798
701.223.6585
bbjella@crowleyfleck.com

May 9, 2016

Mr. Darrell Nitschke
NORTH DAKOTA PUBLIC
SERVICE COMMISSION
600 E. Boulevard Avenue, Dept. 408
Bismarck, ND 58505-0480

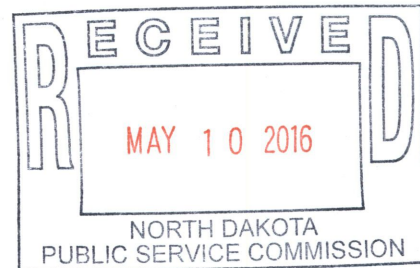

Dear Mr. Nitschke:

In re: In the matter of the Application of
Vantage Pipeline US, LP
West Spur Lateral Pipeline
Williams and Divide Counties, North Dakota
Case No. PU-15-142
Our File No. 74-563-001

Enclosed for filing are 11 copies of the As-Built alignment, with attached letter from KC Harvey Environmental.

Also enclosed is a CD in PDF format.

Please call should you have any questions.

Very truly yours,

Brian Bjella

bw
Enc.
cc: Julie Prescott (w/o enc.)



April 27, 2016

Mr. Patrick Fahn
North Dakota Public Service Commission
600 East Boulevard, Dept. 408
Bismarck, ND 58505-0480

RE: As-Built submittal for Vantage West Spur Lateral Pipeline Case No. PU-15-142

Dear Mr. Fahn and ND PSC,

On behalf of our client, Vantage Pipeline US LP (Pembina Pipeline Corp.), KC Harvey Environmental LLC is submitting the As-Built alignment. Enclosed for filing by Vantage Pipeline US LP is electronic and paper copies of the as-built transmission facility and the corridor. The electronic version is provided as shapefiles and can be imported into ESRI GIS mapping software. The data was developed in North American 1983 datum and is projected in State Plane North Dakota North (Feet). Vertical data values are shown in feet.

The paper copy is bound and presented as a 1:12,000 mapbook. A digital version of the mapbook is also provided in PDF format.

Please contact me regarding any questions or concerns with these documents.


Sincerely,

A handwritten signature in cursive script, appearing to read "Monica Pokorny".

Monica Pokorny, Senior Ecologist
KC Harvey Environmental, LLC.


CC. Keith Learmonth, Cullen Colville, and Brad Agnew, Pembina Pipeline Corporation

Montana
North Dakota

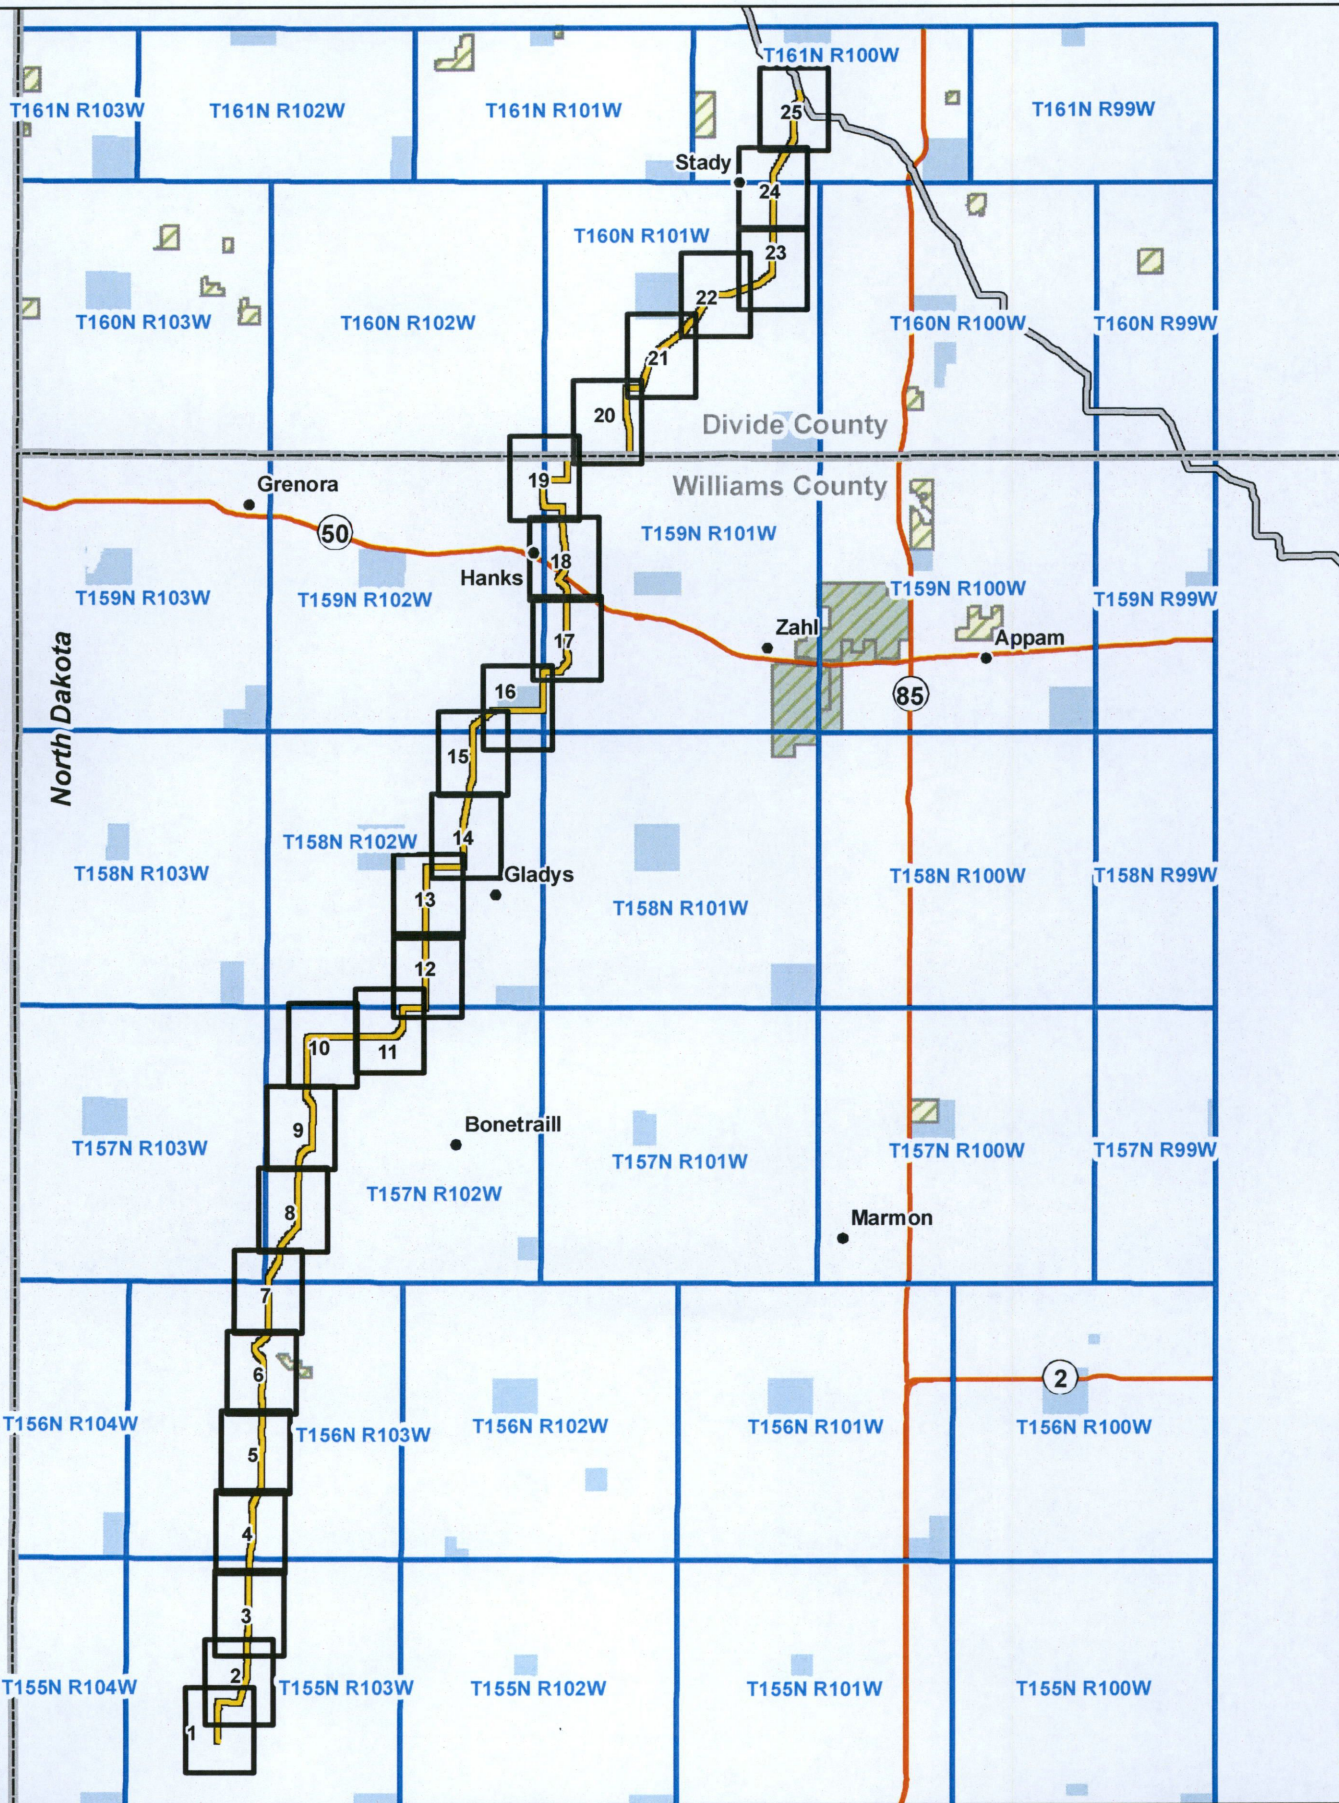

KC HARVEY

376 Gallatin Park Drive
Bozeman, MT 59715
www.kcharvey.com

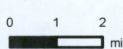

- Asbuilt Vantage West Spur Pipeline
- Vantage Pipeline
- Highway


- Township
- State Land
- National Wildlife Refuge
- Water Fowl Production Area



Vantage Pipeline US LP


Vantage West Spur Pipeline
Index Map for Asbuilt Series

Date: 04/20/2016 Version: 2016-1

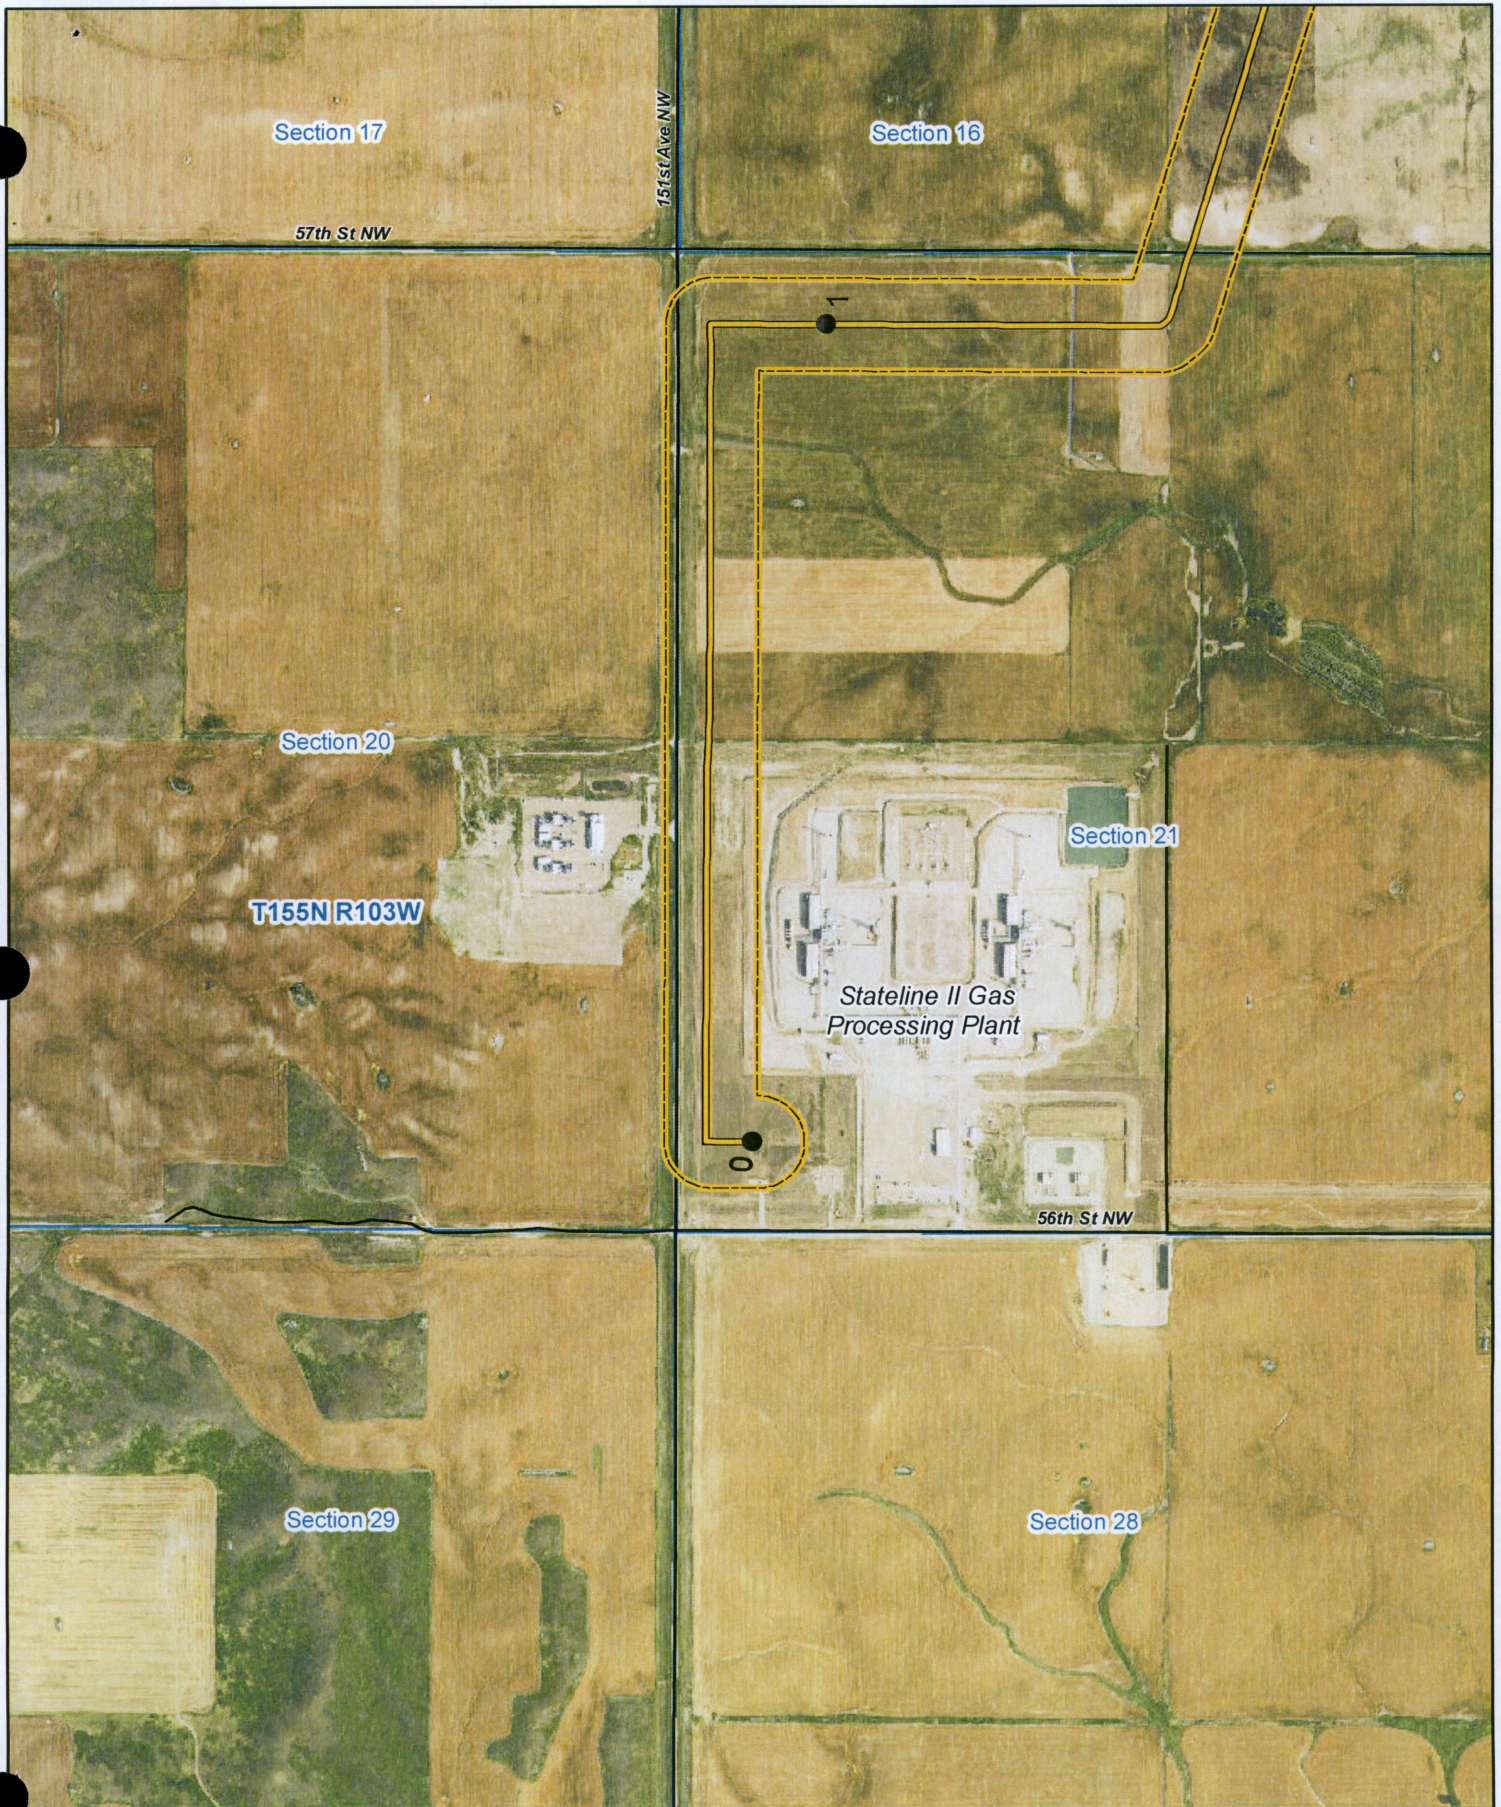

KC HARVEY

376 Gallatin Park Drive
Bozeman, MT 59715
www.kcharvey.com

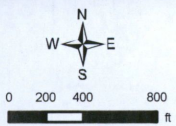

- Asbuilt Route
- Issued Route
- Issued Route Survey Corridor

- Highway
- Local Road
- Private Road
- Trail

- County
- Township
- Section


- State Land
- National Wildlife Refuge
- Water Fowl Production Area

2014 NAIP Imagery

Vantage Pipeline US LP


West Spur Lateral Pipeline
Asbuilt Mapbook
Page 1 1 : 12,000

Date: 04/20/2016 Version: 2016-1

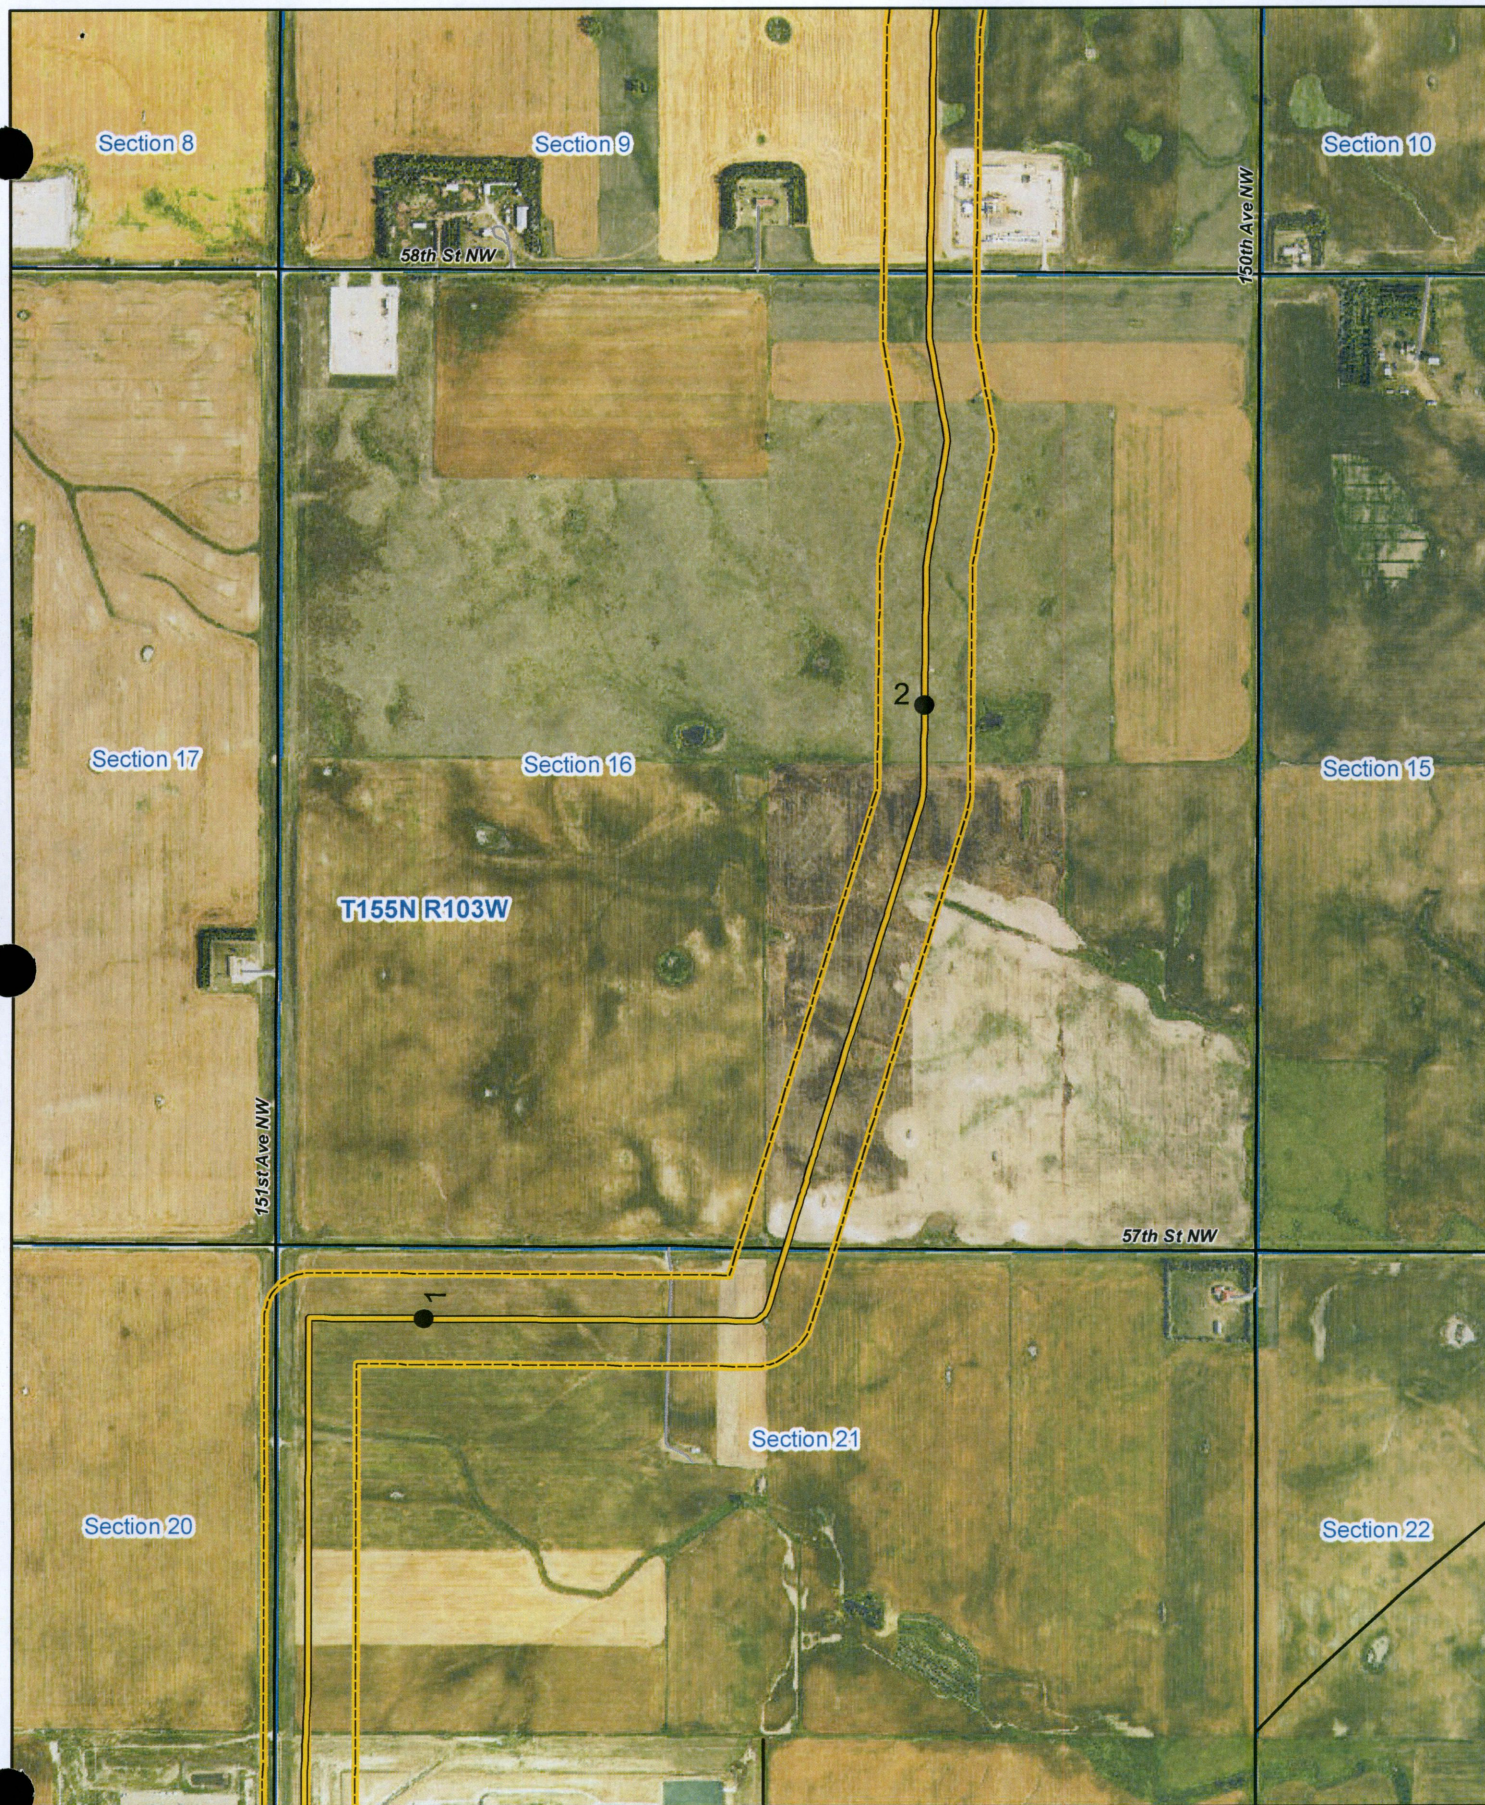

KC HARVEY

376 Gallatin Park Drive
Bozeman, MT 59715
www.kcharvey.com

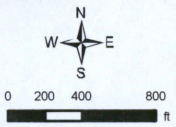

- | | | | |
|------------------------------|--------------|----------|----------------------------|
| Asbuilt Route | Highway | County | State Land |
| Issued Route | Local Road | Township | National Wildlife Refuge |
| Issued Route Survey Corridor | Private Road | Section | Water Fowl Production Area |
| | Trail | | |
- 2014 NAIP Imagery*


Vantage Pipeline US LP

West Spur Lateral Pipeline
Asbuilt Mapbook

Page 2 1 : 12,000
Date: 04/20/2016 Version: 2016-1




KC HARVEY
 376 Gallatin Park Drive
 Bozeman, MT 59715
 www.kcharvey.com

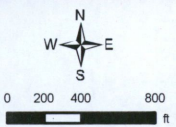


- | | | | |
|------------------------------|--------------|----------|----------------------------|
| Asbuilt Route | Highway | County | State Land |
| Issued Route | Local Road | Township | National Wildlife Refuge |
| Issued Route Survey Corridor | Private Road | Section | Water Fowl Production Area |
| | Trail | | |
- 2014 NAIP Imagery*

Vantage Pipeline US LP
 West Spur Lateral Pipeline
 Asbuilt Mapbook
 Page 3 1 : 12,000
 Date: 04/20/2016 Version: 2016-1

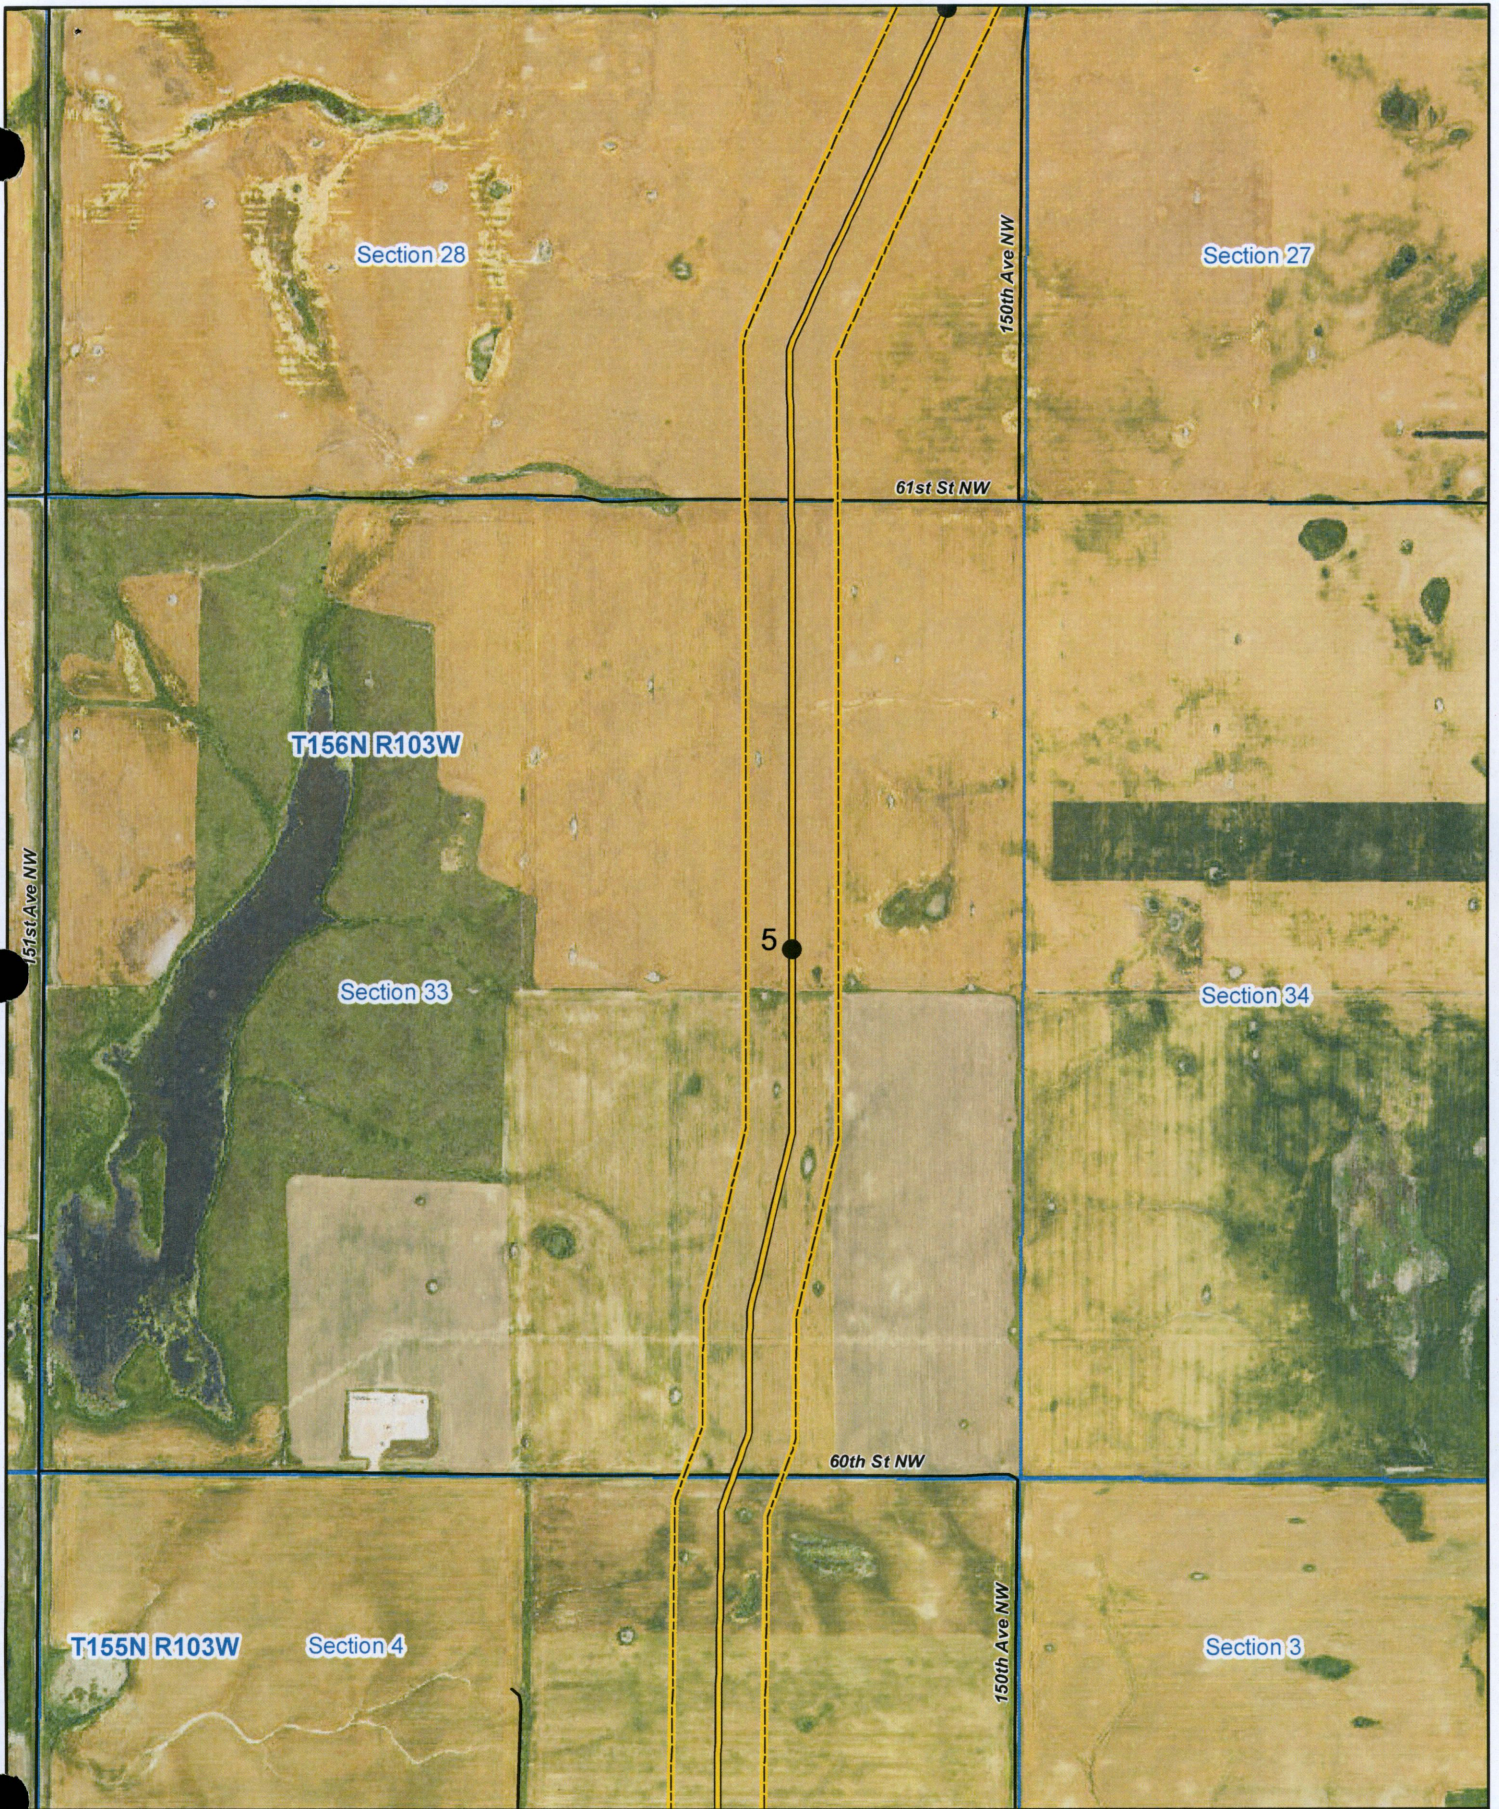

KC HARVEY

376 Gallatin Park Drive
Bozeman, MT 59715
www.kcharvey.com

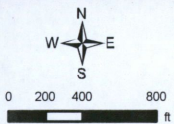

- Asbuilt Route
- - - Issued Route
- Issued Route Survey Corridor

- Highway
- Local Road
- Private Road
- Trail

- County
- Township
- Section

- State Land
- National Wildlife Refuge
- Water Fowl Production Area

2014 NAIP Imagery

Vantage Pipeline US LP


West Spur Lateral Pipeline
Asbuilt Mapbook
Page 4 1 : 12,000

Date: 04/20/2016 Version: 2016-1



KC HARVEY

376 Gallatin Park Drive
Bozeman, MT 59715
www.kcharvey.com

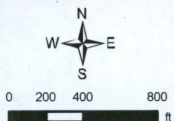

- Asbuilt Route
- Issued Route
- Issued Route Survey Corridor

- Highway
- Local Road
- Private Road
- Trail

- County
- Township
- Section


- State Land
- National Wildlife Refuge
- Water Fowl Production Area

2014 NAIP Imagery

Vantage Pipeline US LP

West Spur Lateral Pipeline
Asbuilt Mapbook
Page 5 1 : 12,000

Date: 04/20/2016 Version: 2016-1

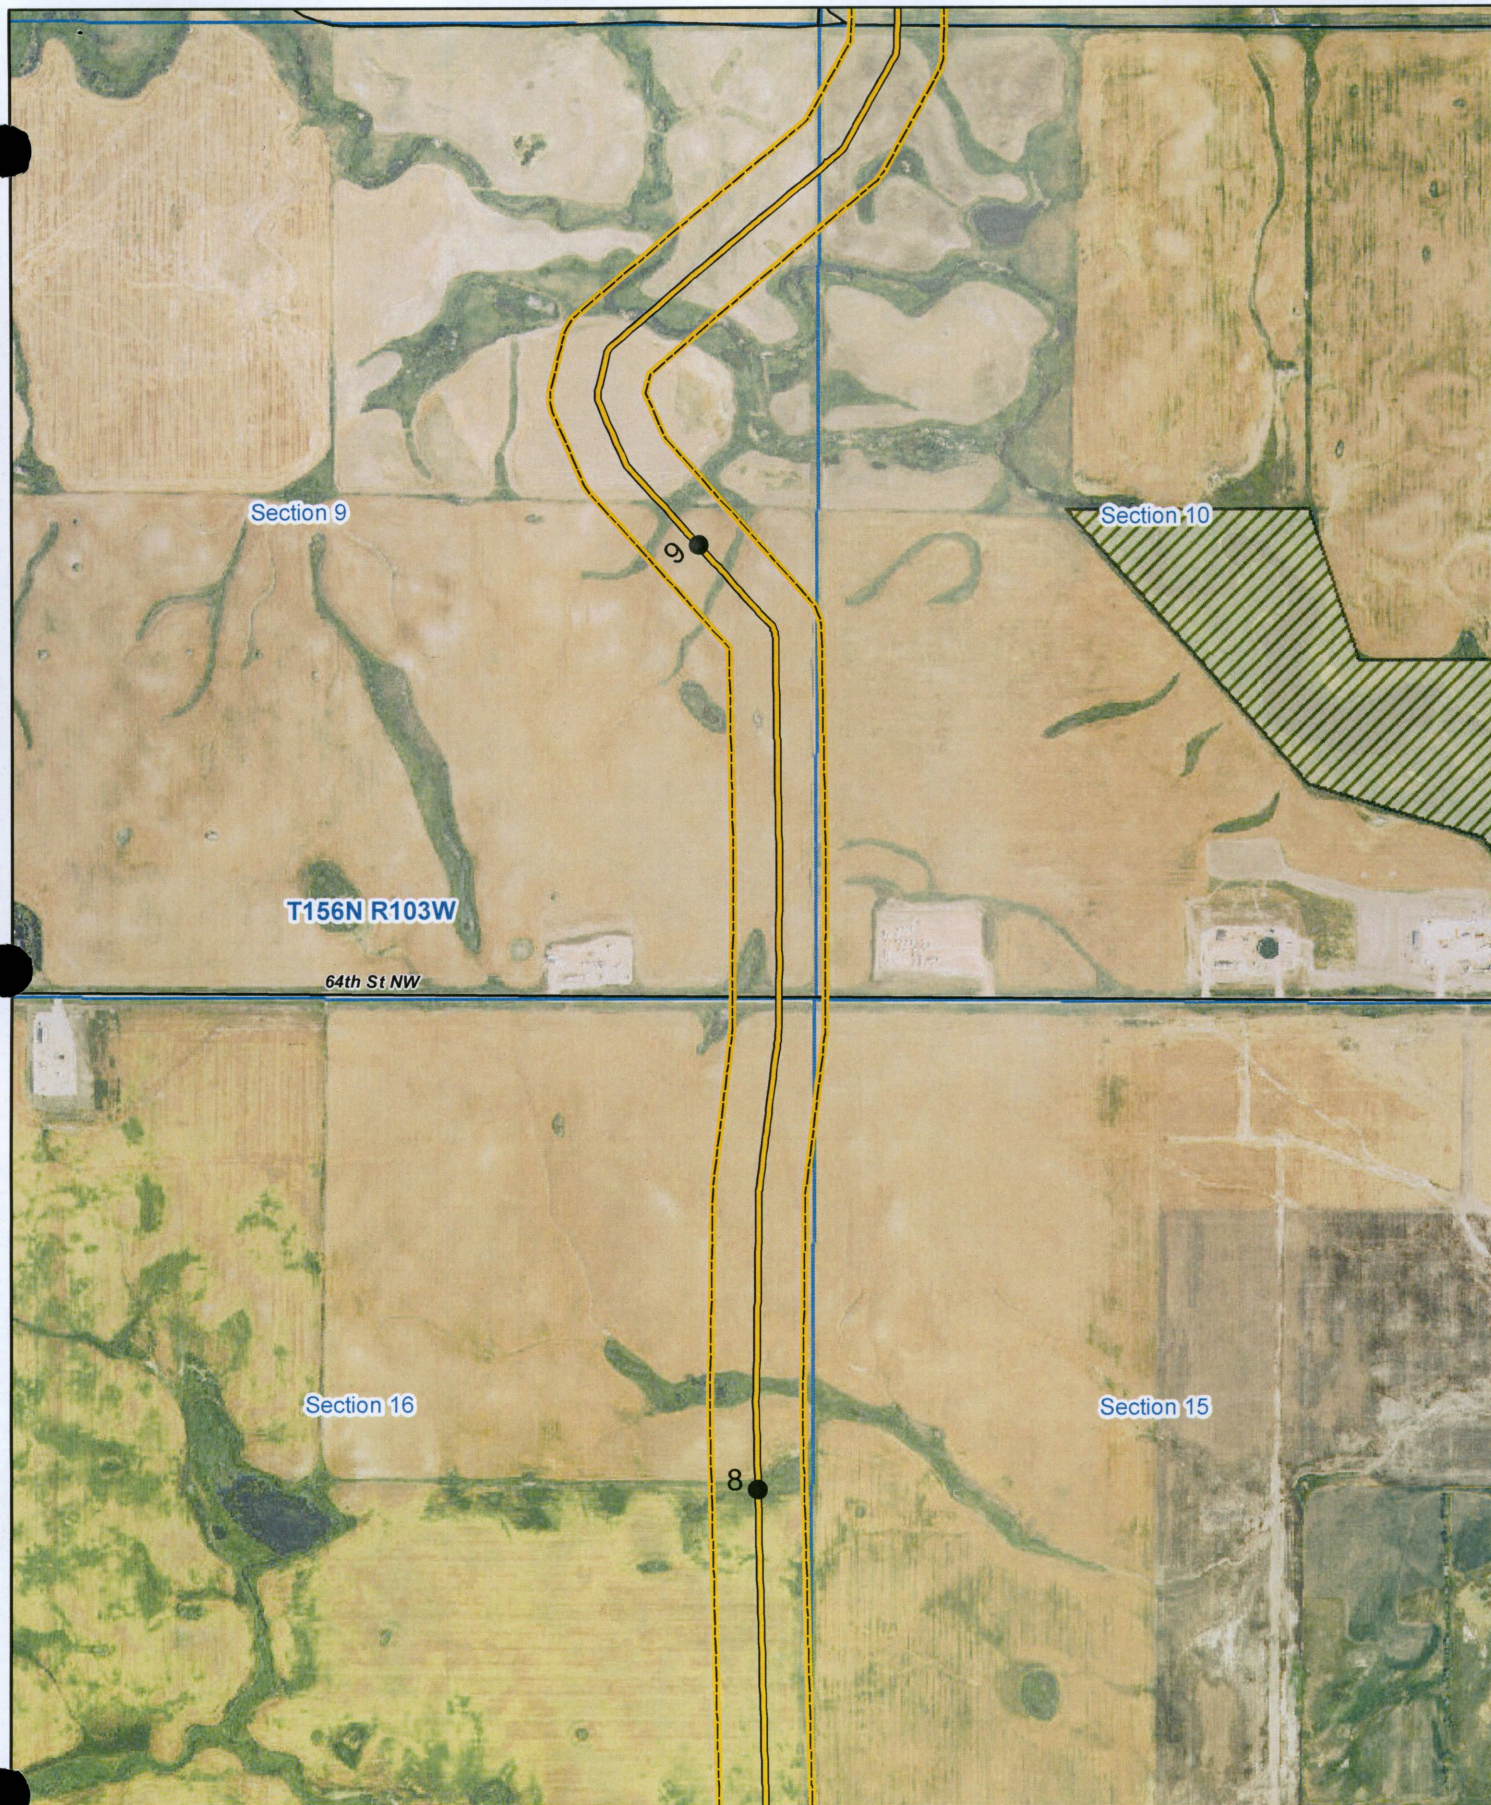

T156N R103W


64th St NW

Section 16

Section 15

KC HARVEY

376 Gallatin Park Drive
Bozeman, MT 59715
www.kcharvey.com

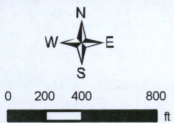


- | | | | |
|------------------------------|--------------|----------|----------------------------|
| Asbuilt Route | Highway | County | State Land |
| Issued Route | Local Road | Township | National Wildlife Refuge |
| Issued Route Survey Corridor | Private Road | Section | Water Fowl Production Area |
| | Trail | | |
- 2014 NAIP Imagery*

Vantage Pipeline US LP


West Spur Lateral Pipeline
Asbuilt Mapbook
Page 6 1 : 12,000

Date: 04/20/2016 Version: 2016-1

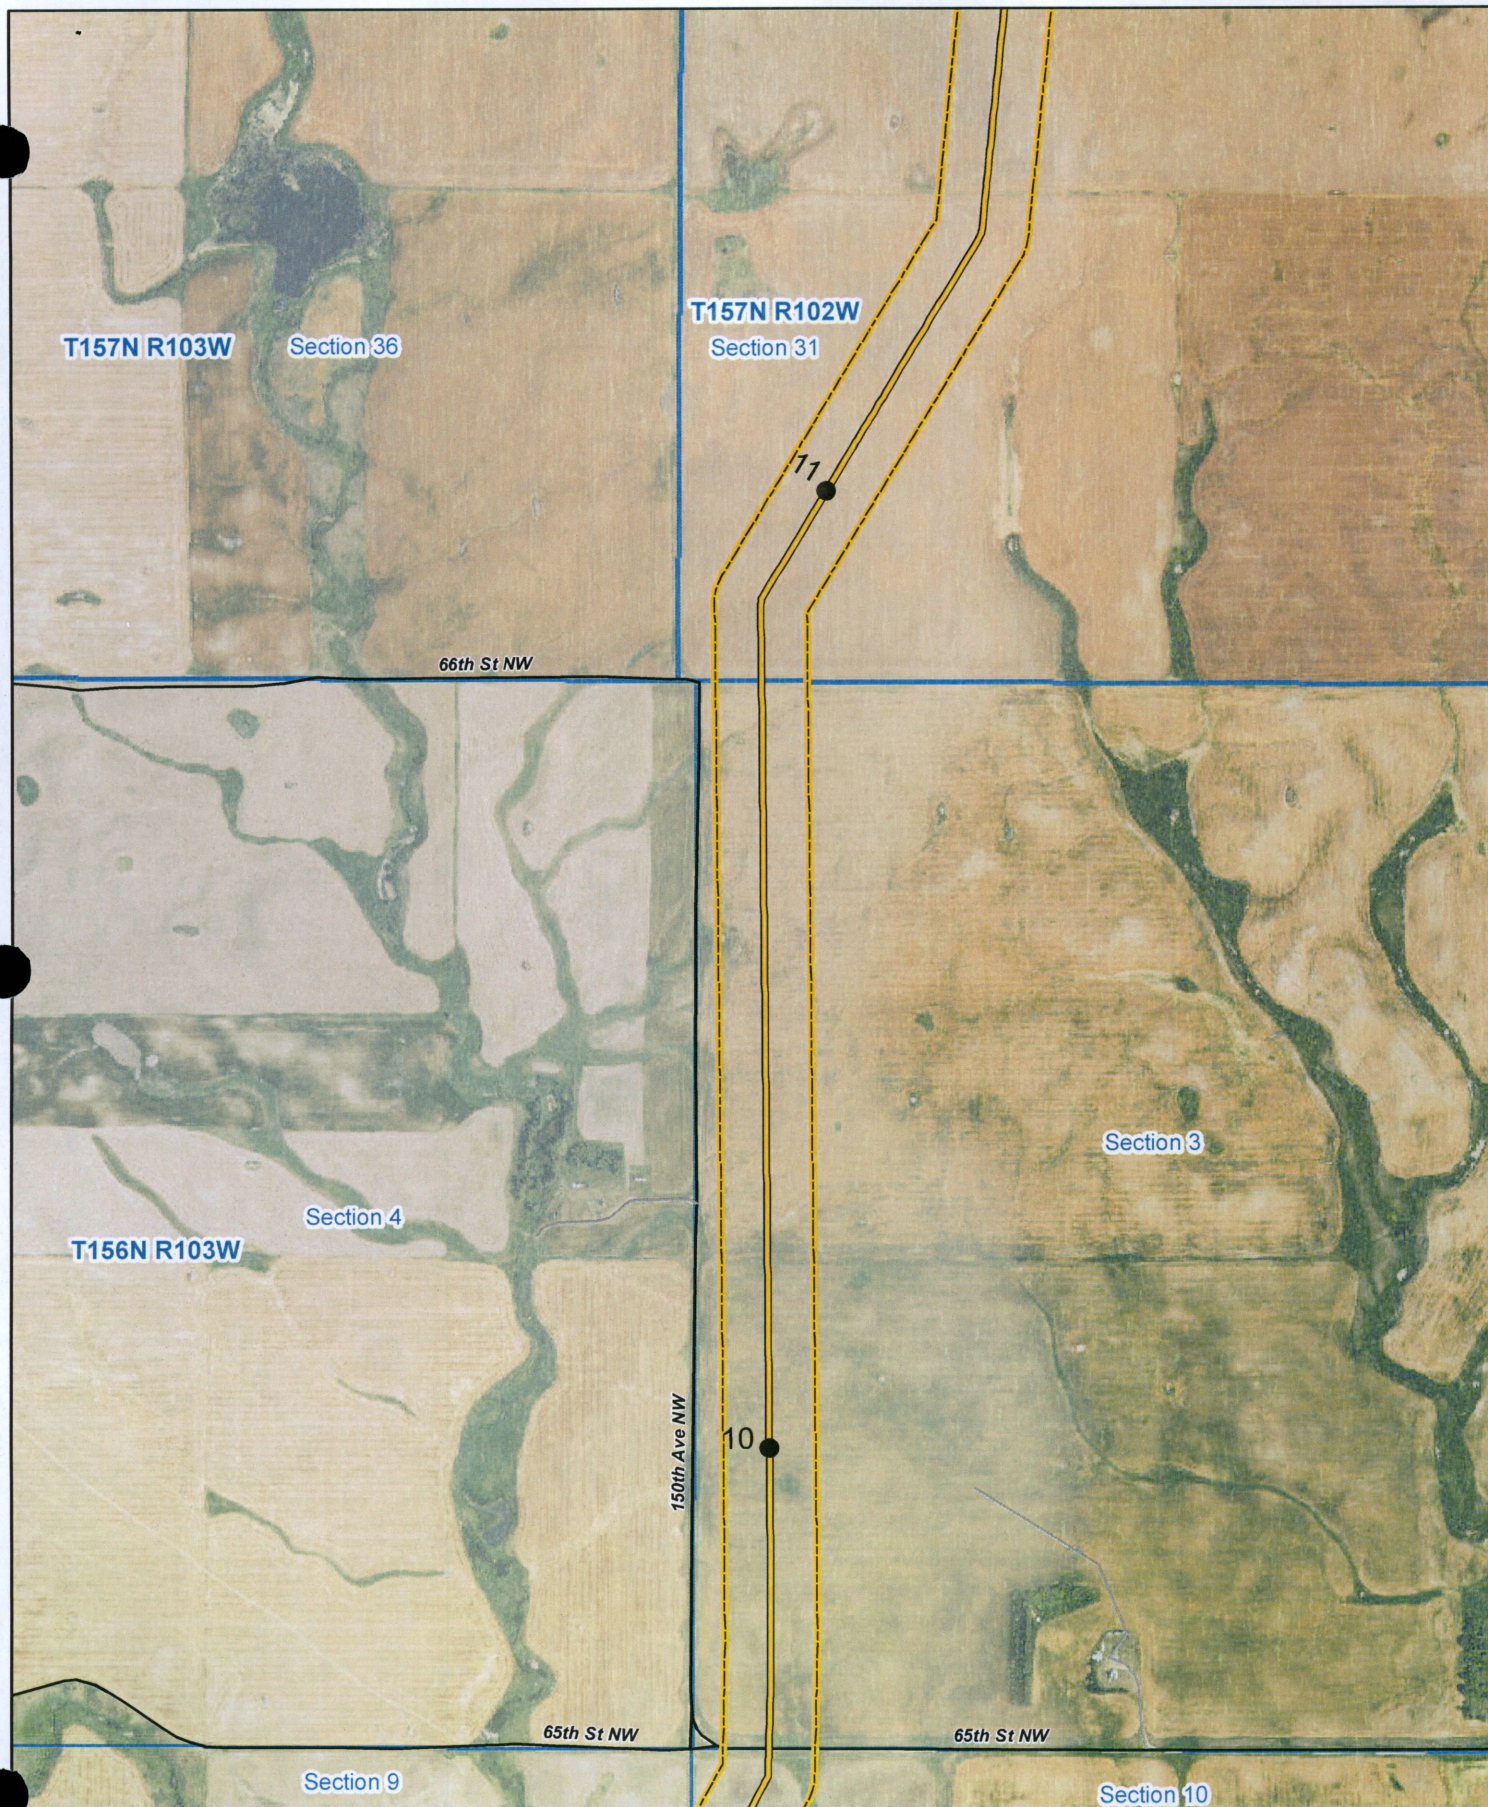

KC HARVEY

376 Gallatin Park Drive
Bozeman, MT 59715
www.kcharvey.com

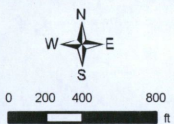

- Asbuilt Route
- - - Issued Route
- Issued Route Survey Corridor

- Highway
- Local Road
- Private Road
- Trail

- County
- Township
- Section


- State Land
- National Wildlife Refuge
- Water Fowl Production Area

2014 NAIP Imagery

Vantage Pipeline US LP


West Spur Lateral Pipeline
Asbuilt Mapbook
Page 7 1 : 12,000

Date: 04/20/2016 Version: 2016-1

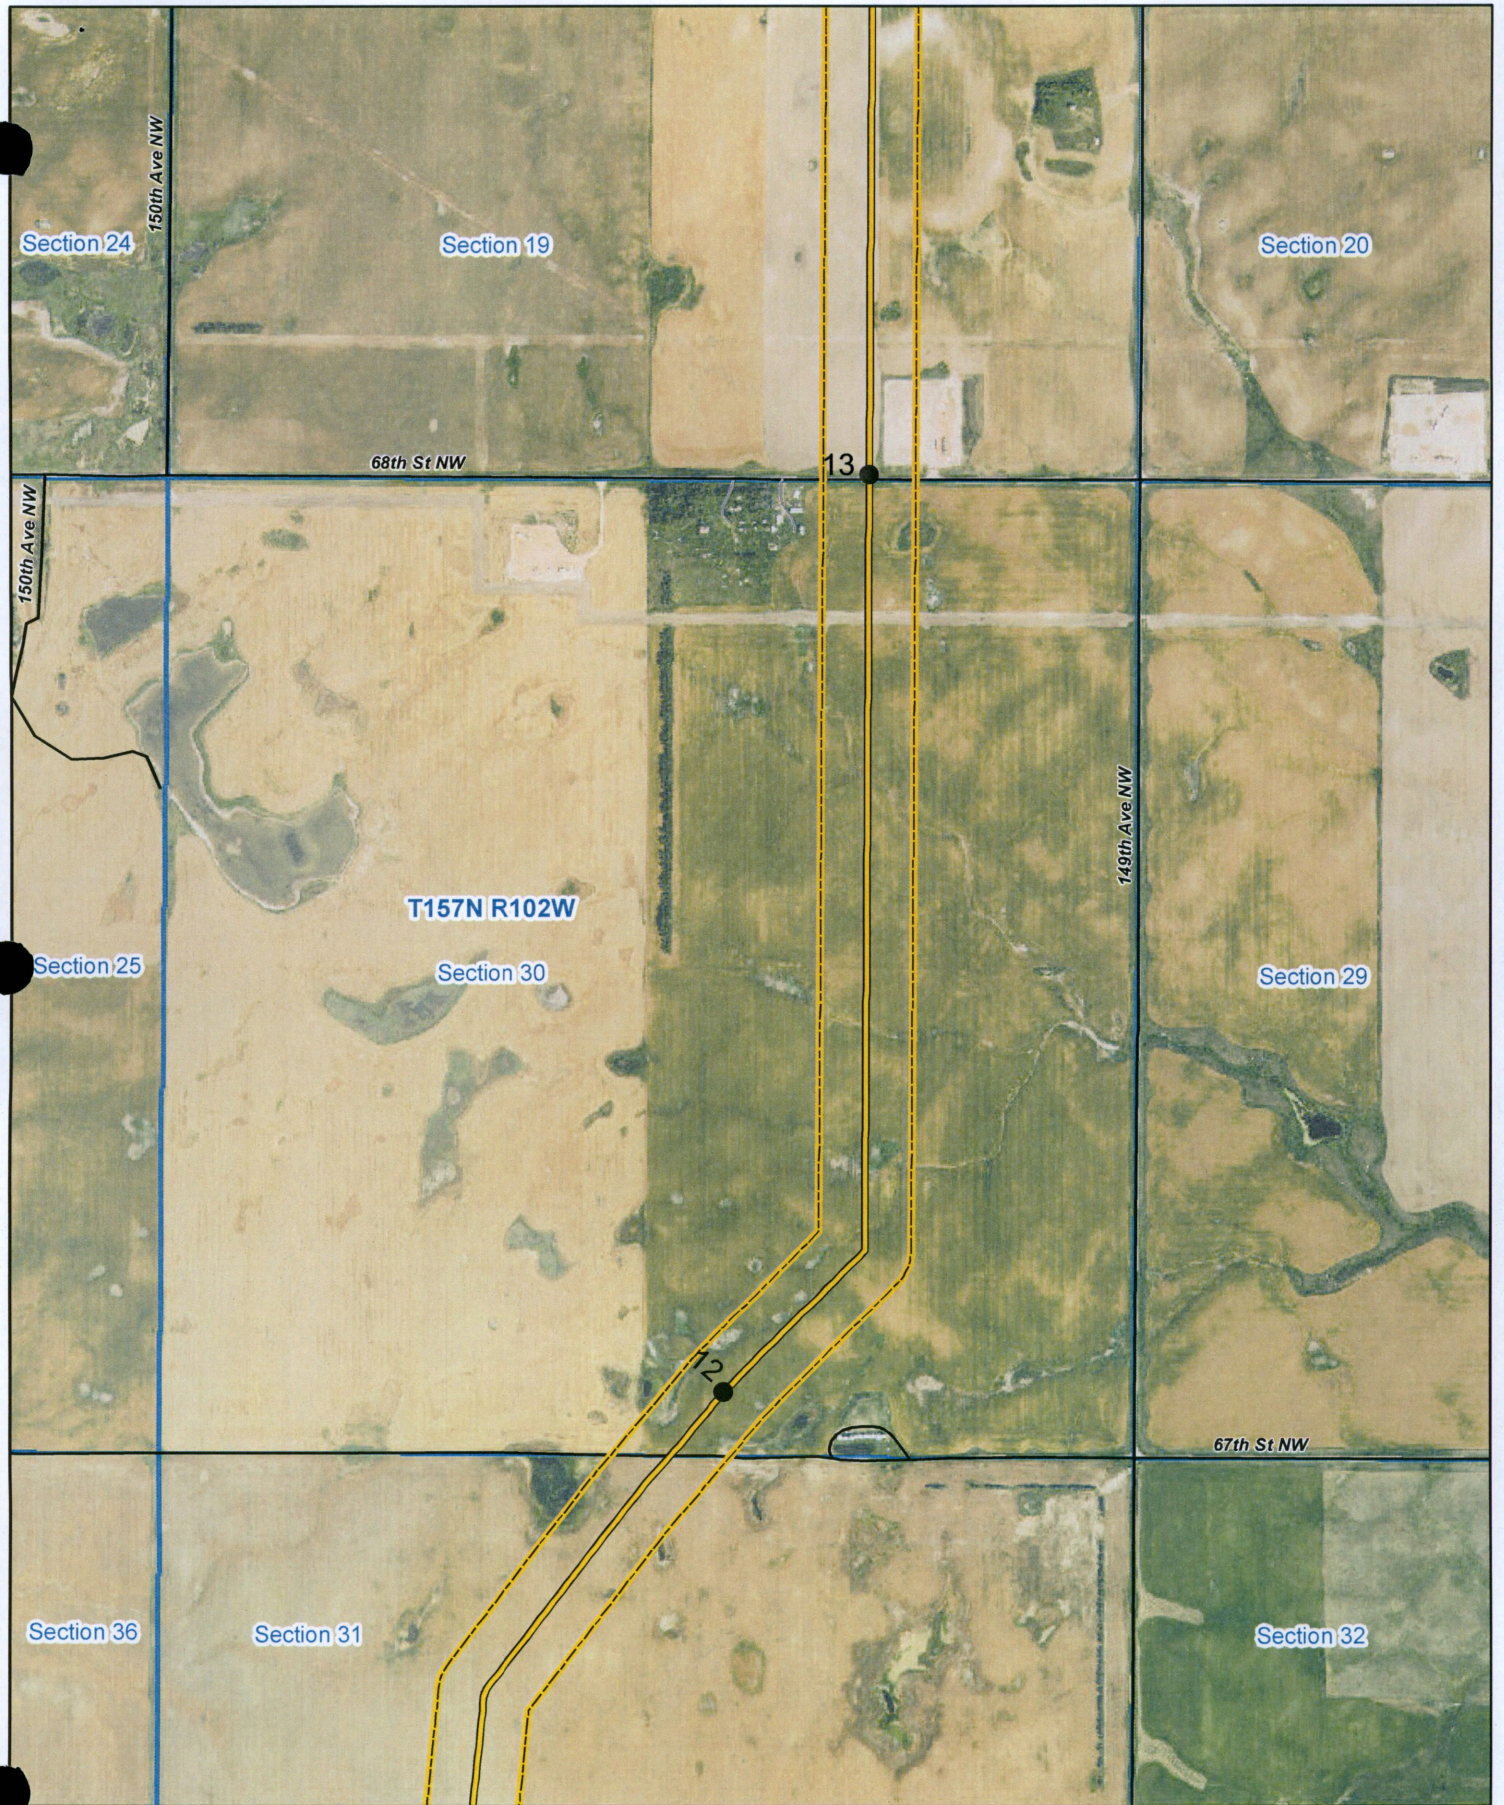

KC HARVEY

376 Gallatin Park Drive
Bozeman, MT 59715
www.kcharvey.com

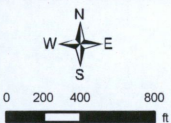

- Asbuilt Route
- Issued Route
- Issued Route Survey Corridor

- Highway
- Local Road
- Private Road
- Trail

- County
- Township
- Section

- State Land
- National Wildlife Refuge
- Water Fowl Production Area


2014 NAIP Imagery

Vantage Pipeline US LP

West Spur Lateral Pipeline
Asbuilt Mapbook


Page 8 1 : 12,000

Date: 04/20/2016 Version: 2016-1

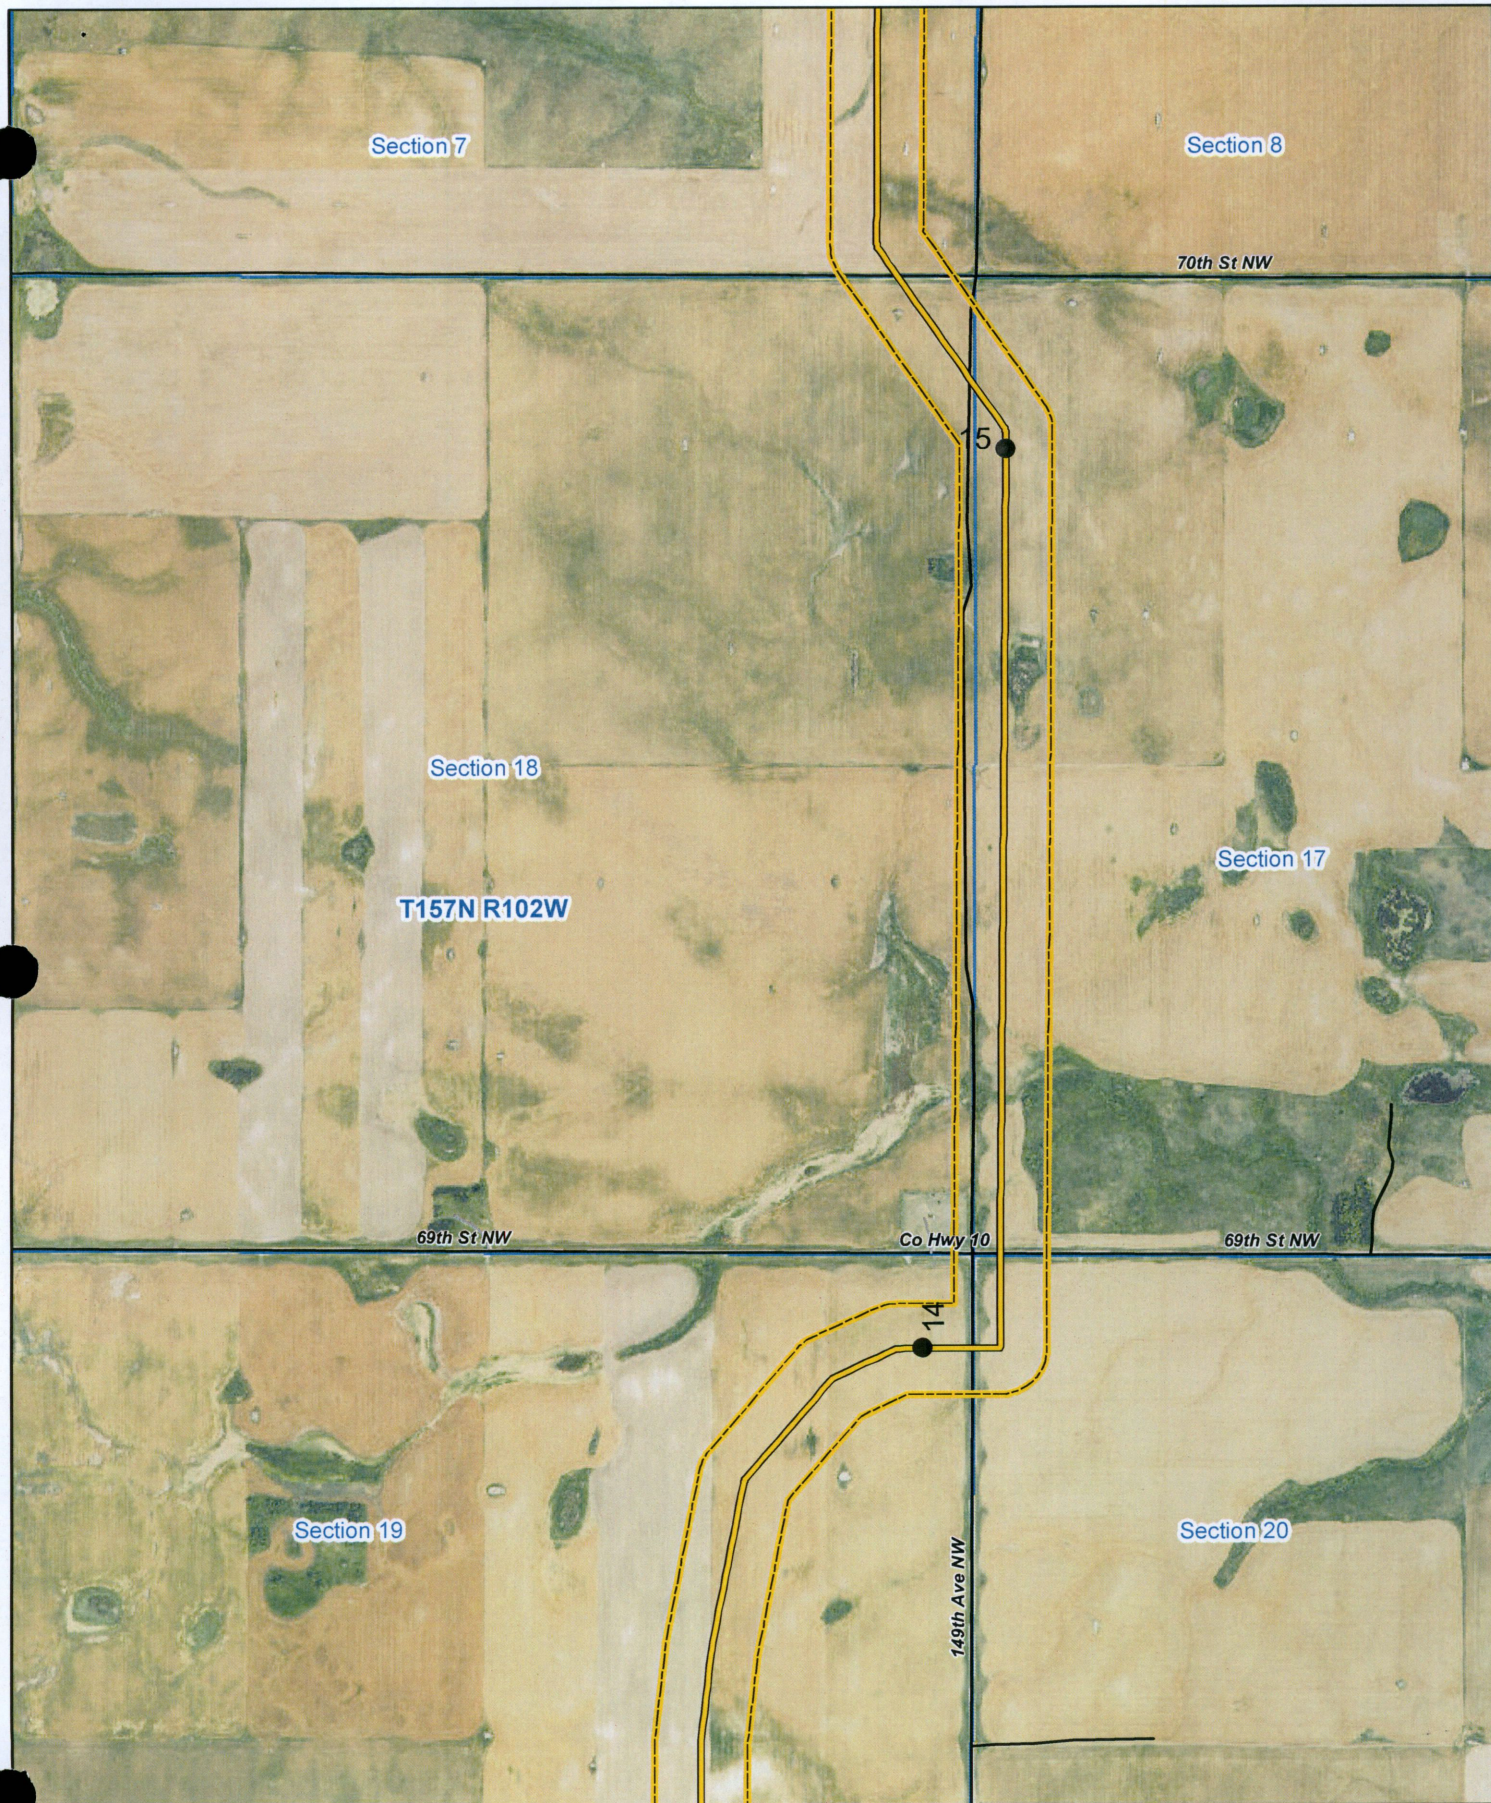

KC HARVEY

376 Gallatin Park Drive
Bozeman, MT 59715
www.kcharvey.com

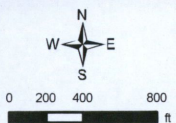

- Asbuilt Route
- - - Issued Route
- Issued Route Survey Corridor

- Highway
- Local Road
- Private Road
- Trail

- County
- Township
- Section


- State Land
- National Wildlife Refuge
- Water Fowl Production Area

2014 NAIP Imagery


Vantage Pipeline US LP

West Spur Lateral Pipeline
Asbuilt Mapbook
Page 9 1 : 12,000

Date: 04/20/2016 Version: 2016-1

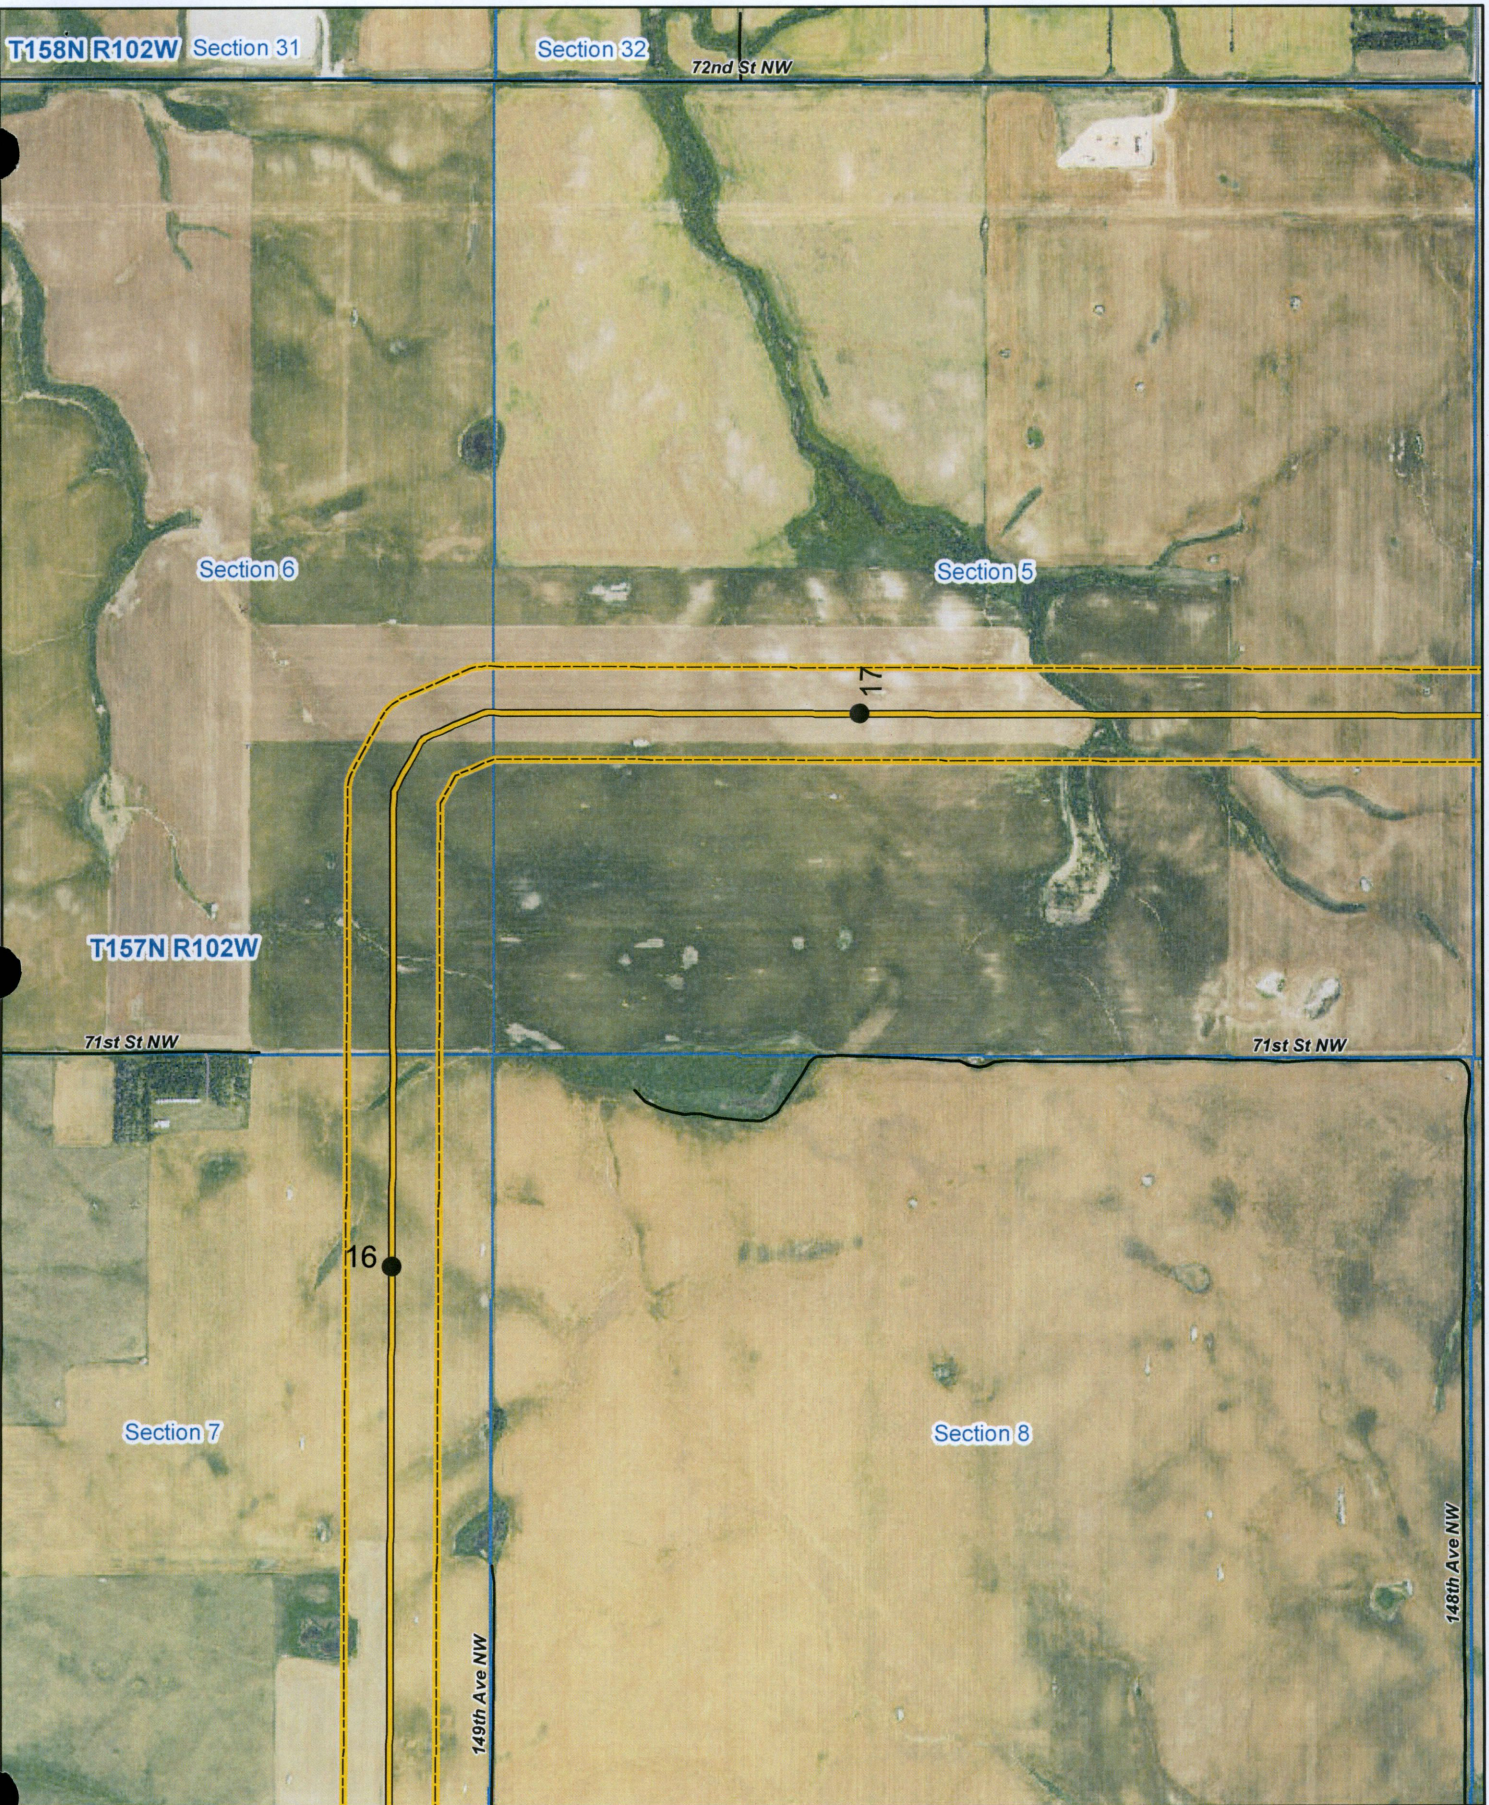

KC HARVEY
 376 Gallatin Park Drive
 Bozeman, MT 59715
 www.kcharvey.com

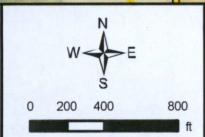


- Asbuilt Route
 - - - Issued Route
 - Issued Route Survey Corridor
 - Highway
 - Local Road
 - Private Road
 - Trail
 - County
 - Township
 - Section
 - State Land
 - National Wildlife Refuge
 - Water Fowl Production Area
- 2014 NAIP Imagery

Vantage Pipeline US LP
 West Spur Lateral Pipeline
 Asbuilt Mapbook
 Page 10 1 : 12,000
 Date: 04/20/2016 Version: 2016-1




KC HARVEY
 376 Gallatin Park Drive
 Bozeman, MT 59715
 www.kcharvey.com

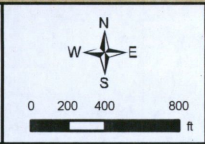


- | | | | |
|------------------------------|--------------|----------|----------------------------|
| Asbuilt Route | Highway | County | State Land |
| Issued Route | Local Road | Township | National Wildlife Refuge |
| Issued Route Survey Corridor | Private Road | Section | Water Fowl Production Area |
| | Trail | | |
- 2014 NAIP Imagery*

Vantage Pipeline US LP
 West Spur Lateral Pipeline
 Asbuilt Mapbook
 Page 11 1 : 12,000
 Date: 04/20/2016 Version: 2016-1

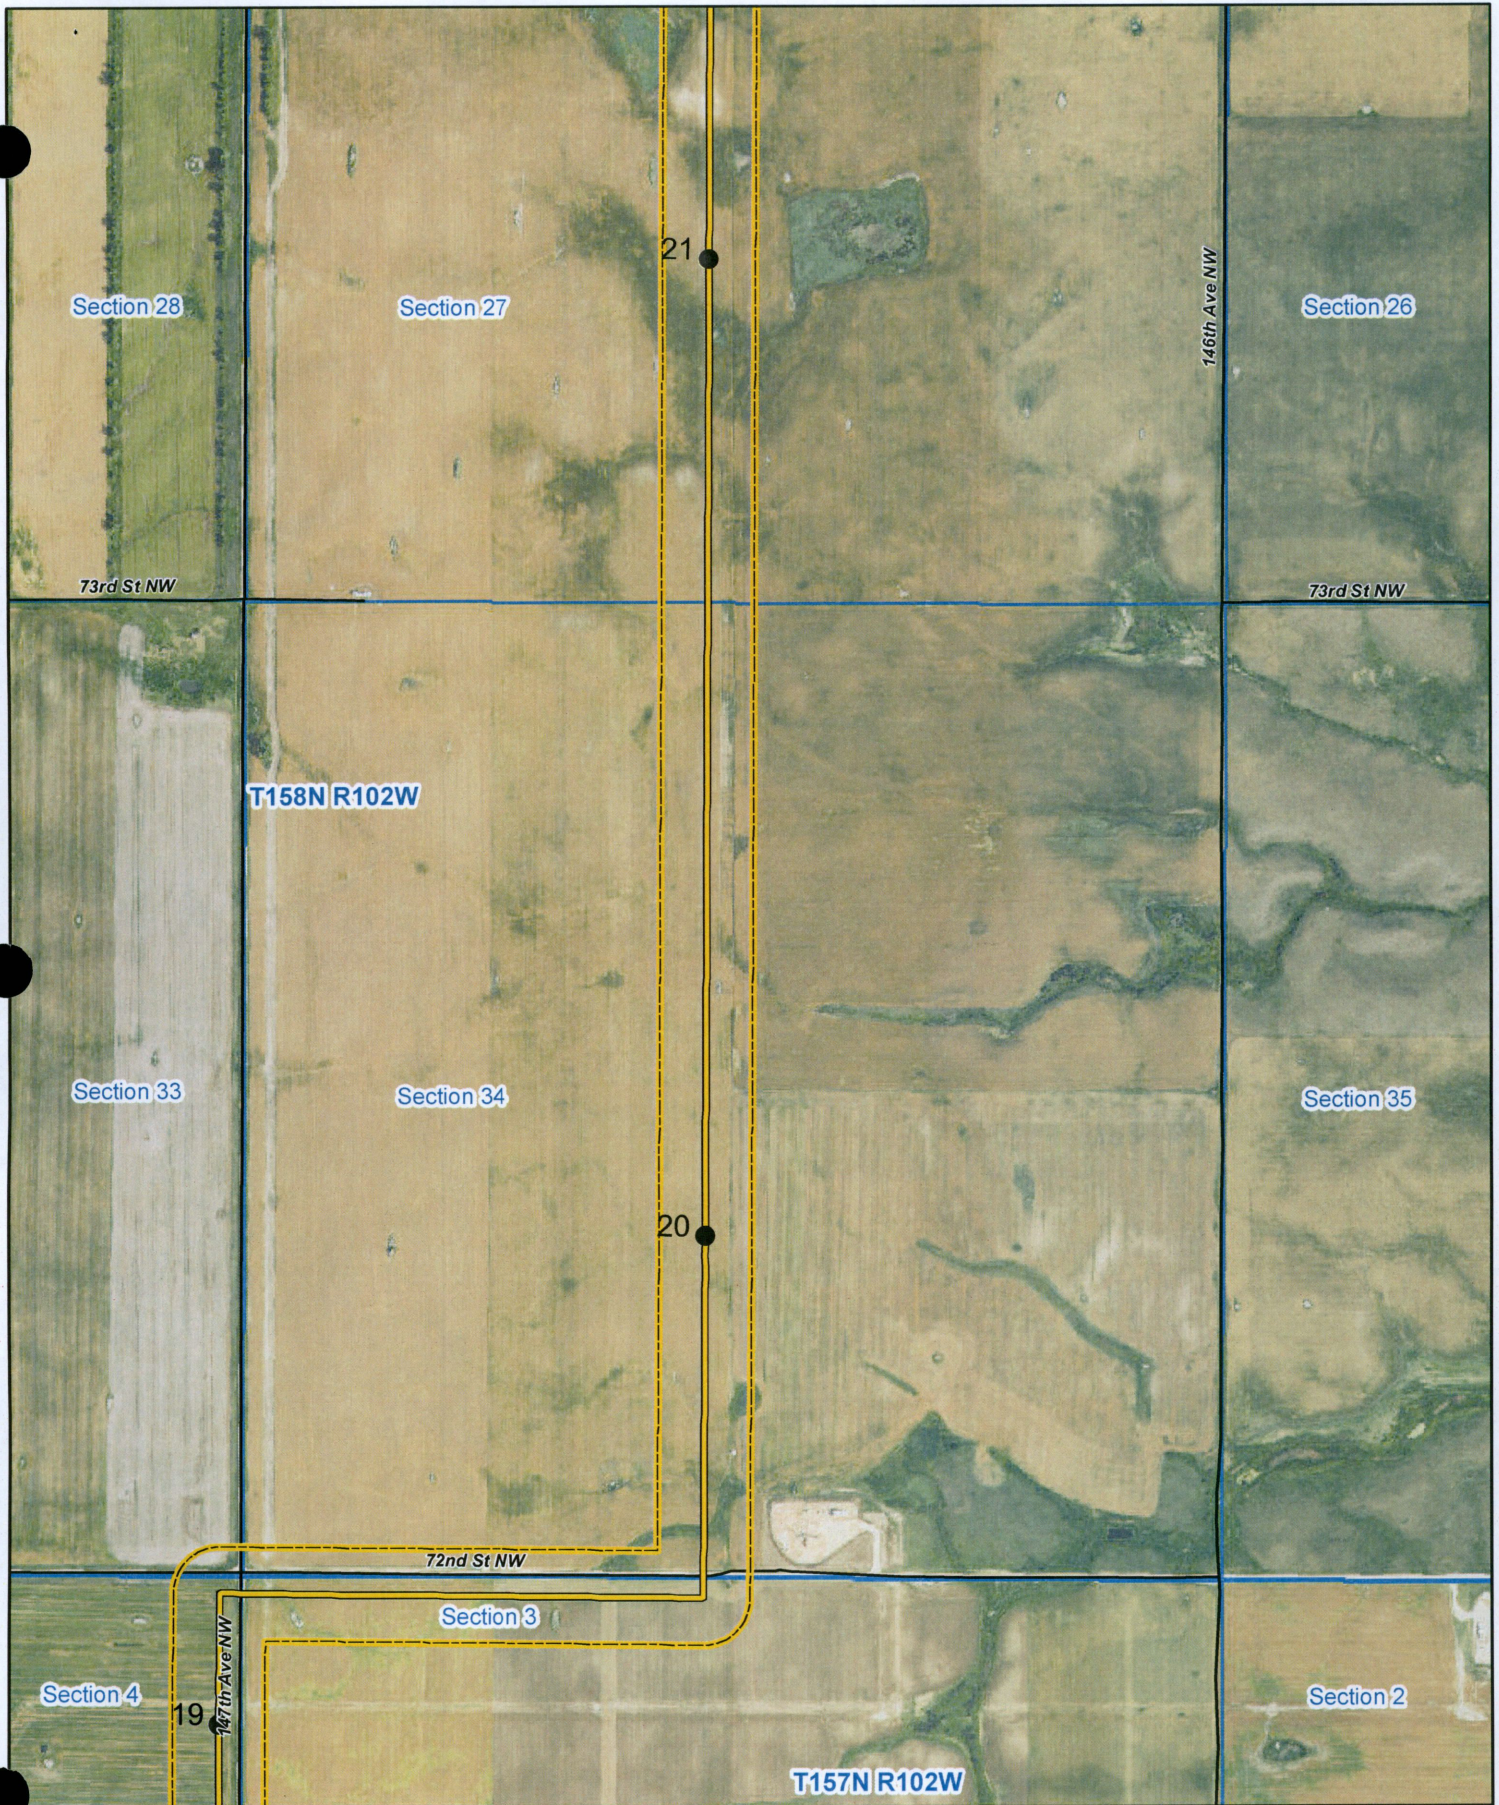

KC HARVEY

376 Gallatin Park Drive
Bozeman, MT 59715
www.kcharvey.com

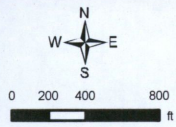

- Asbuilt Route
- - - Issued Route
- Issued Route Survey Corridor

- Highway
- Local Road
- Private Road
- Trail

- County
- Township
- Section


- State Land
- National Wildlife Refuge
- Water Fowl Production Area

2014 NAIP Imagery

Vantage Pipeline US LP


West Spur Lateral Pipeline
Asbuilt Mapbook
Page 12 1 : 12,000

Date: 04/20/2016 Version: 2016-1

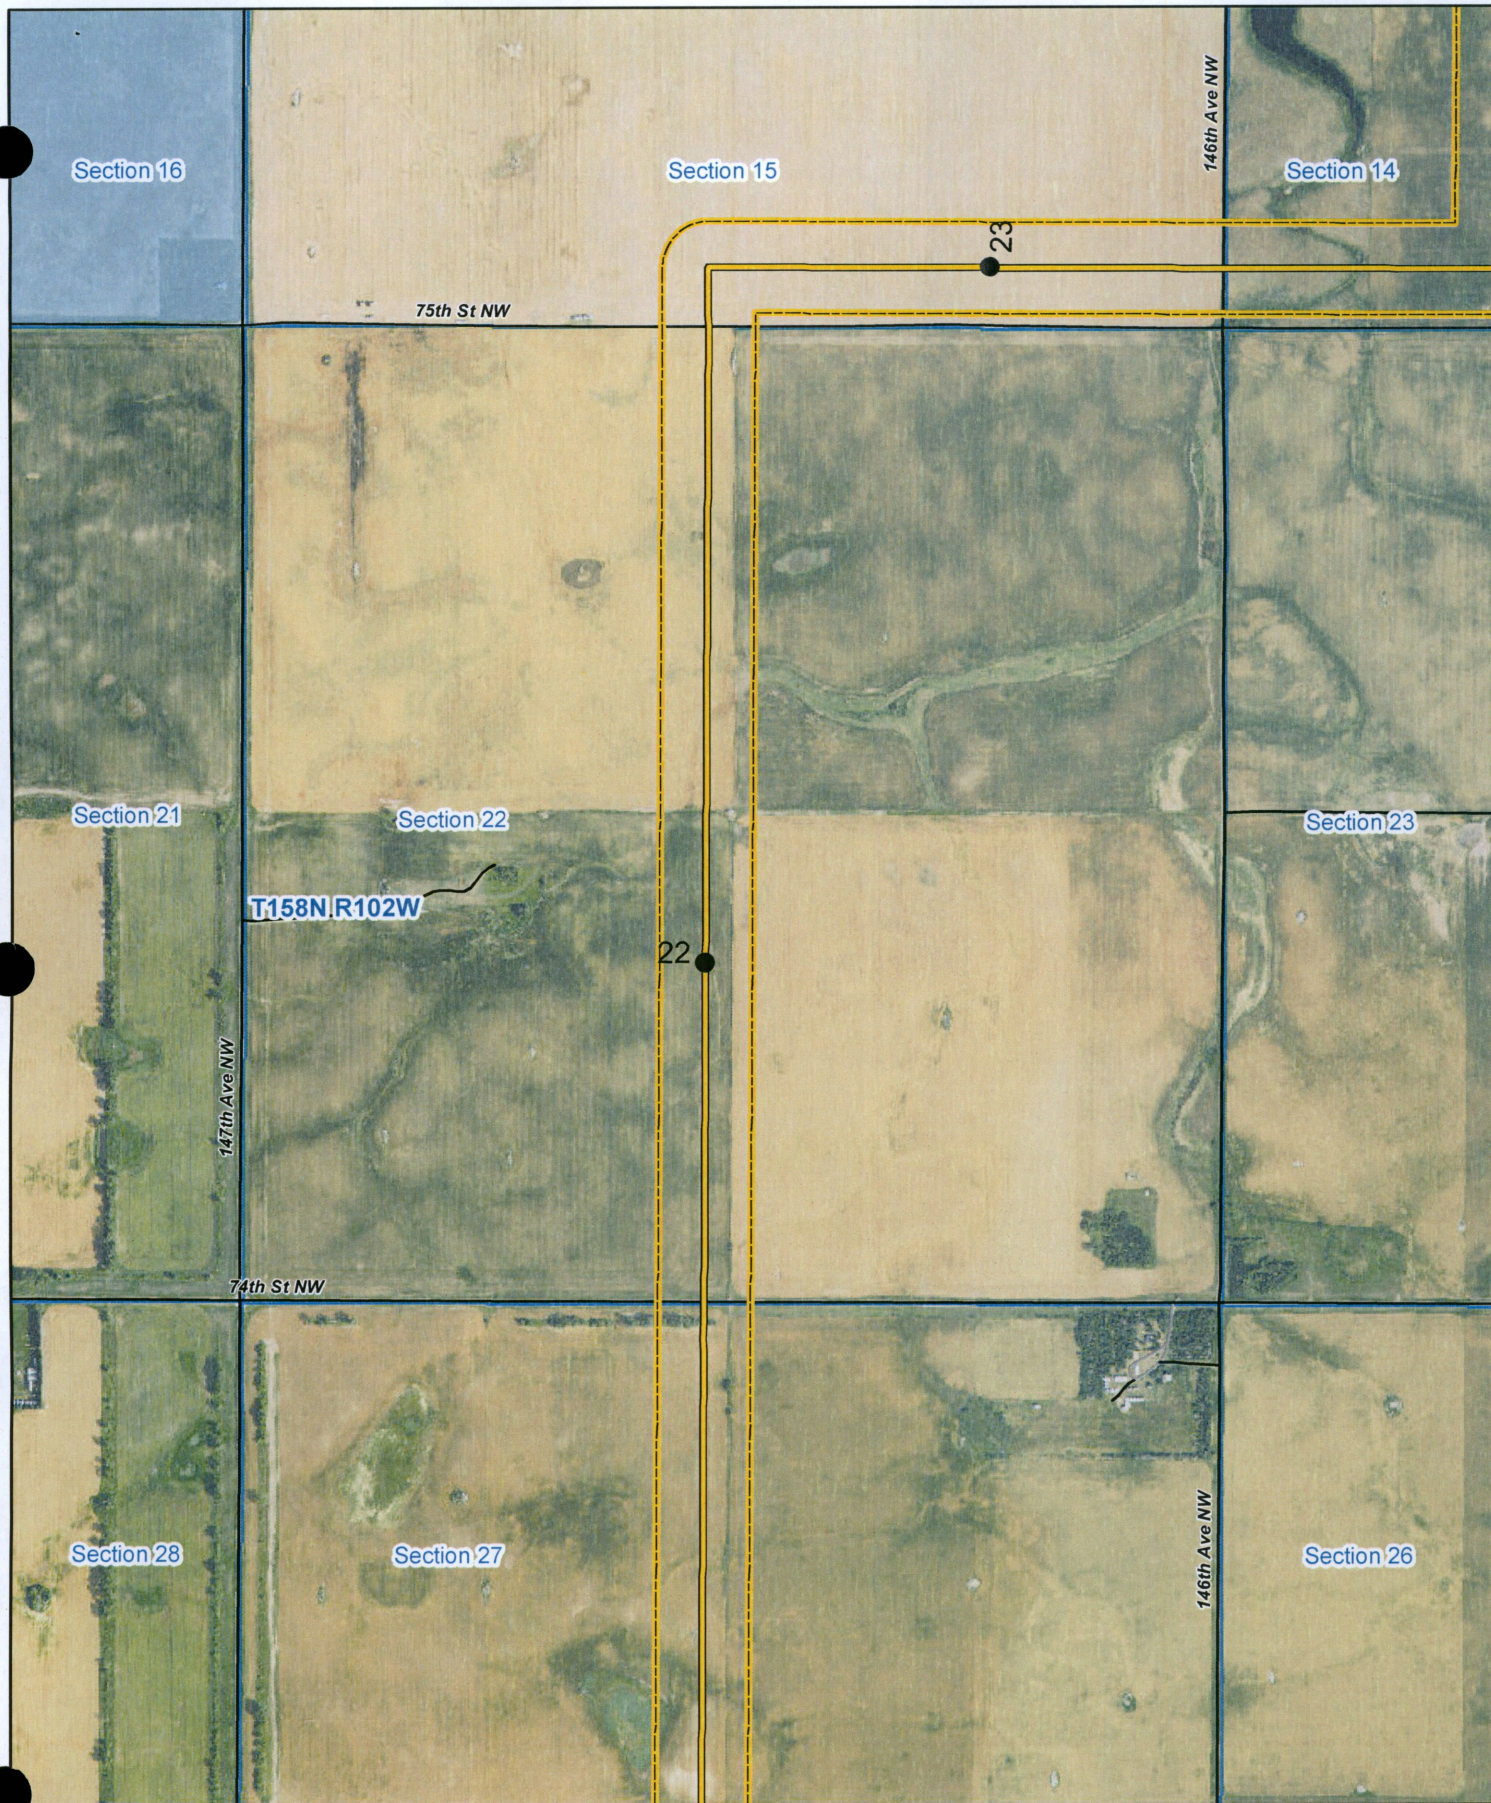

KC HARVEY

376 Gallatin Park Drive
Bozeman, MT 59715
www.kcharvey.com

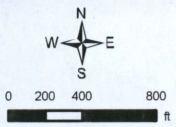

- Asbuilt Route
- - - Issued Route
- Issued Route Survey Corridor

- Highway
- Local Road
- Private Road
- Trail

- County
- Township
- Section


- State Land
- National Wildlife Refuge
- Water Fowl Production Area

2014 NAIP Imagery

Vantage Pipeline US LP


West Spur Lateral Pipeline
Asbuilt Mapbook
Page 13 1 : 12,000

Date: 04/20/2016 Version: 2016-1

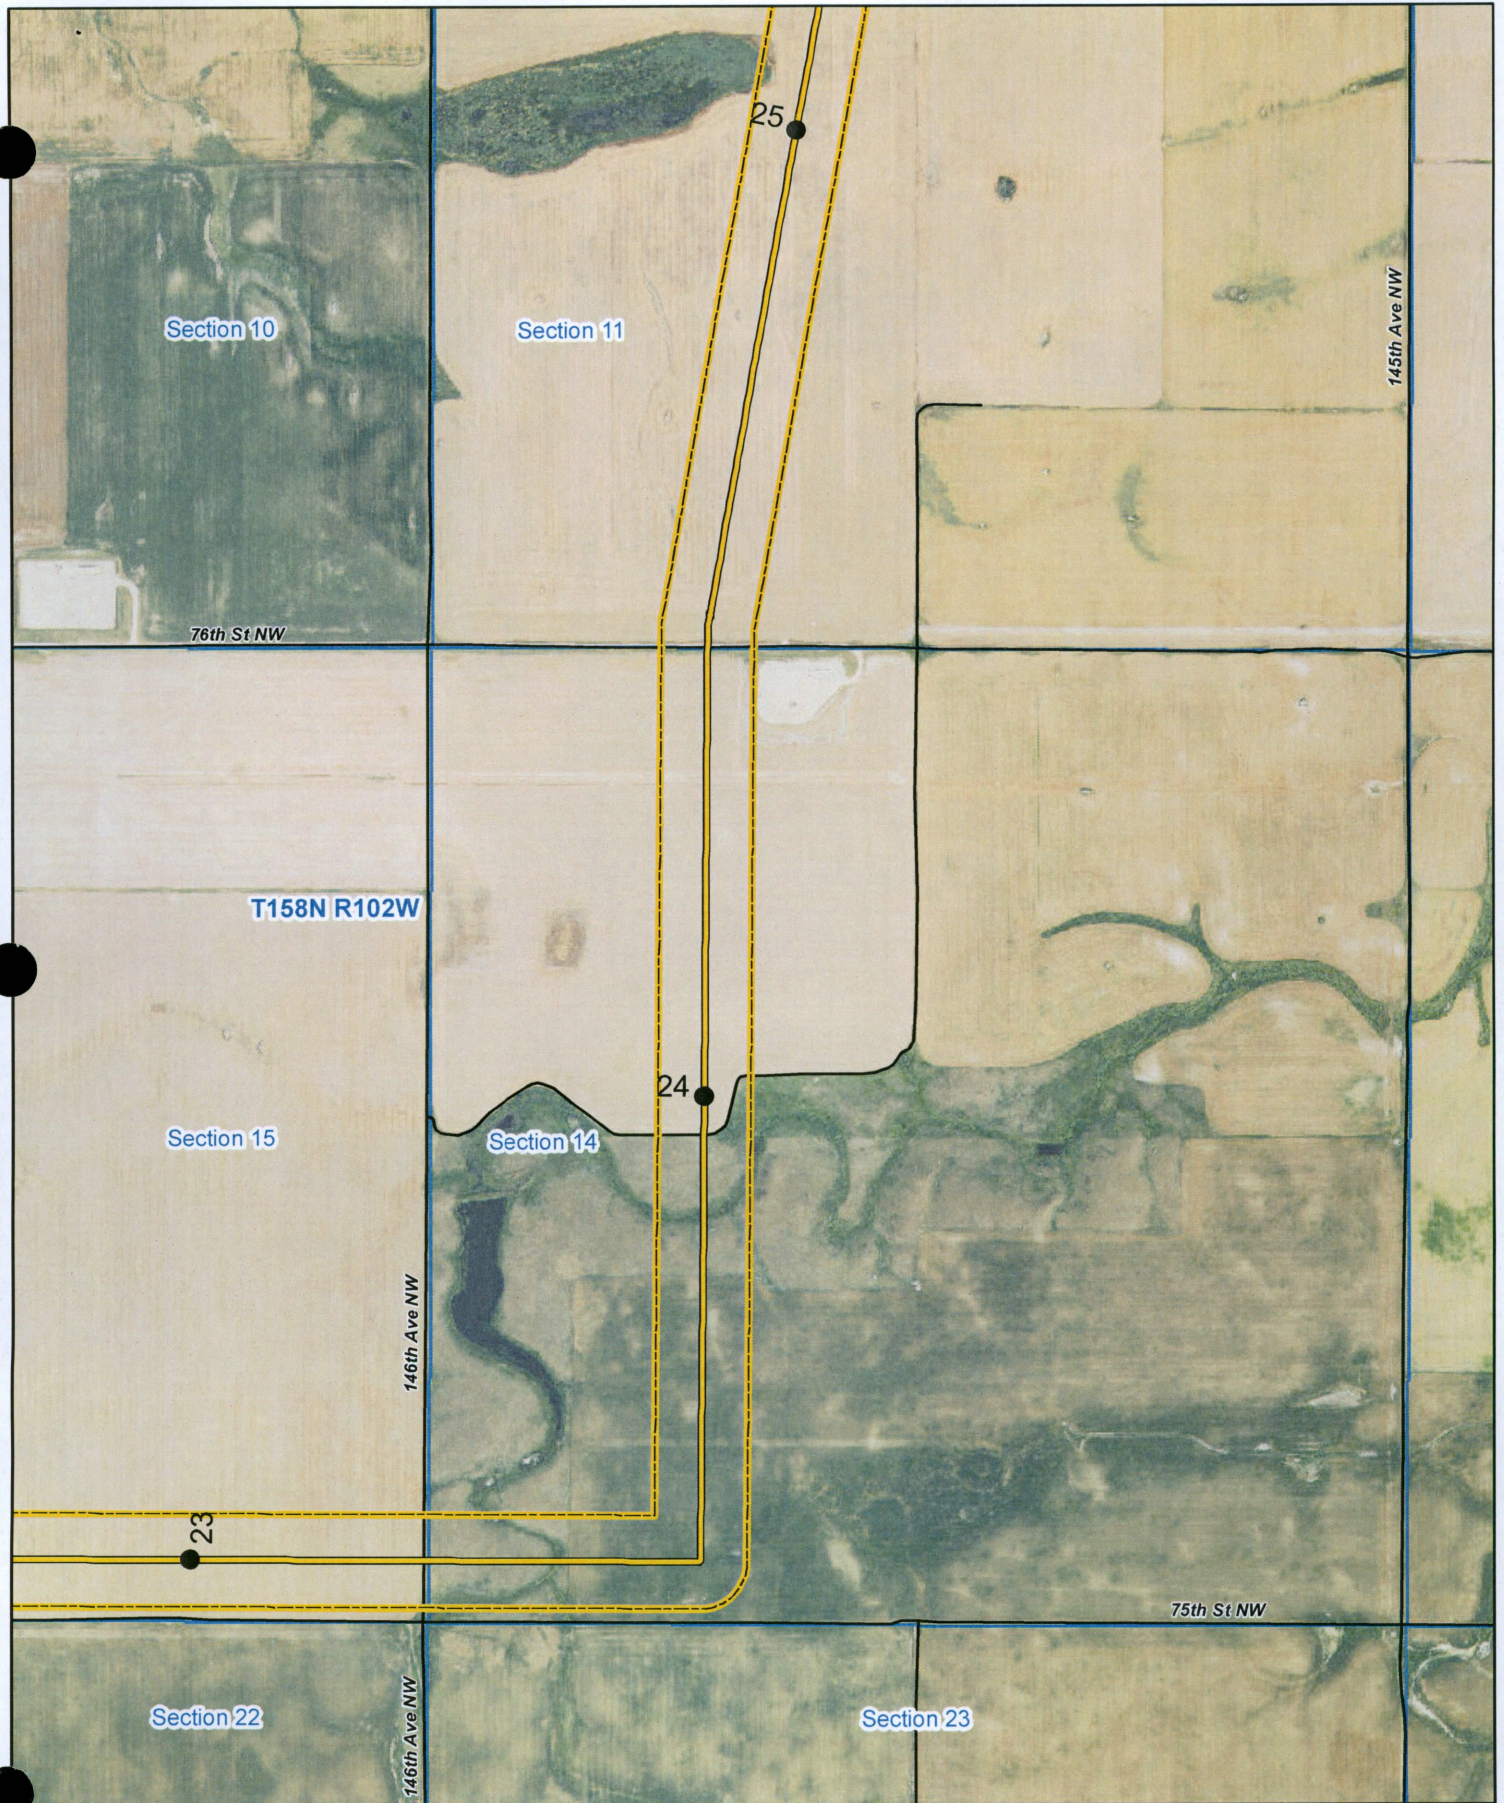

KC HARVEY

376 Gallatin Park Drive
Bozeman, MT 59715
www.kcharvey.com

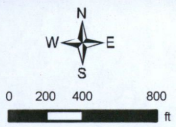


- | | | | |
|------------------------------|--------------|----------|----------------------------|
| Asbuilt Route | Highway | County | State Land |
| Issued Route | Local Road | Township | National Wildlife Refuge |
| Issued Route Survey Corridor | Private Road | Section | Water Fowl Production Area |
| | Trail | | |
- 2014 NAIP Imagery*

Vantage Pipeline US LP


West Spur Lateral Pipeline
Asbuilt Mapbook
Page 14 1 : 12,000

Date: 04/20/2016 Version: 2016-1

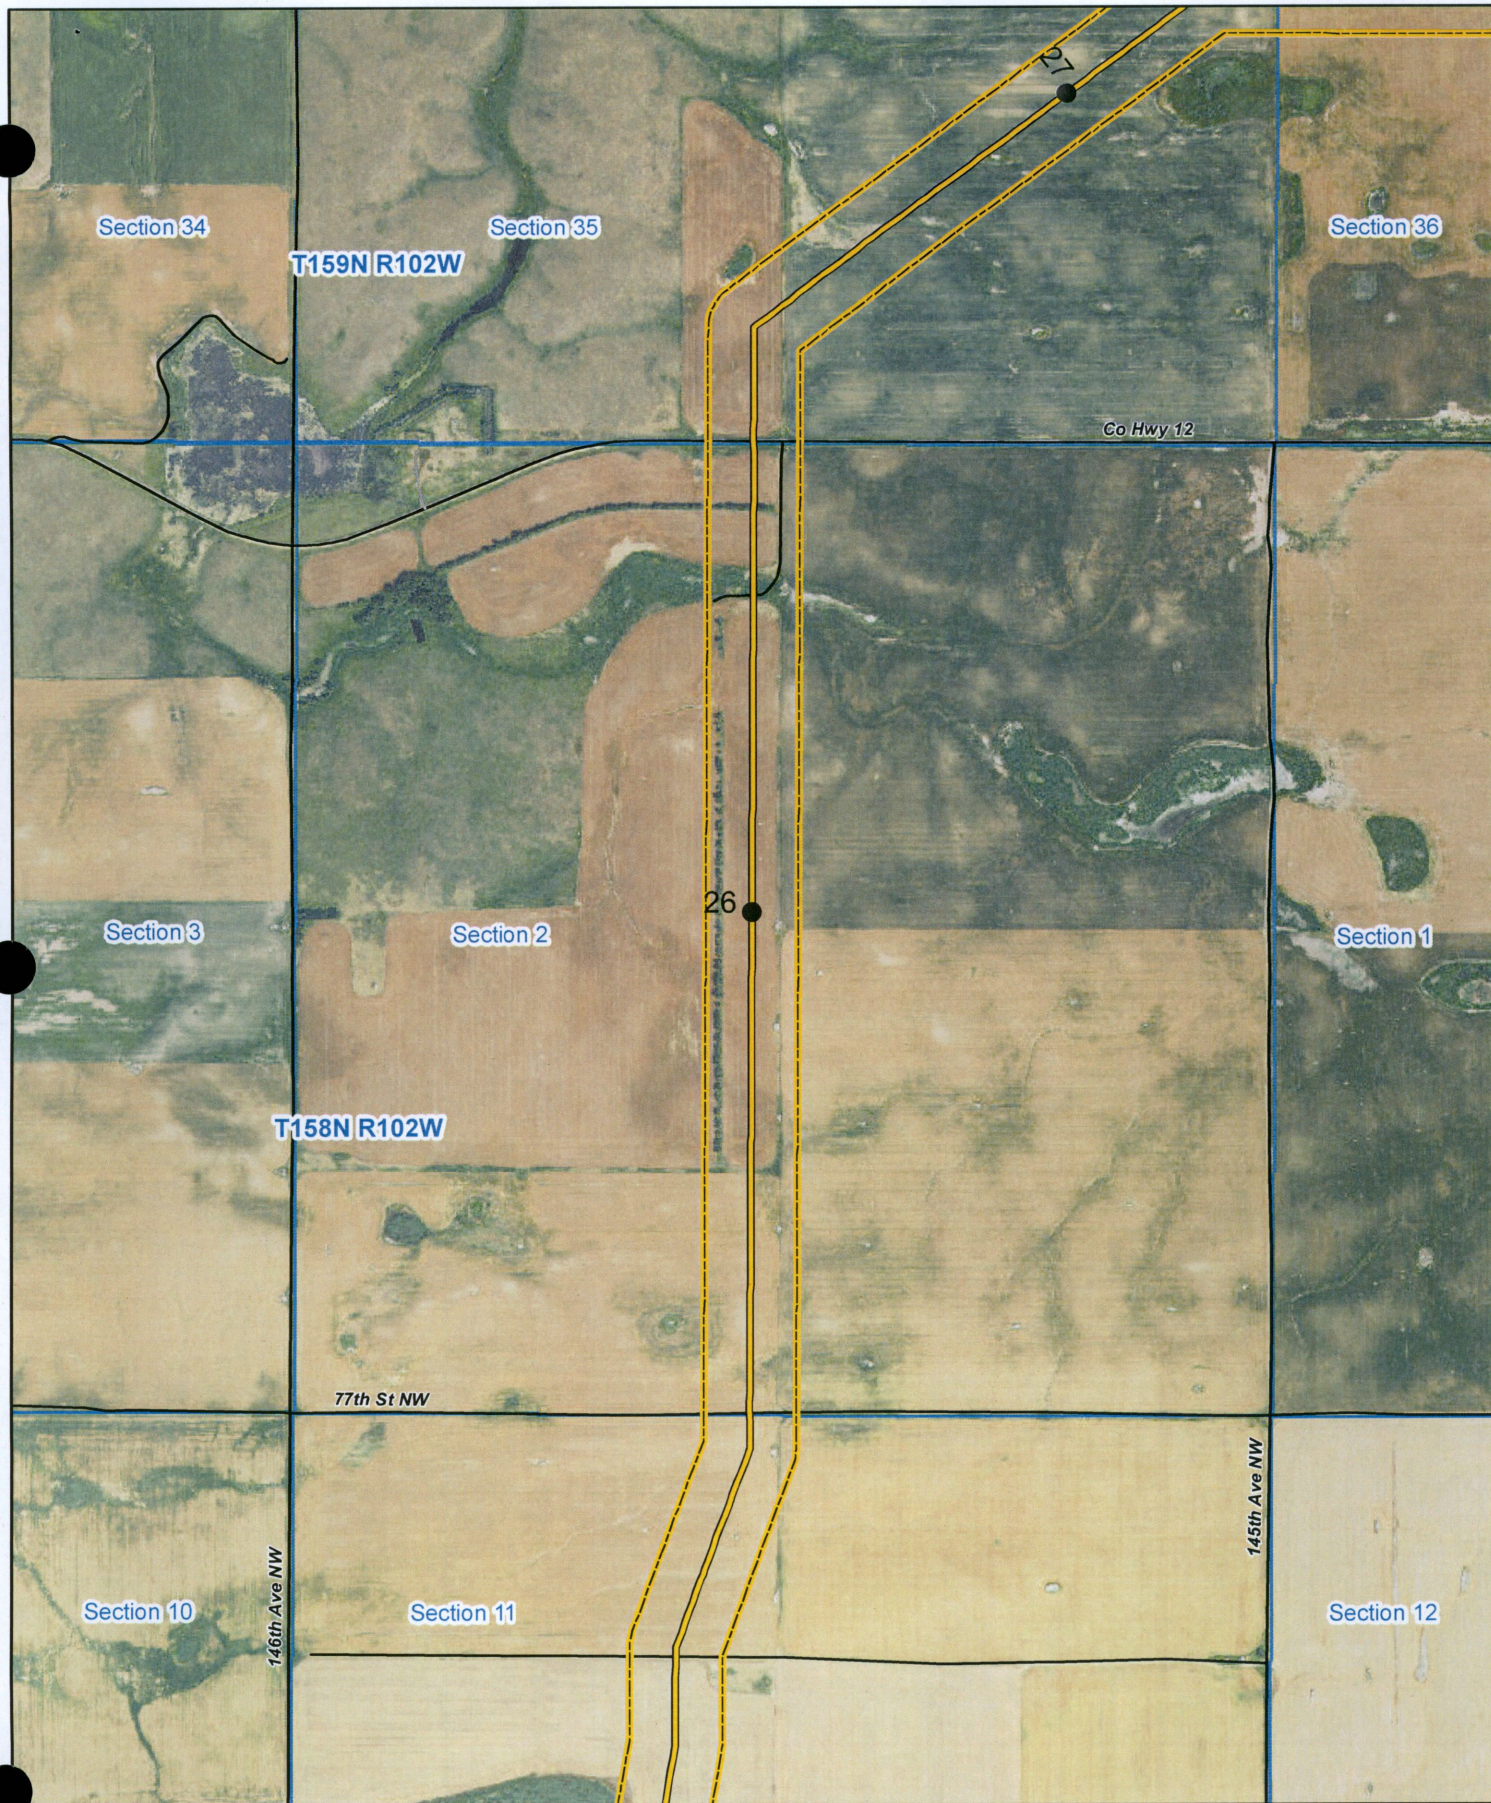

KC HARVEY

376 Gallatin Park Drive
Bozeman, MT 59715
www.kcharvey.com

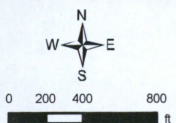

- Asbuilt Route
- Issued Route
- Issued Route Survey Corridor

- Highway
- Local Road
- Private Road
- Trail

- County
- Township
- Section


- State Land
- National Wildlife Refuge
- Water Fowl Production Area

2014 NAIP Imagery

Vantage Pipeline US LP


West Spur Lateral Pipeline
Asbuilt Mapbook
Page 15 1 : 12,000

Date: 04/20/2016 Version: 2016-1

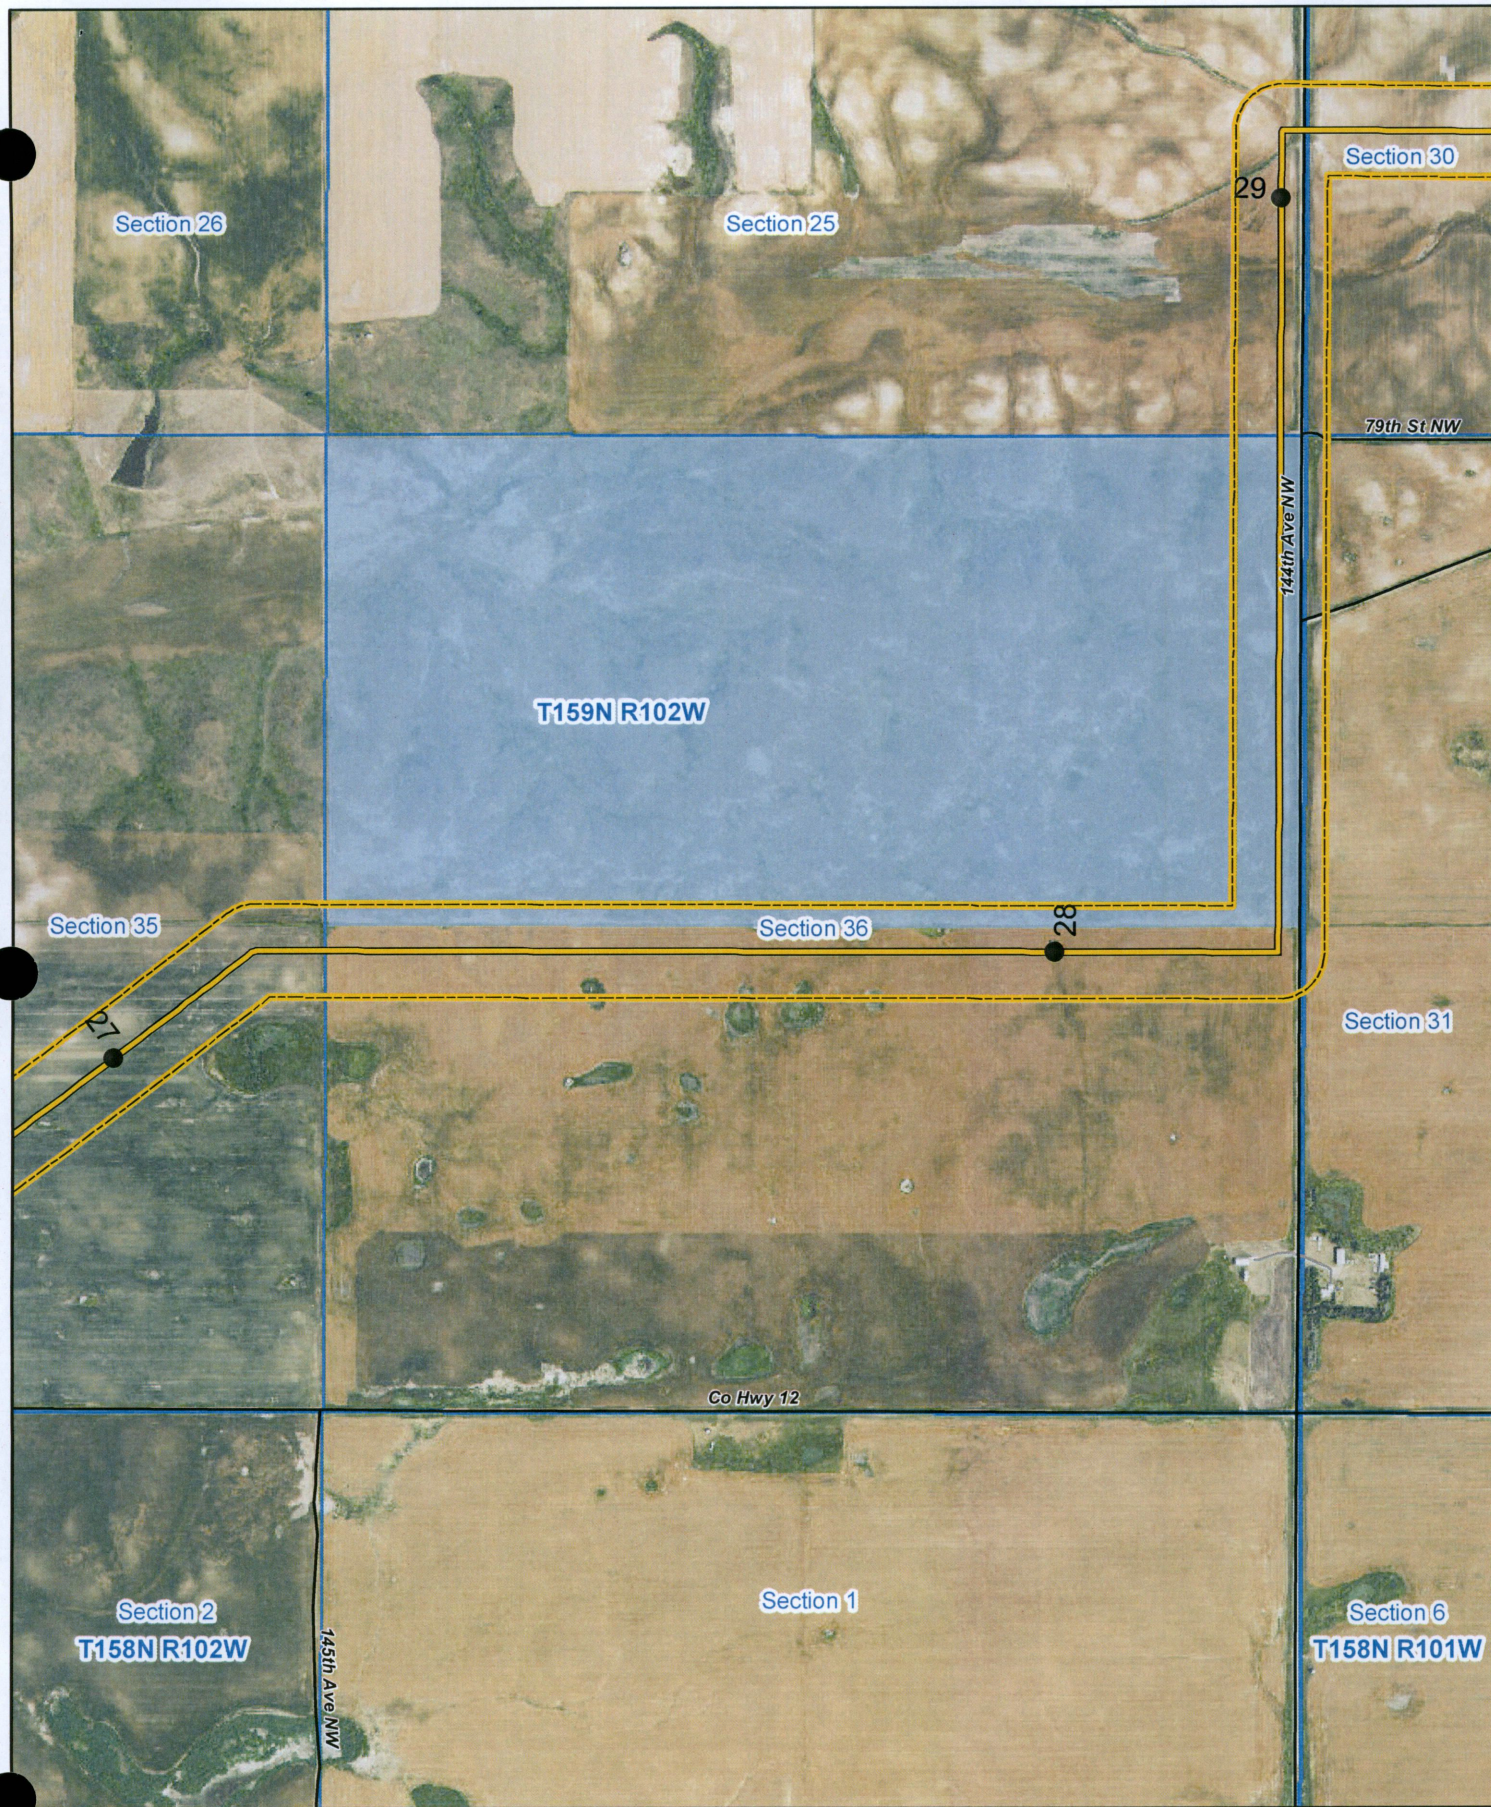

KC HARVEY

376 Gallatin Park Drive
Bozeman, MT 59715
www.kcharvey.com

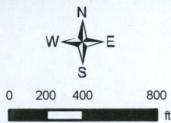

- Asbuilt Route
- - - Issued Route
- Issued Route Survey Corridor

- Highway
- Local Road
- Private Road
- Trail

- County
- Township
- Section


- State Land
- National Wildlife Refuge
- Water Fowl Production Area

2014 NAIP Imagery

Vantage Pipeline US LP


West Spur Lateral Pipeline
Asbuilt Mapbook
Page 16 1 : 12,000

Date: 04/20/2016 Version: 2016-1

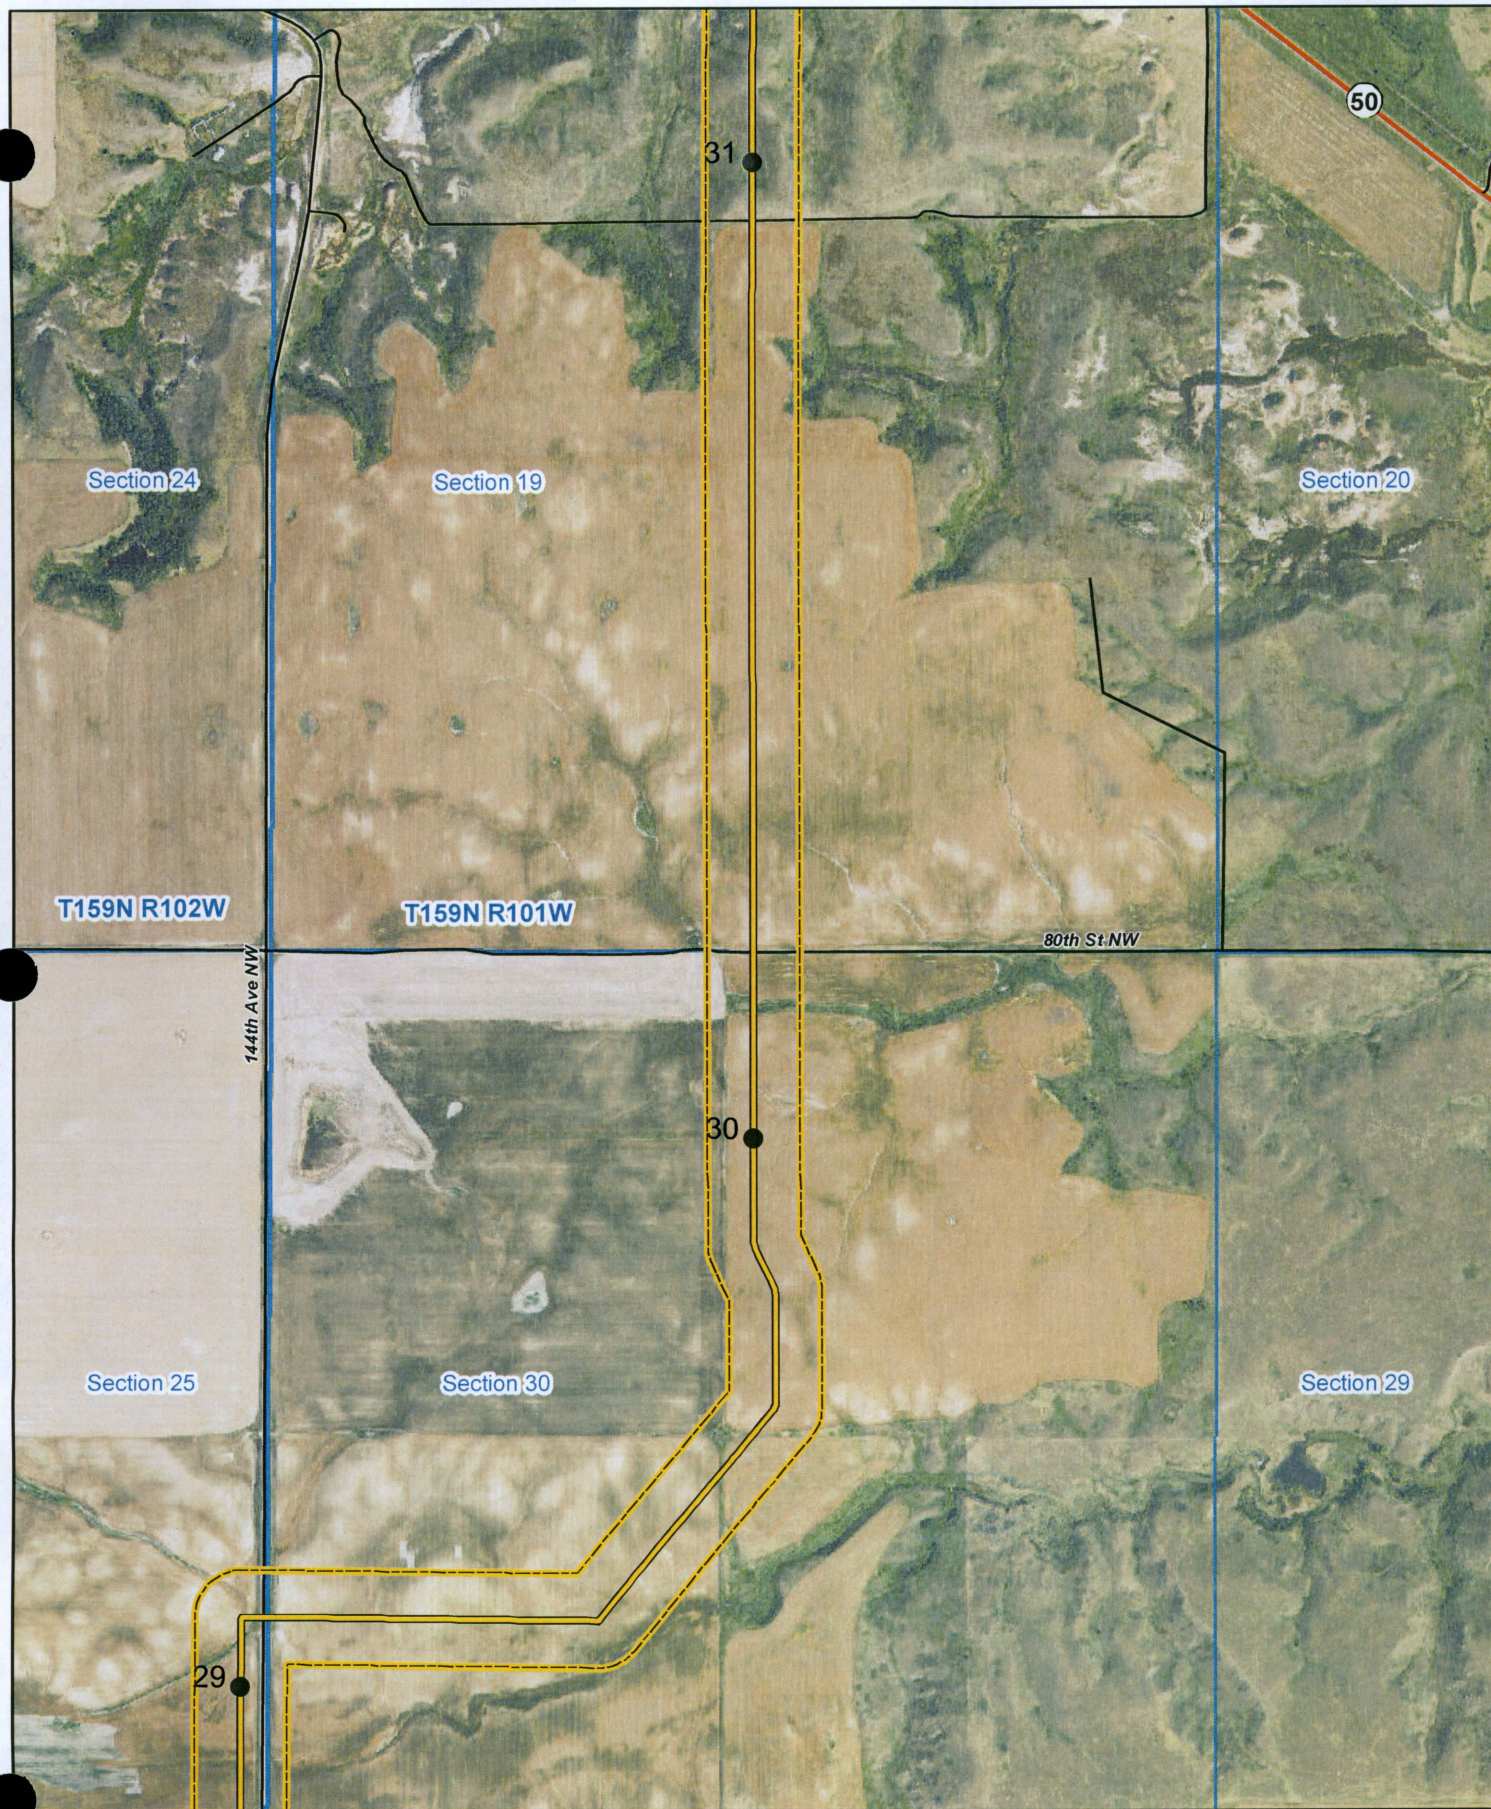

KC HARVEY

376 Gallatin Park Drive
Bozeman, MT 59715
www.kcharvey.com

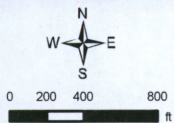

- Asbuilt Route
- Issued Route
- Issued Route Survey Corridor

- Highway
- Local Road
- Private Road
- Trail

- County
- Township
- Section

- State Land
- National Wildlife Refuge
- Water Fowl Production Area


2014 NAIP Imagery

Vantage Pipeline US LP

West Spur Lateral Pipeline
Asbuilt Mapbook


Page 17 1 : 12,000

Date: 04/20/2016 Version: 2016-1

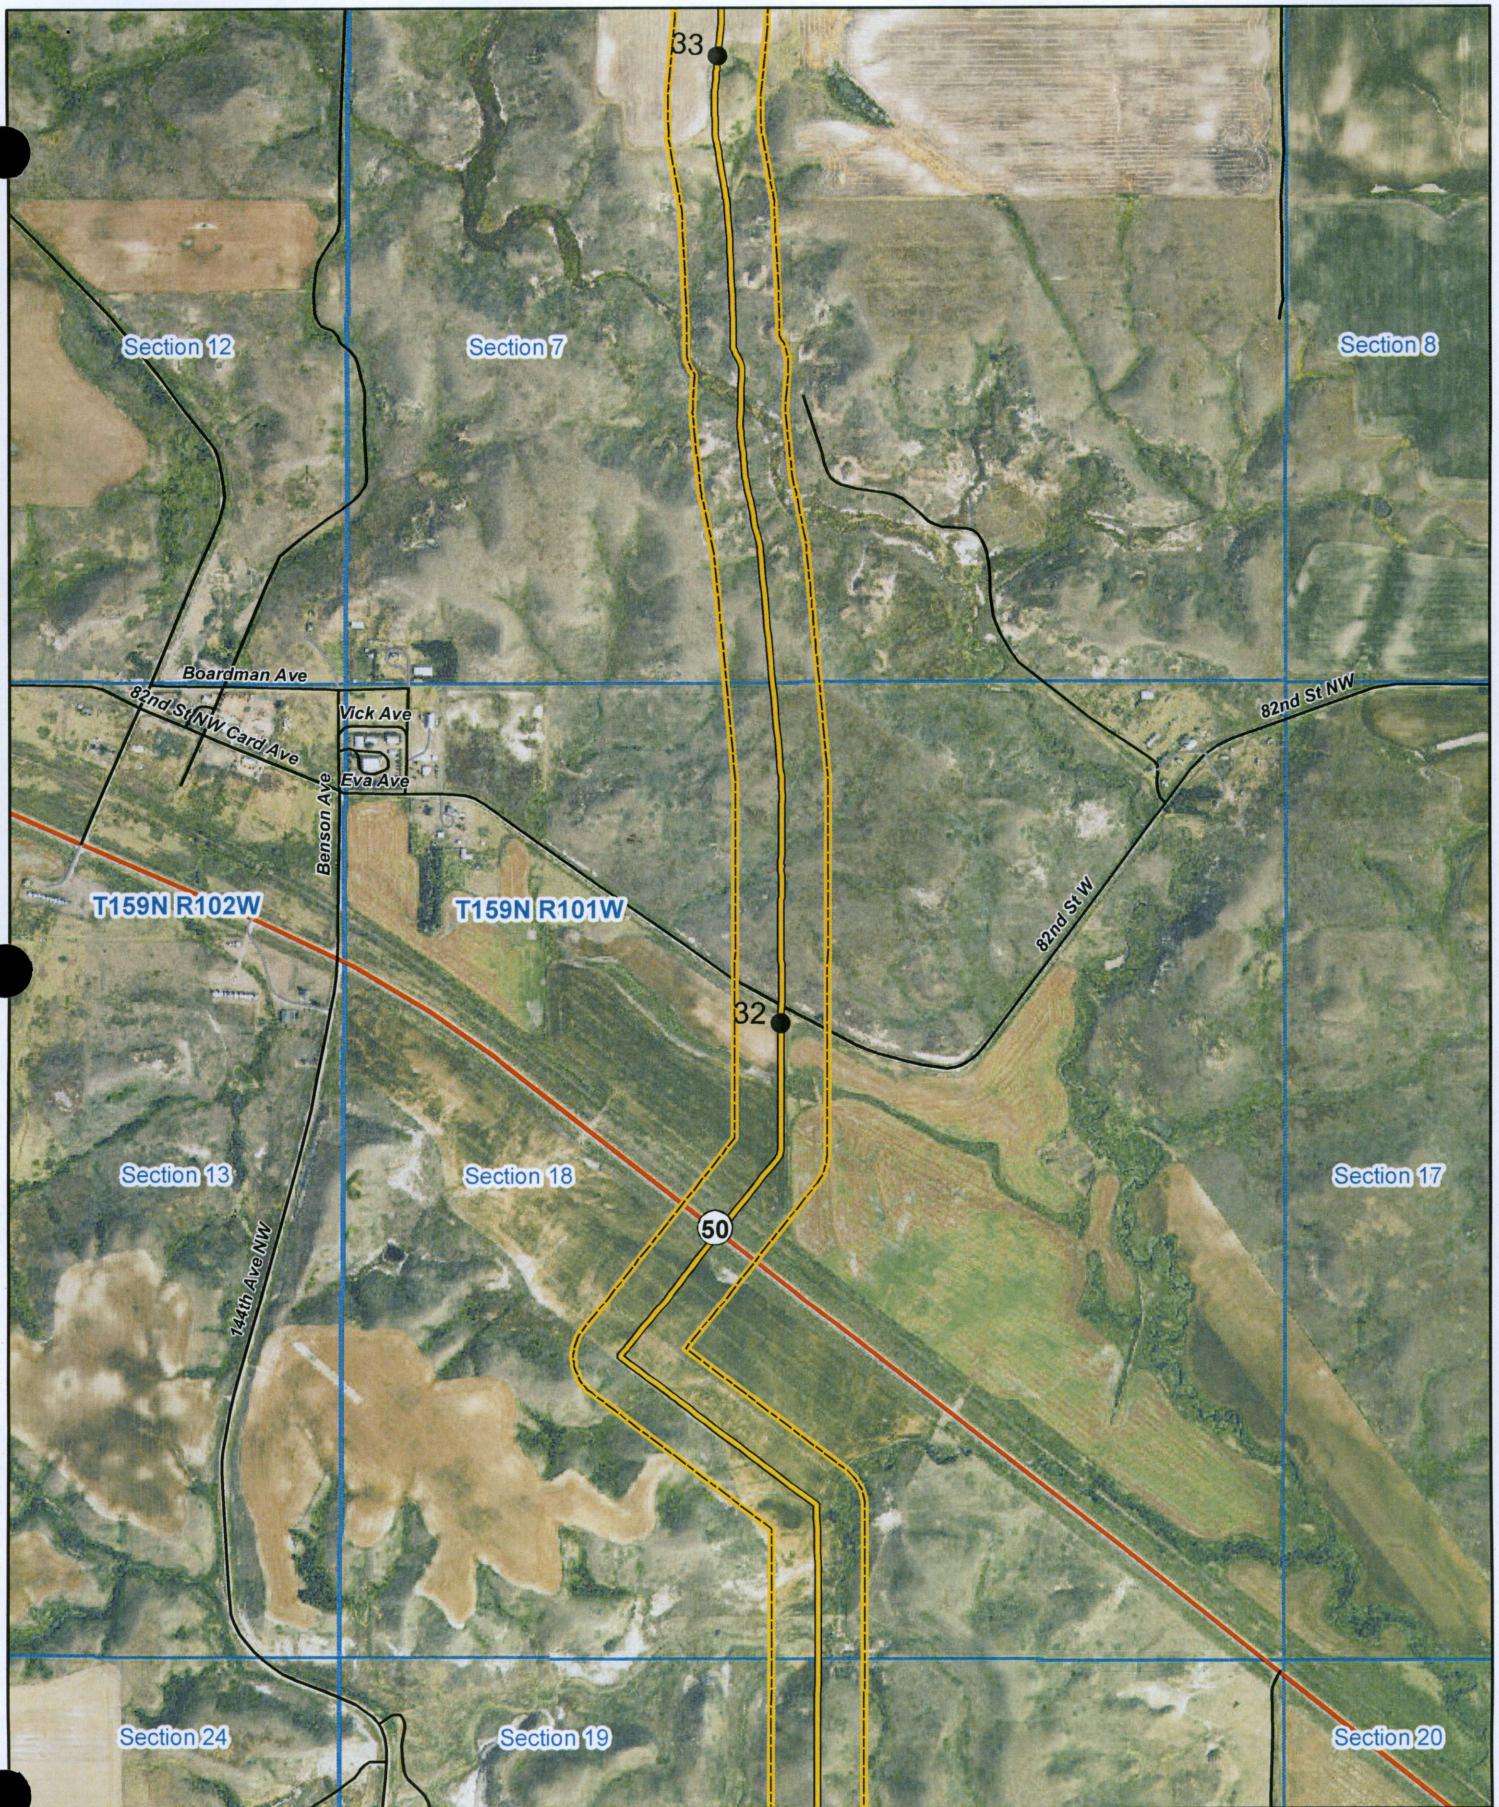

KC HARVEY

376 Gallatin Park Drive
Bozeman, MT 59715
www.kcharvey.com

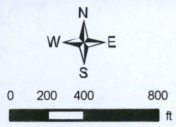

- Asbuilt Route
- - - Issued Route
- Issued Route Survey Corridor
- Highway
- Local Road
- Private Road
- Trail

- County
- Township
- Section


- State Land
- National Wildlife Refuge
- Water Fowl Production Area

2014 NAI/P Imagery

Vantage Pipeline US LP


West Spur Lateral Pipeline
Asbuilt Mapbook
Page 18 1 : 12,000

Date: 04/20/2016 Version: 2016-1

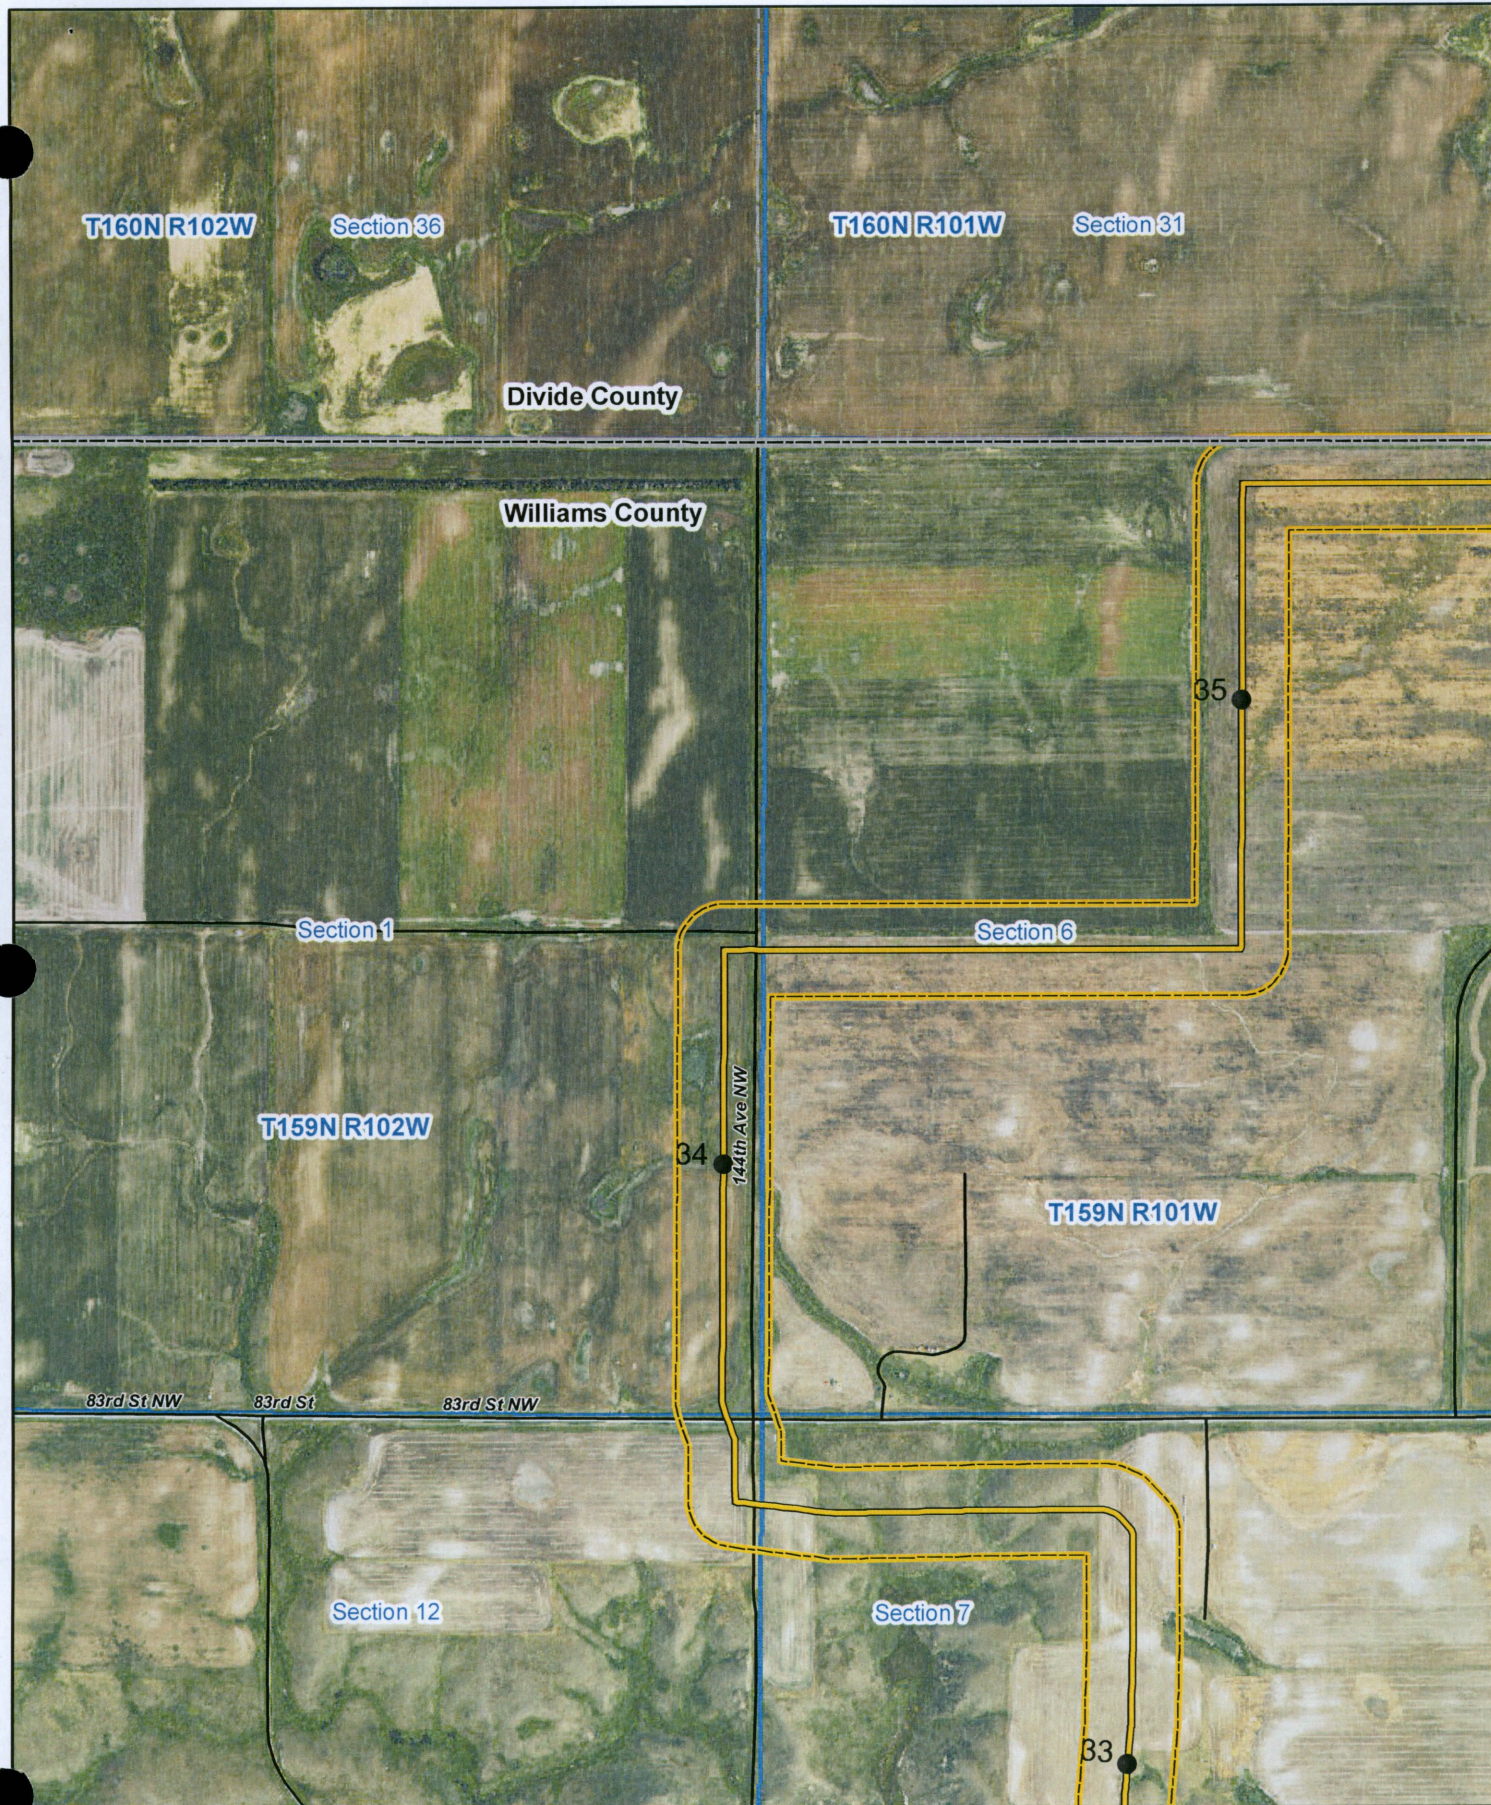

KC HARVEY

376 Gallatin Park Drive
Bozeman, MT 59715
www.kcharvey.com

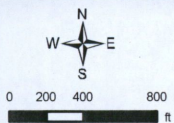

- Asbuilt Route
- - - Issued Route
- Issued Route Survey Corridor

- Highway
- Local Road
- Private Road
- Trail

- County
- Township
- Section


- State Land
- National Wildlife Refuge
- Water Fowl Production Area

2014 NAIP Imagery

Vantage Pipeline US LP


West Spur Lateral Pipeline
Asbuilt Mapbook
Page 19 1 : 12,000

Date: 04/20/2016 Version: 2016-1

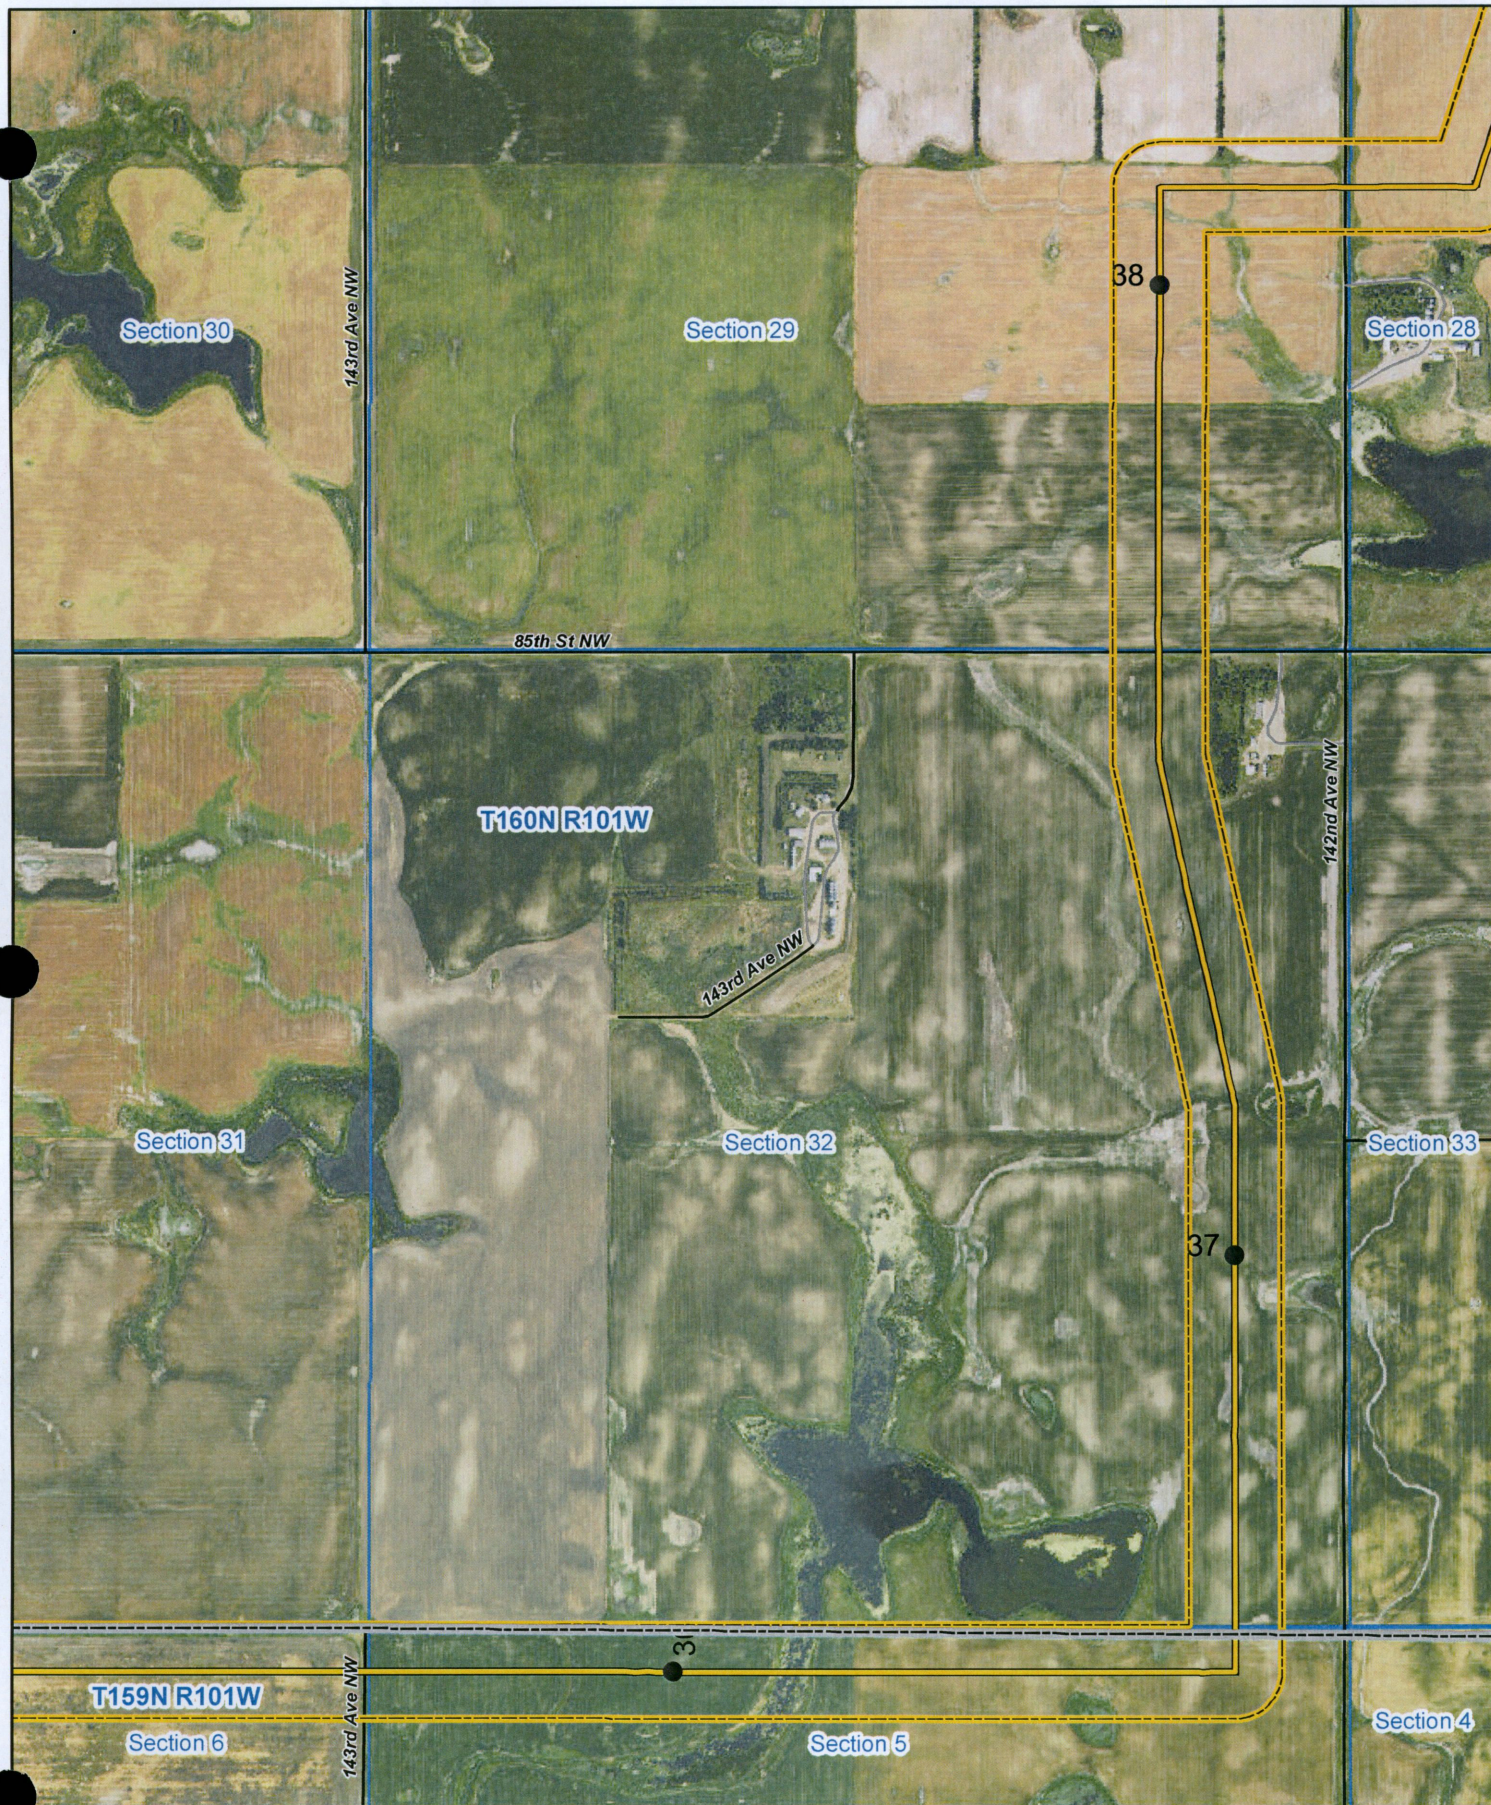

KC HARVEY

376 Gallatin Park Drive
Bozeman, MT 59715
www.kcharvey.com

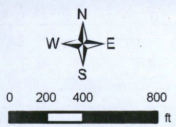

- Asbuilt Route
- - - Issued Route
- Issued Route Survey Corridor

- Highway
- Local Road
- Private Road
- Trail

- County
- Township
- Section

- State Land
- National Wildlife Refuge
- Water Fowl Production Area


2014 NAIP Imagery

Vantage Pipeline US LP

West Spur Lateral Pipeline
Asbuilt Mapbook


Page 20 1 : 12,000

Date: 04/20/2016 Version: 2016-1

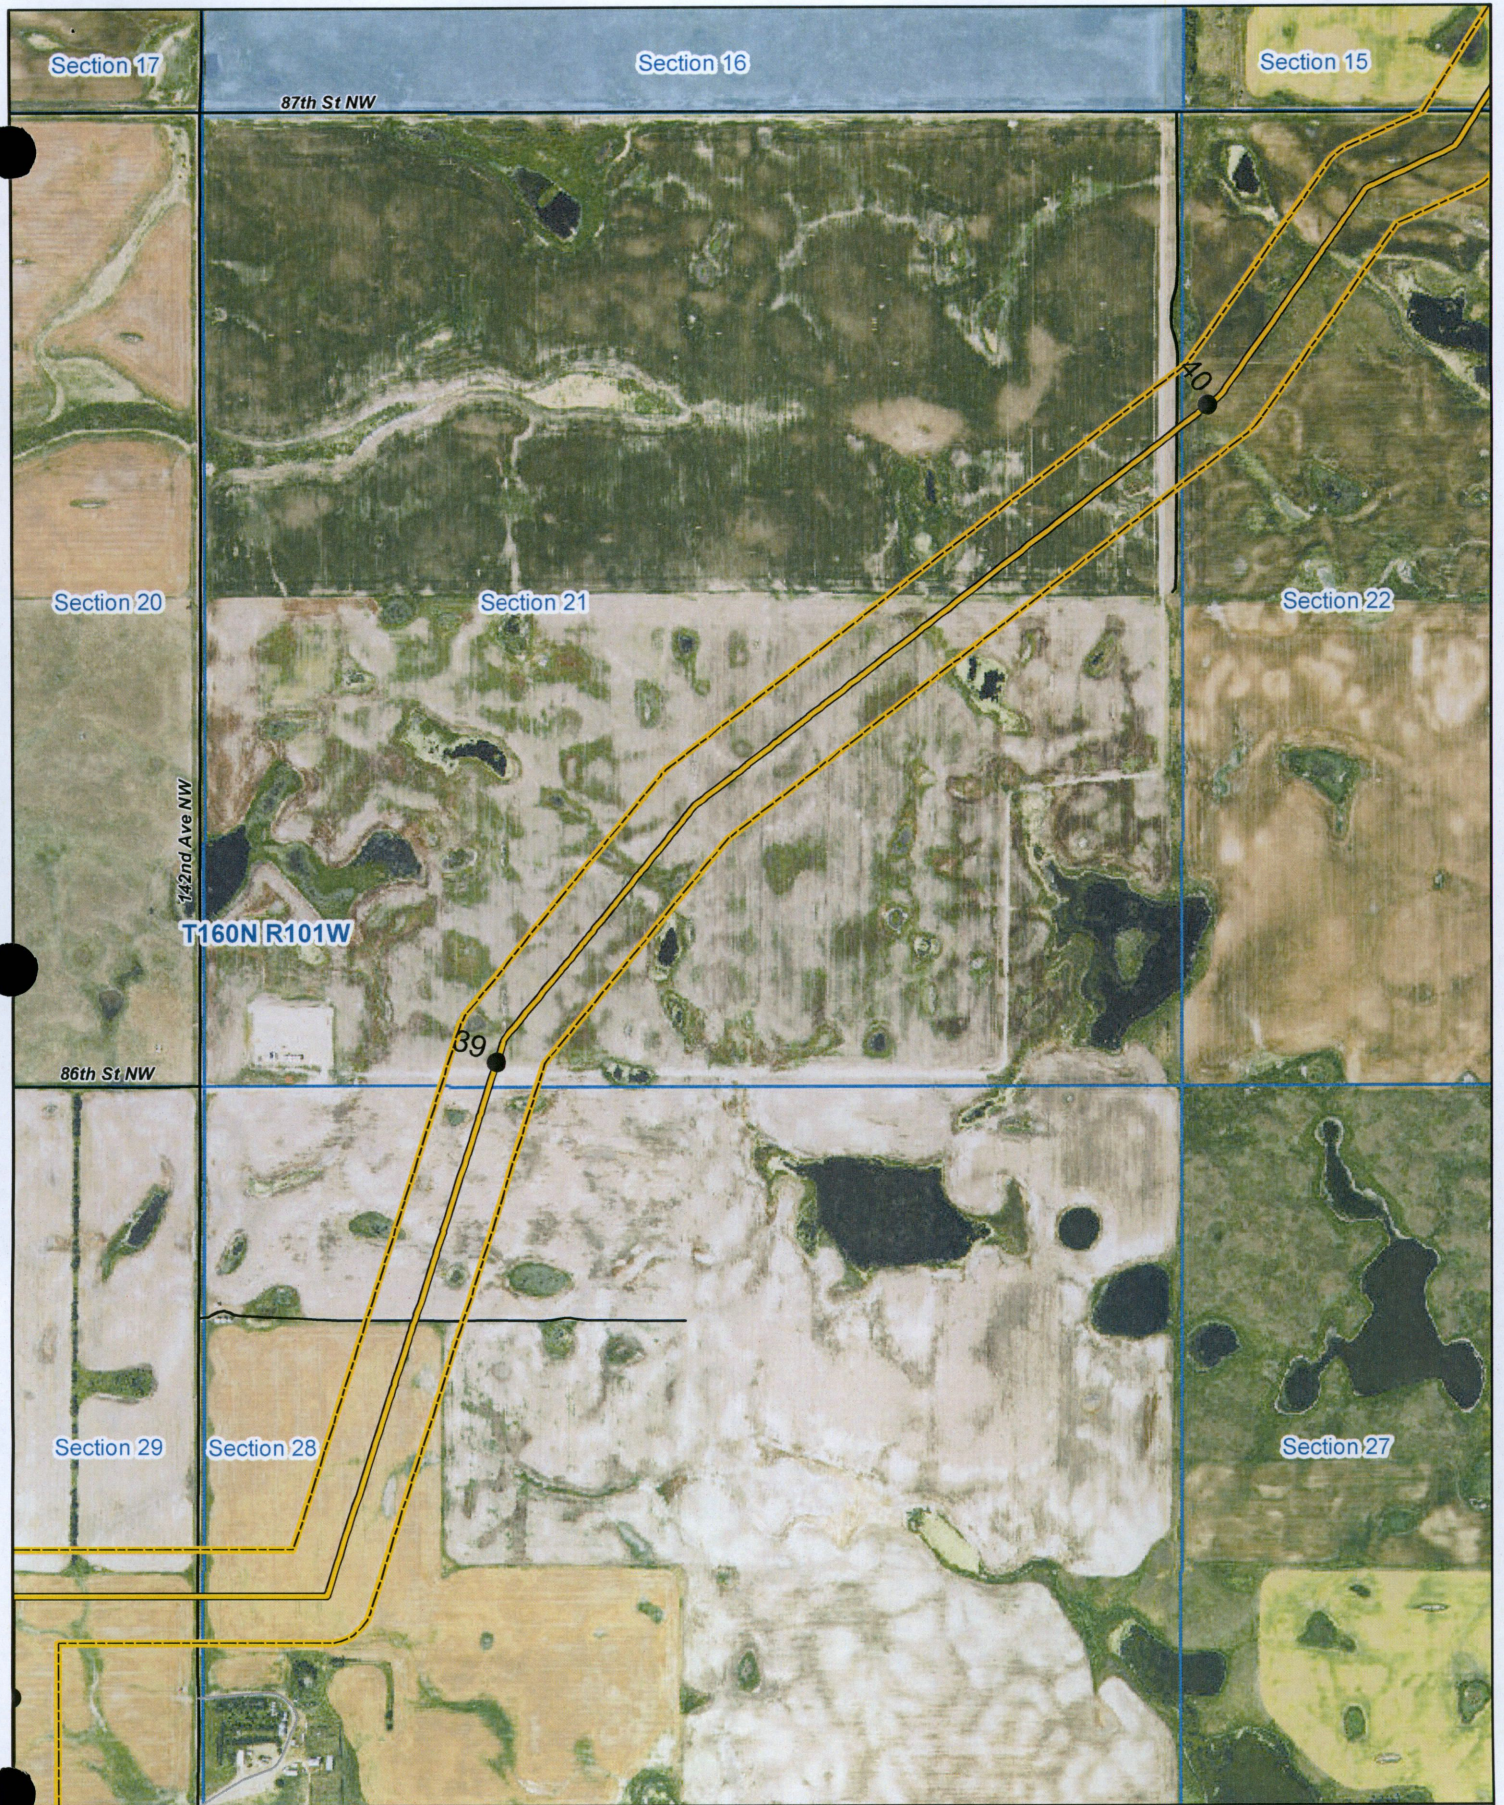

KC HARVEY

376 Gallatin Park Drive
Bozeman, MT 59715
www.kcharvey.com

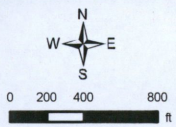

- Asbuilt Route
- - - Issued Route
- Issued Route Survey Corridor

- Highway
- Local Road
- Private Road
- Trail

- County
- Township
- Section


- State Land
- National Wildlife Refuge
- Water Fowl Production Area

2014 NAIP Imagery

Vantage Pipeline US LP


West Spur Lateral Pipeline
Asbuilt Mapbook
Page 21 1 : 12,000

Date: 04/20/2016 Version: 2016-1

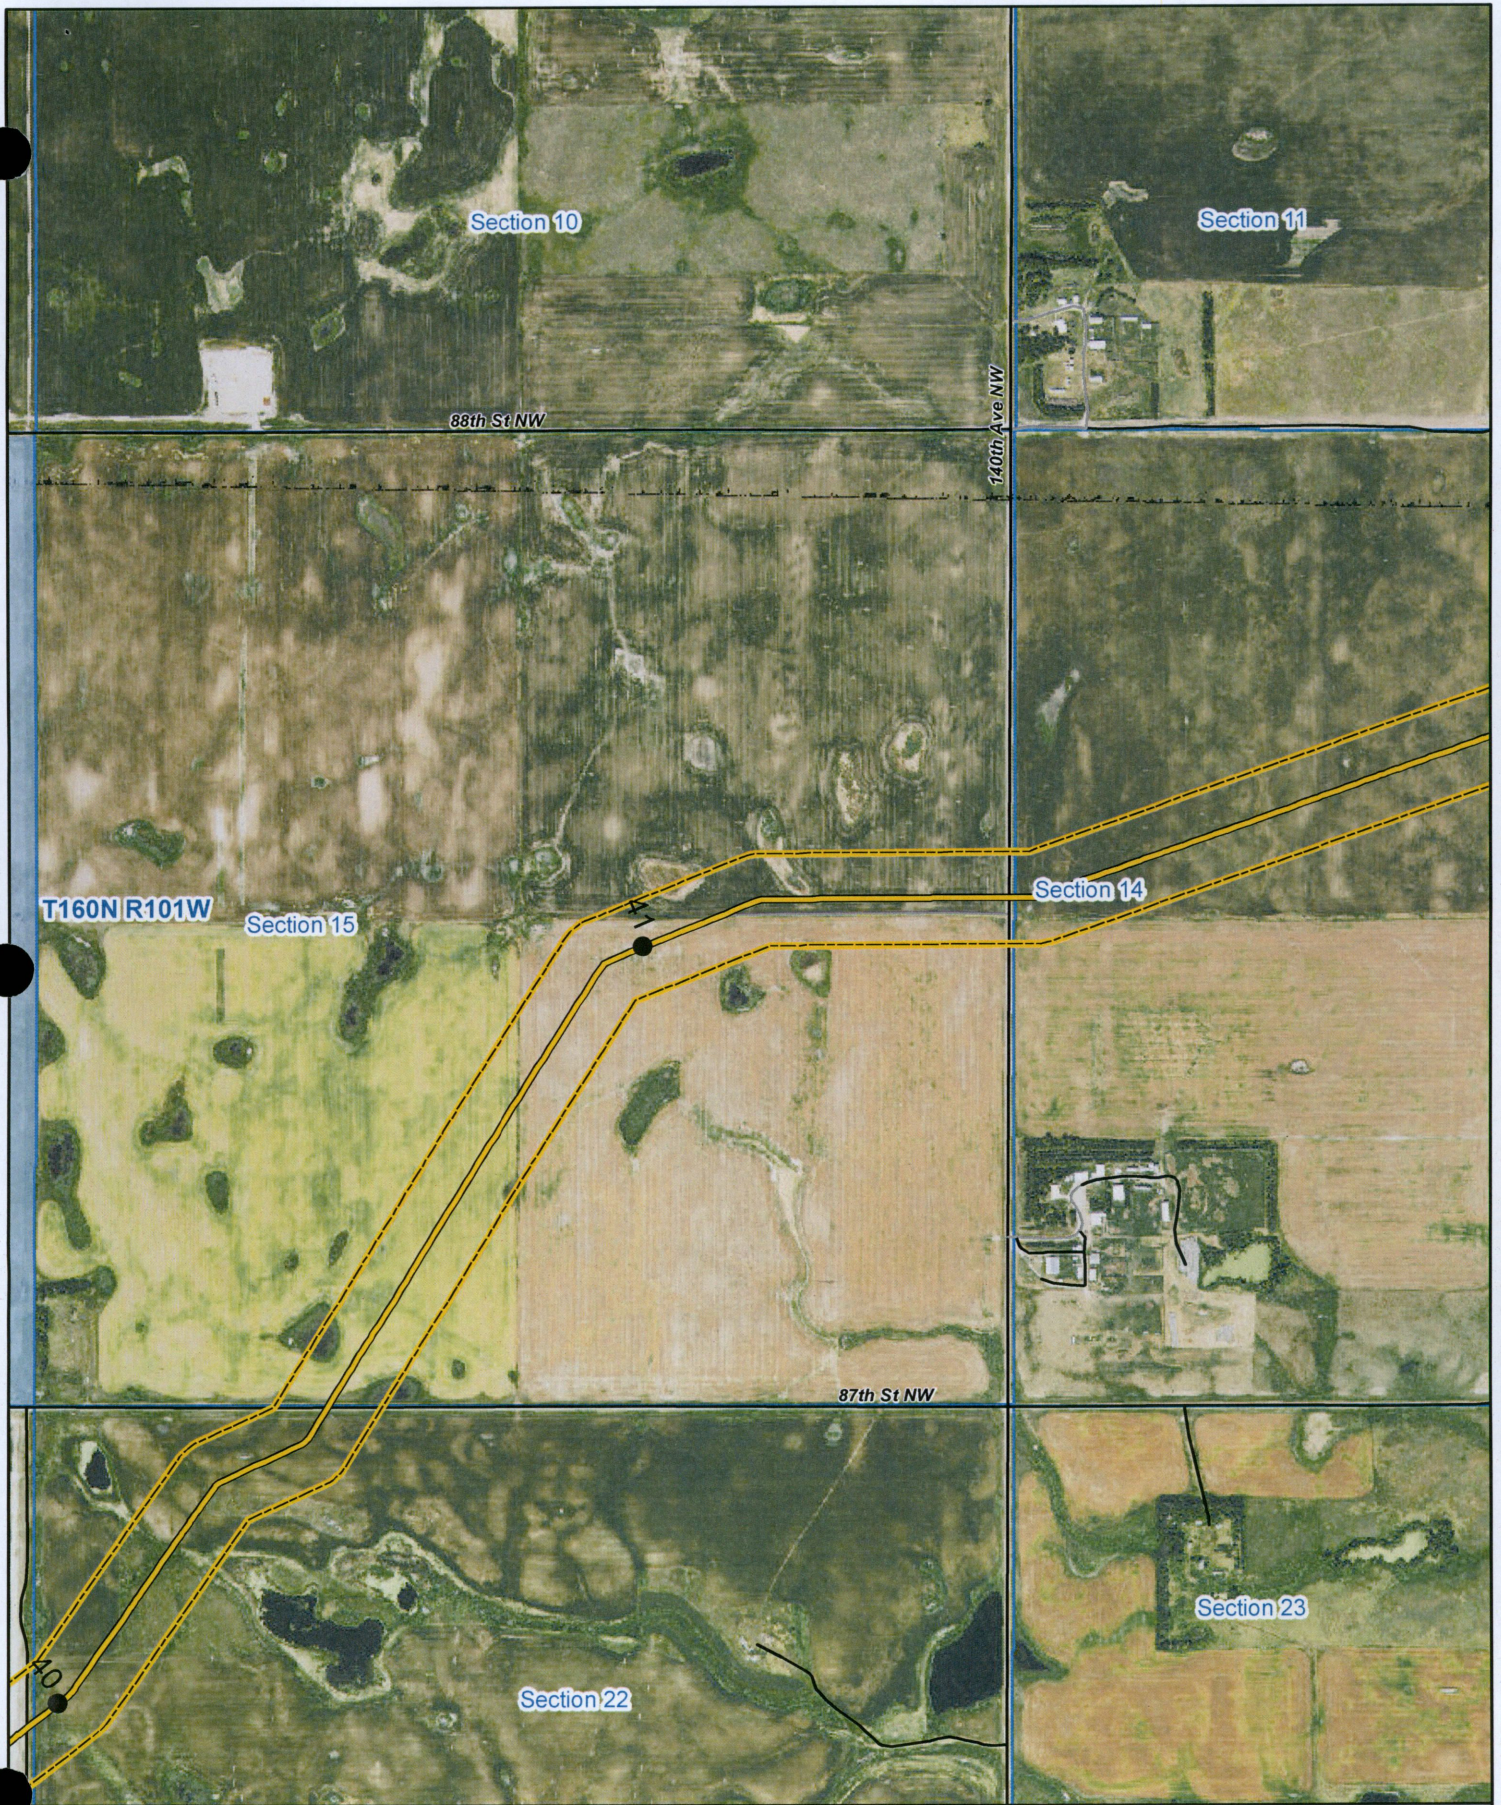

KC HARVEY

376 Gallatin Park Drive
Bozeman, MT 59715
www.kcharvey.com

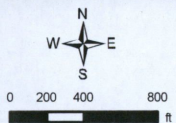

- Asbuilt Route
- Issued Route
- Issued Route Survey Corridor

- Highway
- Local Road
- Private Road
- Trail

- County
- Township
- Section

- State Land
- National Wildlife Refuge
- Water Fowl Production Area


2014 NAIP Imagery

Vantage Pipeline US LP

West Spur Lateral Pipeline
Asbuilt Mapbook
Page 22 1 : 12,000


Date: 04/20/2016

Version: 2016-1

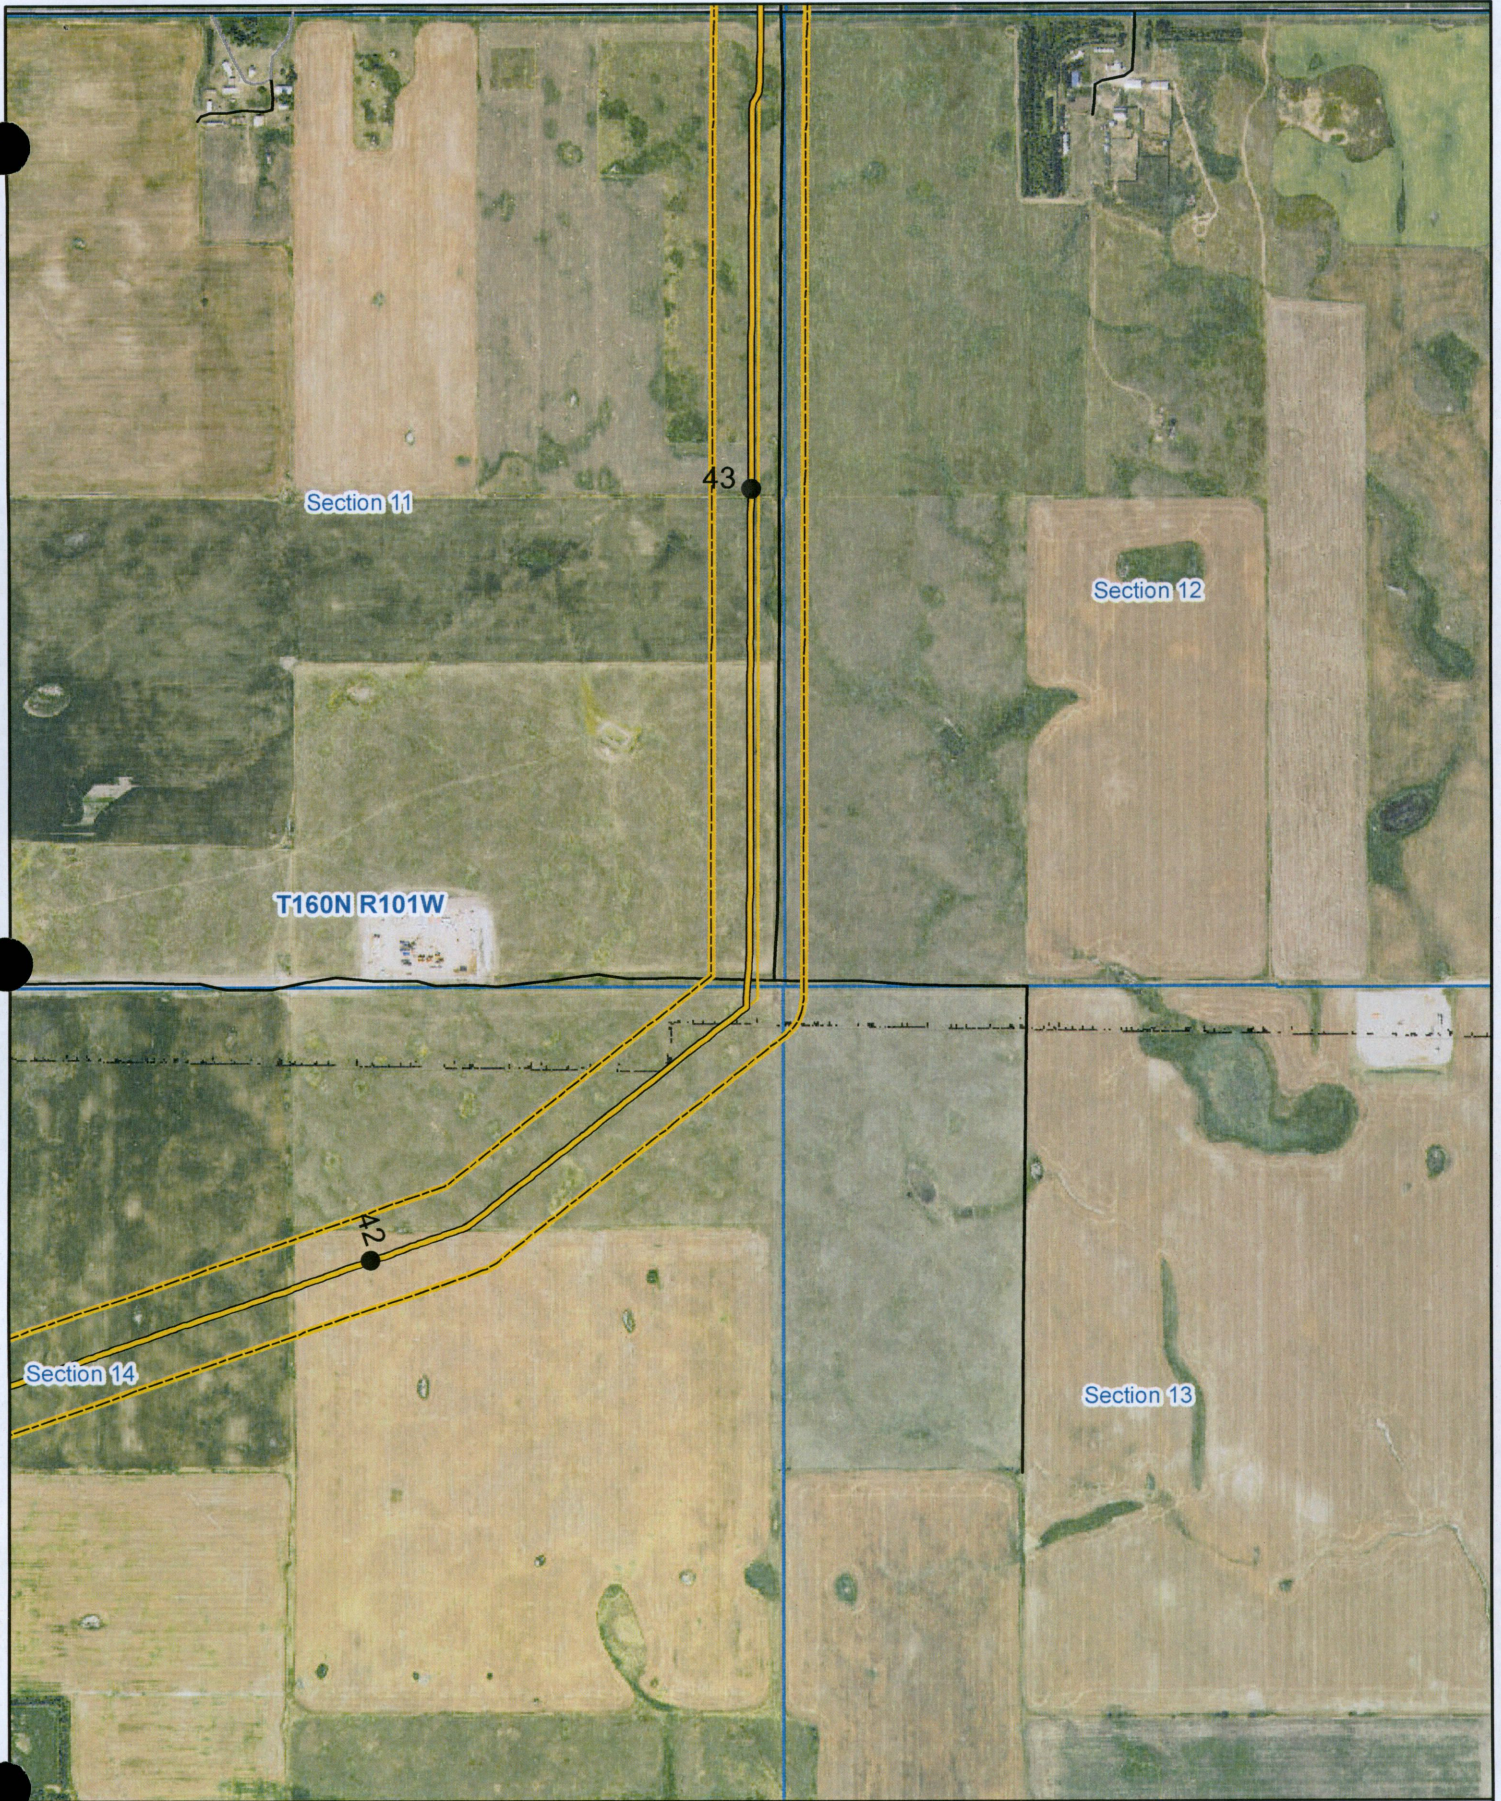

KC HARVEY

376 Gallatin Park Drive
Bozeman, MT 59715
www.kcharvey.com

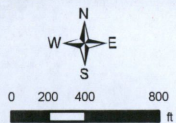

- Asbuilt Route
- - - Issued Route
- Issued Route Survey Corridor

- Highway
- Local Road
- Private Road
- Trail

- County
- Township
- Section

- State Land
- National Wildlife Refuge
- Water Fowl Production Area


2014 NAIP Imagery

Vantage Pipeline US LP

West Spur Lateral Pipeline
Asbuilt Mapbook
Page 23 1 : 12,000


Date: 04/20/2016

Version: 2016-1

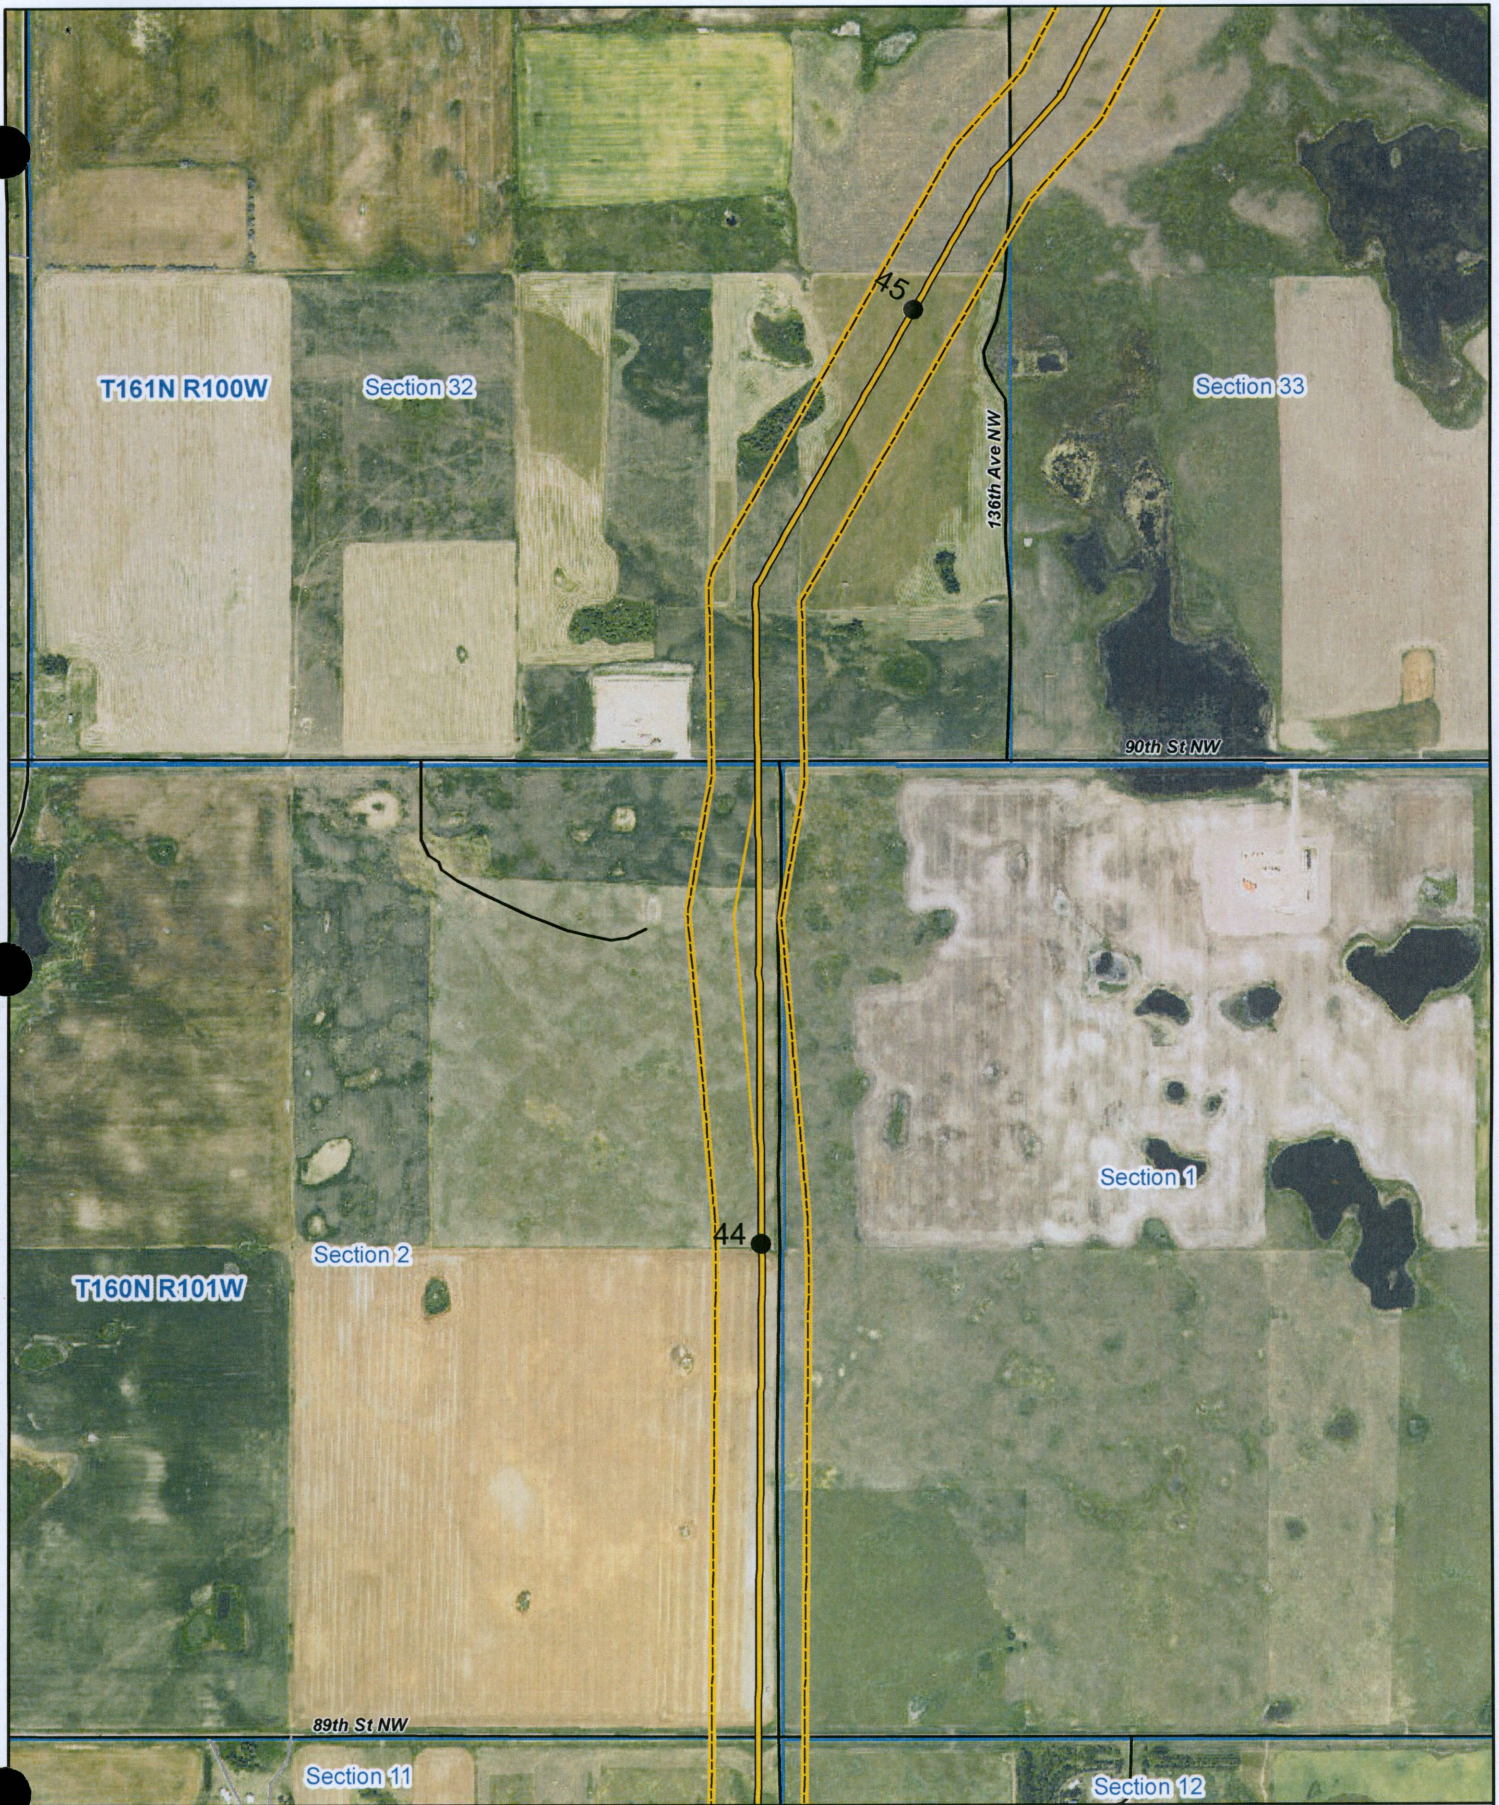

KC HARVEY

376 Gallatin Park Drive
Bozeman, MT 59715
www.kcharvey.com

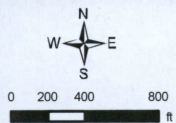

- Asbuilt Route
- - - Issued Route
- Issued Route Survey Corridor

- Highway
- Local Road
- Private Road
- Trail

- County
- Township
- Section


- State Land
- National Wildlife Refuge
- Water Fowl Production Area

2014 NAIP Imagery

Vantage Pipeline US LP


West Spur Lateral Pipeline
Asbuilt Mapbook
Page 24 1 : 12,000

Date: 04/20/2016 Version: 2016-1

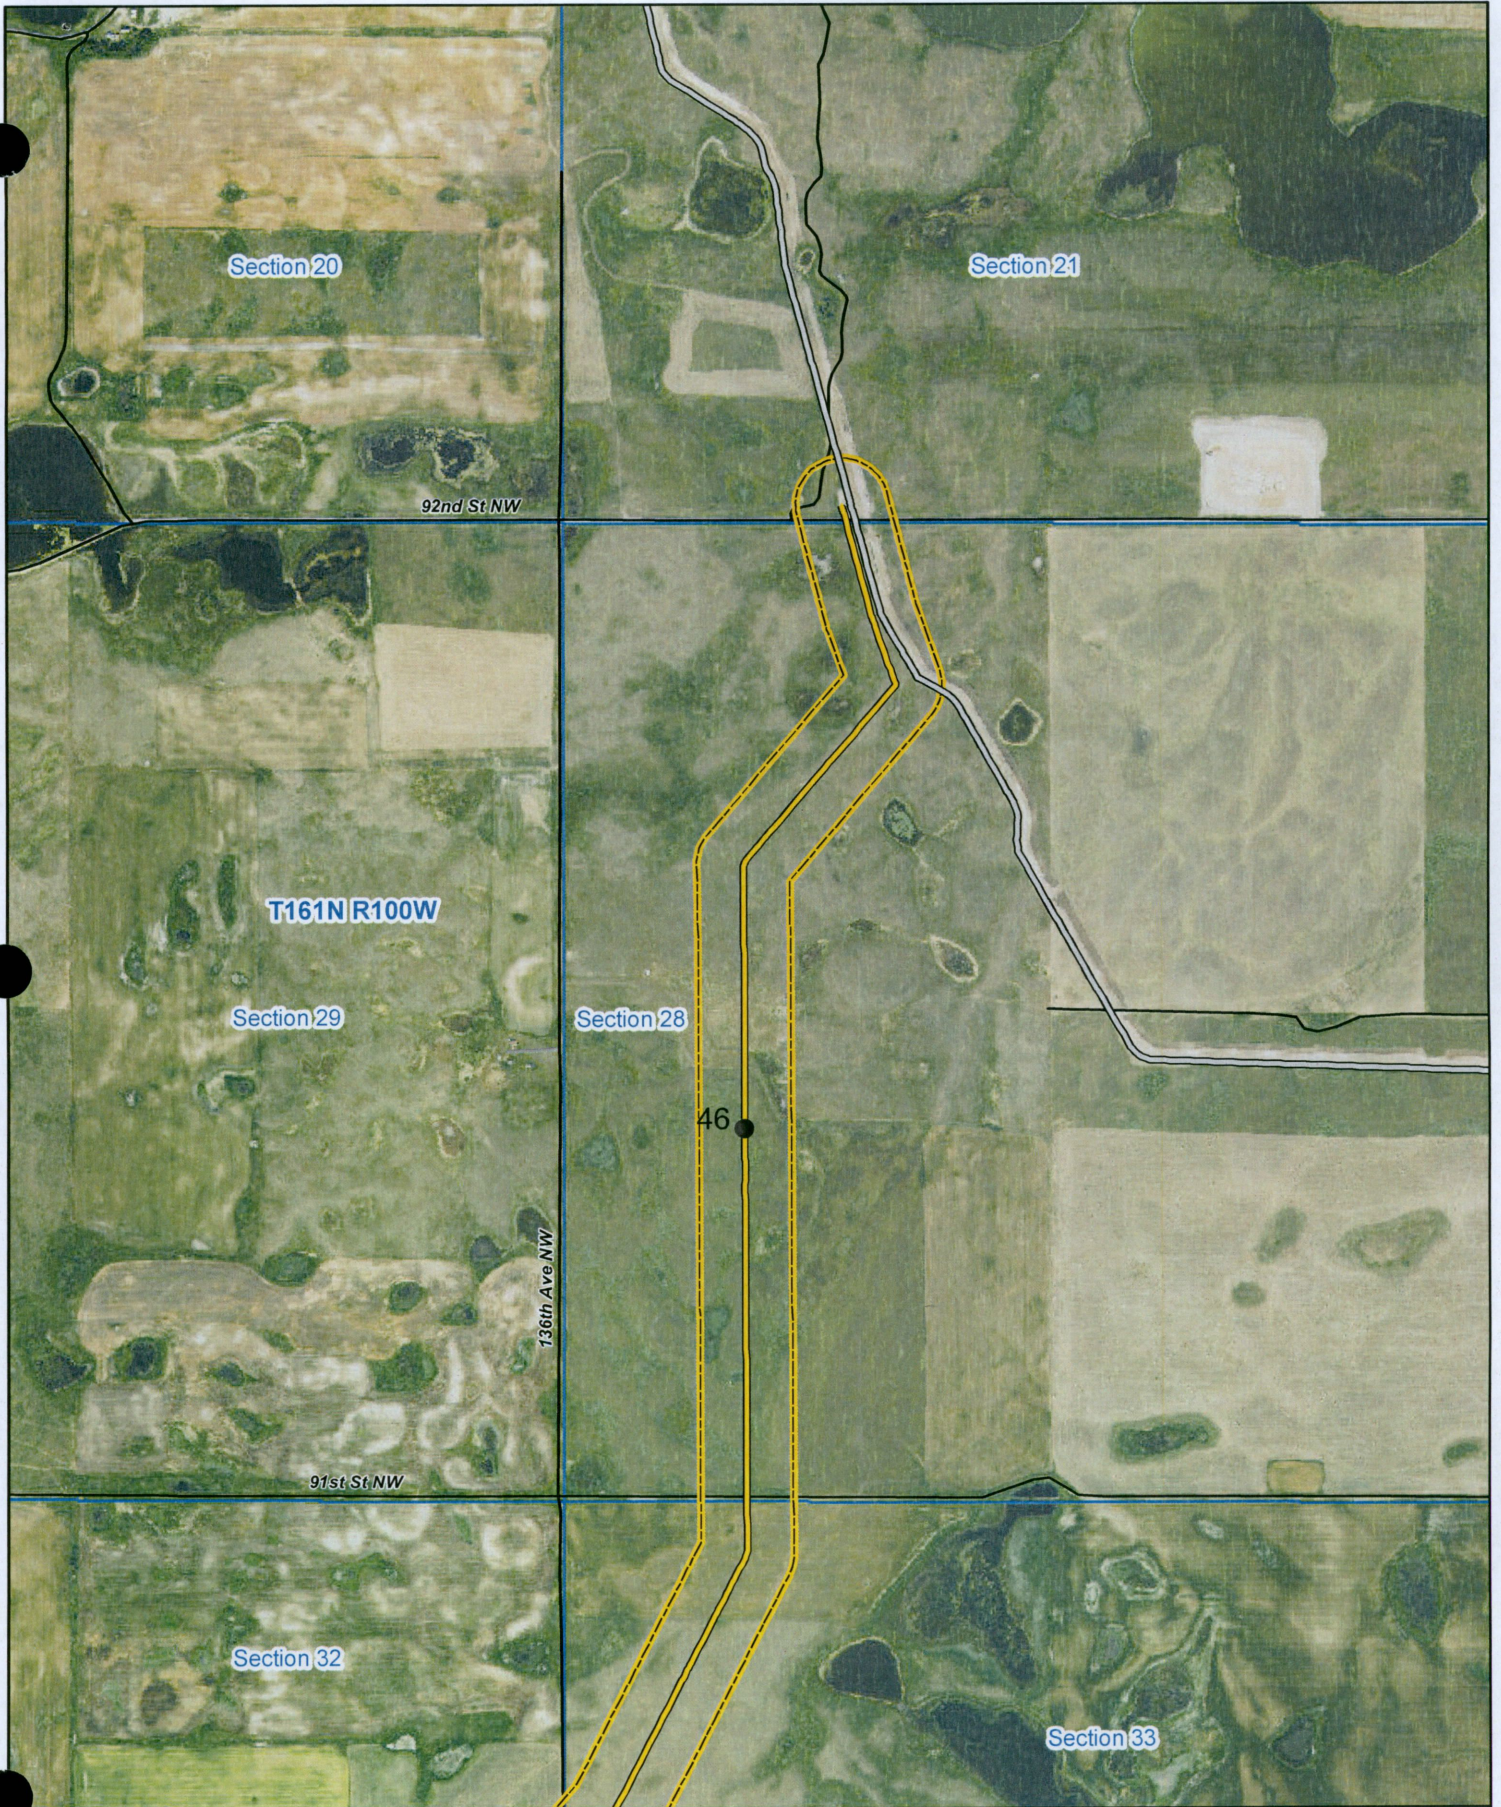

KC HARVEY

376 Gallatin Park Drive
Bozeman, MT 59715
www.kcharvey.com

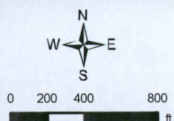

- Asbuilt Route
- - - Issued Route
- Issued Route Survey Corridor

- Highway
- Local Road
- Private Road
- Trail

- County
- Township
- Section

- State Land
- National Wildlife Refuge
- Water Fowl Production Area

2014 NAIP Imagery

Vantage Pipeline US LP

West Spur Lateral Pipeline
Asbuilt Mapbook
Page 25 1 : 12,000

Date: 04/20/2016

Version: 2016-1