



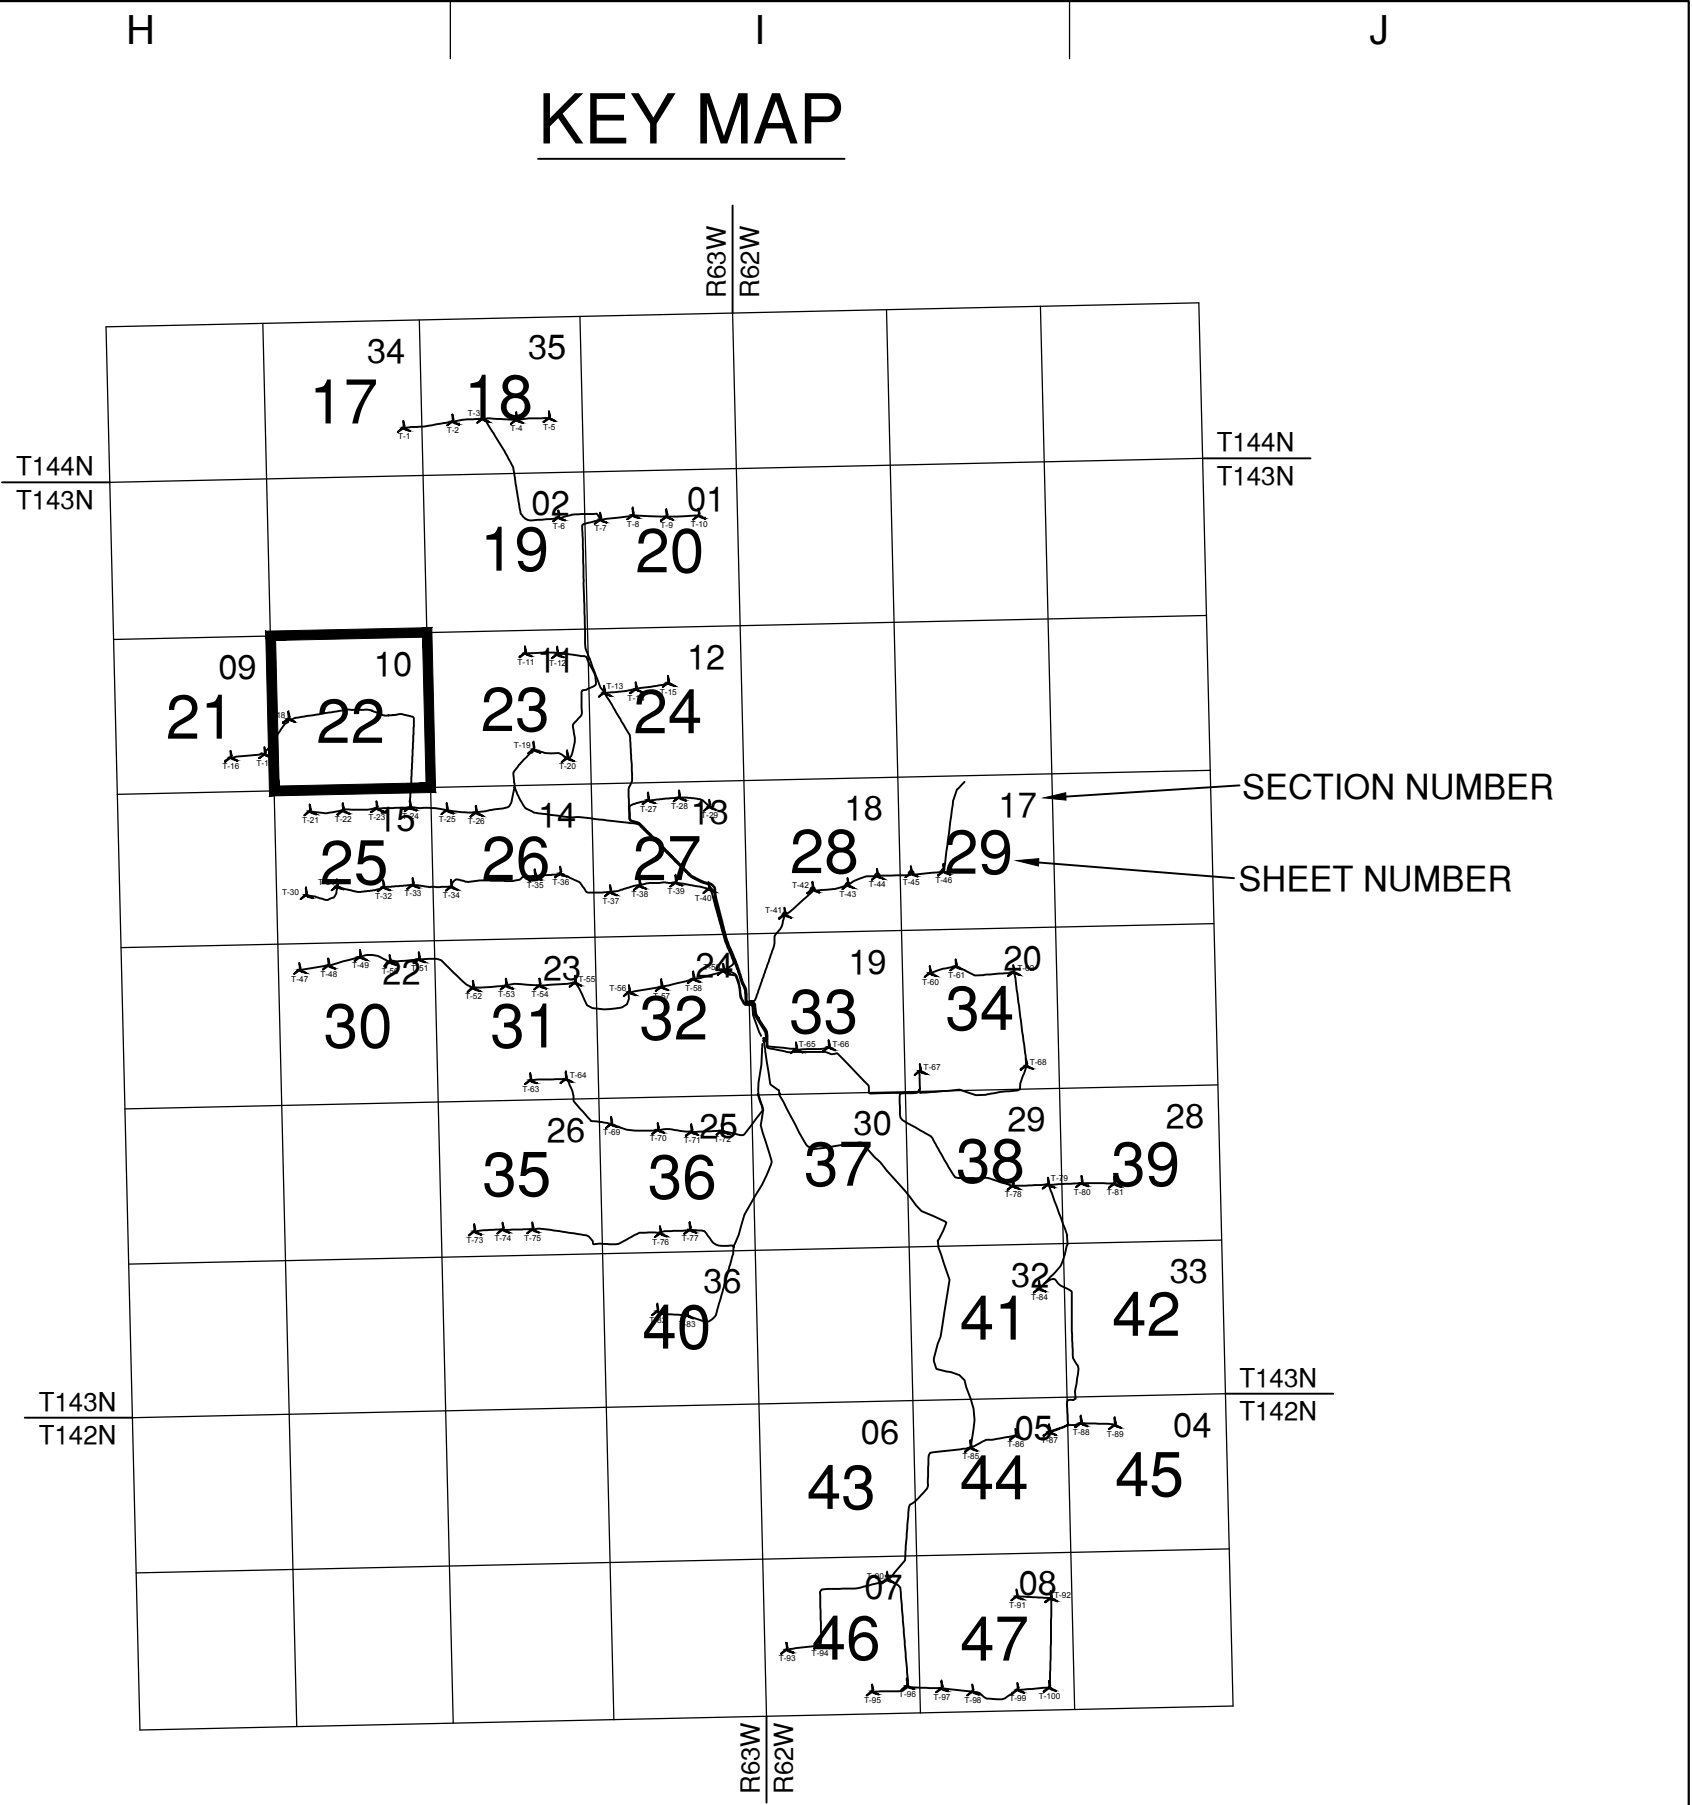

- NOTES:
- THIS DRAWING WAS COMPILED FROM INFORMATION PROVIDED BY WANZEK, UTILIZING INFORMATION FROM THE FOLLOWING FILE LIST.
 - CRM_AvoidanceBuffer_110813.SHX
 - USFWS_WetEase_1012.SHX
 - Wetlands_Poly_102314.SHX
 - Courtenay_TurbineArrayRenumbering_2015_07_15.SHX
 - Courtenay_ALTA 150120.DWG
 - Courtenay_CollectionRecordLines_20161108.SHP
 - Courtenay_AdditionalSurveyCorridor_2015_10_07.kmz
 - THE AERIAL WAS OBTAINED BY ULTEIG.
 - CourtenayAerial_NDStateplane_HarrNAD83_South_IntlFt.SID

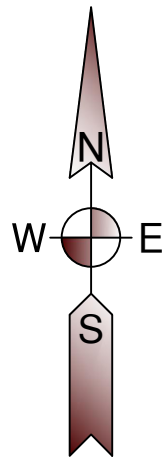

RECORD DRAWING
DRAWINGS ARE BASED UPON
CONSTRUCTION CONTRACTOR REDLINES
WHICH HAVE NOT BEEN FIELD VERIFIED BY
ENGINEER OF RECORD.

LEGEND

- XX WIND TURBINE
- F1 FEEDER 1
- F2 FEEDER 2
- F3 FEEDER 3
- F4 FEEDER 4
- F5 FEEDER 5
- F6 FEEDER 6
- F7 FEEDER 7
- F8 FEEDER 8
- FOC FIBER ROUTE
- SURVEYED CORRIDORS
- RIGHT OF WAY
- NON LEASED
- XJBX JUNCTION BOX
- SPLX-X CABLE SPLICE
- FSX-X FIBER SPLICE
- GRDX-X MID SPAN GROUND
- ACCESS ROADS
- BORE LOCATION RB X-X

NO	REVISION	ZONE	DATE	BY	CHK	ENG	NO	REVISION	ZONE	DATE	BY	CHK	ENG	REFERENCE DRAWINGS		
A	0		10/12/2015	MJ	JH	BG								DWG NO.	MANUFACTURER	DESCRIPTION
			01/22/2016	AS	JH	BG										
1	REVISED KEY MAP		02/10/2016	CL	JH	BG										
2	RECORD DRAWING		12/05/2016	GP	JH	BG										

NORTHERN STATES POWER

COURTENAY WIND - COLLECTION SYSTEM

STUTSMAN COUNTY, NORTH DAKOTA

DWN: MJ	DATE:01/22/2016	CHK:	DATE:
ENG: BG	DATE:01/22/2016	CHK:	DATE:
PM: BD	DATE:01/22/2016	PROJ. NO: 121901101	
APVD:	DATE:	SCALE:NONE	

THIS MAP/DOCUMENT IS A TOOL TO ASSIST EMPLOYEES IN THE PERFORMANCE OF THEIR JOBS. YOUR PERSONAL SAFETY IS PROVIDED FOR BY USING SAFETY PRACTICES, PROCEDURES, AND EQUIPMENT AS DESCRIBED IN THE SAFETY TRAINING PROGRAMS AND MANUALS.

ENERGY SUPPLY
ENGINEERING & CONSTRUCTION

UNIT 0

FEEDER ROUTING DIAGRAM
SECTION 10, T143N, R63W

NH-271536-22

REV
2