

MARK	REVISION	DATE	BY
Engineer: SCH	Checked By: MCG	Scale: 1" = 2500'	
Technician: DW	Date: 11-30-15	Field Bk: 1140895	
Project No: 1140895			Sheet 1 of 1

NEXTERA ENERGY - BRADY WIND II, LLC

AS-BUILT OVERALL SITE PLAN

SNYDER & ASSOCIATES, INC.


1751 MADISON AVENUE
COUNCIL BLUFFS, IA 51503
712-322-3202 | www.snyder-associates.com

Project No: 1140895

Sheet 1 of 1

LEGEND

- 72 2.10MW GE TURBINE WITH NUMBER (116 Meter Rotor 80 Meter Tower 06-27-16 Array)
- 51 1.79 MW GElix TURBINE WITH NUMBER (100 Meter Rotor 80 Meter Tower 06-27-16 Array Turbines 41-43, 46, 47, 50 & 51)
- SM01 MET TOWER (SM01 = 80 Meter - 02-19-16 Location)
- ACCESS ROAD = 175,925' ± LENGTH
- ALTERNATE ACCESS ROAD
- TEMPORARY ACCESS ROAD
- UNDERGROUND COLLECTION
- CONSTRUCTION EASEMENT
- EXISTING TRANSMISSION LINE
- EXISTING PIPELINE
- PROPERTY BOUNDARY
- EXISTING ROAD RIGHT-OF-WAY
- NON PARTICIPATING PARCEL INSIDE PROJECT BOUNDARY
- PROJECT BOUNDARY
- MICROWAVE BEAM PATH (With 202' Setback)
- FLOODPLAIN
- WETLANDS
- NWI WETLAND
- 300' RAPTOR NESTS BUFFER
- DAKOTA SKIPPER(GOOD) & SPRAGUES PIPIT HABITAT BOUNDARIES
- CULTURAL
- NORTH DAKOTA TRUST LANDS
- PLOTS (Private Lands Open To Sportsmen)
- PRIME FARMLAND
- OCCUPIED HOUSE
- 2000' SETBACK

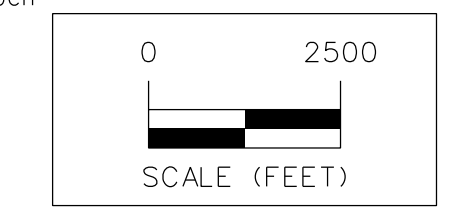

ISSUE DATE: 02-28-2017

2/28/2017 8:41:54 AM
 D:\114_0895\Cadd\1140895_BRADY_WIND_AS-BUILT_TURBINE_SITE_PLAN.dgn
 Y:\nwind\brady\1140895\cadd\1140895_brady_wind_as-built_turbine_site-plan.dwg
 11/30/15 11:30:15 AM
 1140895