




Ramberg Truck Facility



-  As-Built Centerline
-  Certified Corridor

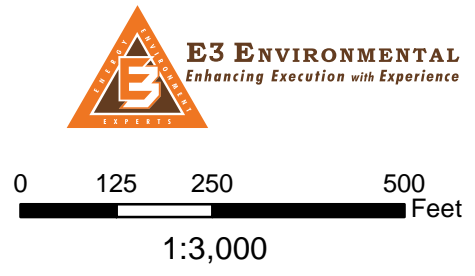

**Hess North Dakota
Export Logistics LLC**
 ETP Pipeline (PU-16-189)
 As-Built Alignment and
 Certified Corridor
Page 1 of 2
 Williams County, North Dakota



 As-Built Centerline
 Certificated Corridor


 **E3 ENVIRONMENTAL**
Enhancing Execution with Experience

0 125 250 500 Feet
 1:3,000

**Hess North Dakota
 Export Logistics LLC**
 ETP Pipeline (PU-16-189)
 As-Built Alignment and
 Certificated Corridor
Page 2 of 2
 Williams County, North Dakota