




- As Built Centerline
- Areas Out of Corridor
- PSC Approved Route

**Y-Grade PSC Corridor and
As Built Centerline**




Page: 1
0 165 330 660 Feet

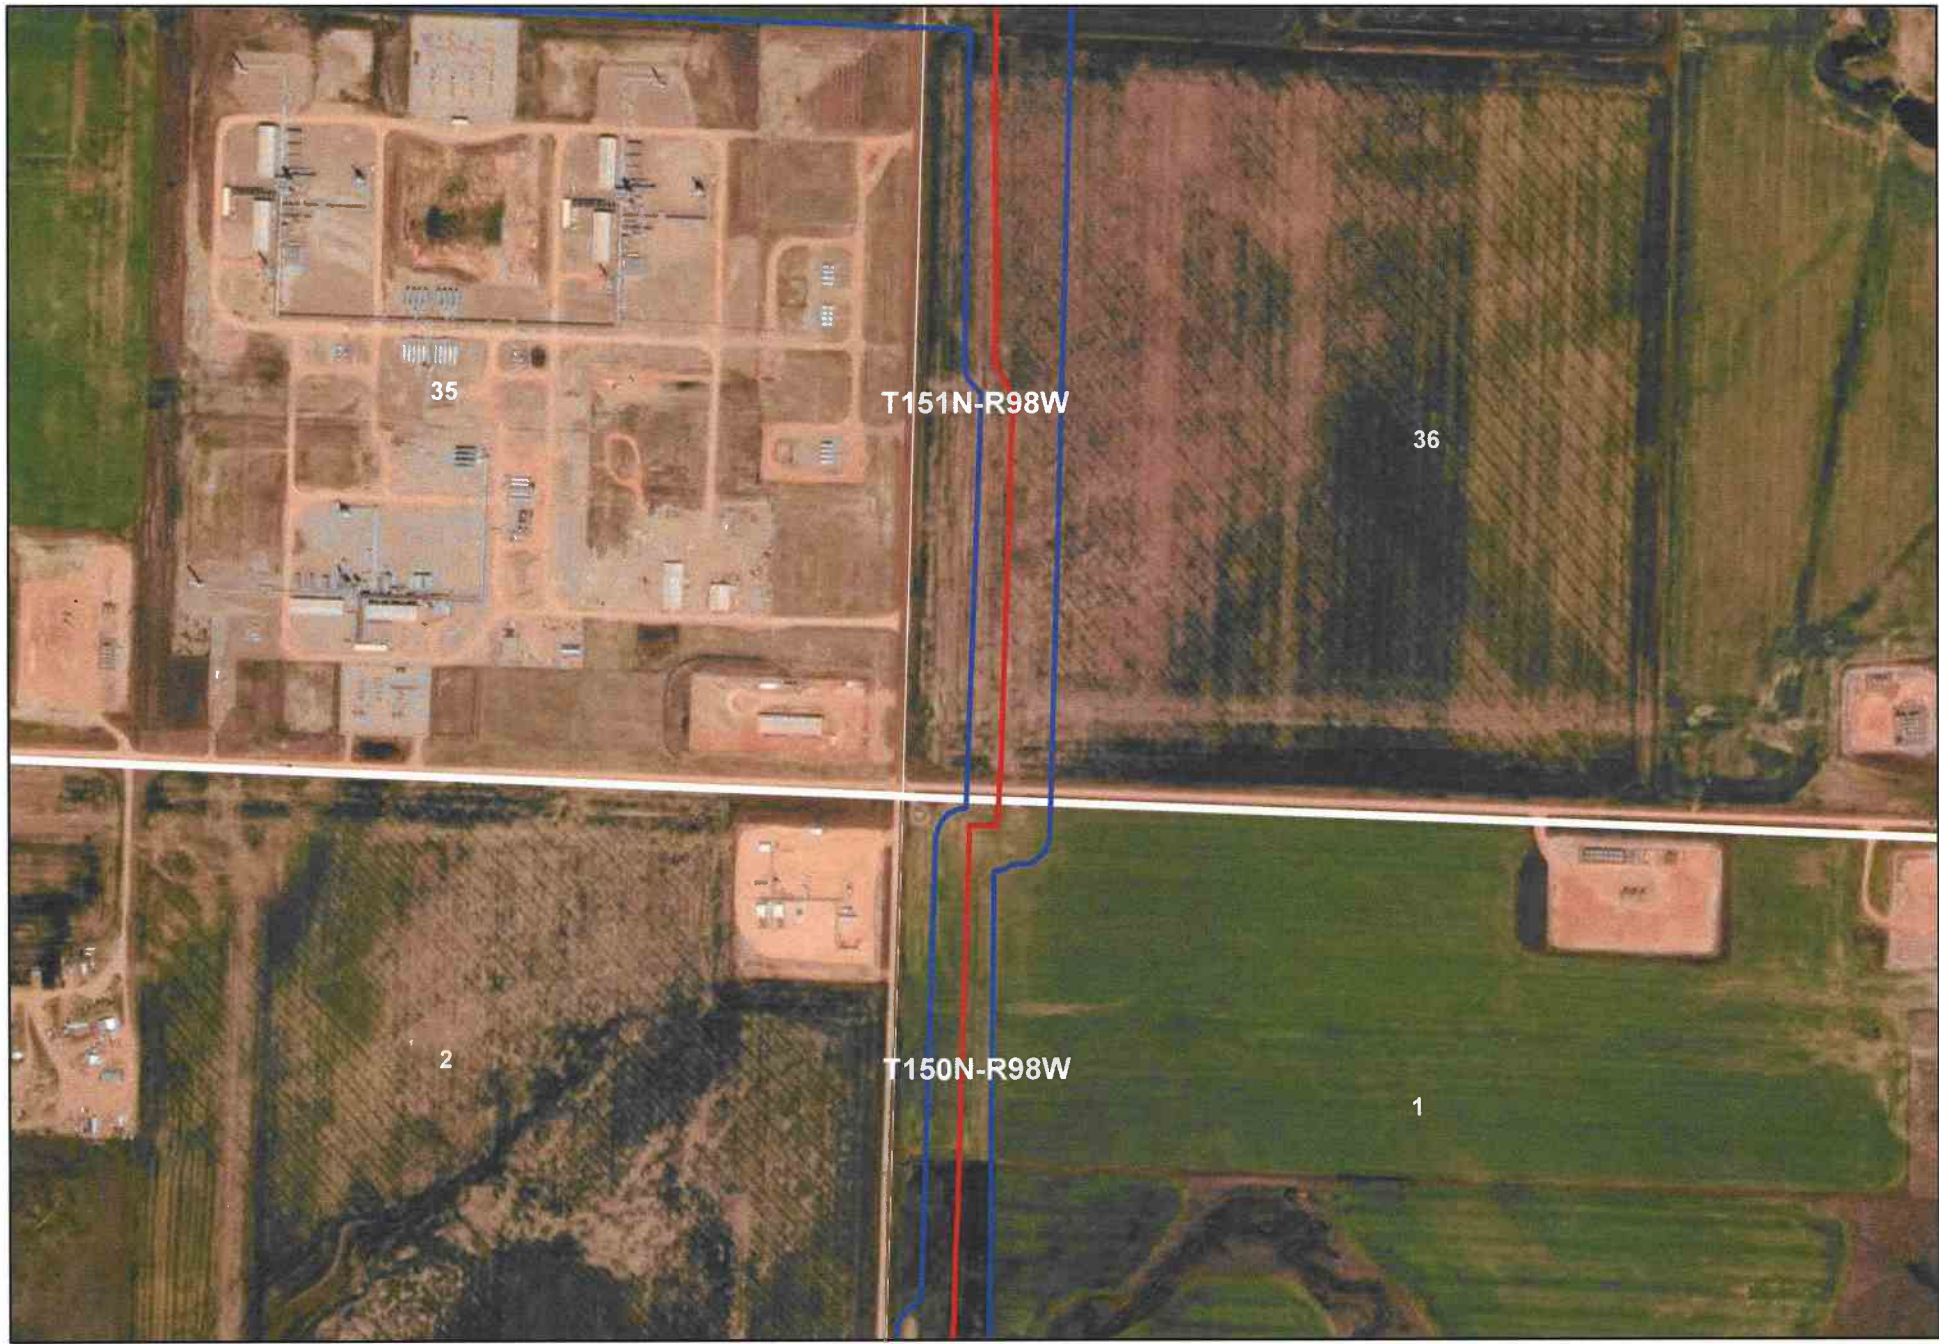

- As Built Centerline
- Areas Out of Corridor
- PSC Approved Route

**Y-Grade PSC Corridor and
As Built Centerline**

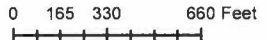



- As Built Centerline
- Areas Out of Corridor
- PSC Approved Route

**Y-Grade PSC Corridor and
As Built Centerline**





- As Built Centerline
- Areas Out of Corridor
- PSC Approved Route


**Y-Grade PSC Corridor and
As Built Centerline**





- As Built Centerline
- Areas Out of Corridor
- PSC Approved Route



**Y-Grade PSC Corridor and
As Built Centerline**

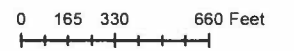



- As Built Centerline
- Areas Out of Corridor
- PSC Approved Route


**Y-Grade PSC Corridor and
As Built Centerline**

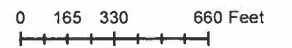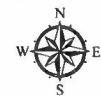



- As Built Centerline
- Areas Out of Corridor
- PSC Approved Route

**Y-Grade PSC Corridor and
As Built Centerline**

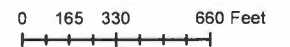



27

26

25

T150N-R98W

34

35

36

- As Built Centerline
- Areas Out of Corridor
- PSC Approved Route

**Y-Grade PSC Corridor and
As Built Centerline**





- As Built Centerline
- Areas Out of Corridor
- PSC Approved Route

**Y-Grade PSC Corridor and
As Built Centerline**






- As Built Centerline
- Areas Out of Corridor
- PSC Approved Route

Y-Grade PSC Corridor and As Built Centerline




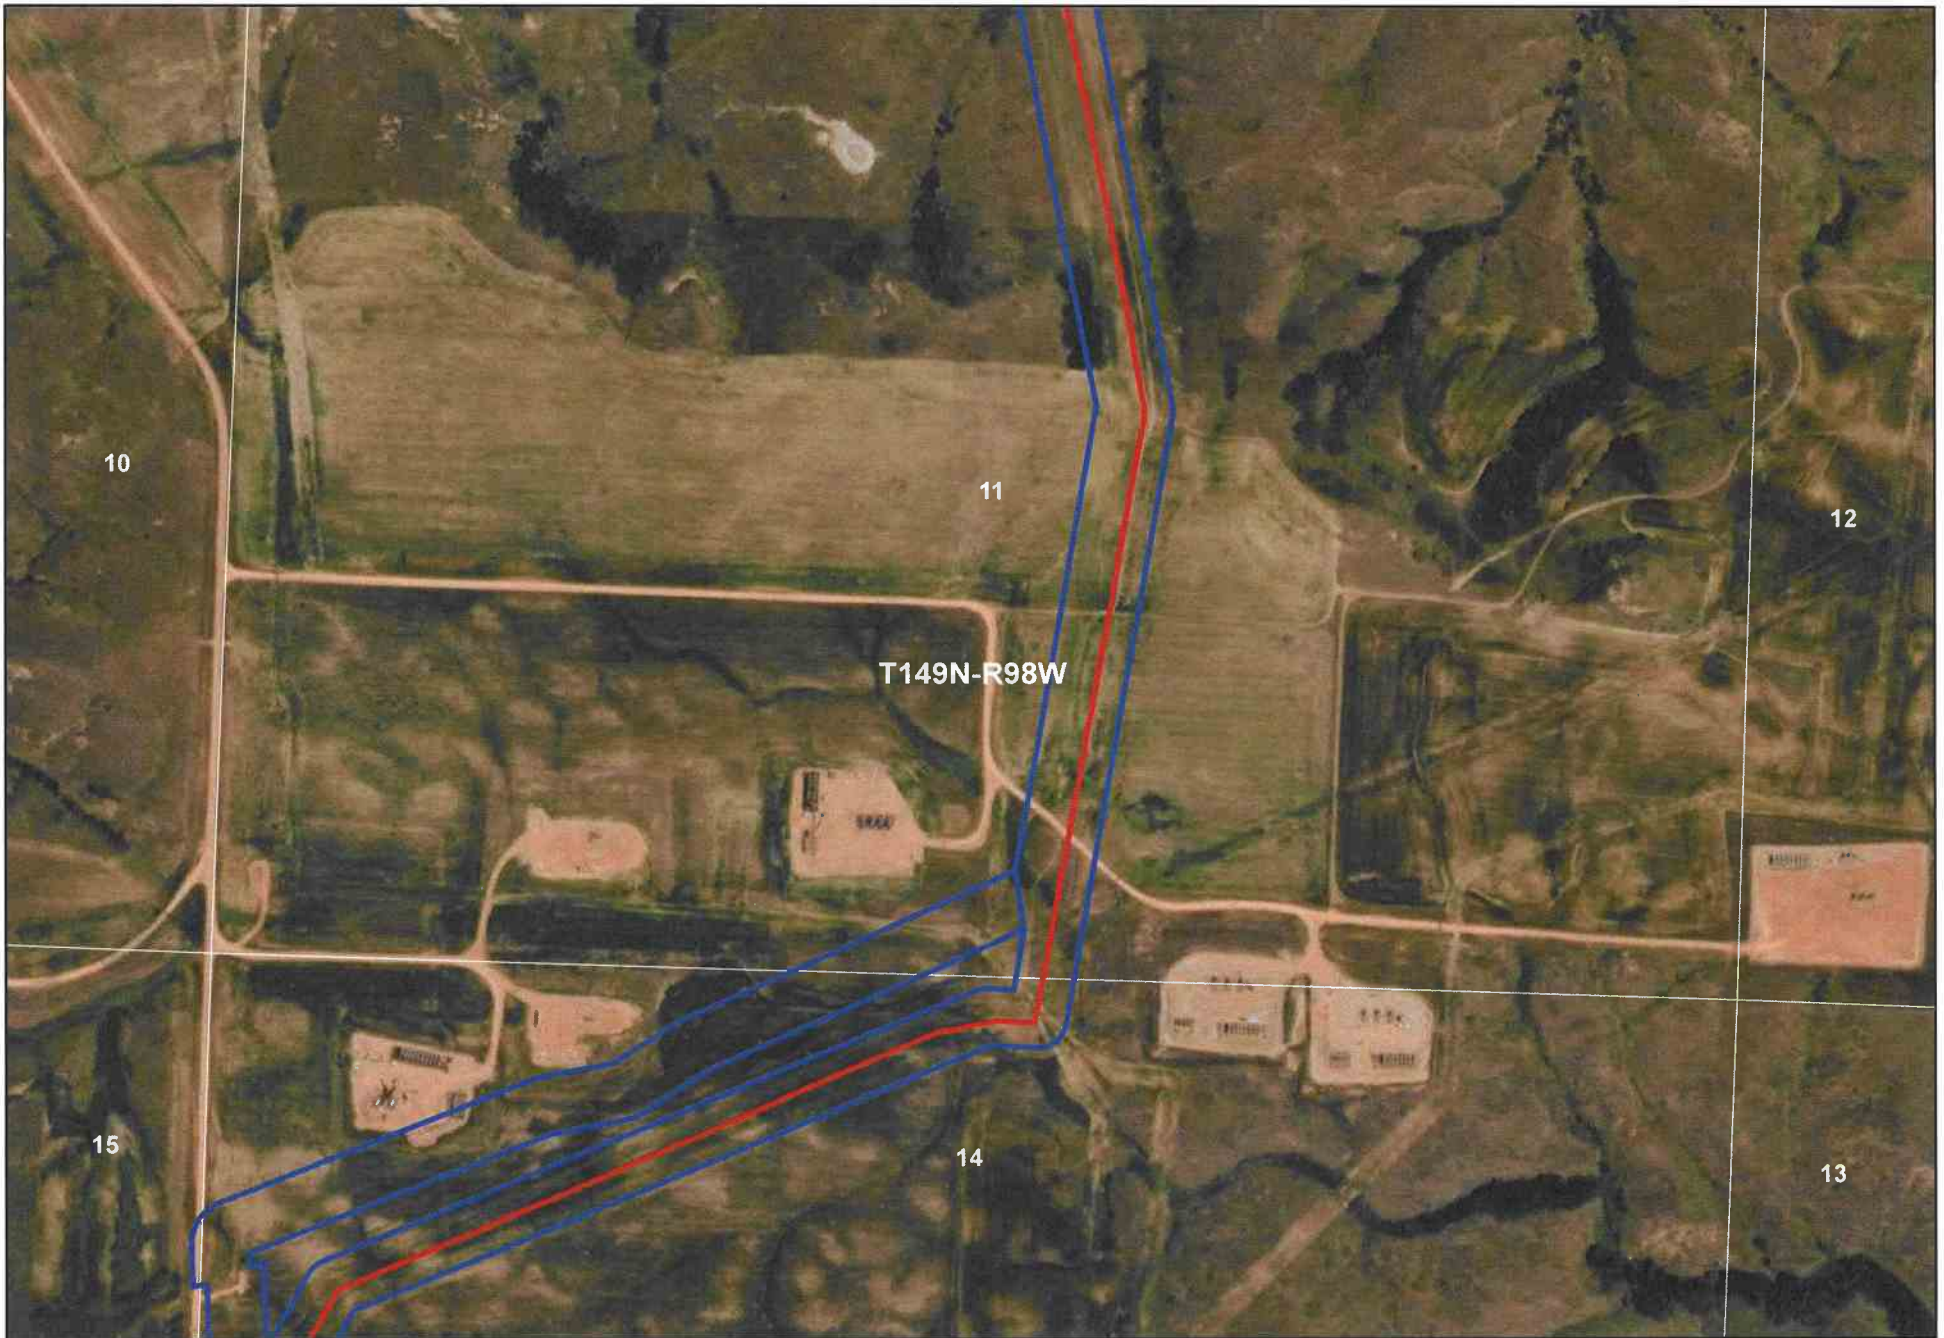

- As Built Centerline
- Areas Out of Corridor
- PSC Approved Route


**Y-Grade PSC Corridor and
As Built Centerline**



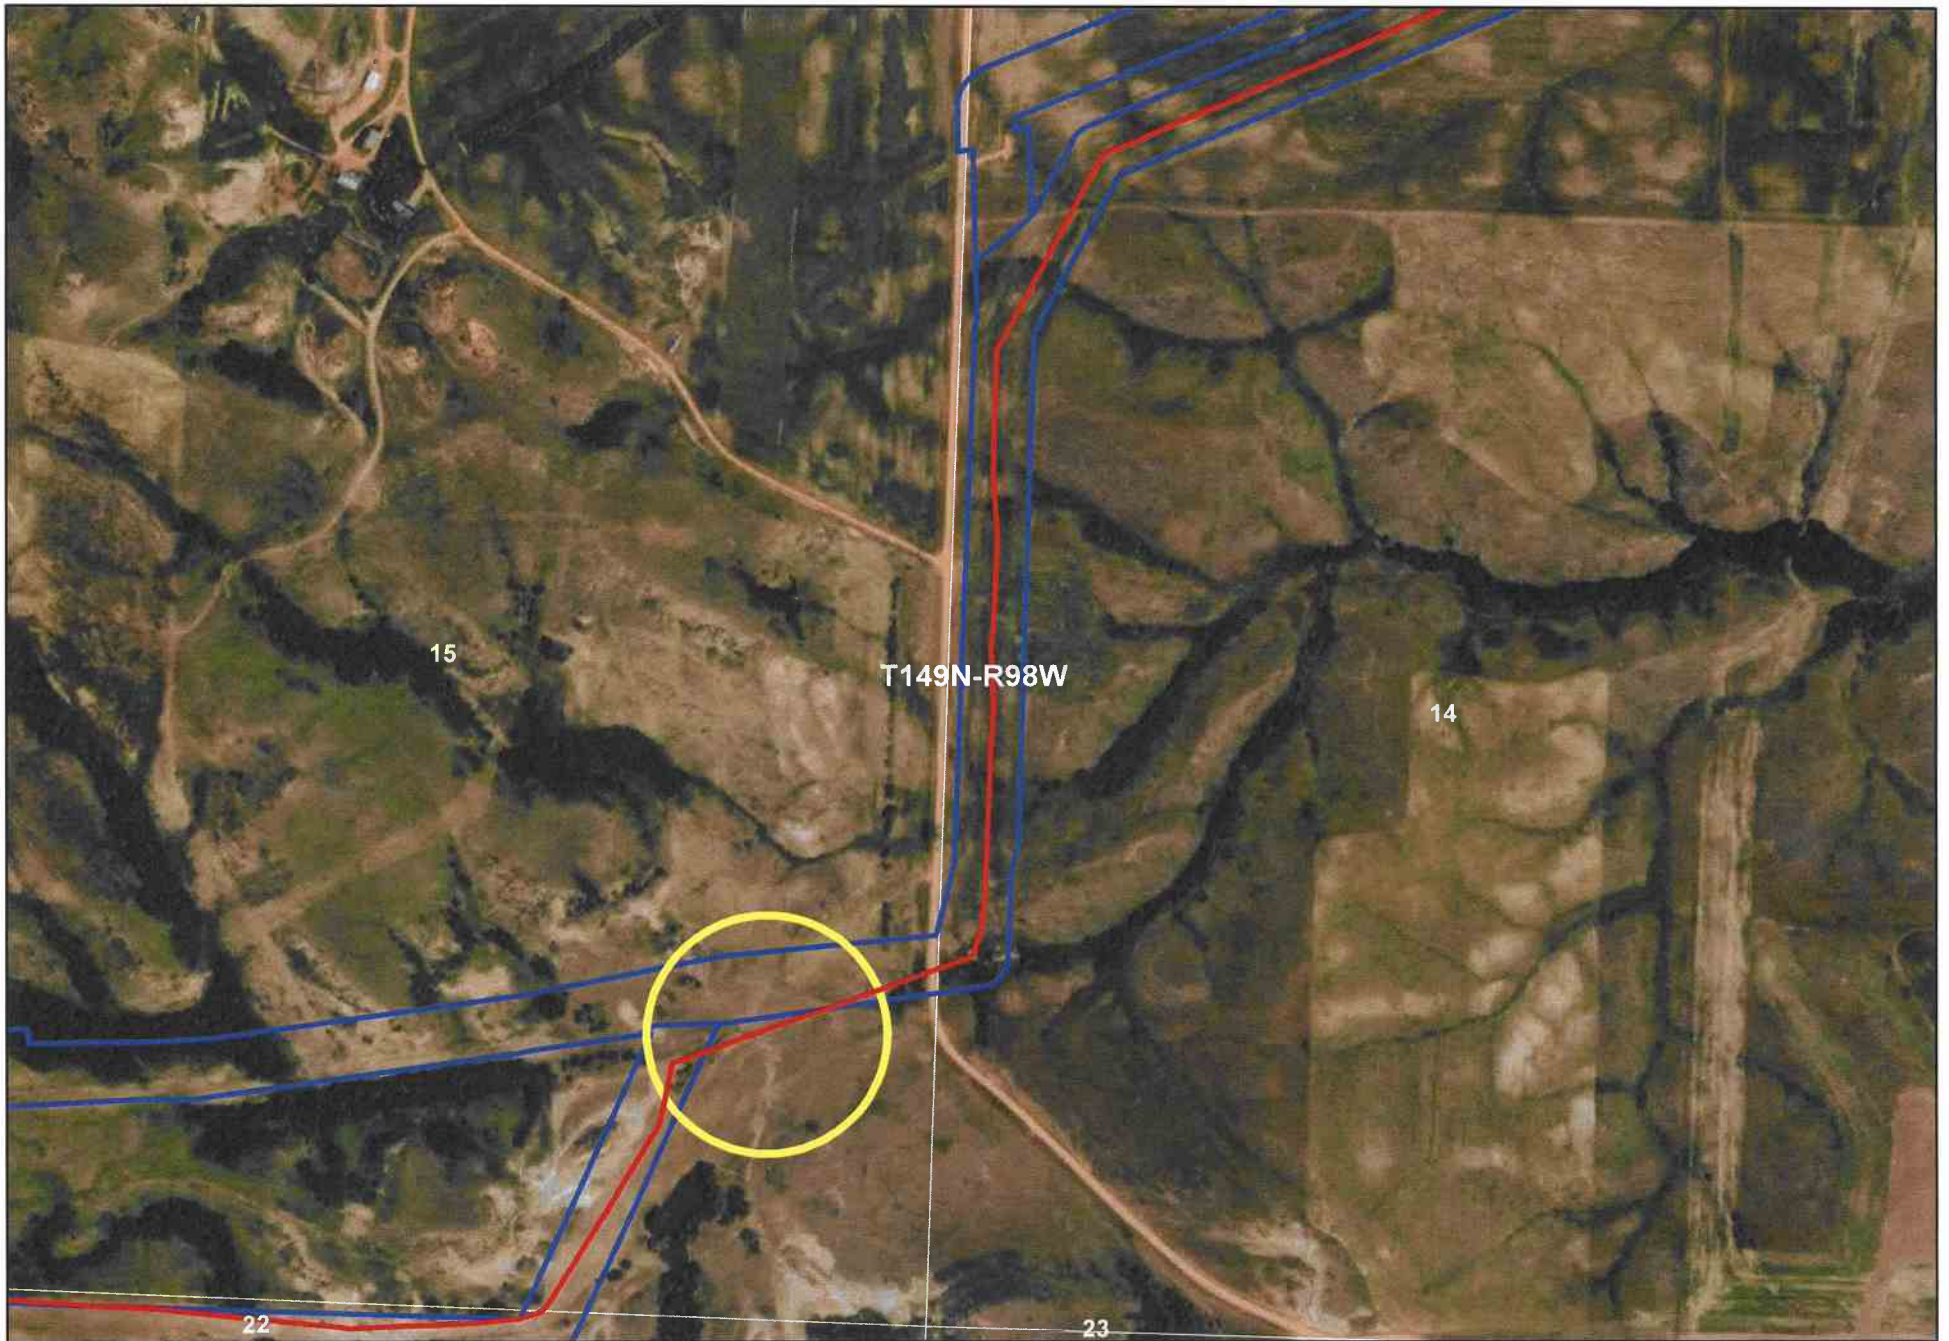

- As Built Centerline
- Areas Out of Corridor
- PSC Approved Route

**Y-Grade PSC Corridor and
As Built Centerline**

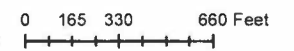



- As Built Centerline
- Areas Out of Corridor
- PSC Approved Route

**Y-Grade PSC Corridor and
As Built Centerline**





21

T149N-R98W

22

16

15

-  As Built Centerline
-  Areas Out of Corridor
-  PSC Approved Route


**Y-Grade PSC Corridor and
As Built Centerline**






- As Built Centerline
- Areas Out of Corridor
- PSC Approved Route


**Y-Grade PSC Corridor and
As Built Centerline**

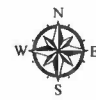

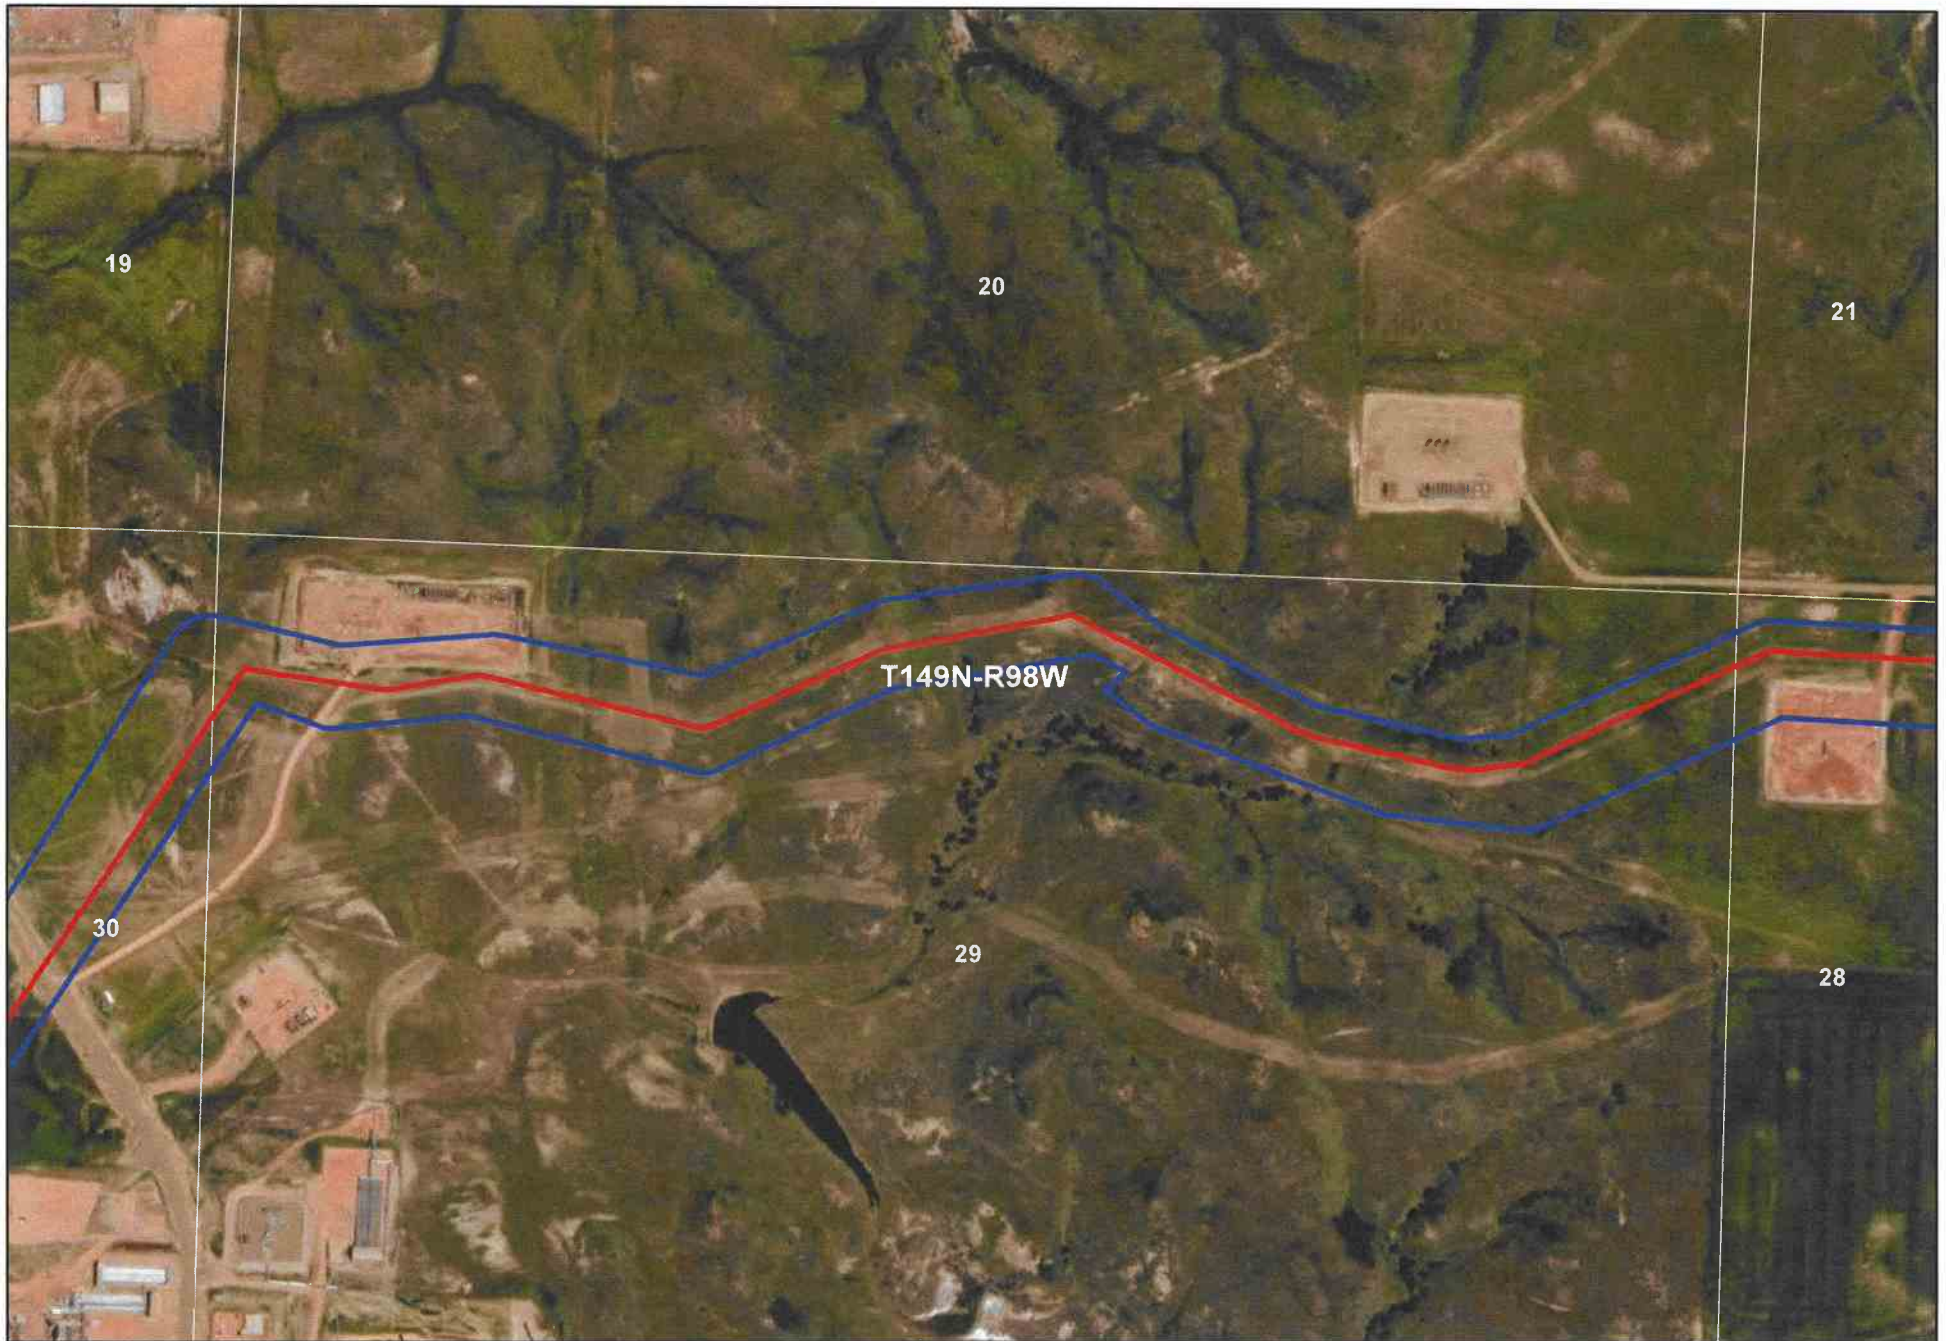

- As Built Centerline
- Areas Out of Corridor
- PSC Approved Route


**Y-Grade PSC Corridor and
As Built Centerline**

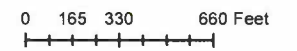



- As Built Centerline
- Areas Out of Corridor
- PSC Approved Route

**Y-Grade PSC Corridor and
As Built Centerline**

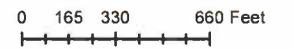



- As Built Centerline
- Areas Out of Corridor
- PSC Approved Route

**Y-Grade PSC Corridor and
As Built Centerline**





- As Built Centerline
- Areas Out of Corridor
- PSC Approved Route

**Y-Grade PSC Corridor and
As Built Centerline**






- As Built Centerline
- Areas Out of Corridor
- PSC Approved Route

**Y-Grade PSC Corridor and
As Built Centerline**




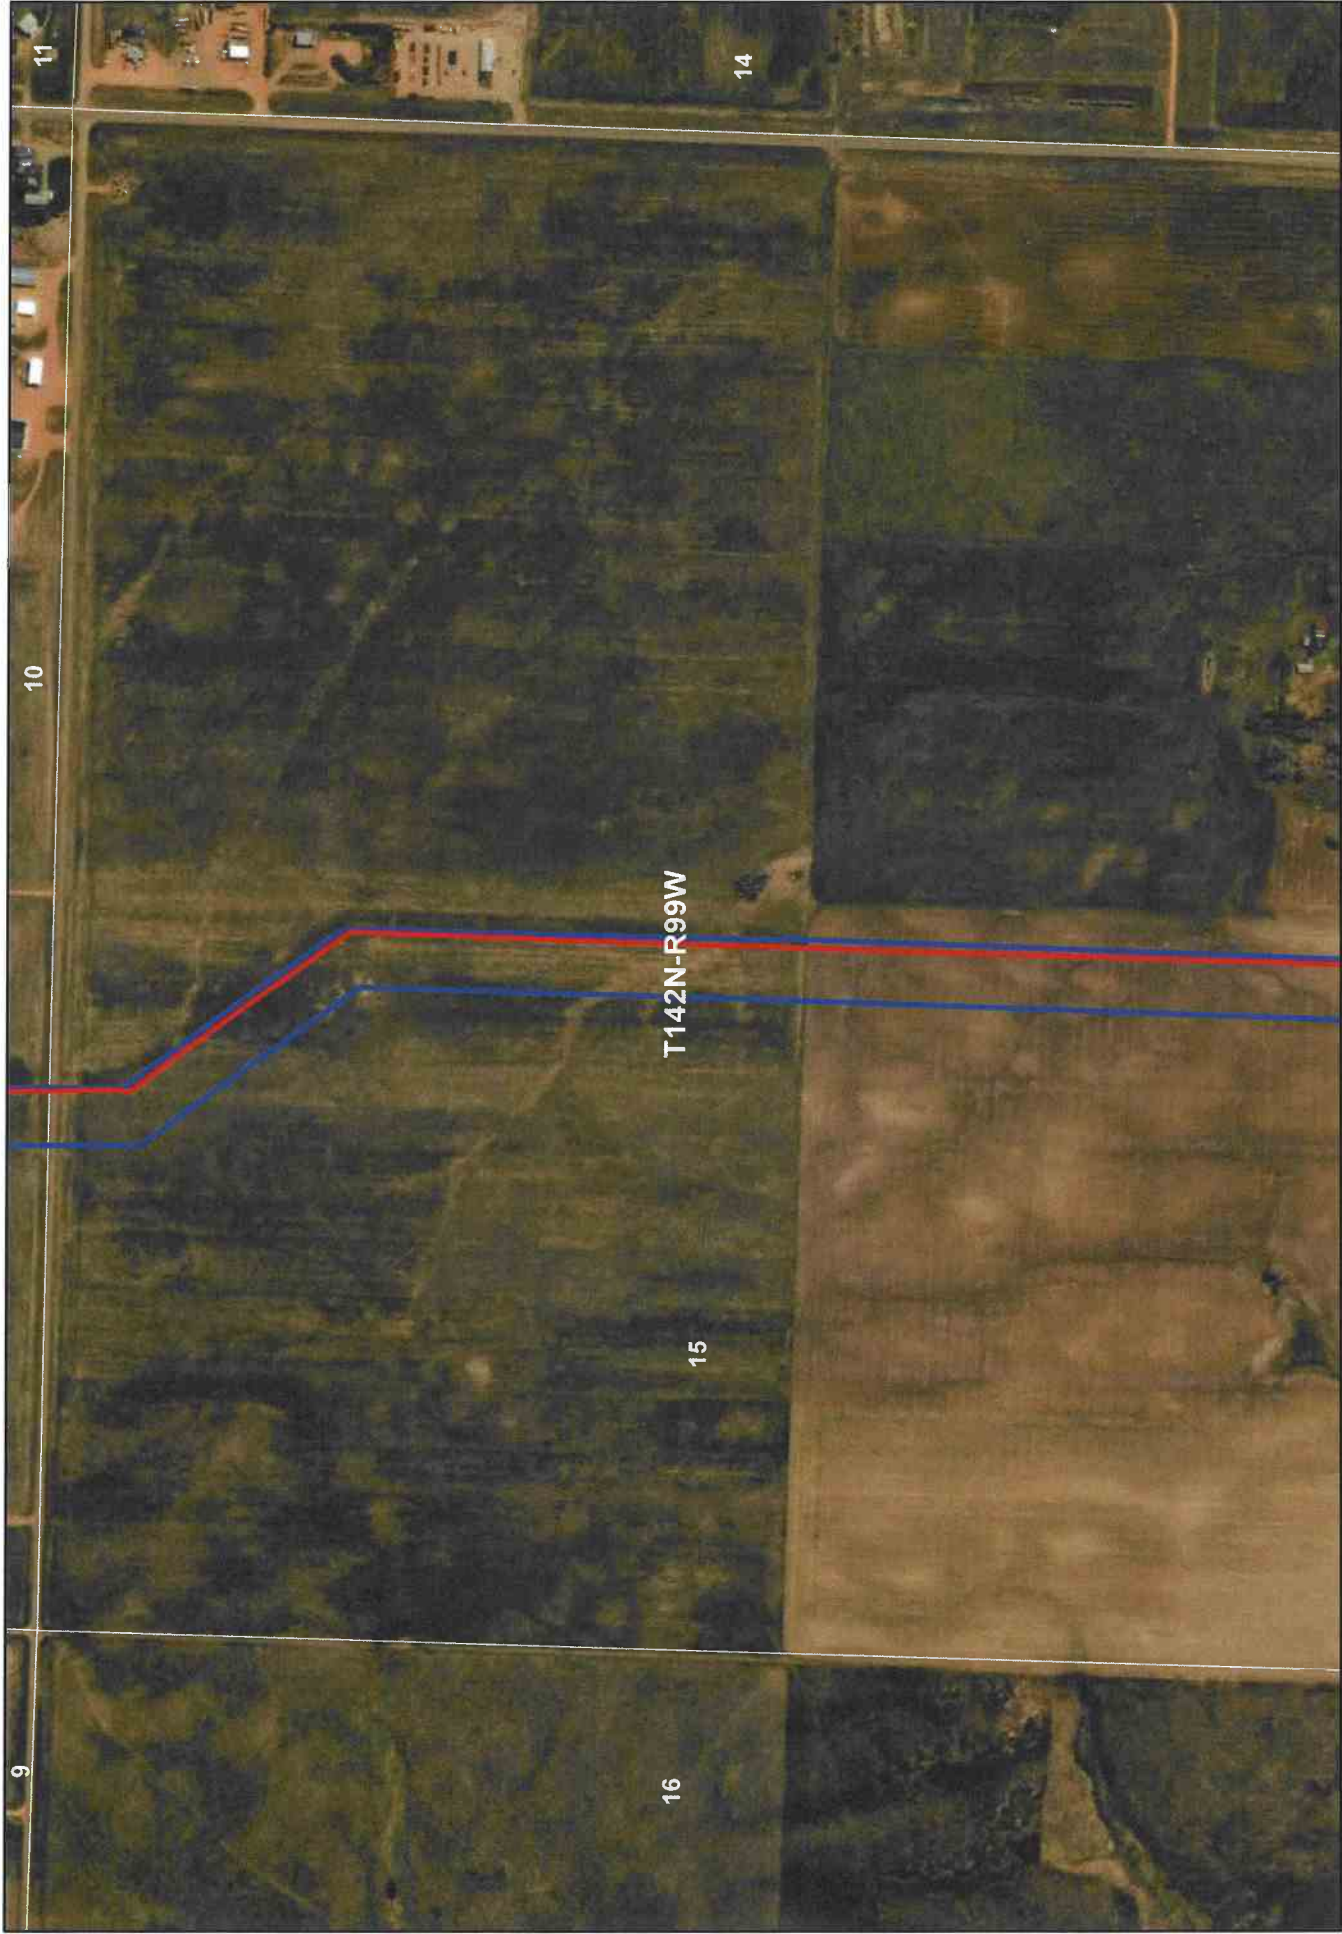

- As Built Centerline
- Areas Out of Corridor
- PSC Approved Route

**Y-Grade PSC Corridor and
As Built Centerline**



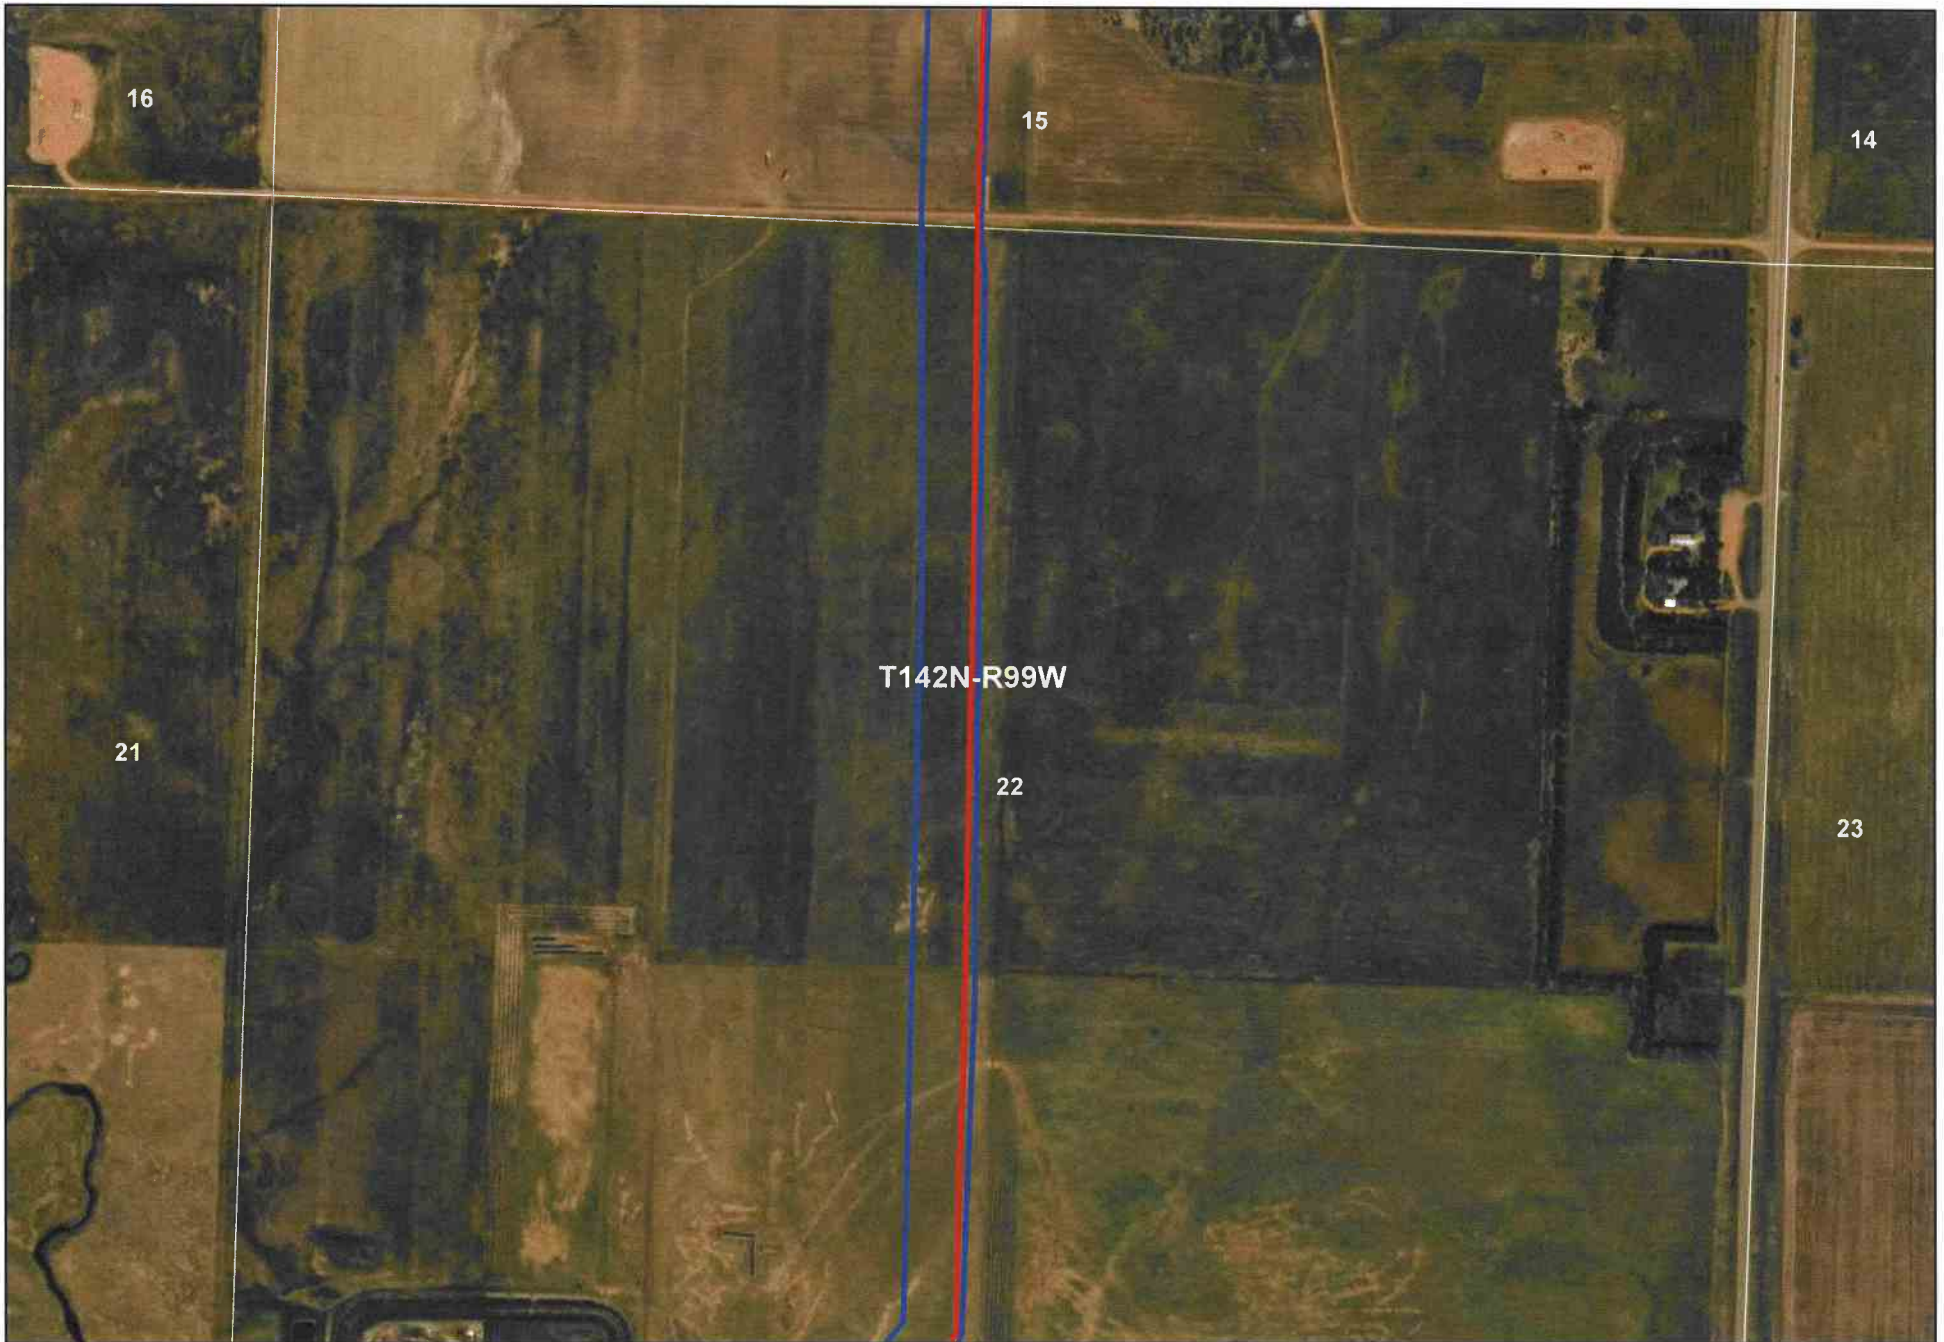

- As Built Centerline
- Areas Out of Corridor
- PSC Approved Route


**Y-Grade PSC Corridor and
As Built Centerline**





- As Built Centerline
- Areas Out of Corridor
- PSC Approved Route


**Y-Grade PSC Corridor and
As Built Centerline**

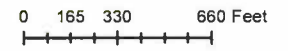




- As Built Centerline
- Areas Out of Corridor
- PSC Approved Route

**Y-Grade PSC Corridor and
As Built Centerline**

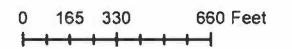


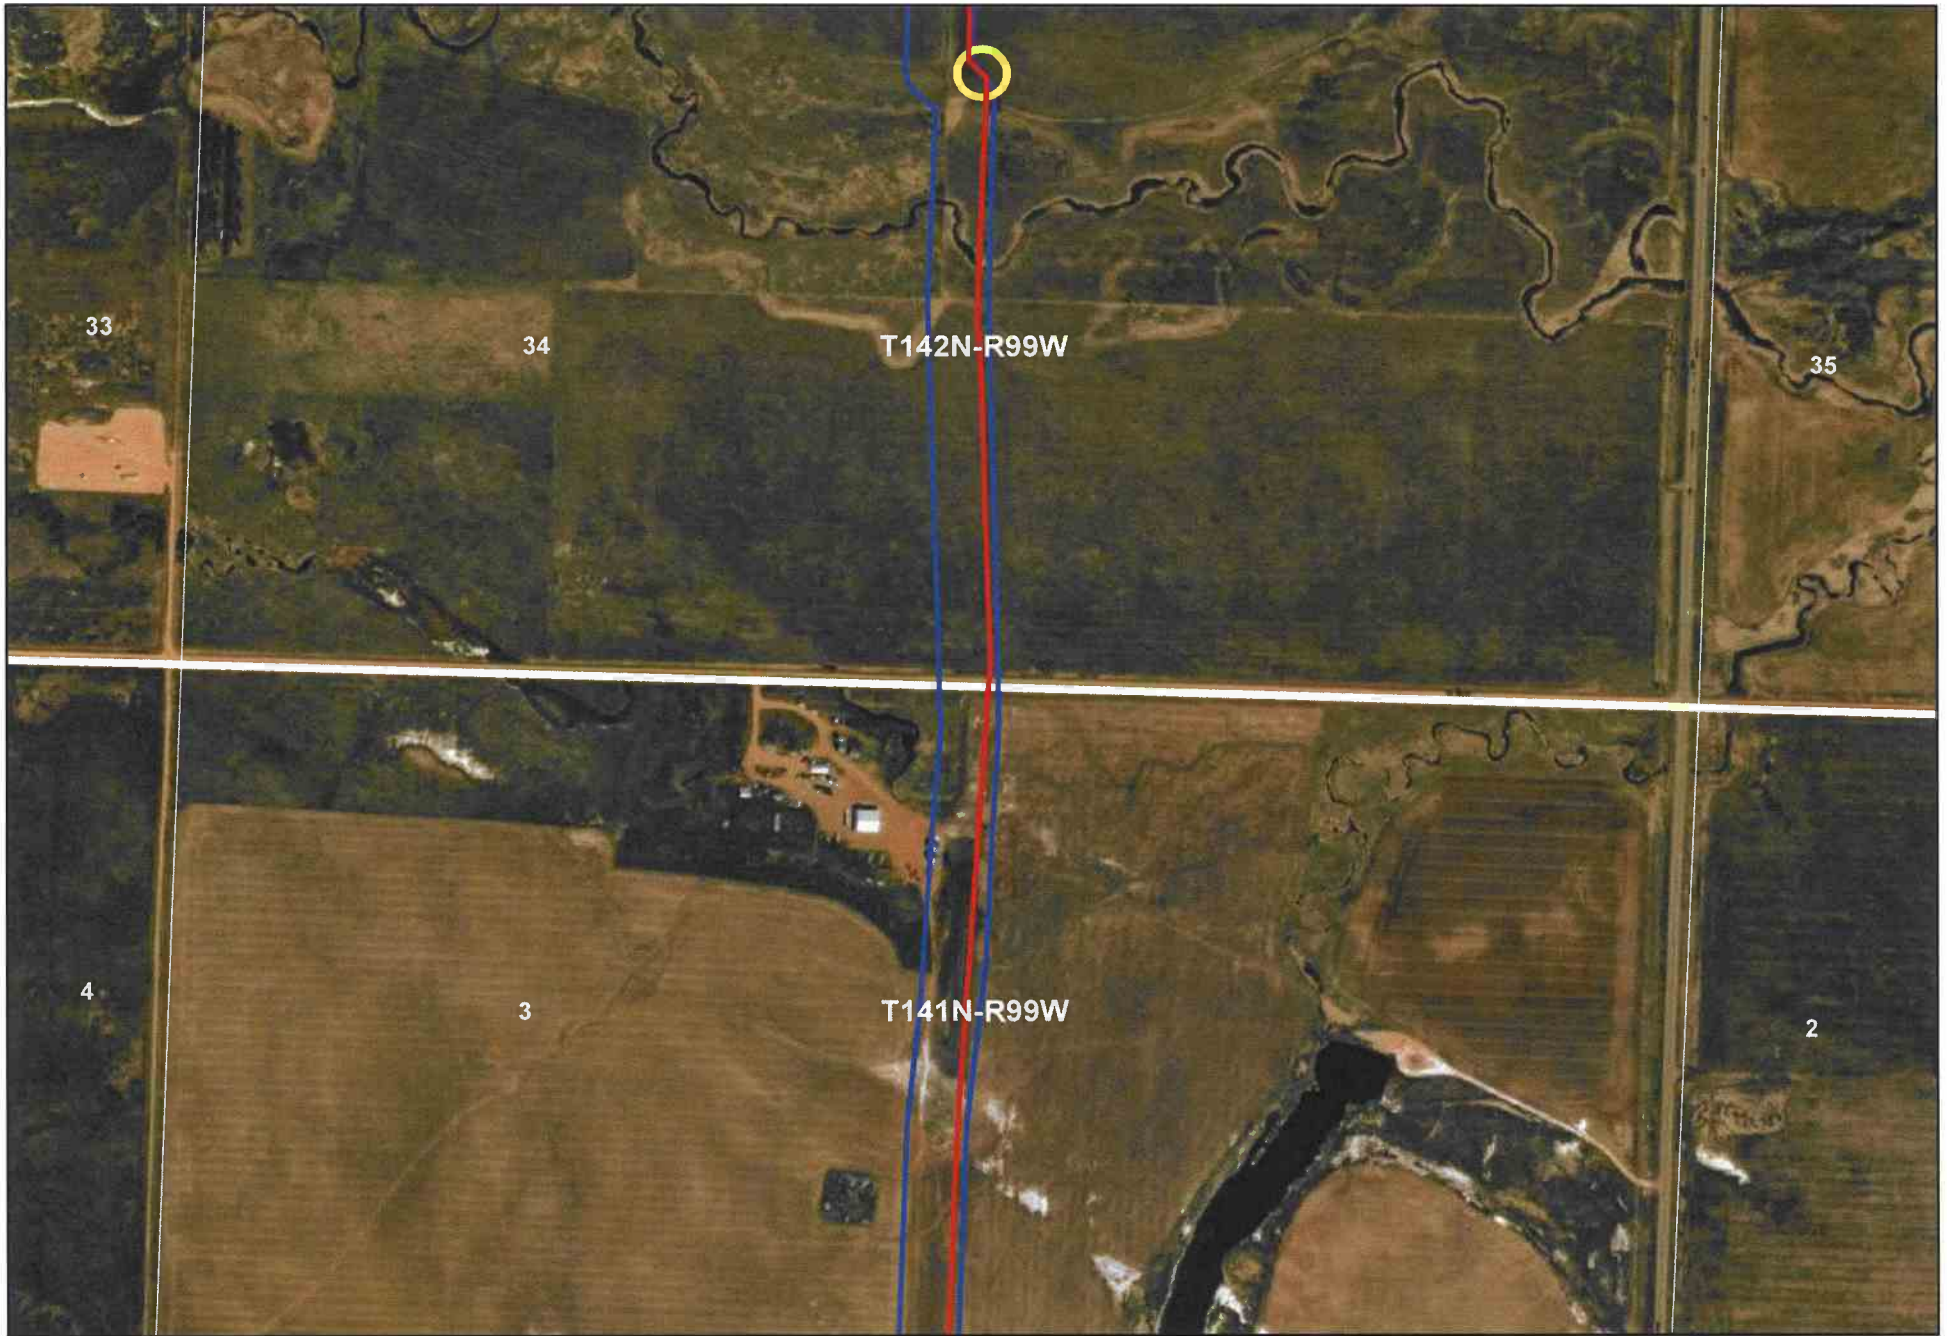

- As Built Centerline
- Areas Out of Corridor
- PSC Approved Route


**Y-Grade PSC Corridor and
As Built Centerline**




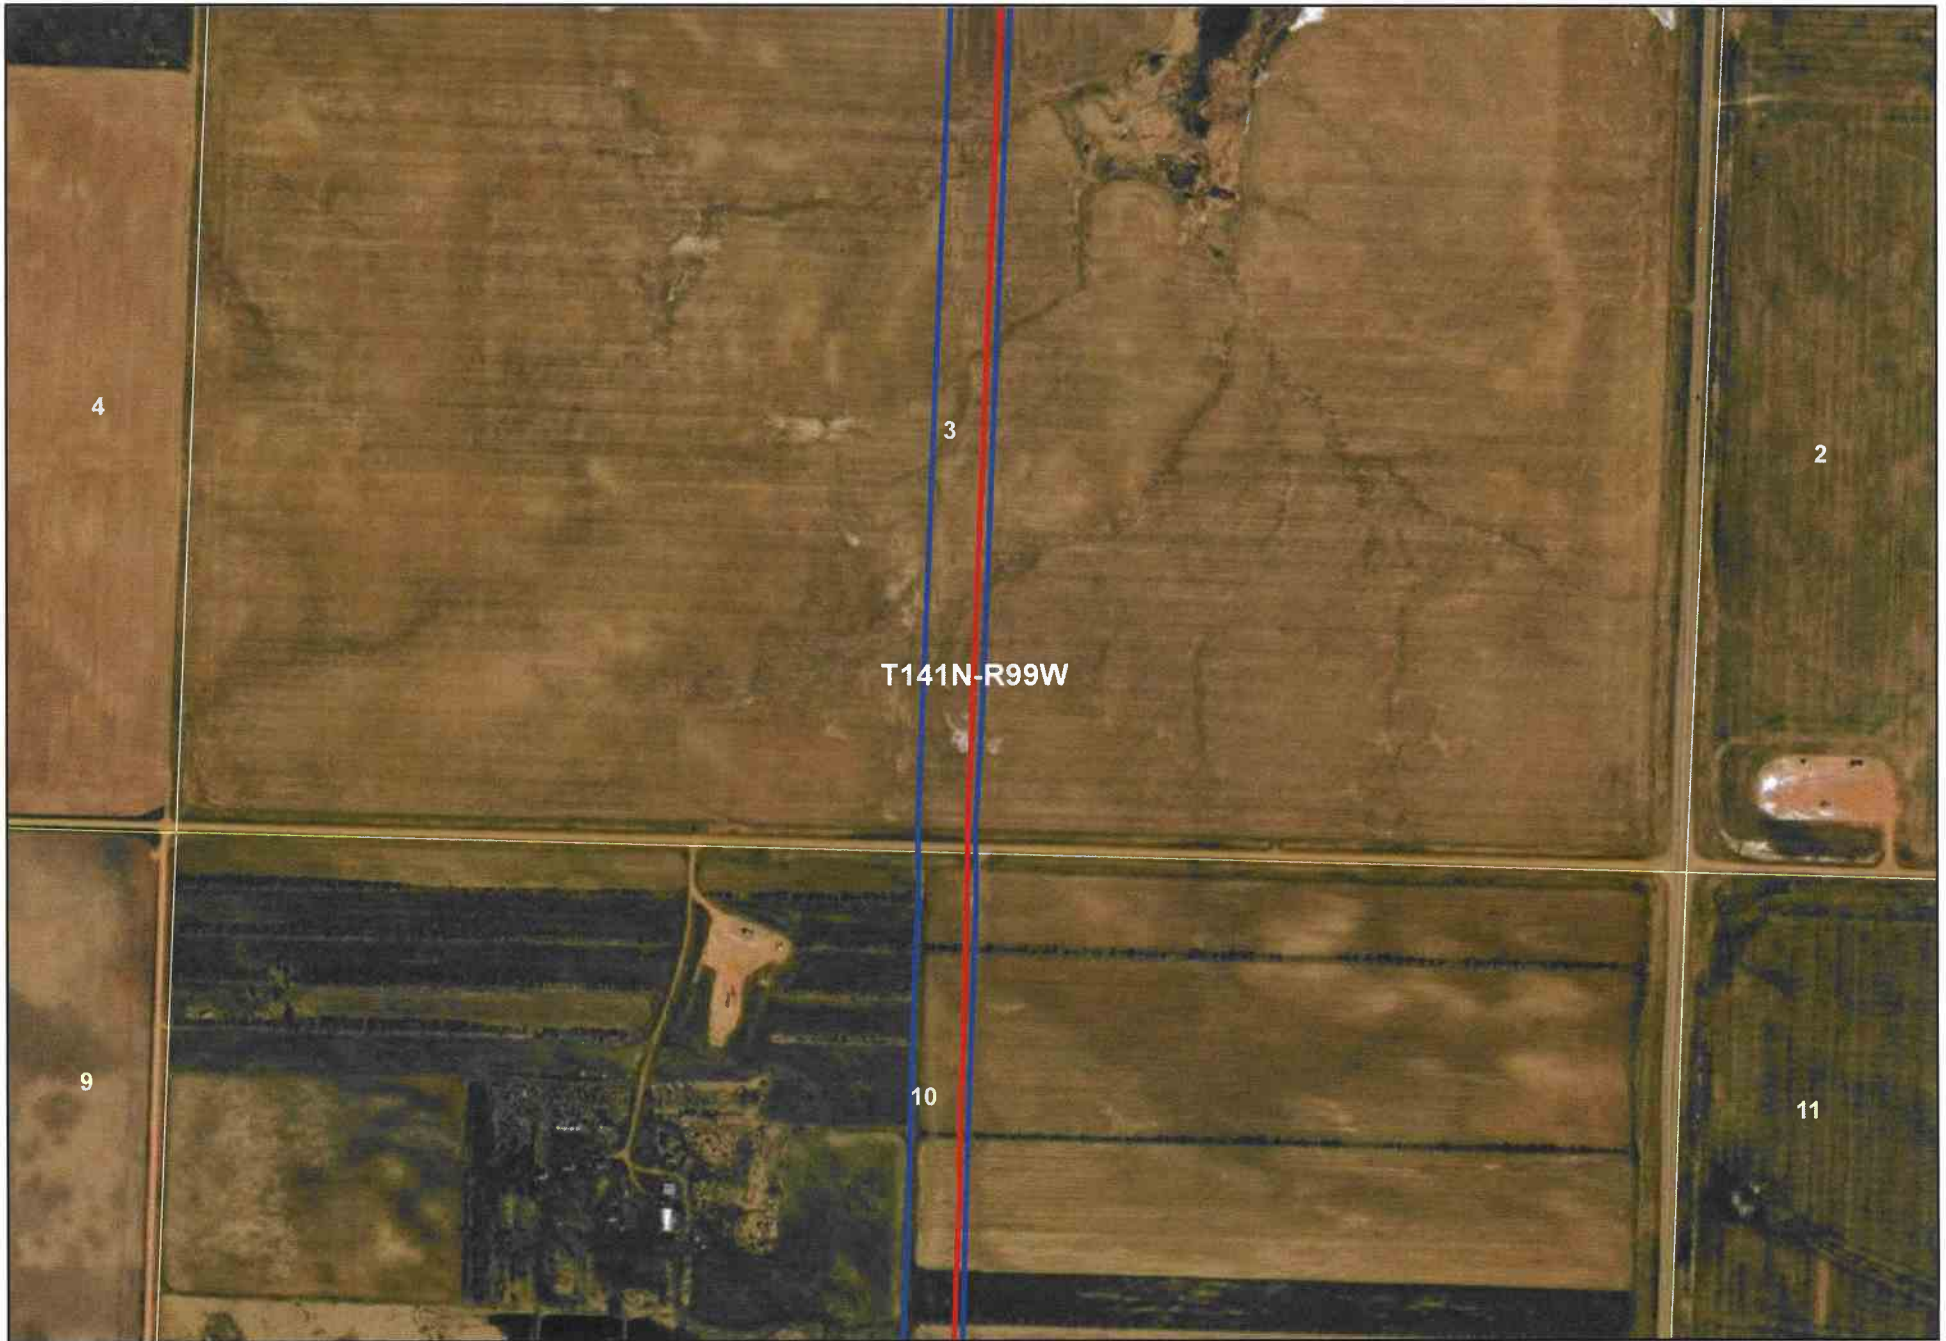

- As Built Centerline
- Areas Out of Corridor
- PSC Approved Route

**Y-Grade PSC Corridor and
As Built Centerline**

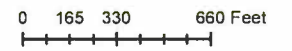


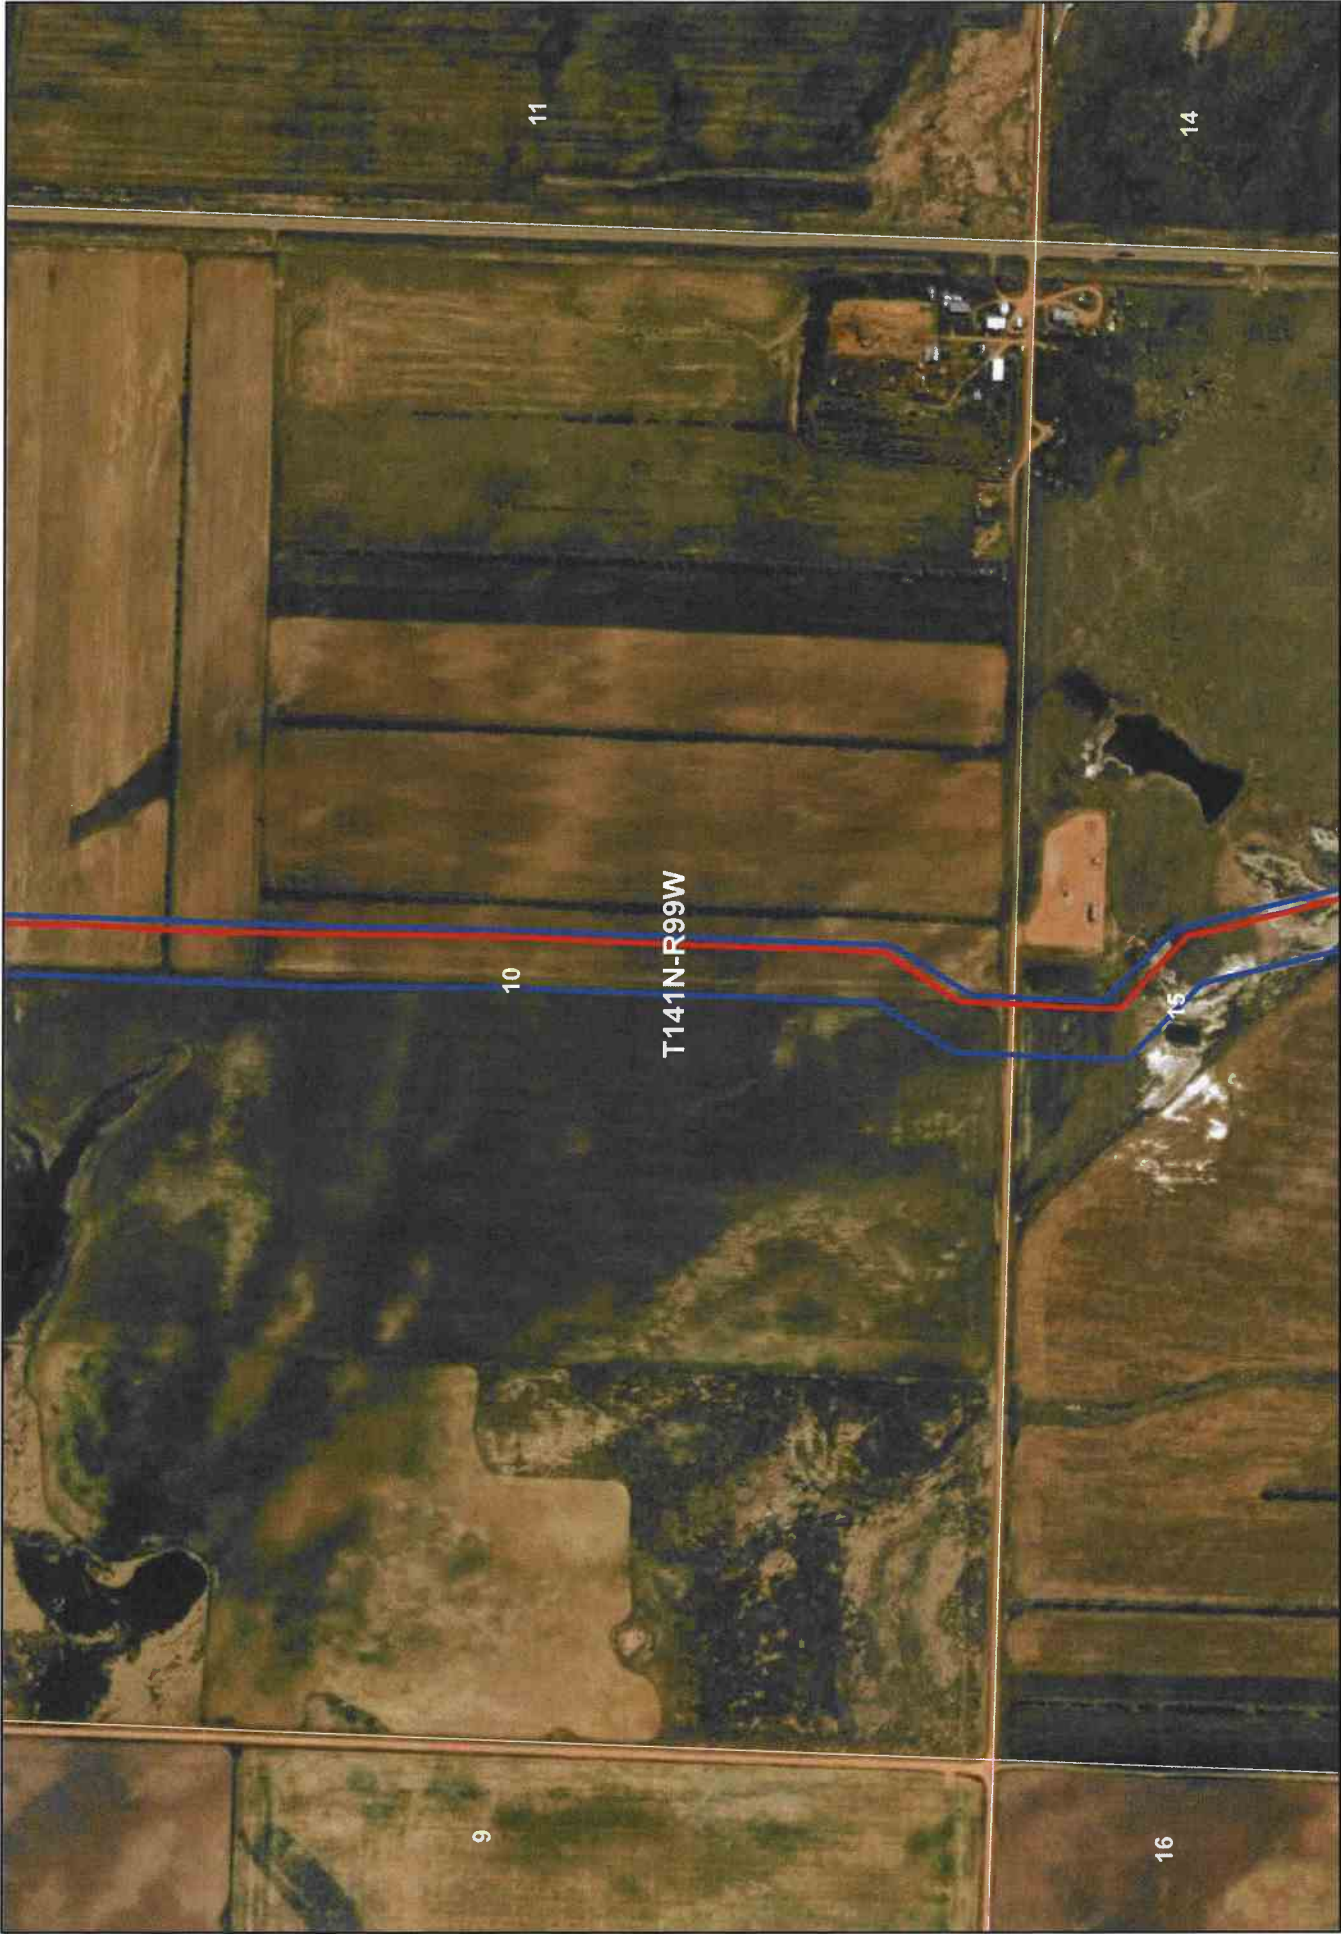

- As Built Centerline
- Areas Out of Coondor
- PSC Approved Route

**Y-Grade PSC Corridor and
As Built Centerline**



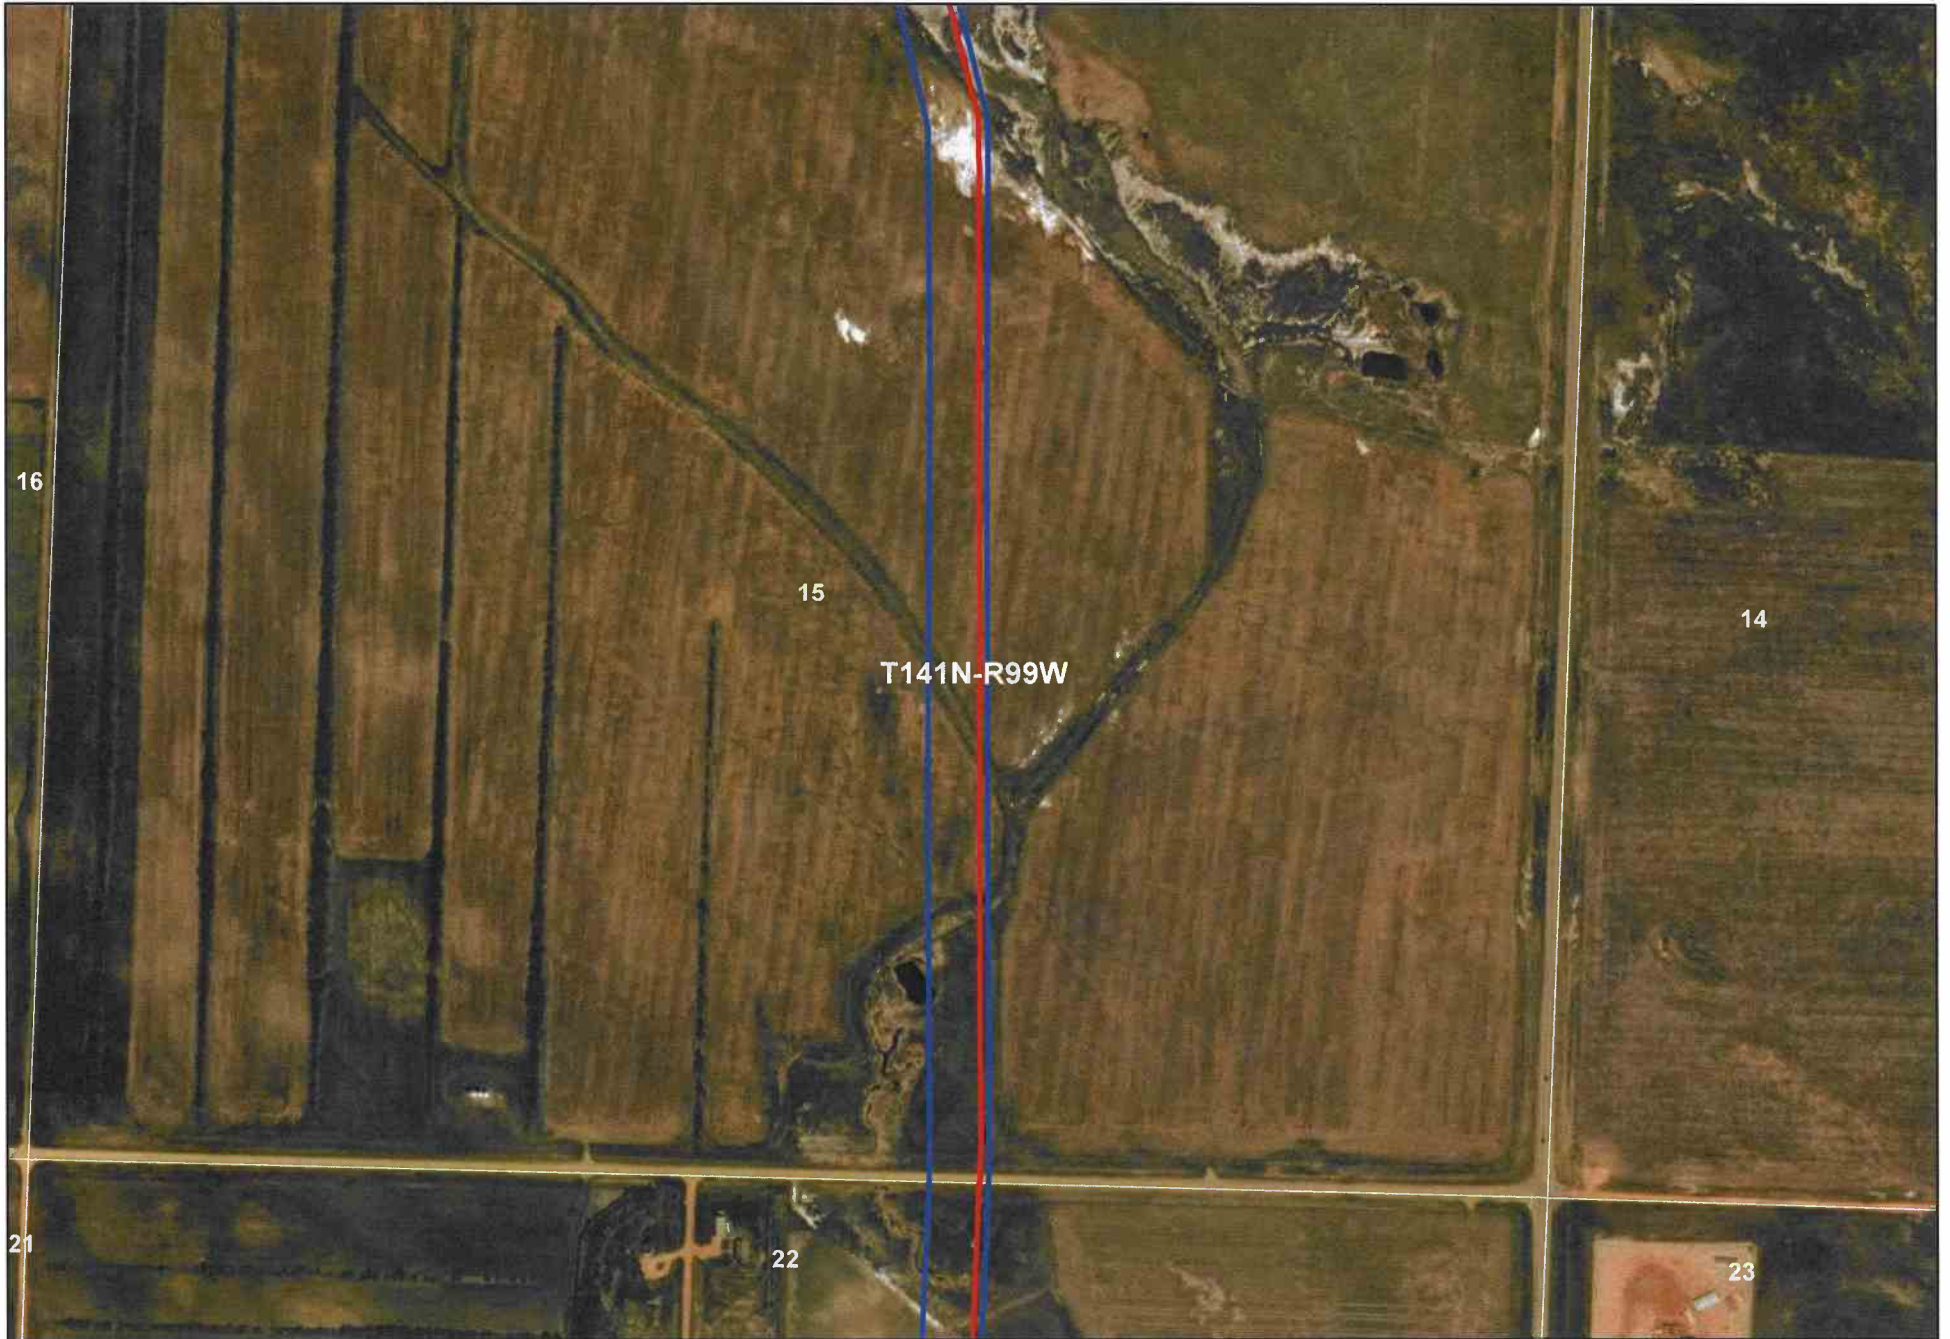


- As Built Centerline
- Areas Out of Corridor
- PSC Approved Route

**Y-Grade PSC Corridor and
As Built Centerline**



- As Built Centerline
- Areas Out of Corridor
- PSC Approved Route

**Y-Grade PSC Corridor and
As Built Centerline**

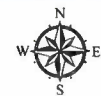



- As Built Centerline
- Areas Out of Corridor
- PSC Approved Route



**Y-Grade PSC Corridor and
As Built Centerline**






- As Built Centerline
- Areas Out of Corridor
- PSC Approved Route

**Y-Grade PSC Corridor and
As Built Centerline**



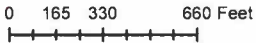


Page: 31 



- As Built Centerline
- Areas Out of Corridor
- PSC Approved Route

**Y-Grade PSC Corridor and
As Built Centerline**





Page: 32 0 165 330 660 Feet



- As Built Centerline
- Areas Out of Corridor
- PSC Approved Route

Y-Grade PSC Corridor and
As Built Centerline

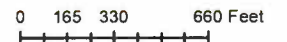



- As Built Centerline
- Areas Out of Corridor
- PSC Approved Route

**Y-Grade PSC Corridor and
As Built Centerline**






- As Built Centerline
- Areas Out of Corridor
- PSC Approved Route

**Y-Grade PSC Corridor and
As Built Centerline**



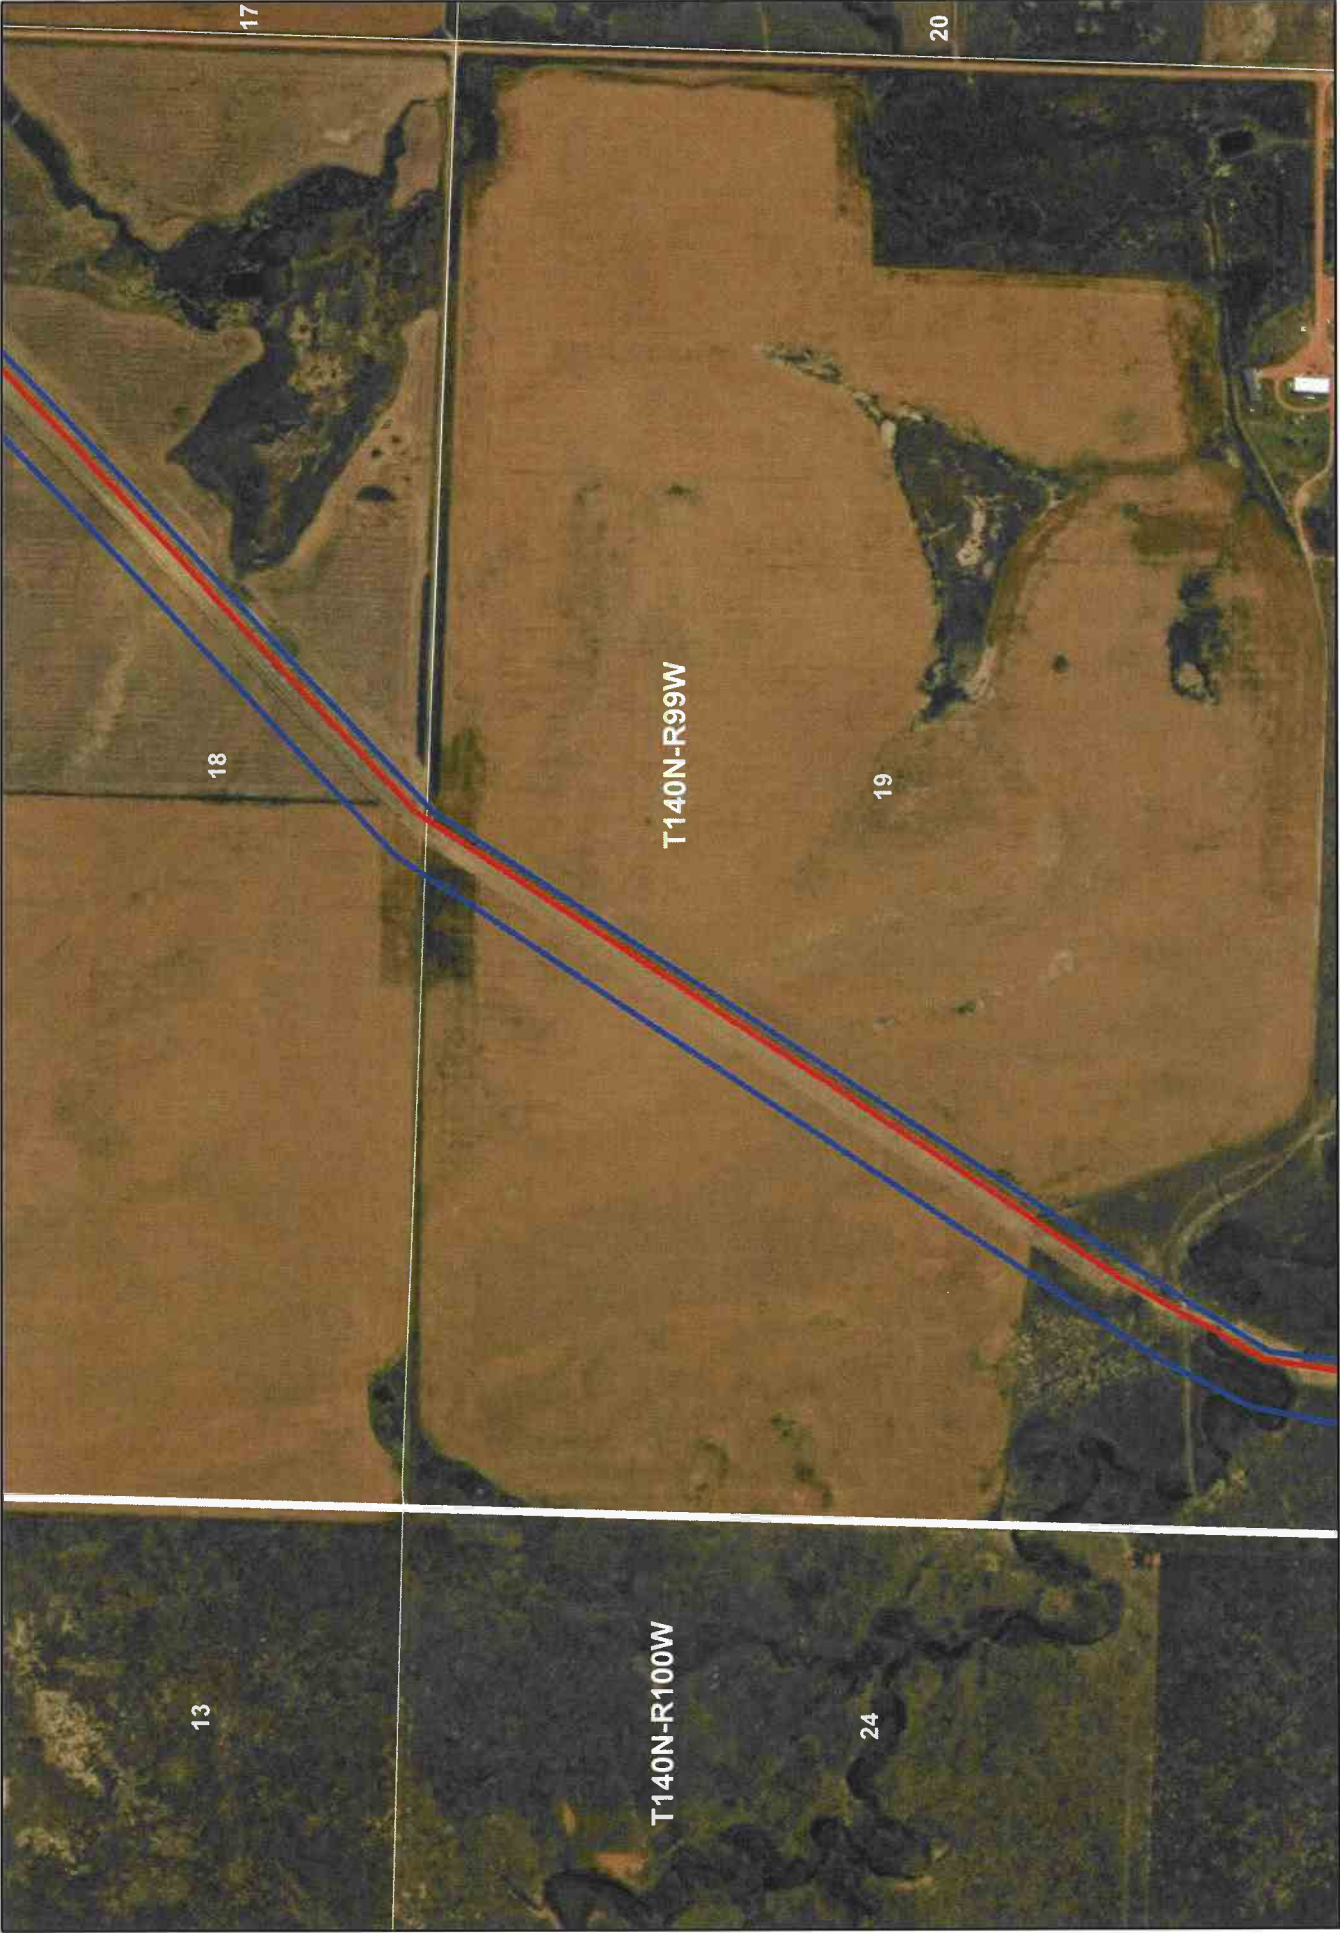

- As Built Centerline
- Areas Out of Corridor
- PSC Approved Route


**Y-Grade PSC Corridor and
As Built Centerline**





- As Built Centerline
- Areas Out of Corridor
- PSC Approved Route

**Y-Grade PSC Corridor and
As Built Centerline**

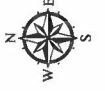



- As Built Centerline
- Areas Out of Corridor
- PSC Approved Route


**Y-Grade PSC Corridor and
As Built Centerline**





- As Built Centerline
- Areas Out of Corridor
- PSC Approved Route

**Y-Grade PSC Corridor and
As Built Centerline**

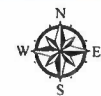



- As Built Centerline
- Areas Out of Corridor
- PSC Approved Route


**Y-Grade PSC Corridor and
As Built Centerline**






- As Built Centerline
- Areas Out of Corridor
- PSC Approved Route

**Y-Grade PSC Corridor and
As Built Centerline**

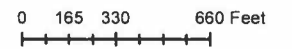


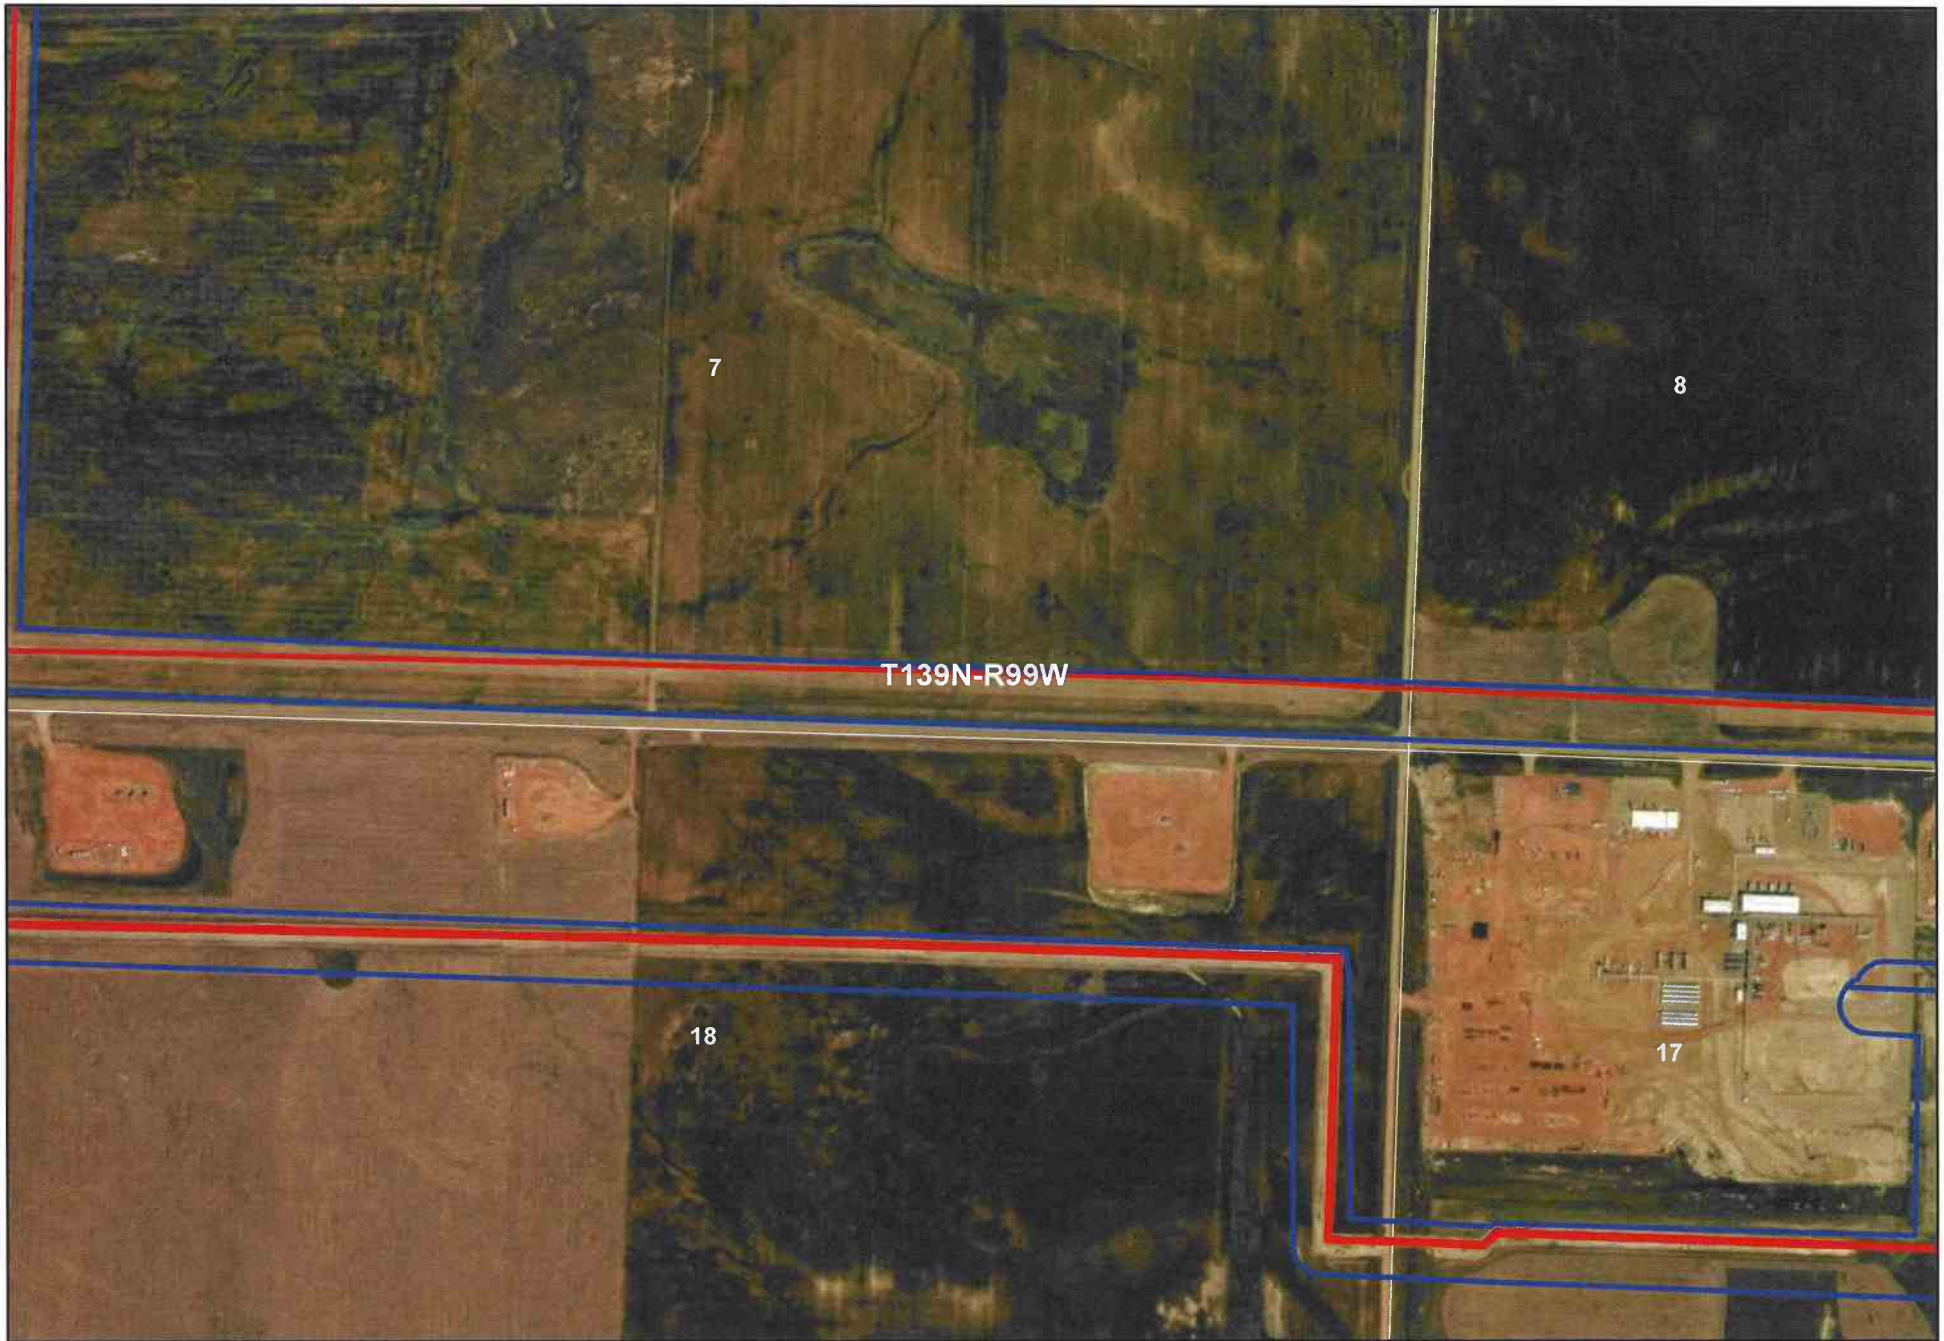

- As Built Centerline
- Areas Out of Corridor
- PSC Approved Route

Y-Grade PSC Corridor and
As Built Centerline



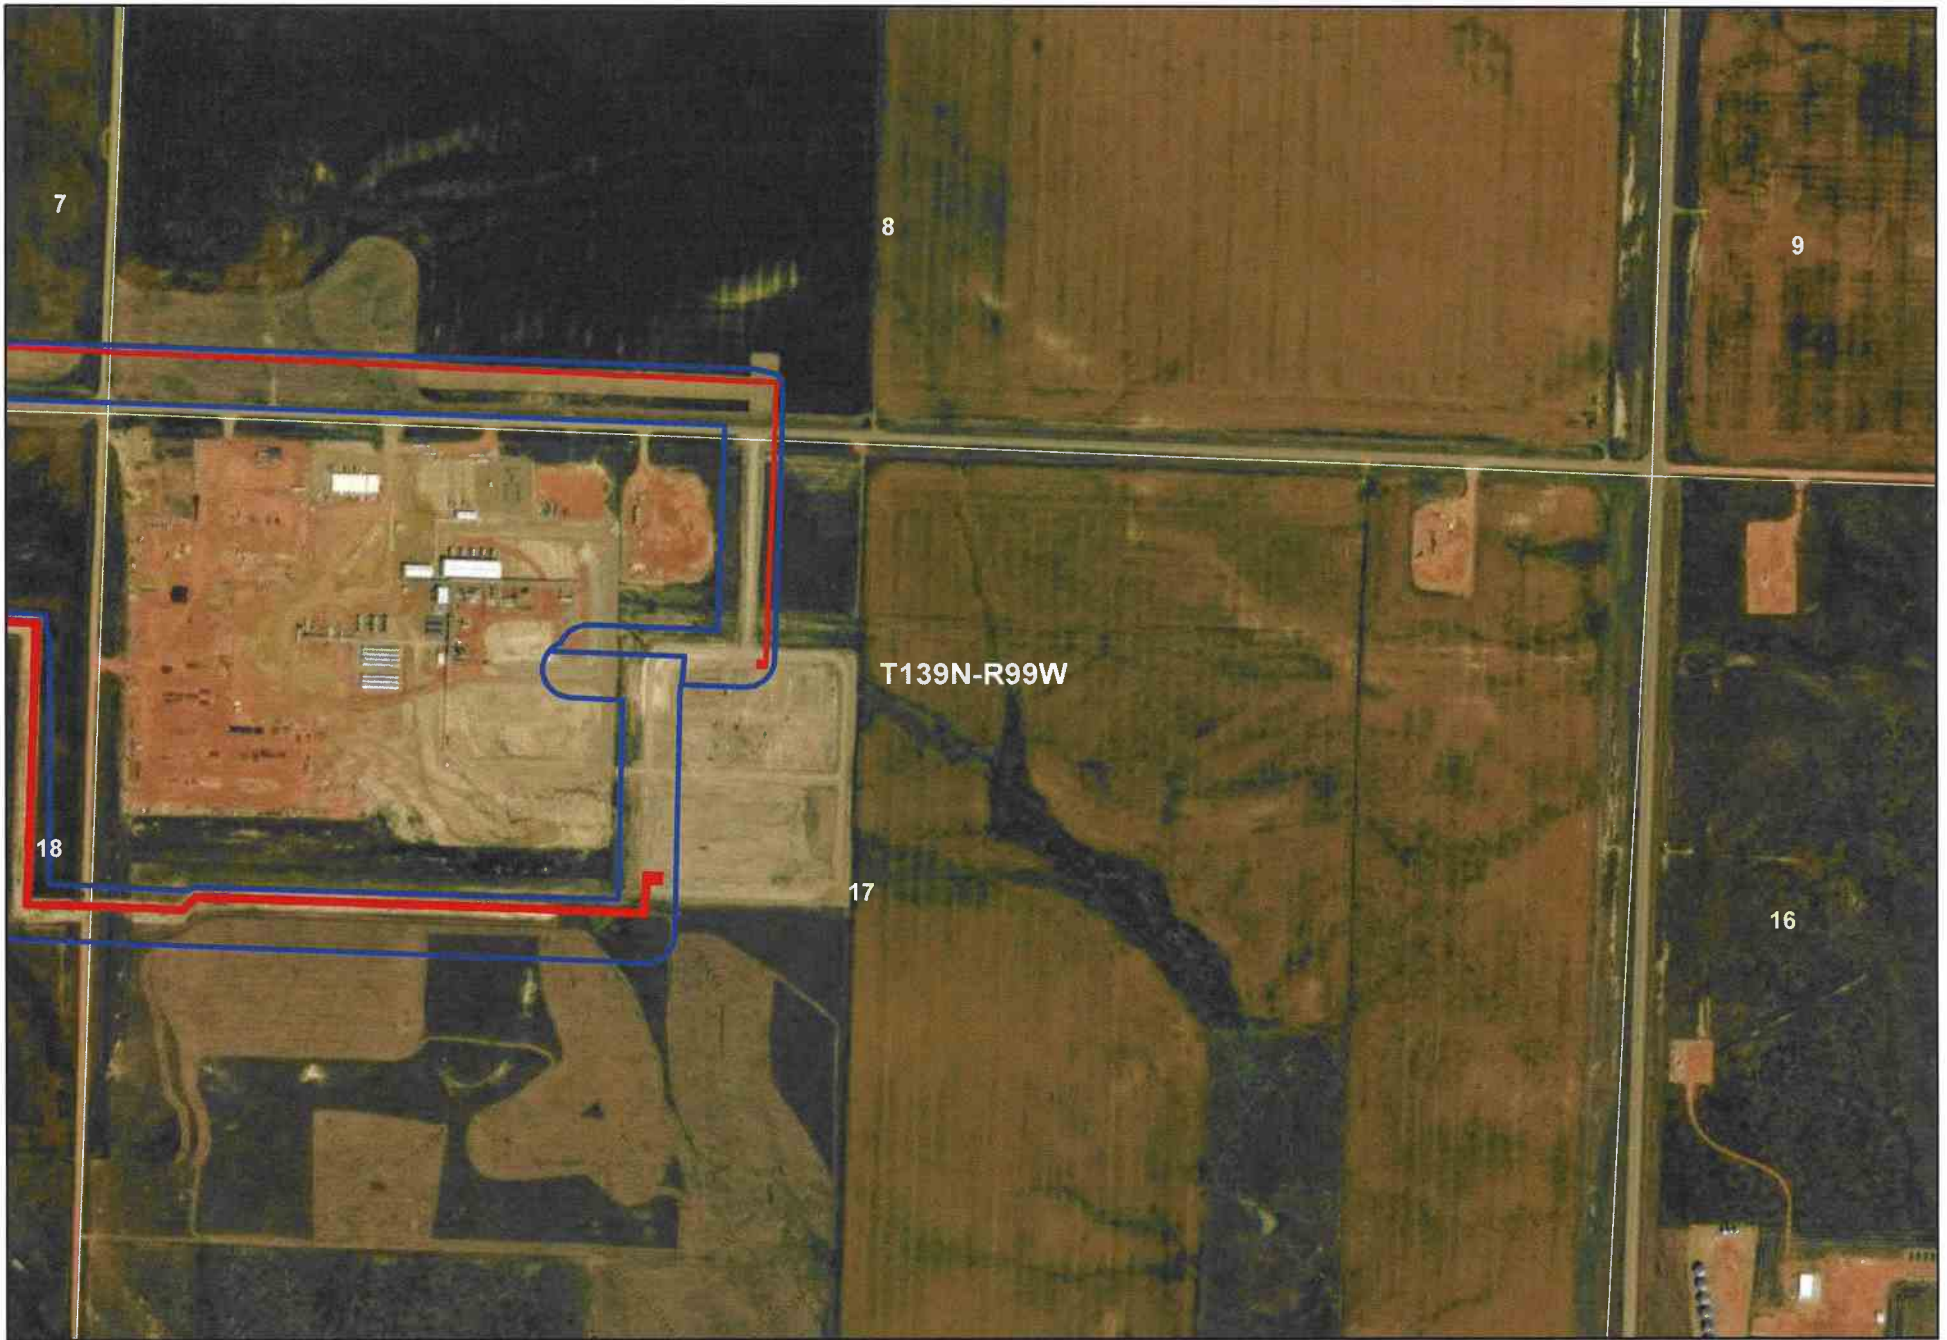

- As Built Centerline
- Areas Out of Corridor
- PSC Approved Route

**Y-Grade PSC Corridor and
As Built Centerline**





- As Built Centerline
- Areas Out of Corridor
- PSC Approved Route

**Y-Grade PSC Corridor and
As Built Centerline**





- As Built Centerline
- Areas Out of Corridor
- PSC Approved Route

**Y-Grade PSC Corridor and
As Built Centerline**





- As Built Centerline
- Areas Out of Cooridor
- PSC Approved Route


**Y-Grade PSC Corridor and
As Built Centerline**






- As Built Centerline
- Areas Out of Corridor
- PSC Approved Route

**Y-Grade PSC Corridor and
As Built Centerline**

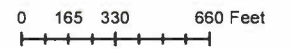

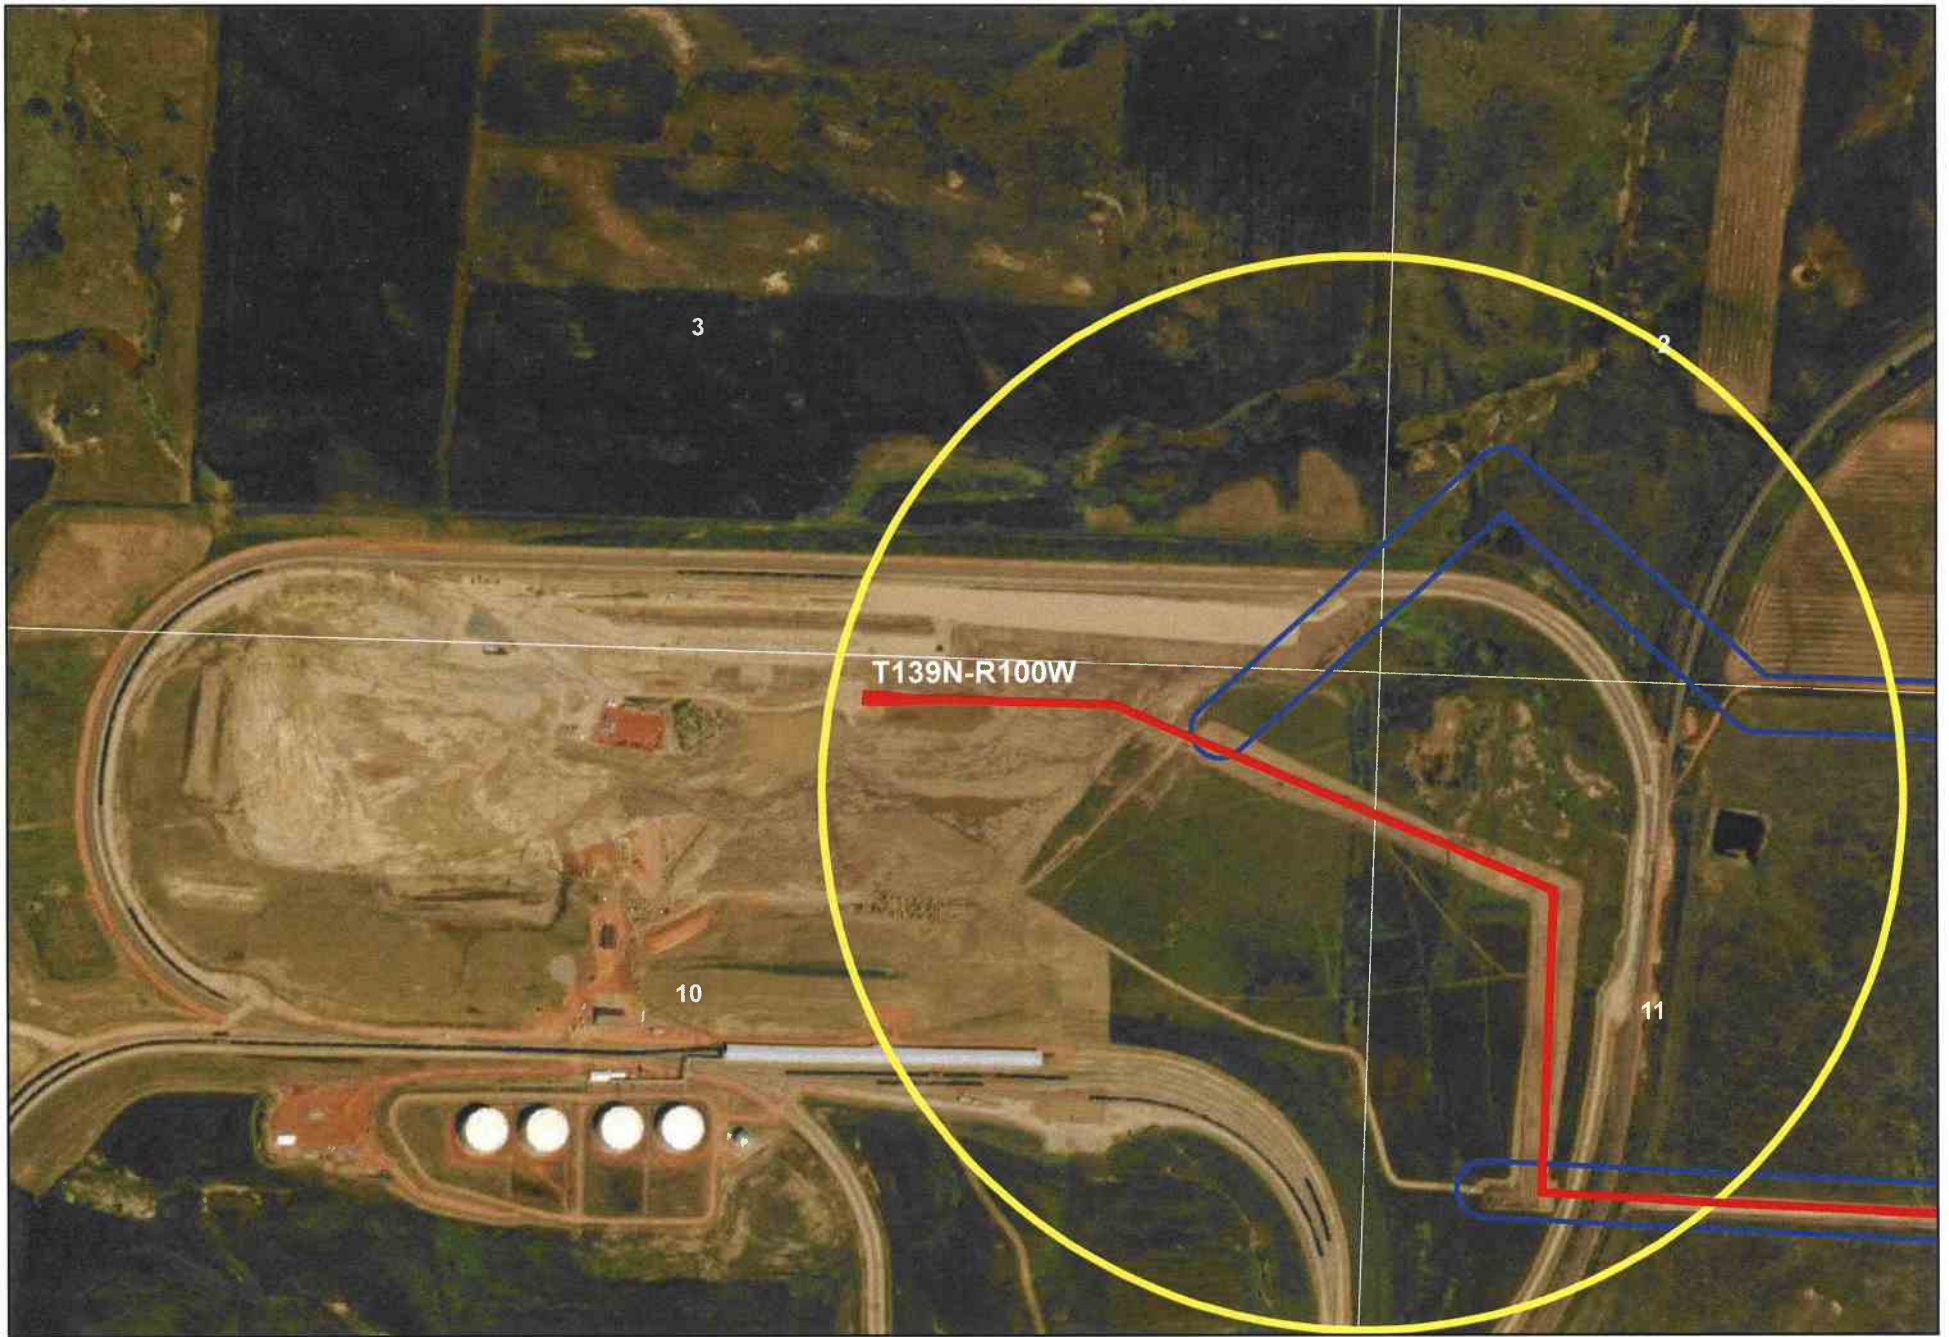

- As Built Centerline
- Areas Out of Corridor
- PSC Approved Route

**Y-Grade PSC Corridor and
As Built Centerline**

