

- Milepost
- As-Built Centerline
- Project Corridor

**ONEOK Bakken Pipeline, L.L.C.
Demicks Lake Pipeline Project**




**As-Built Centerline and
Certificated Corridor**

Page 1 of 38

McKenzie County, ND



Date: (1/20/2020) Source: Z:\Clients\M_L\Oneok\Demicks_Lake_Pipeline\Permitting\PSC\20200120_As_Built\DLF_PSC_As_Built_Centerline_Maps.mxd

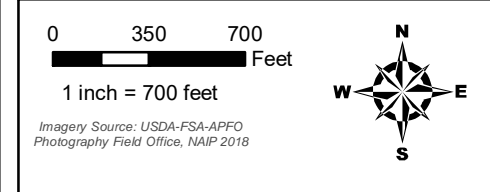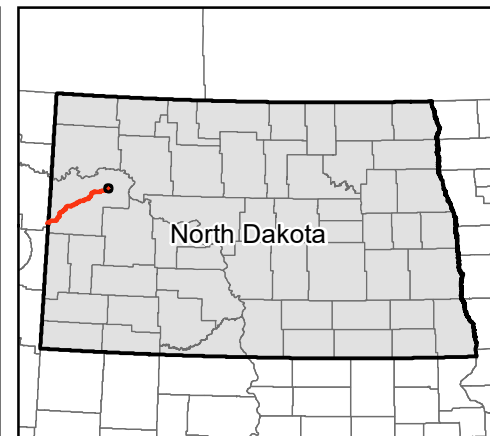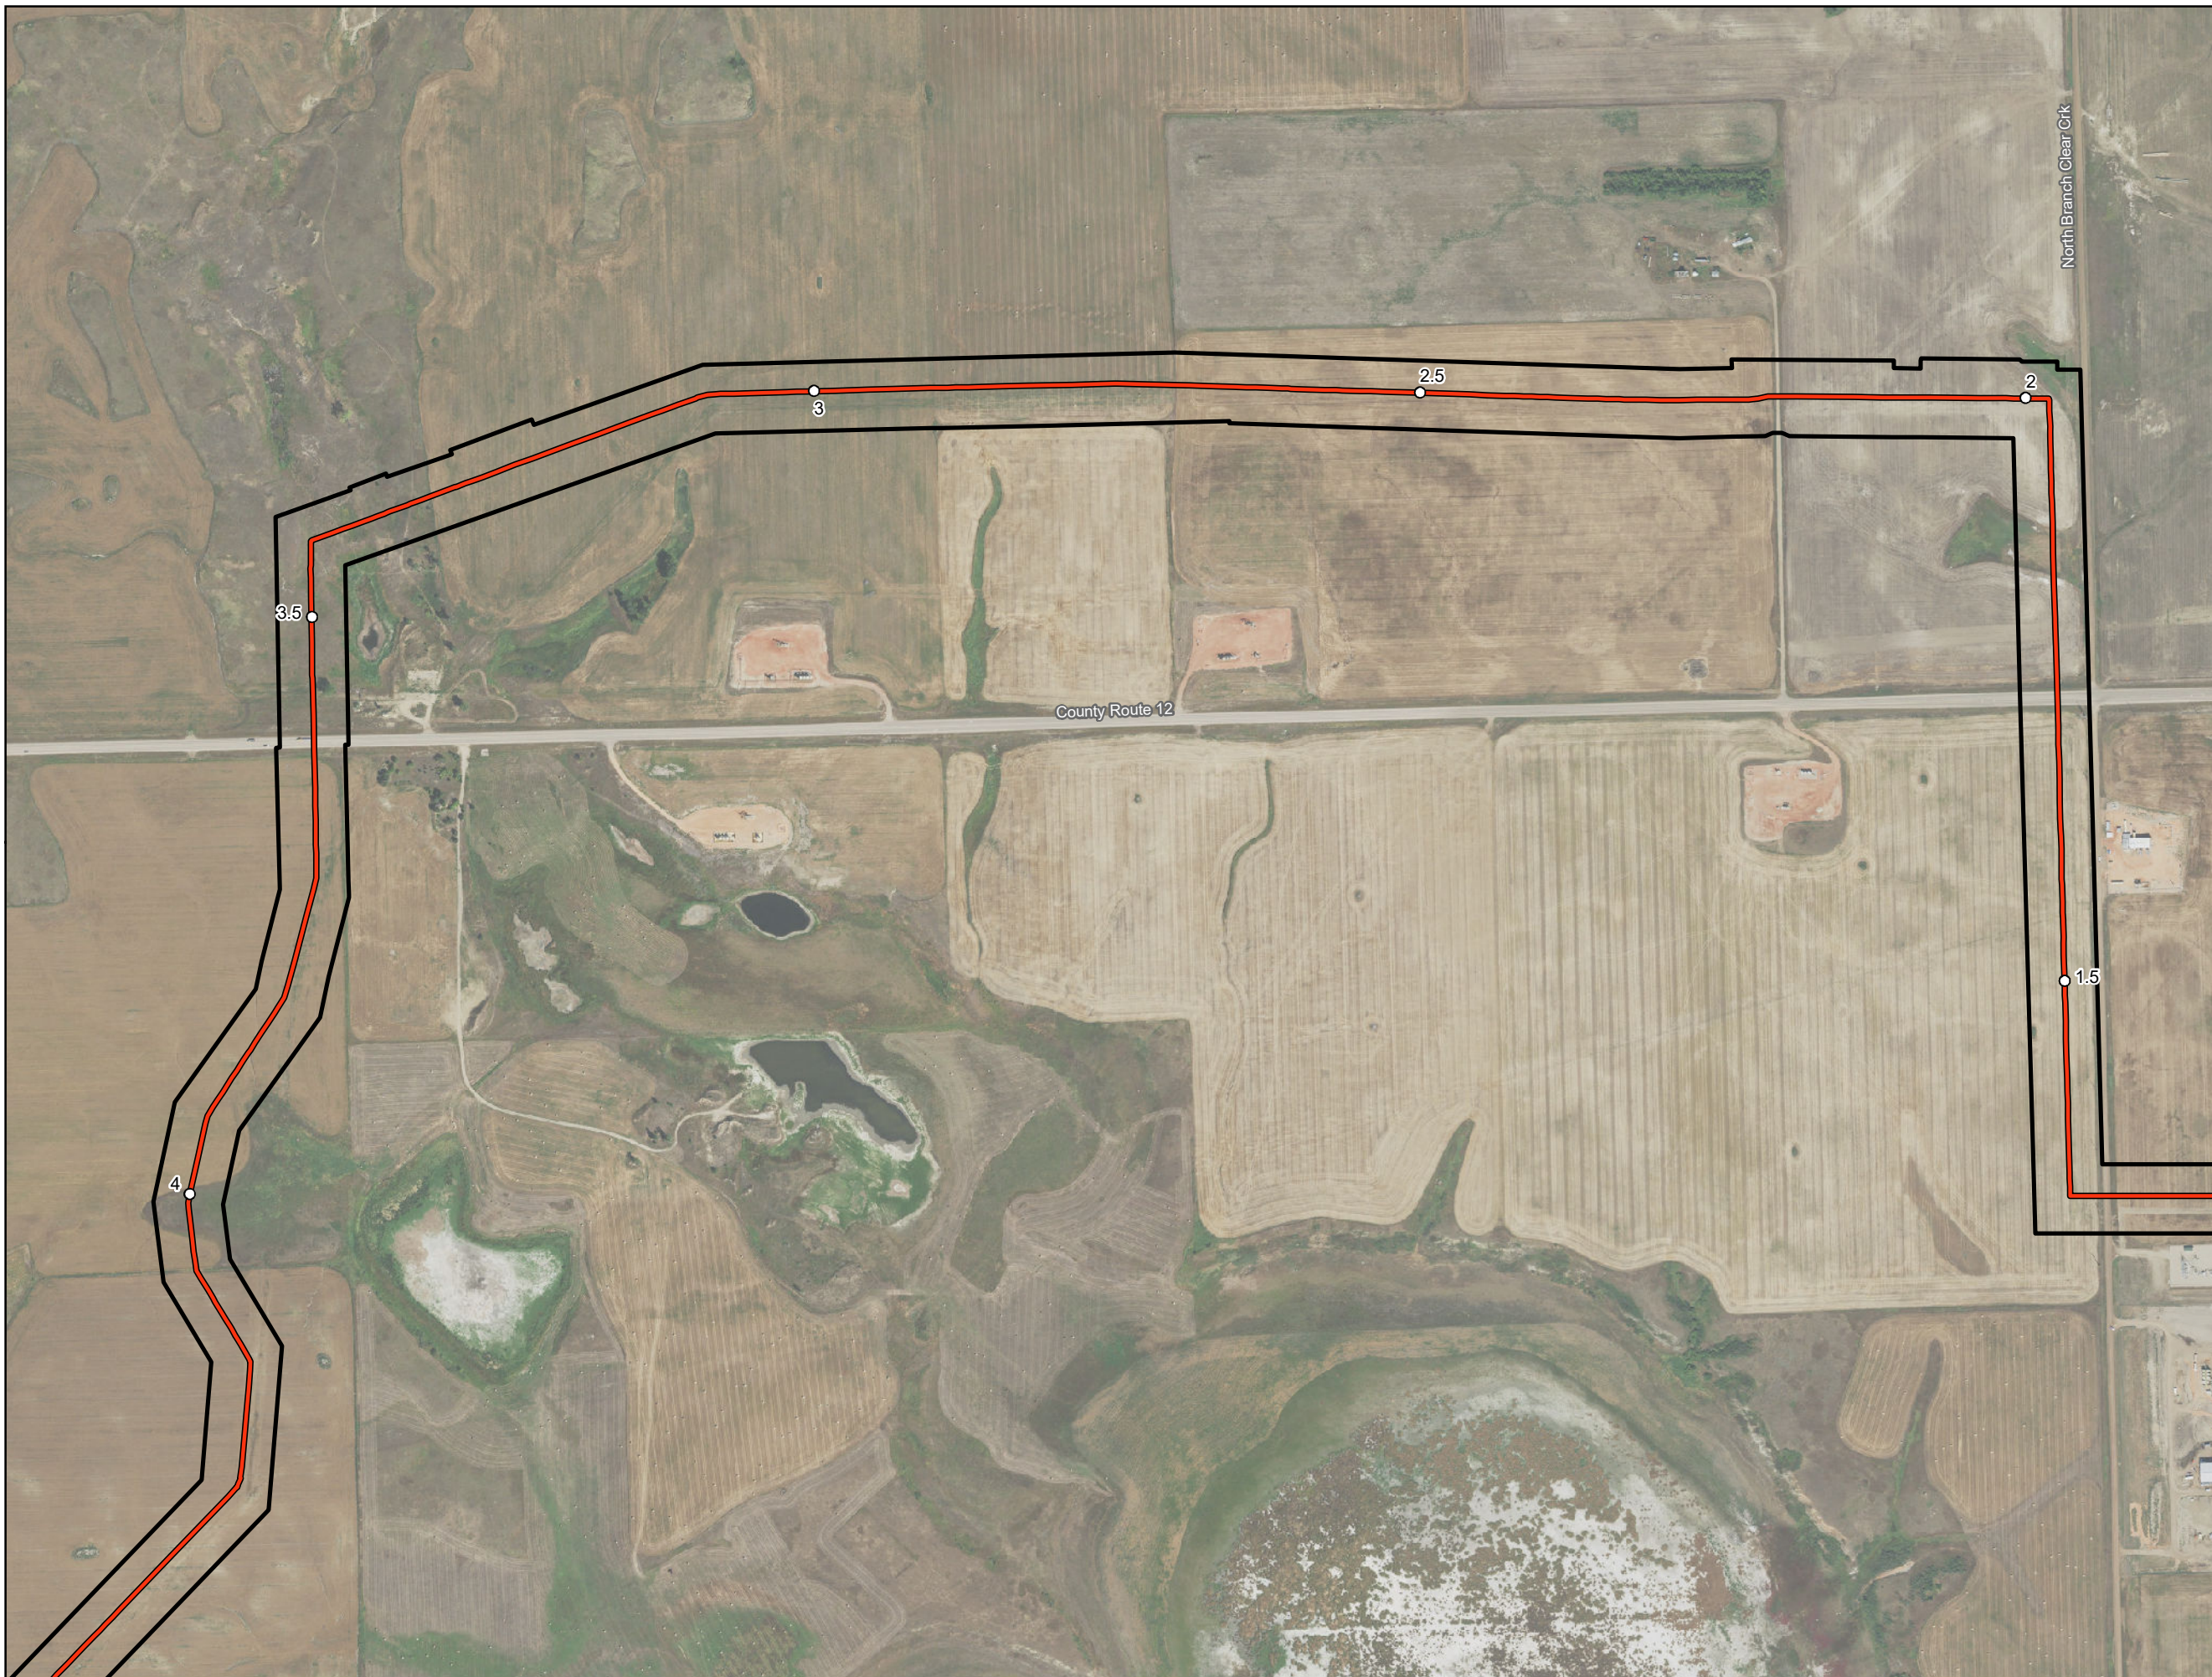

Imagery Source: USDA-FSA-APFO
Photography Field Office, NAIP 2018

- Milepost
- As-Built Centerline
- Project Corridor

**ONEOK Bakken Pipeline, L.L.C.
Demicks Lake Pipeline Project**





**As-Built Centerline and
Certificated Corridor**

Page 2 of 38

McKenzie County, ND



Date: (1/20/2020) Source: Z:\Clients\M_L_P\Oneok\Demicks_Lake_Pipeline\Permitting\FSC\20200120_As_Built\DLF_PSC_As_Built_Centerline_Maps.mxd

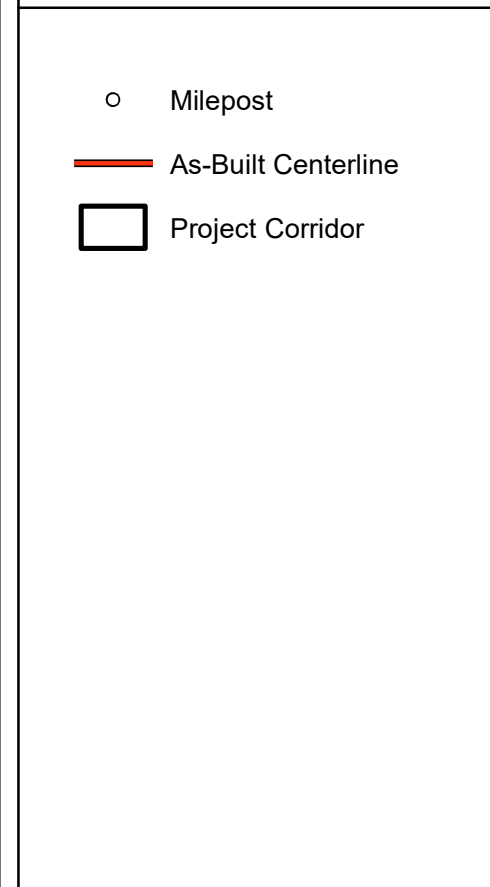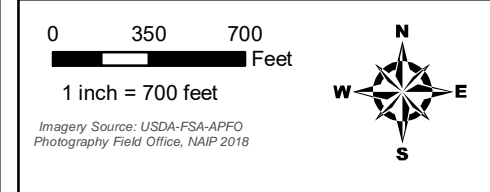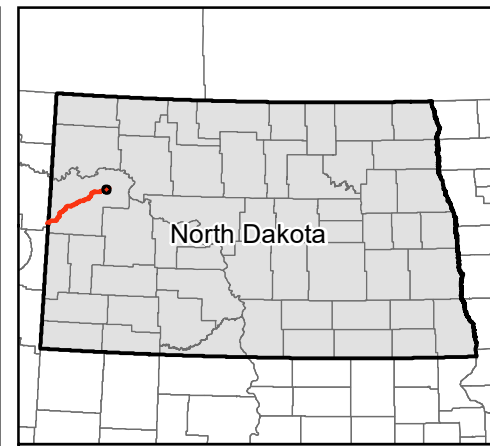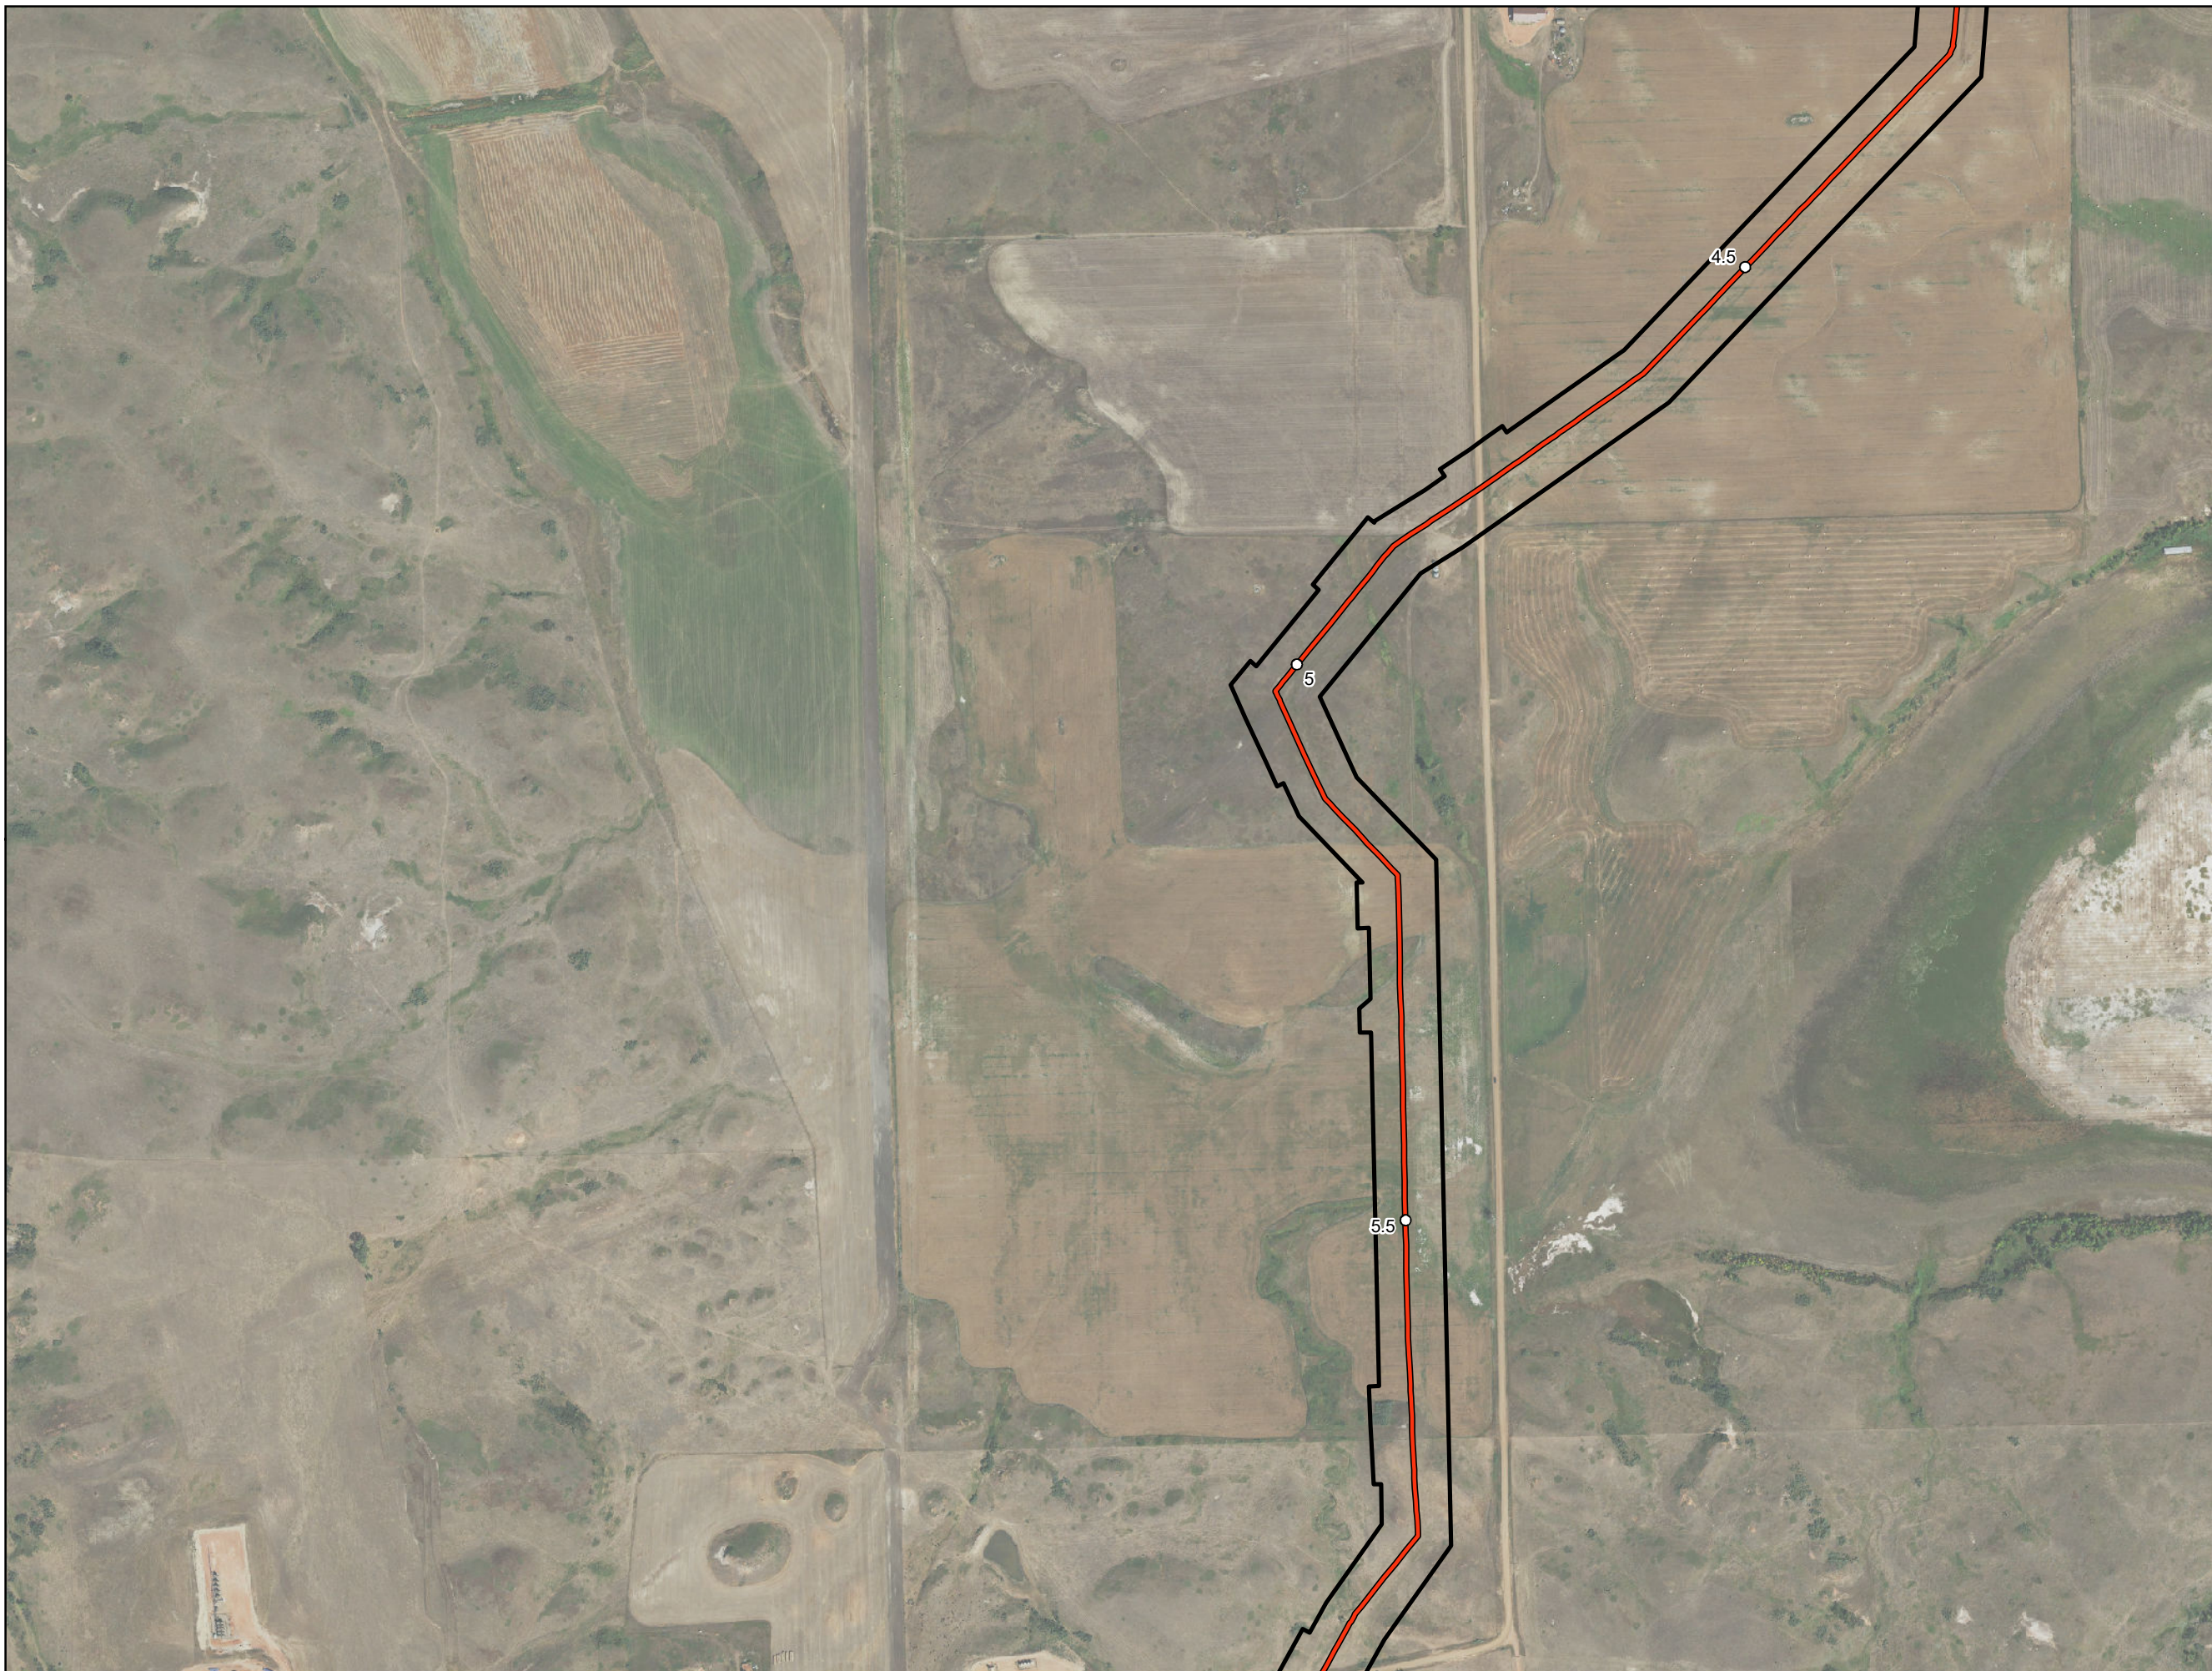




**ONEOK Bakken Pipeline, L.L.C.
Demicks Lake Pipeline Project**

**As-Built Centerline and
Certificated Corridor**

Page 3 of 38
McKenzie County, ND



Date: (1/20/2020) Source: Z:\Clients\MLP\Oneok\Demicks_Lake_Pipeline\Permitting\FSC\20200120_As_Built\DLF_PSC_As_Built_Centerline_Maps.mxd

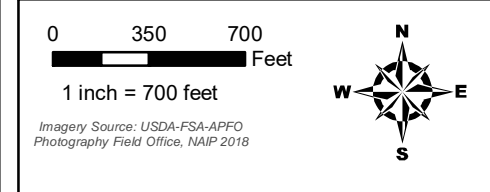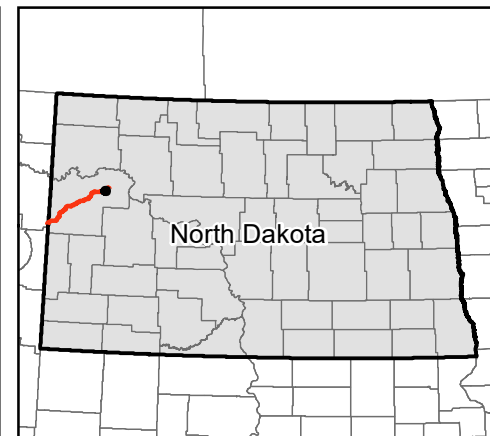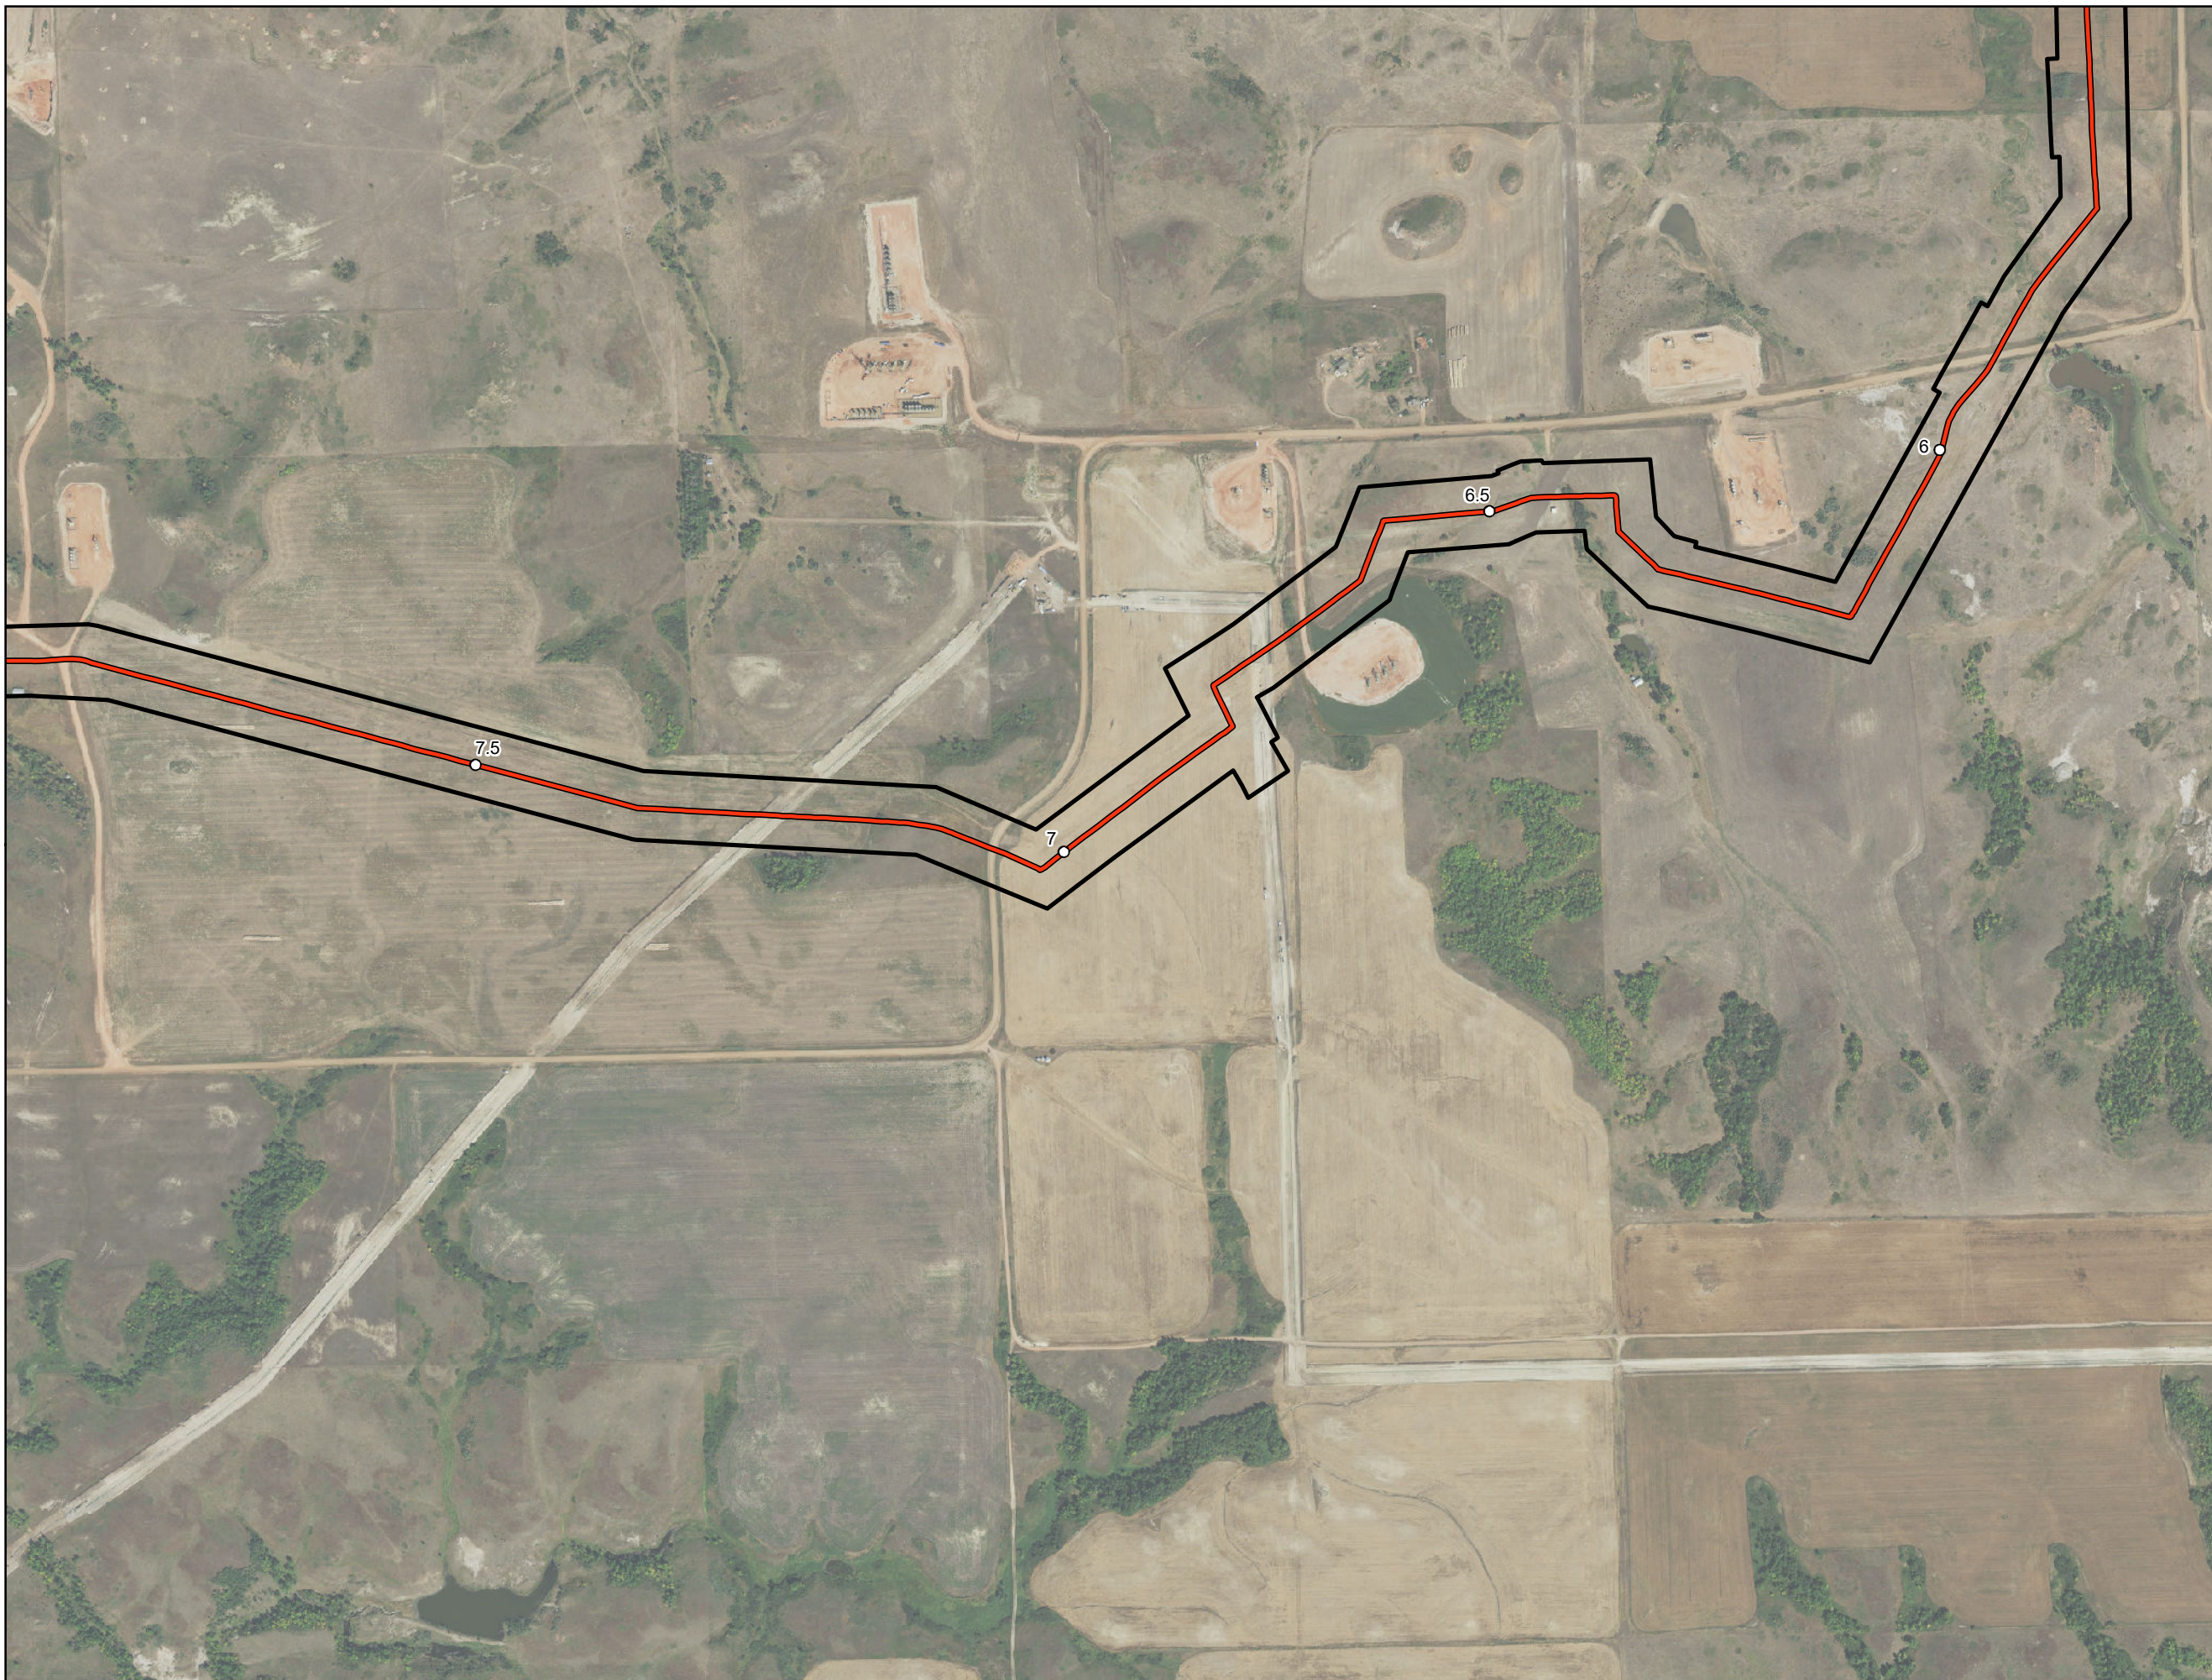

- Milepost
- As-Built Centerline
- Project Corridor

**ONEOK Bakken Pipeline, L.L.C.
Demicks Lake Pipeline Project**




**As-Built Centerline and
Certificated Corridor**

Page 4 of 38

McKenzie County, ND



Date: (1/20/2020) Source: Z:\Clients\MLP\Oneok\Demicks_Lake_Pipeline\Permitting\FSC\20200120_As_Built\DLF_PSC_As_Built_Centerline_Maps.mxd

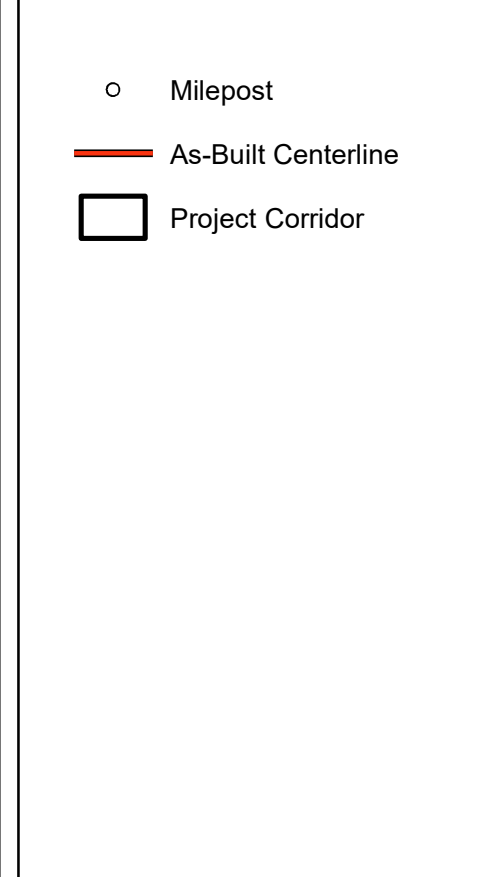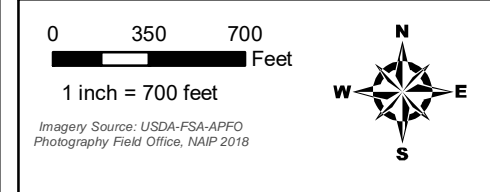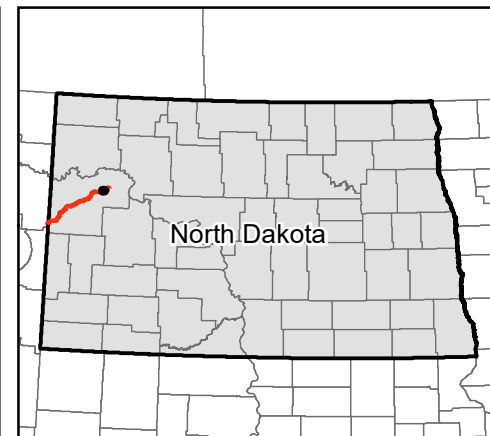

**ONEOK Bakken Pipeline, L.L.C.
Demicks Lake Pipeline Project**




**As-Built Centerline and
Certificated Corridor**

Page 5 of 38

McKenzie County, ND



Date: (1/20/2020) Source: Z:\Clients\MLP\Oneok\Demicks_Lake_Pipeline\Permitting\PSC\20200120_As_Built\DLF_PSC_As_Built_Centerline_Maps.mxd

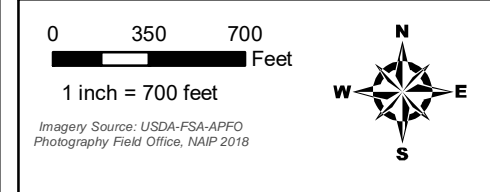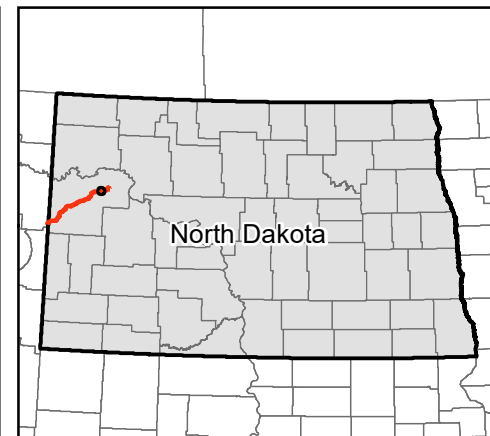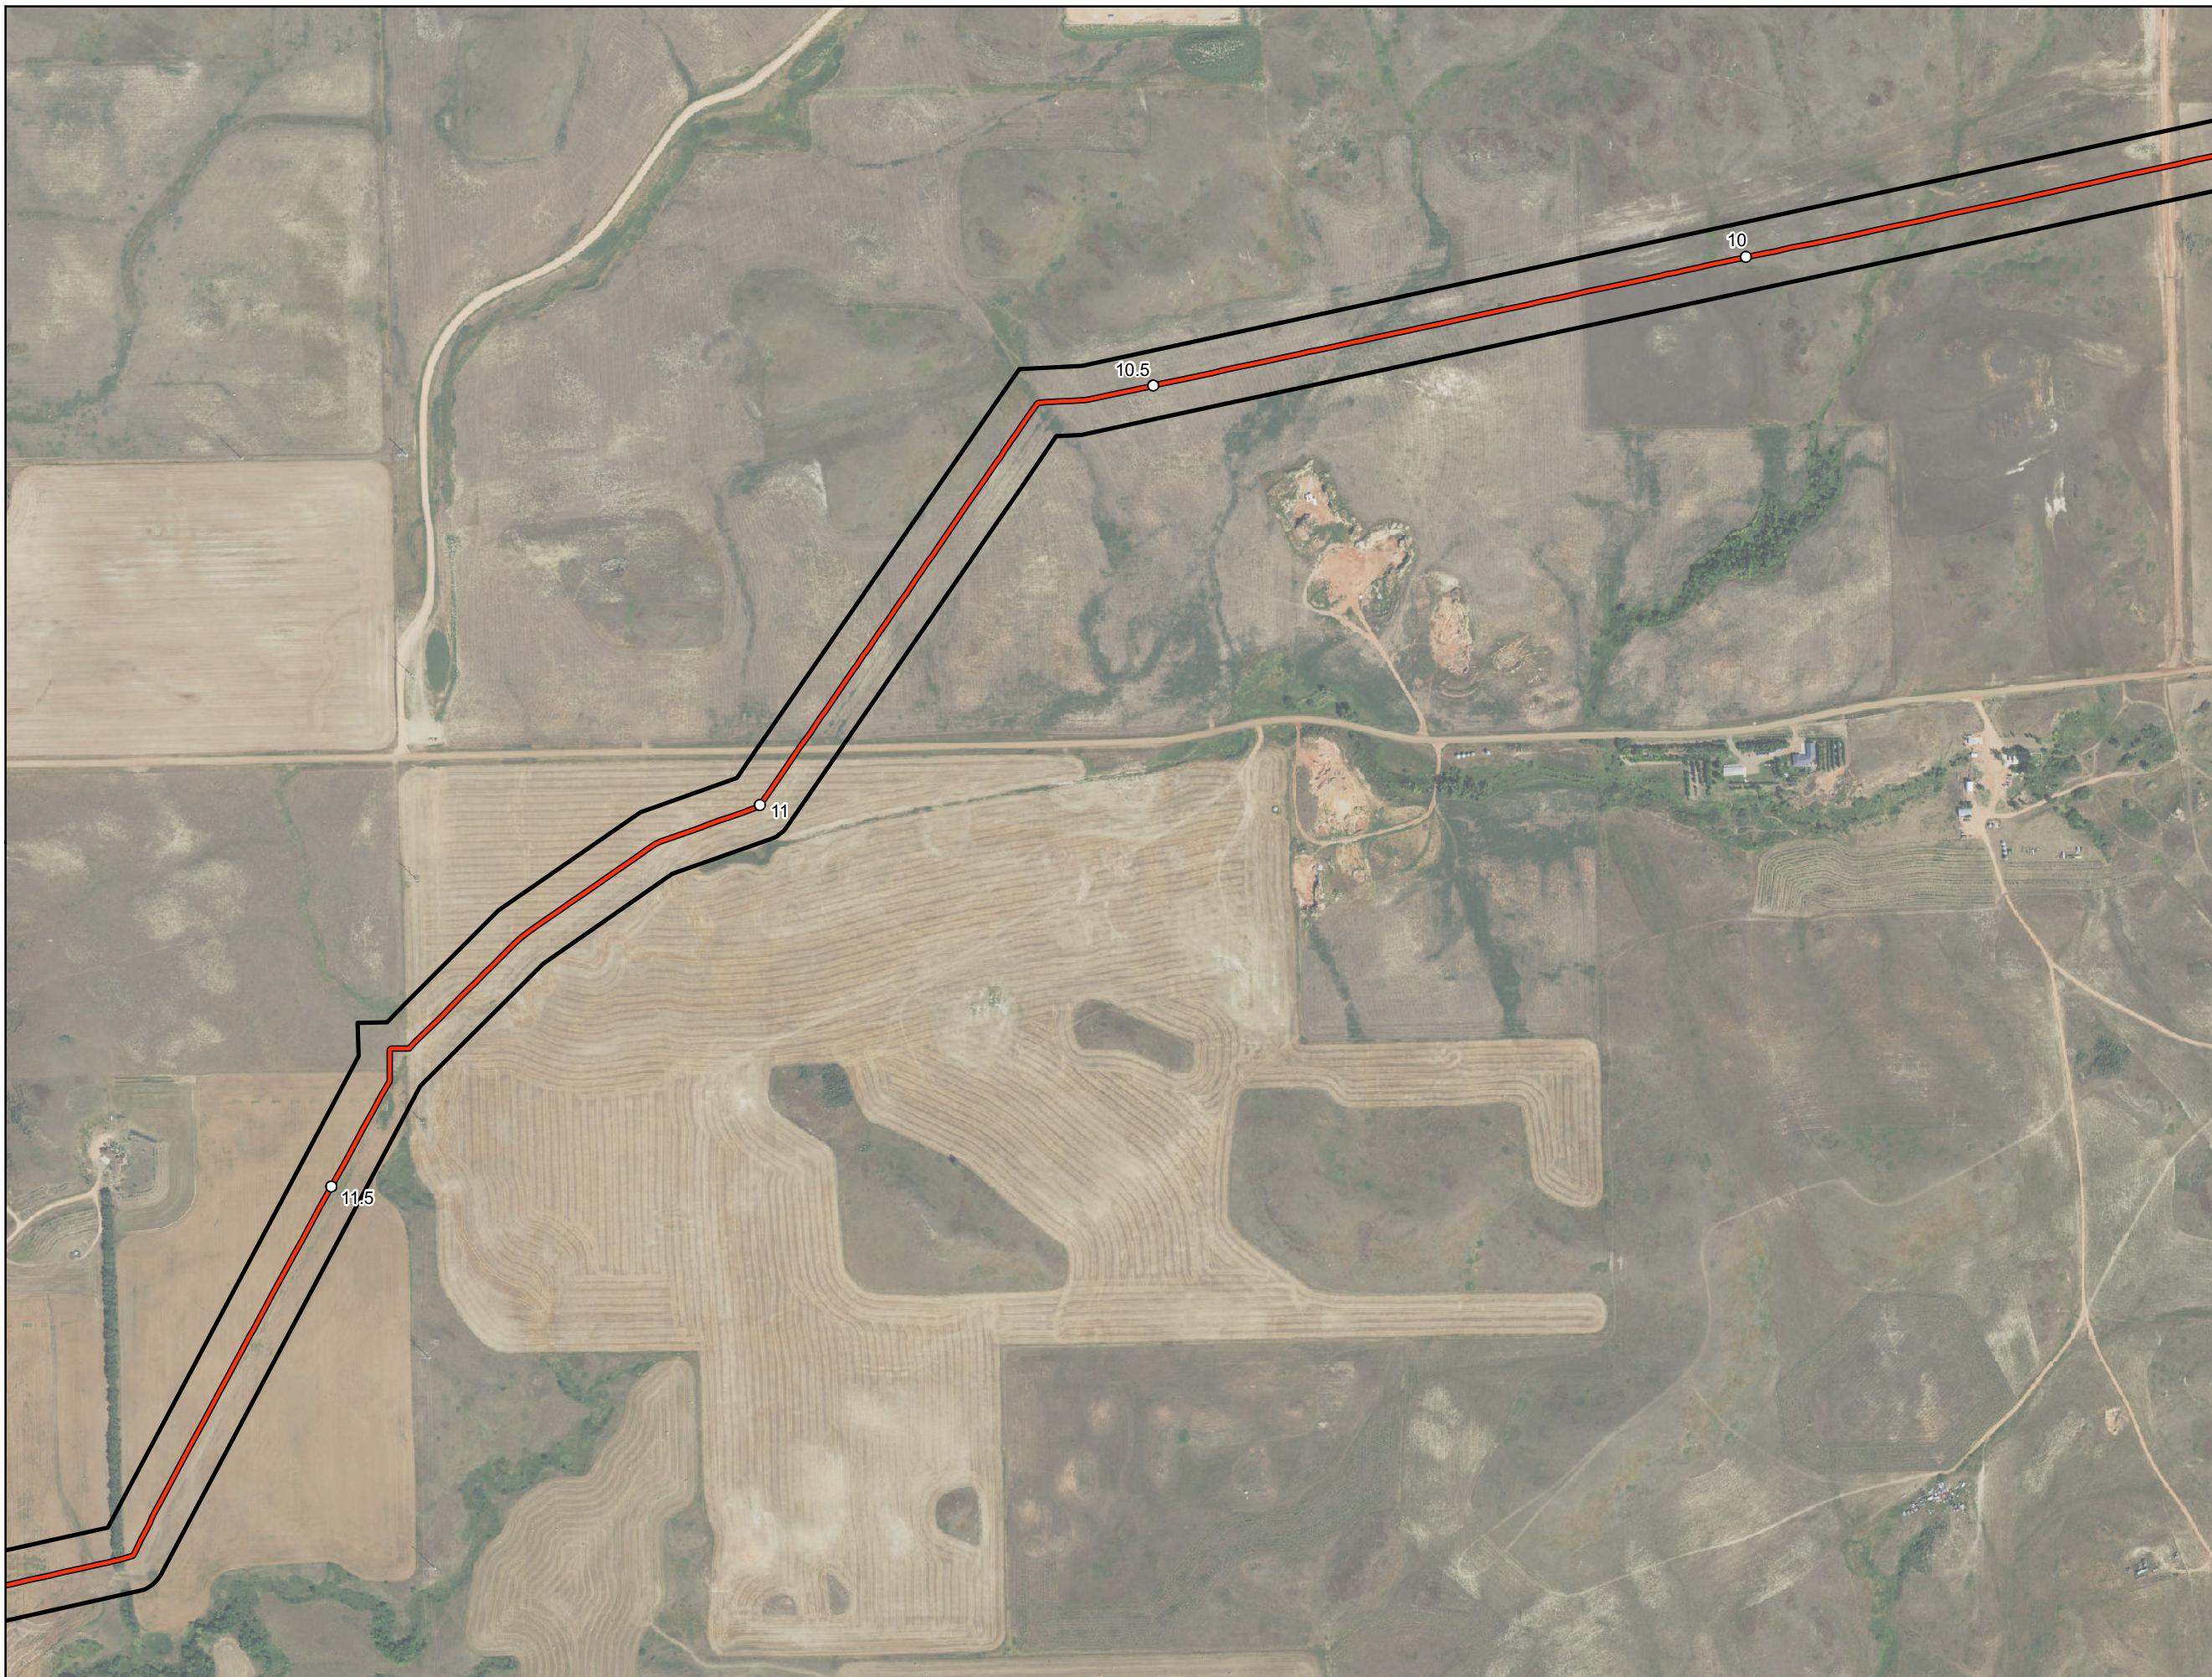

- Milepost
- As-Built Centerline
- Project Corridor

**ONEOK Bakken Pipeline, L.L.C.
Demicks Lake Pipeline Project**




**As-Built Centerline and
Certificated Corridor**

Page 6 of 38

McKenzie County, ND



Date: (1/20/2020) Source: Z:\Clients\MLP\Oneok\Demicks_Lake_Pipeline\Permitting\PSC\20200120_As_Built\DLF_PSC_As_Built_Centerline_Maps.mxd

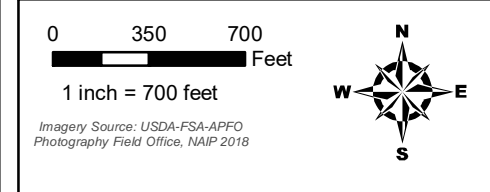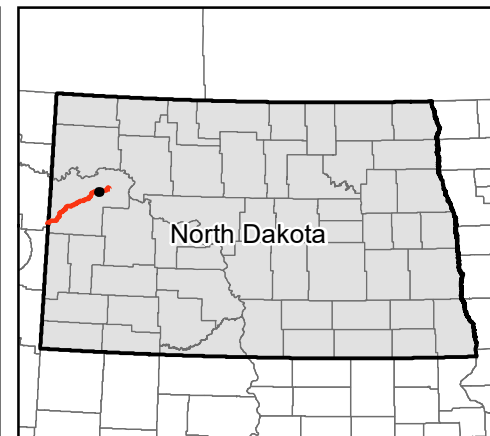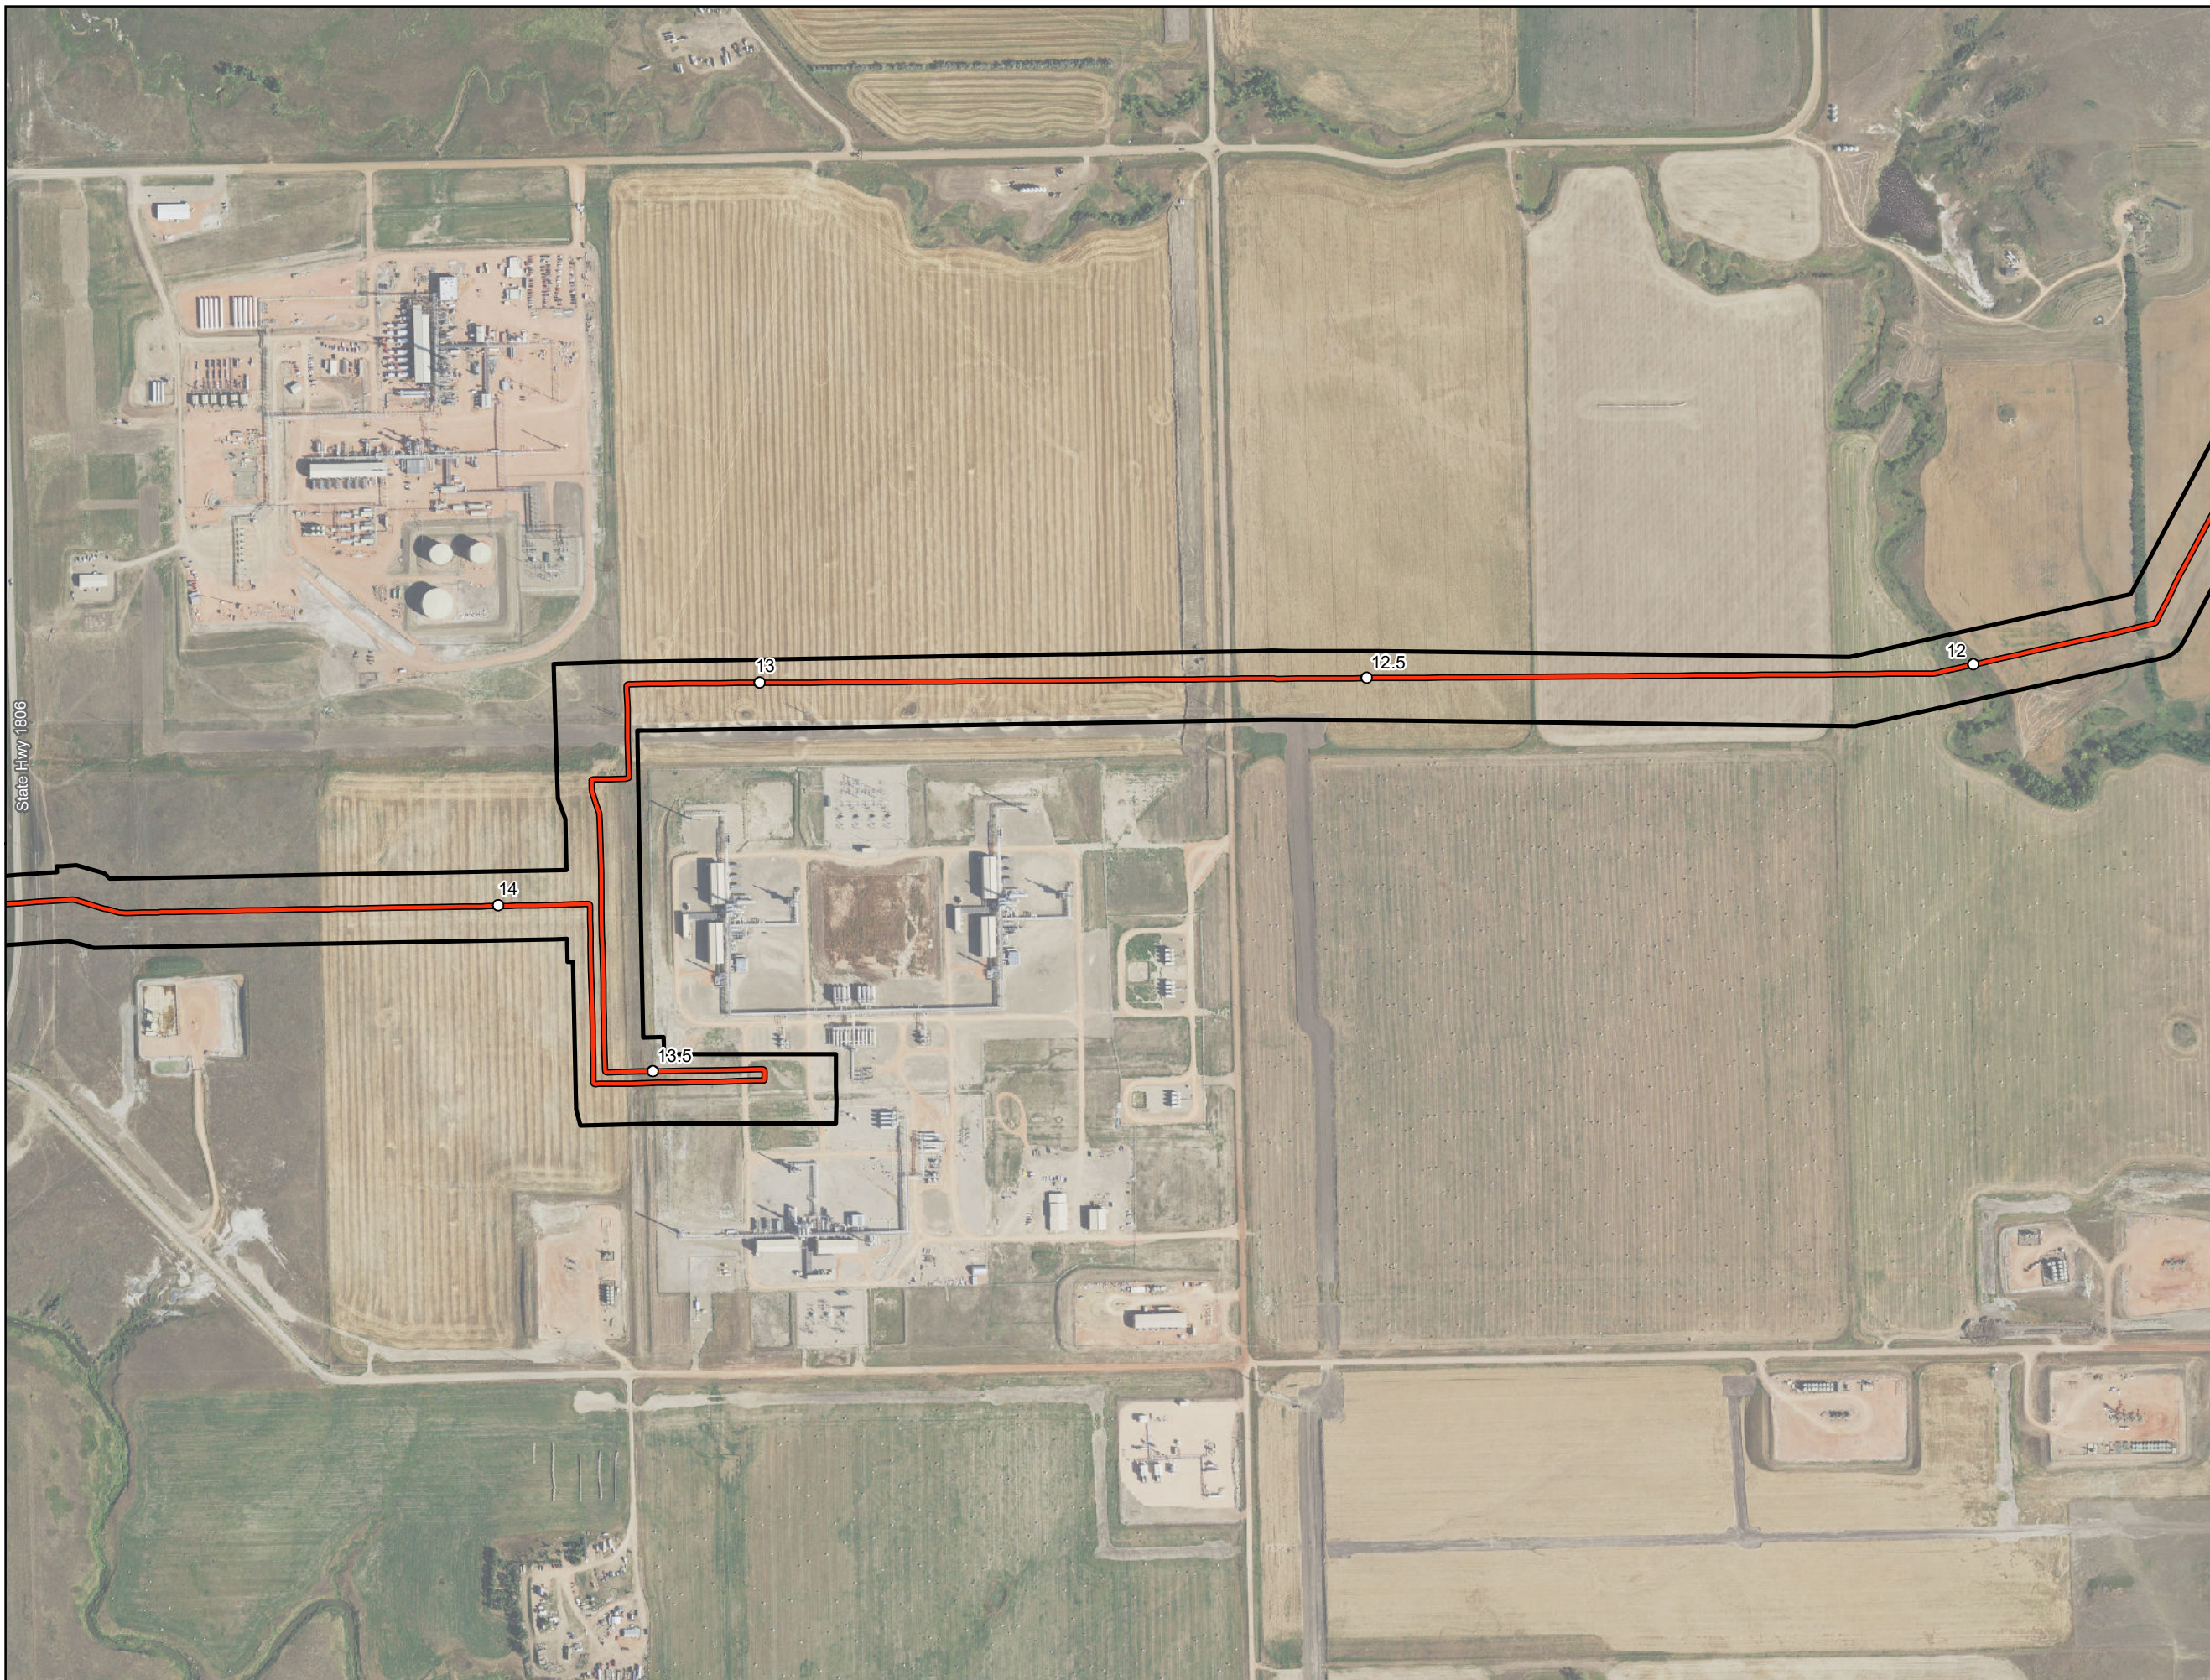

- Milepost
- As-Built Centerline
- Project Corridor

**ONEOK Bakken Pipeline, L.L.C.
Demicks Lake Pipeline Project**





**As-Built Centerline and
Certificated Corridor**

Page 7 of 38

McKenzie County, ND



Date: (1/20/2020) Source: Z:\Clients\MLP\Oneok\Demicks_Lake_Pipeline\Permitting\FSC\20200120_As_Built\DLF_PSC_As_Built_Centerline_Maps.mxd

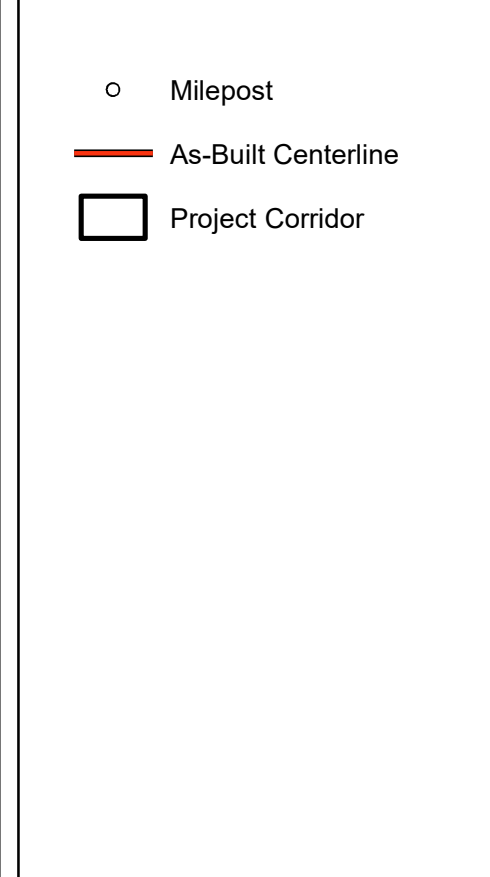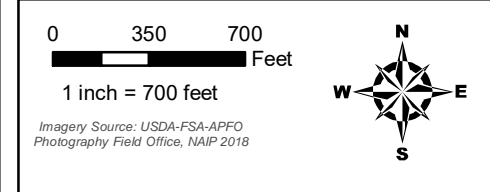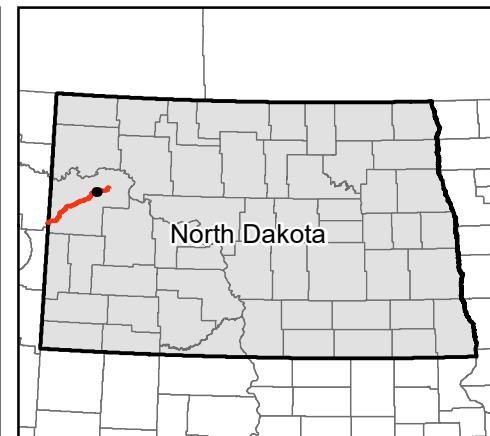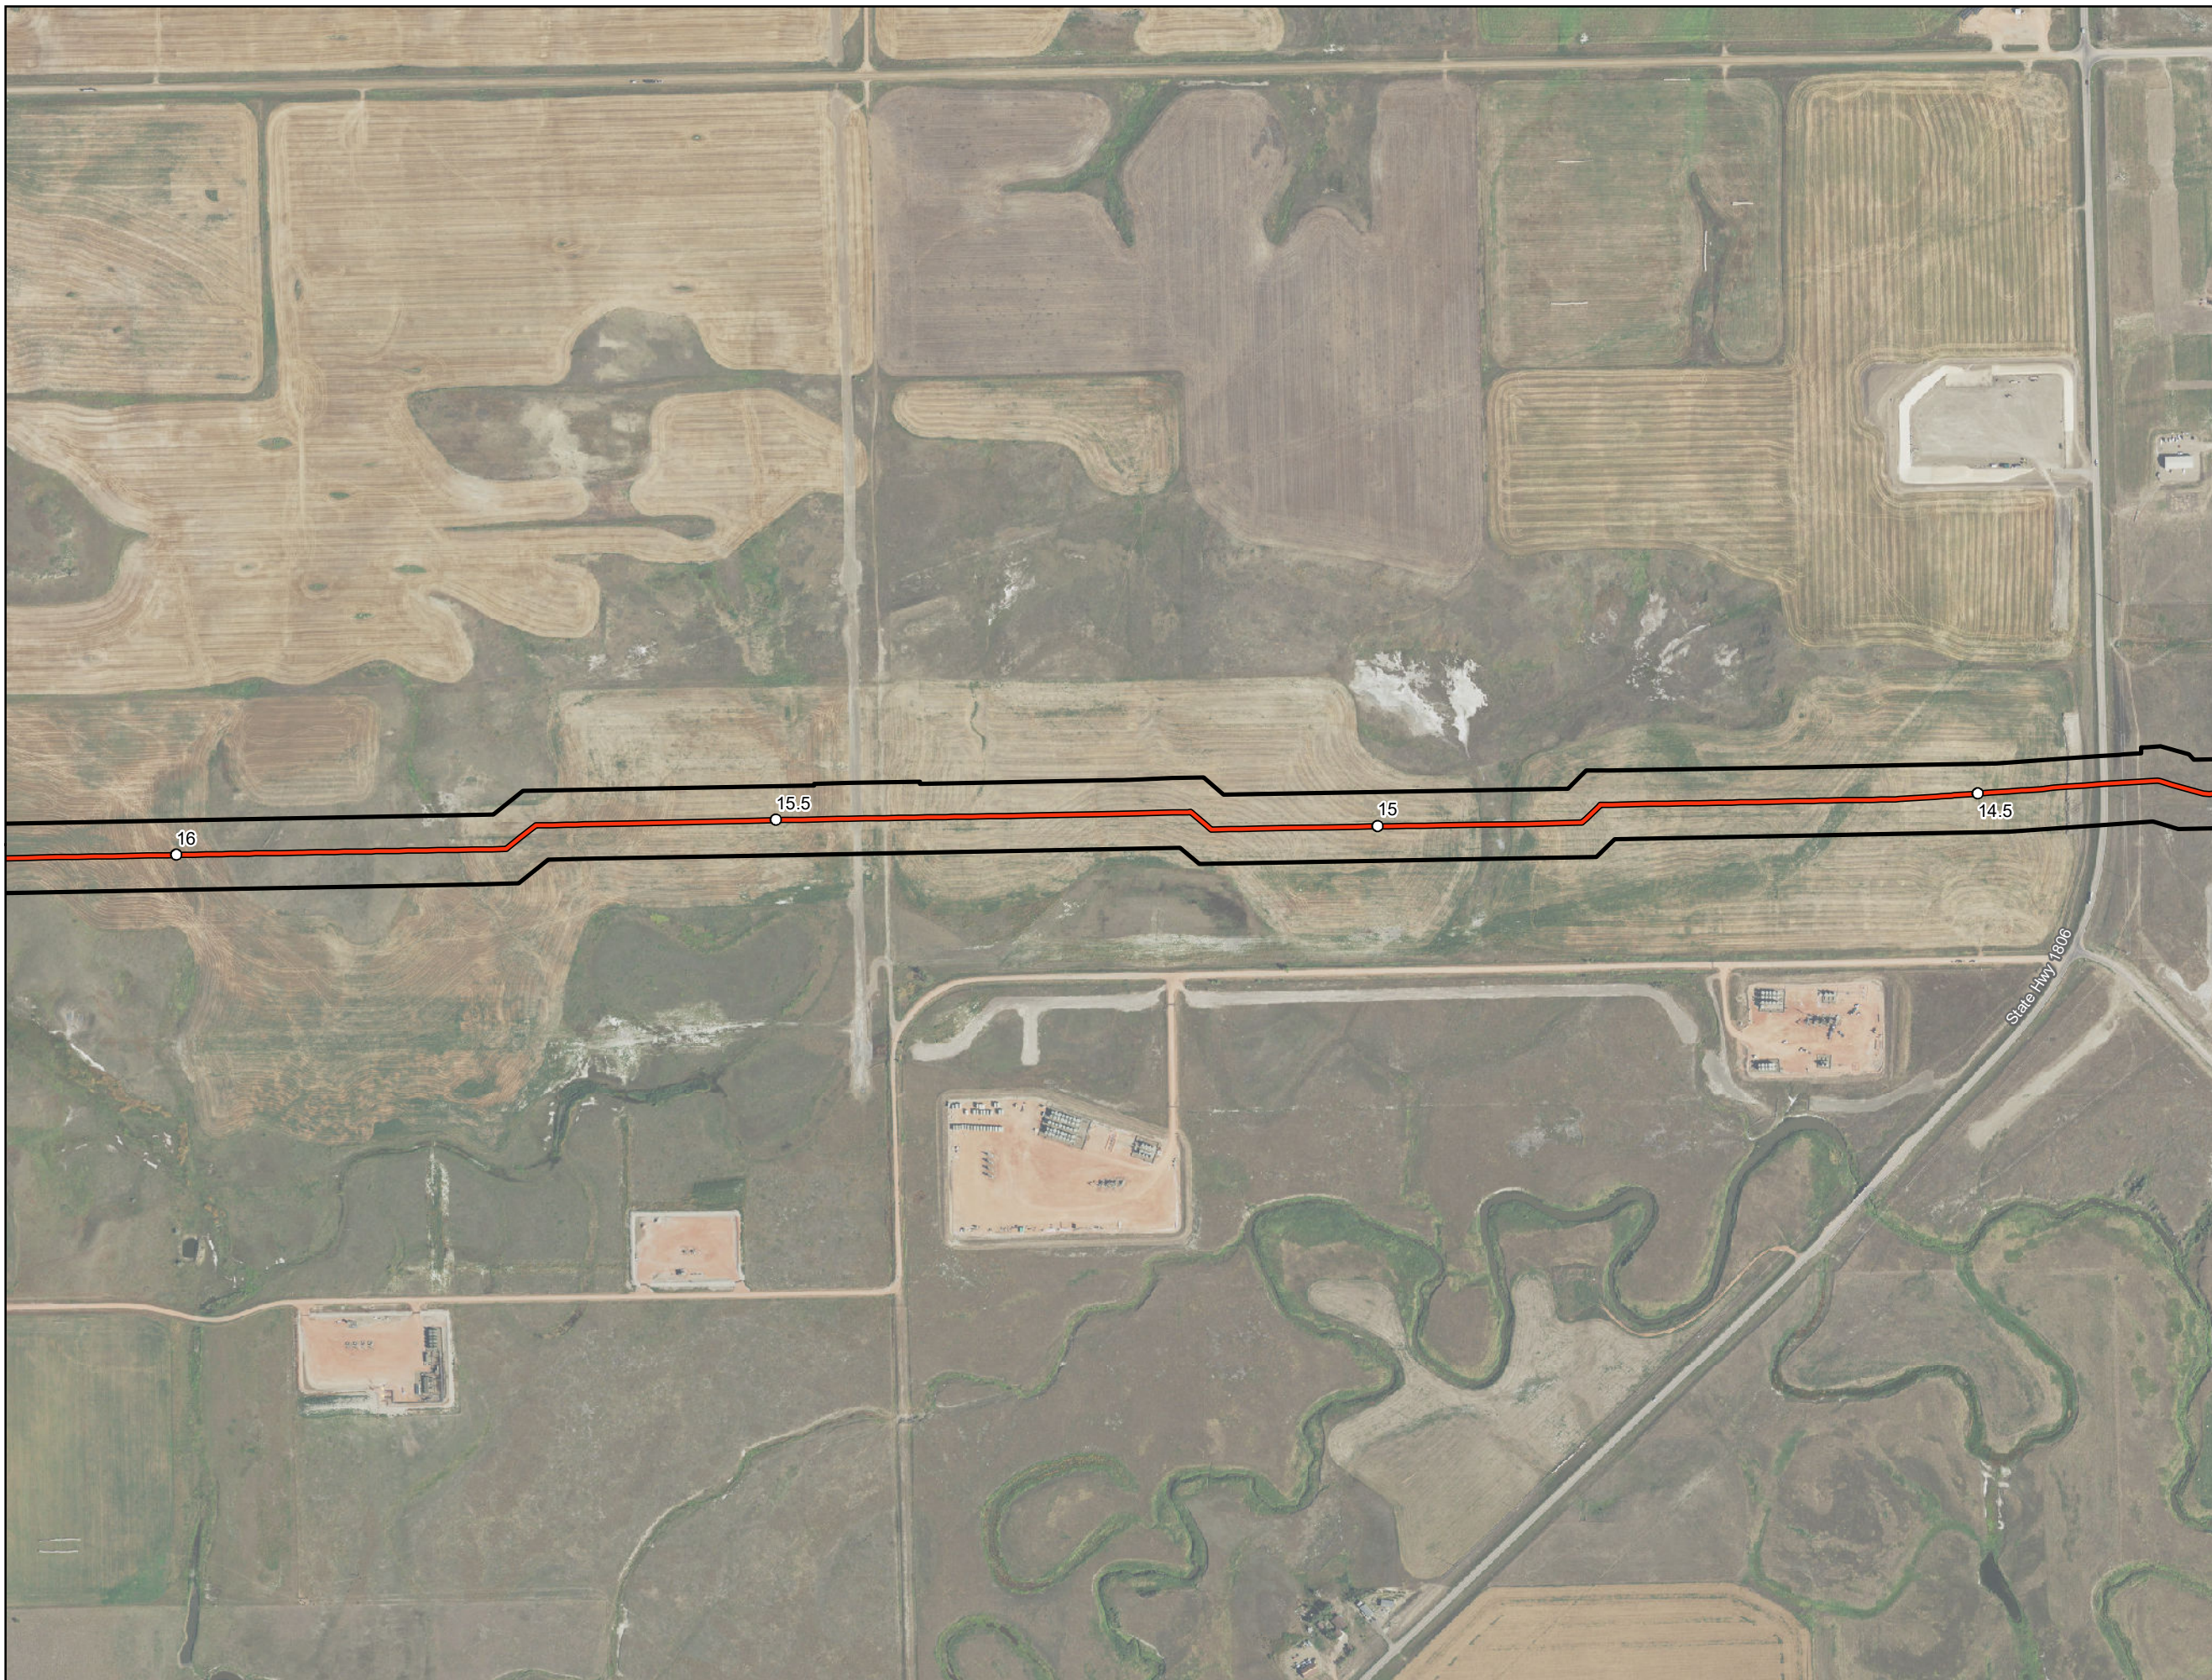

**ONEOK Bakken Pipeline, L.L.C.
Demicks Lake Pipeline Project**




**As-Built Centerline and
Certificated Corridor**

Page 8 of 38

McKenzie County, ND



Date: (1/20/2020) Source: Z:\Clients\MLP\Oneok\Demicks_Lake_Pipeline\Permitting\PSC\20200120_As_Built\DLF_PSC_As_Built_Centerline_Maps.mxd

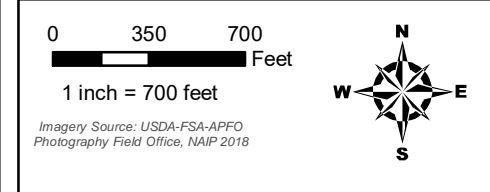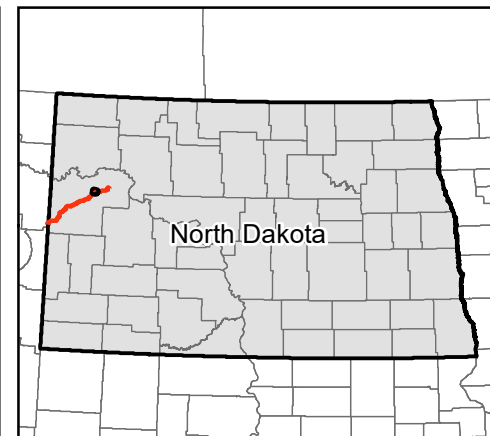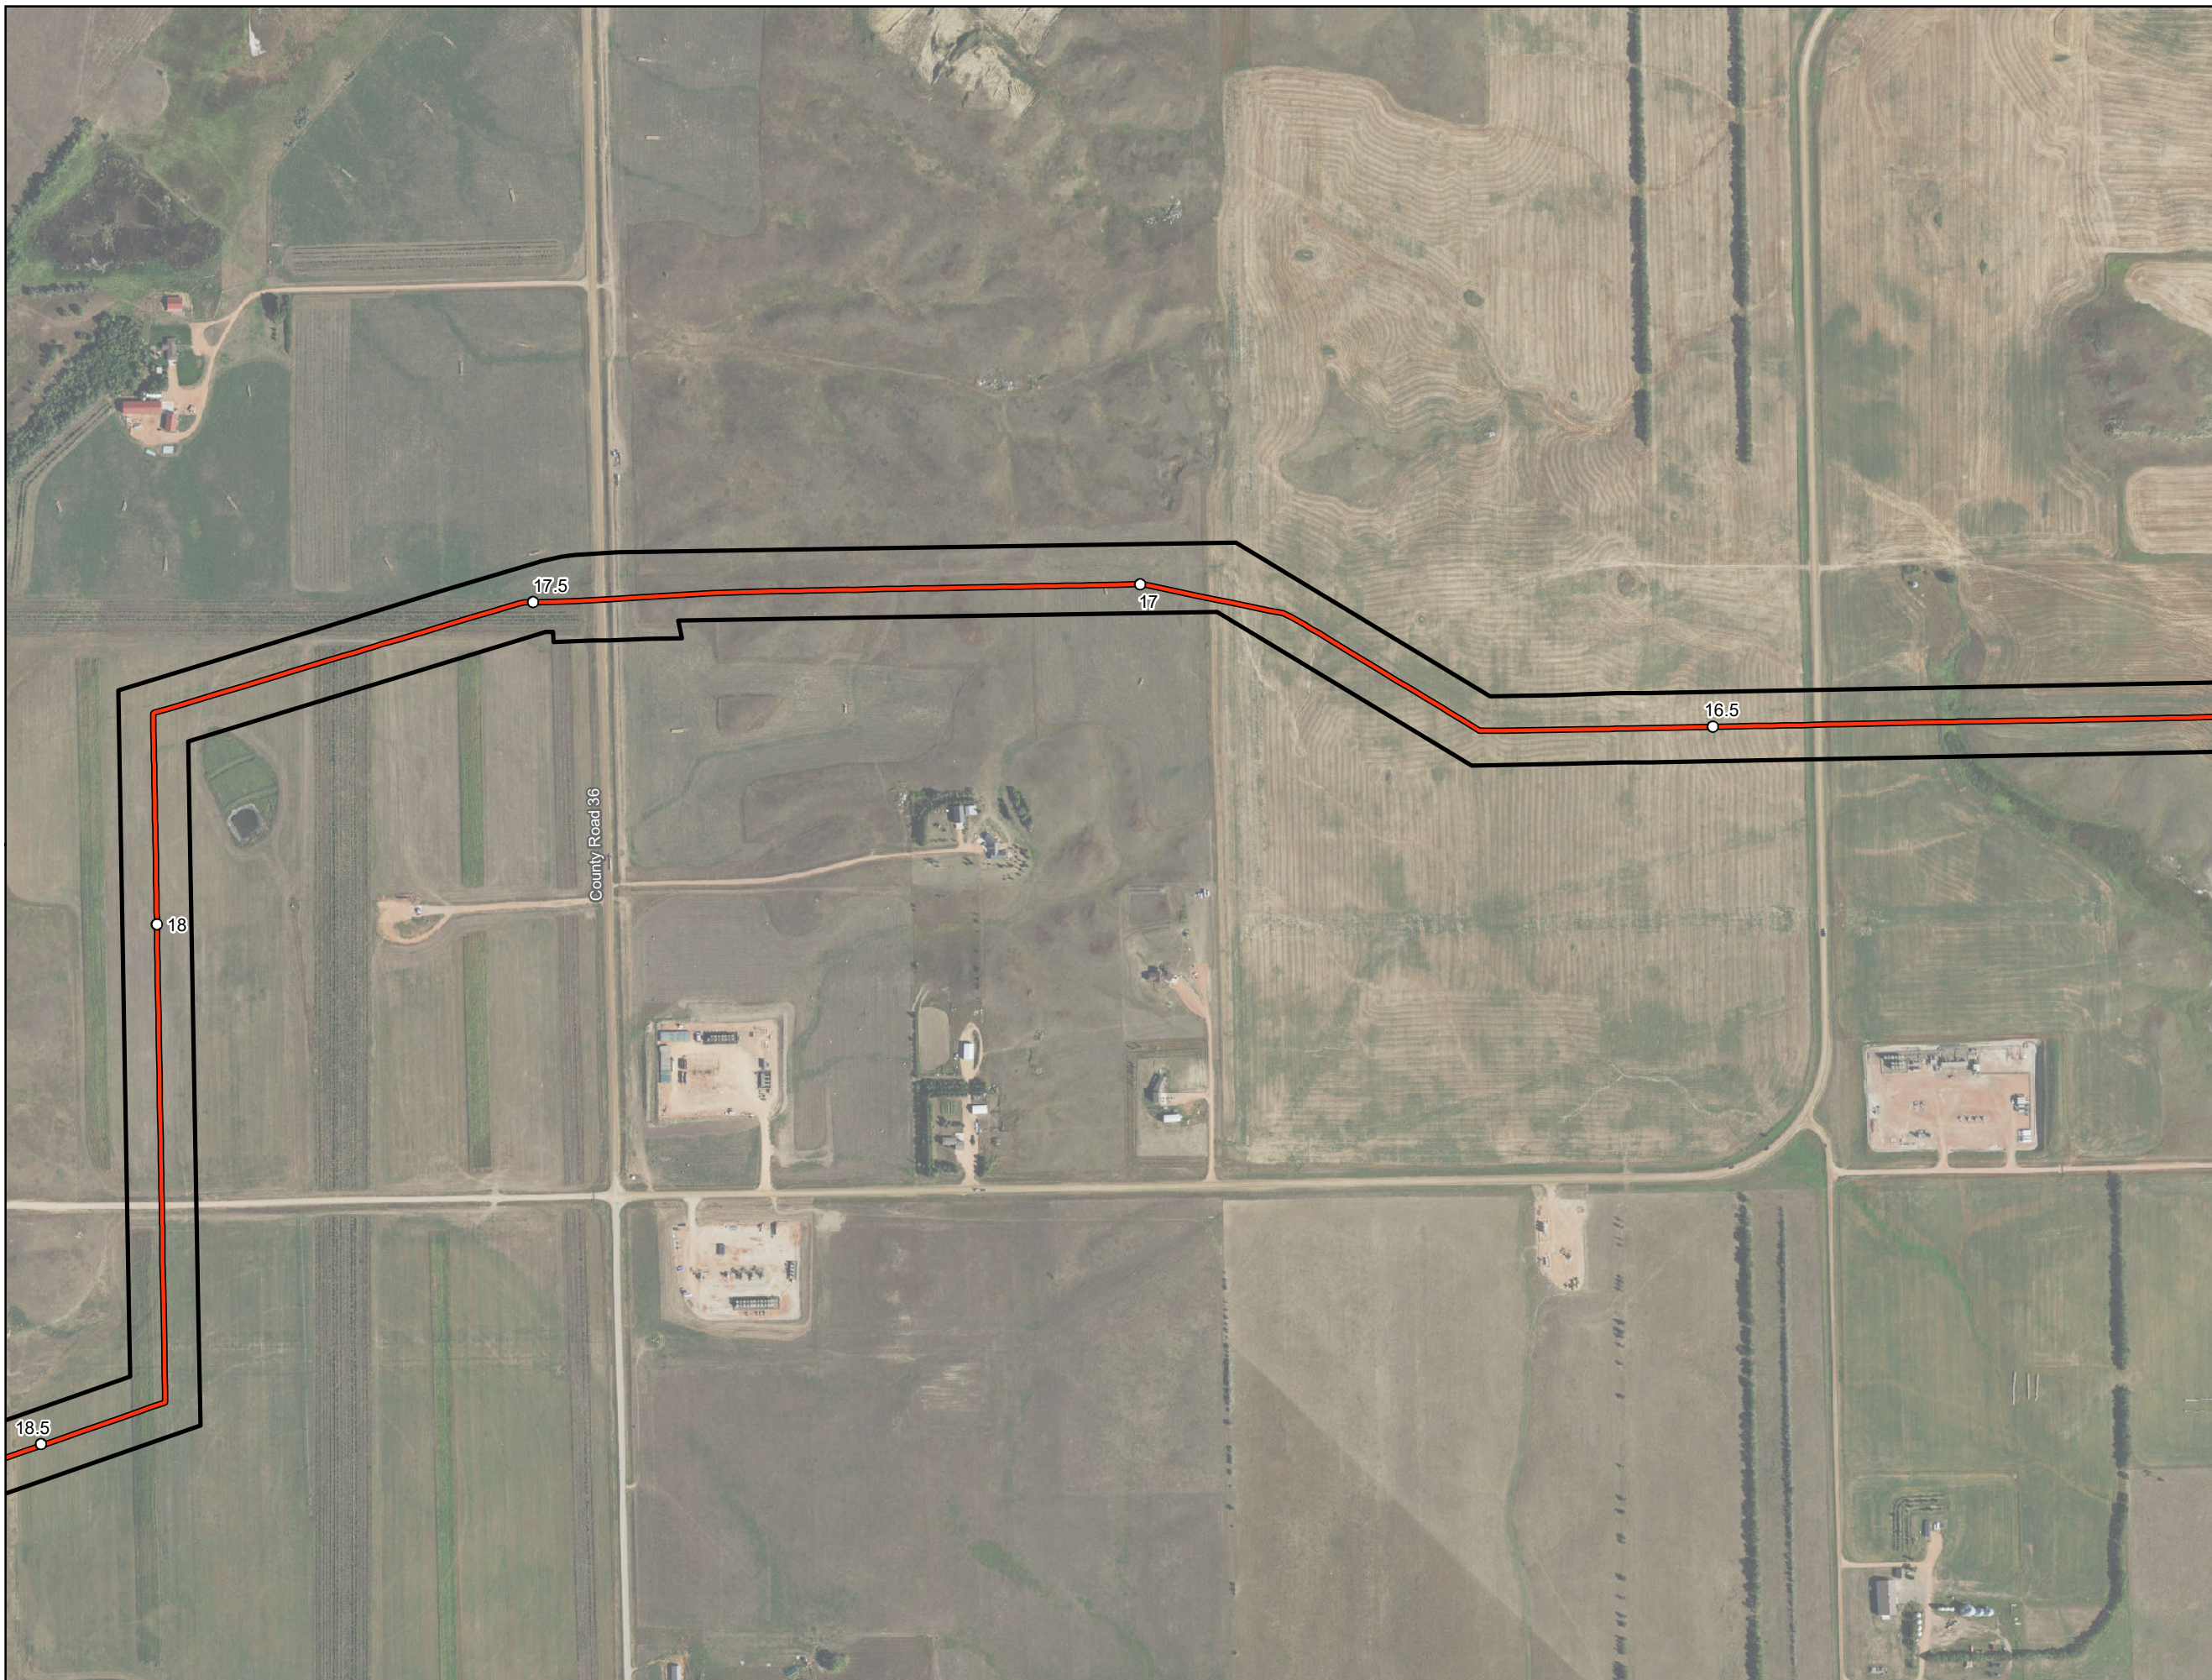

- Milepost
- As-Built Centerline
- Project Corridor

**ONEOK Bakken Pipeline, L.L.C.
Demicks Lake Pipeline Project**




**As-Built Centerline and
Certificated Corridor**

Page 9 of 38

McKenzie County, ND



Date: (1/20/2020) Source: Z:\Clients\MLP\Oneok\Demicks_Lake_Pipeline\Permitting\FSC\20200120_As_Built\DLF_PSC_As_Built_Centerline_Maps.mxd

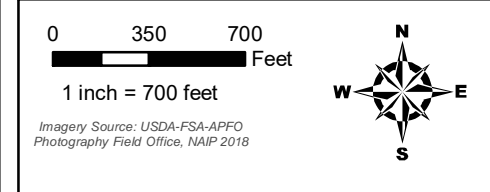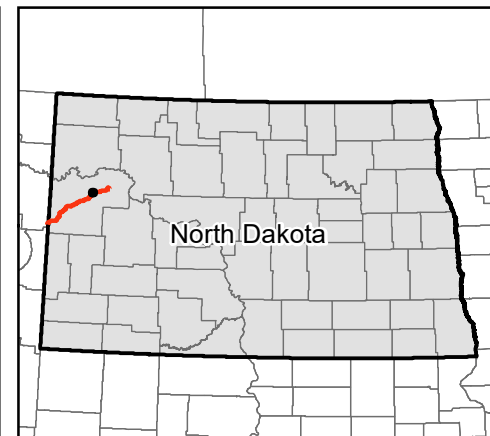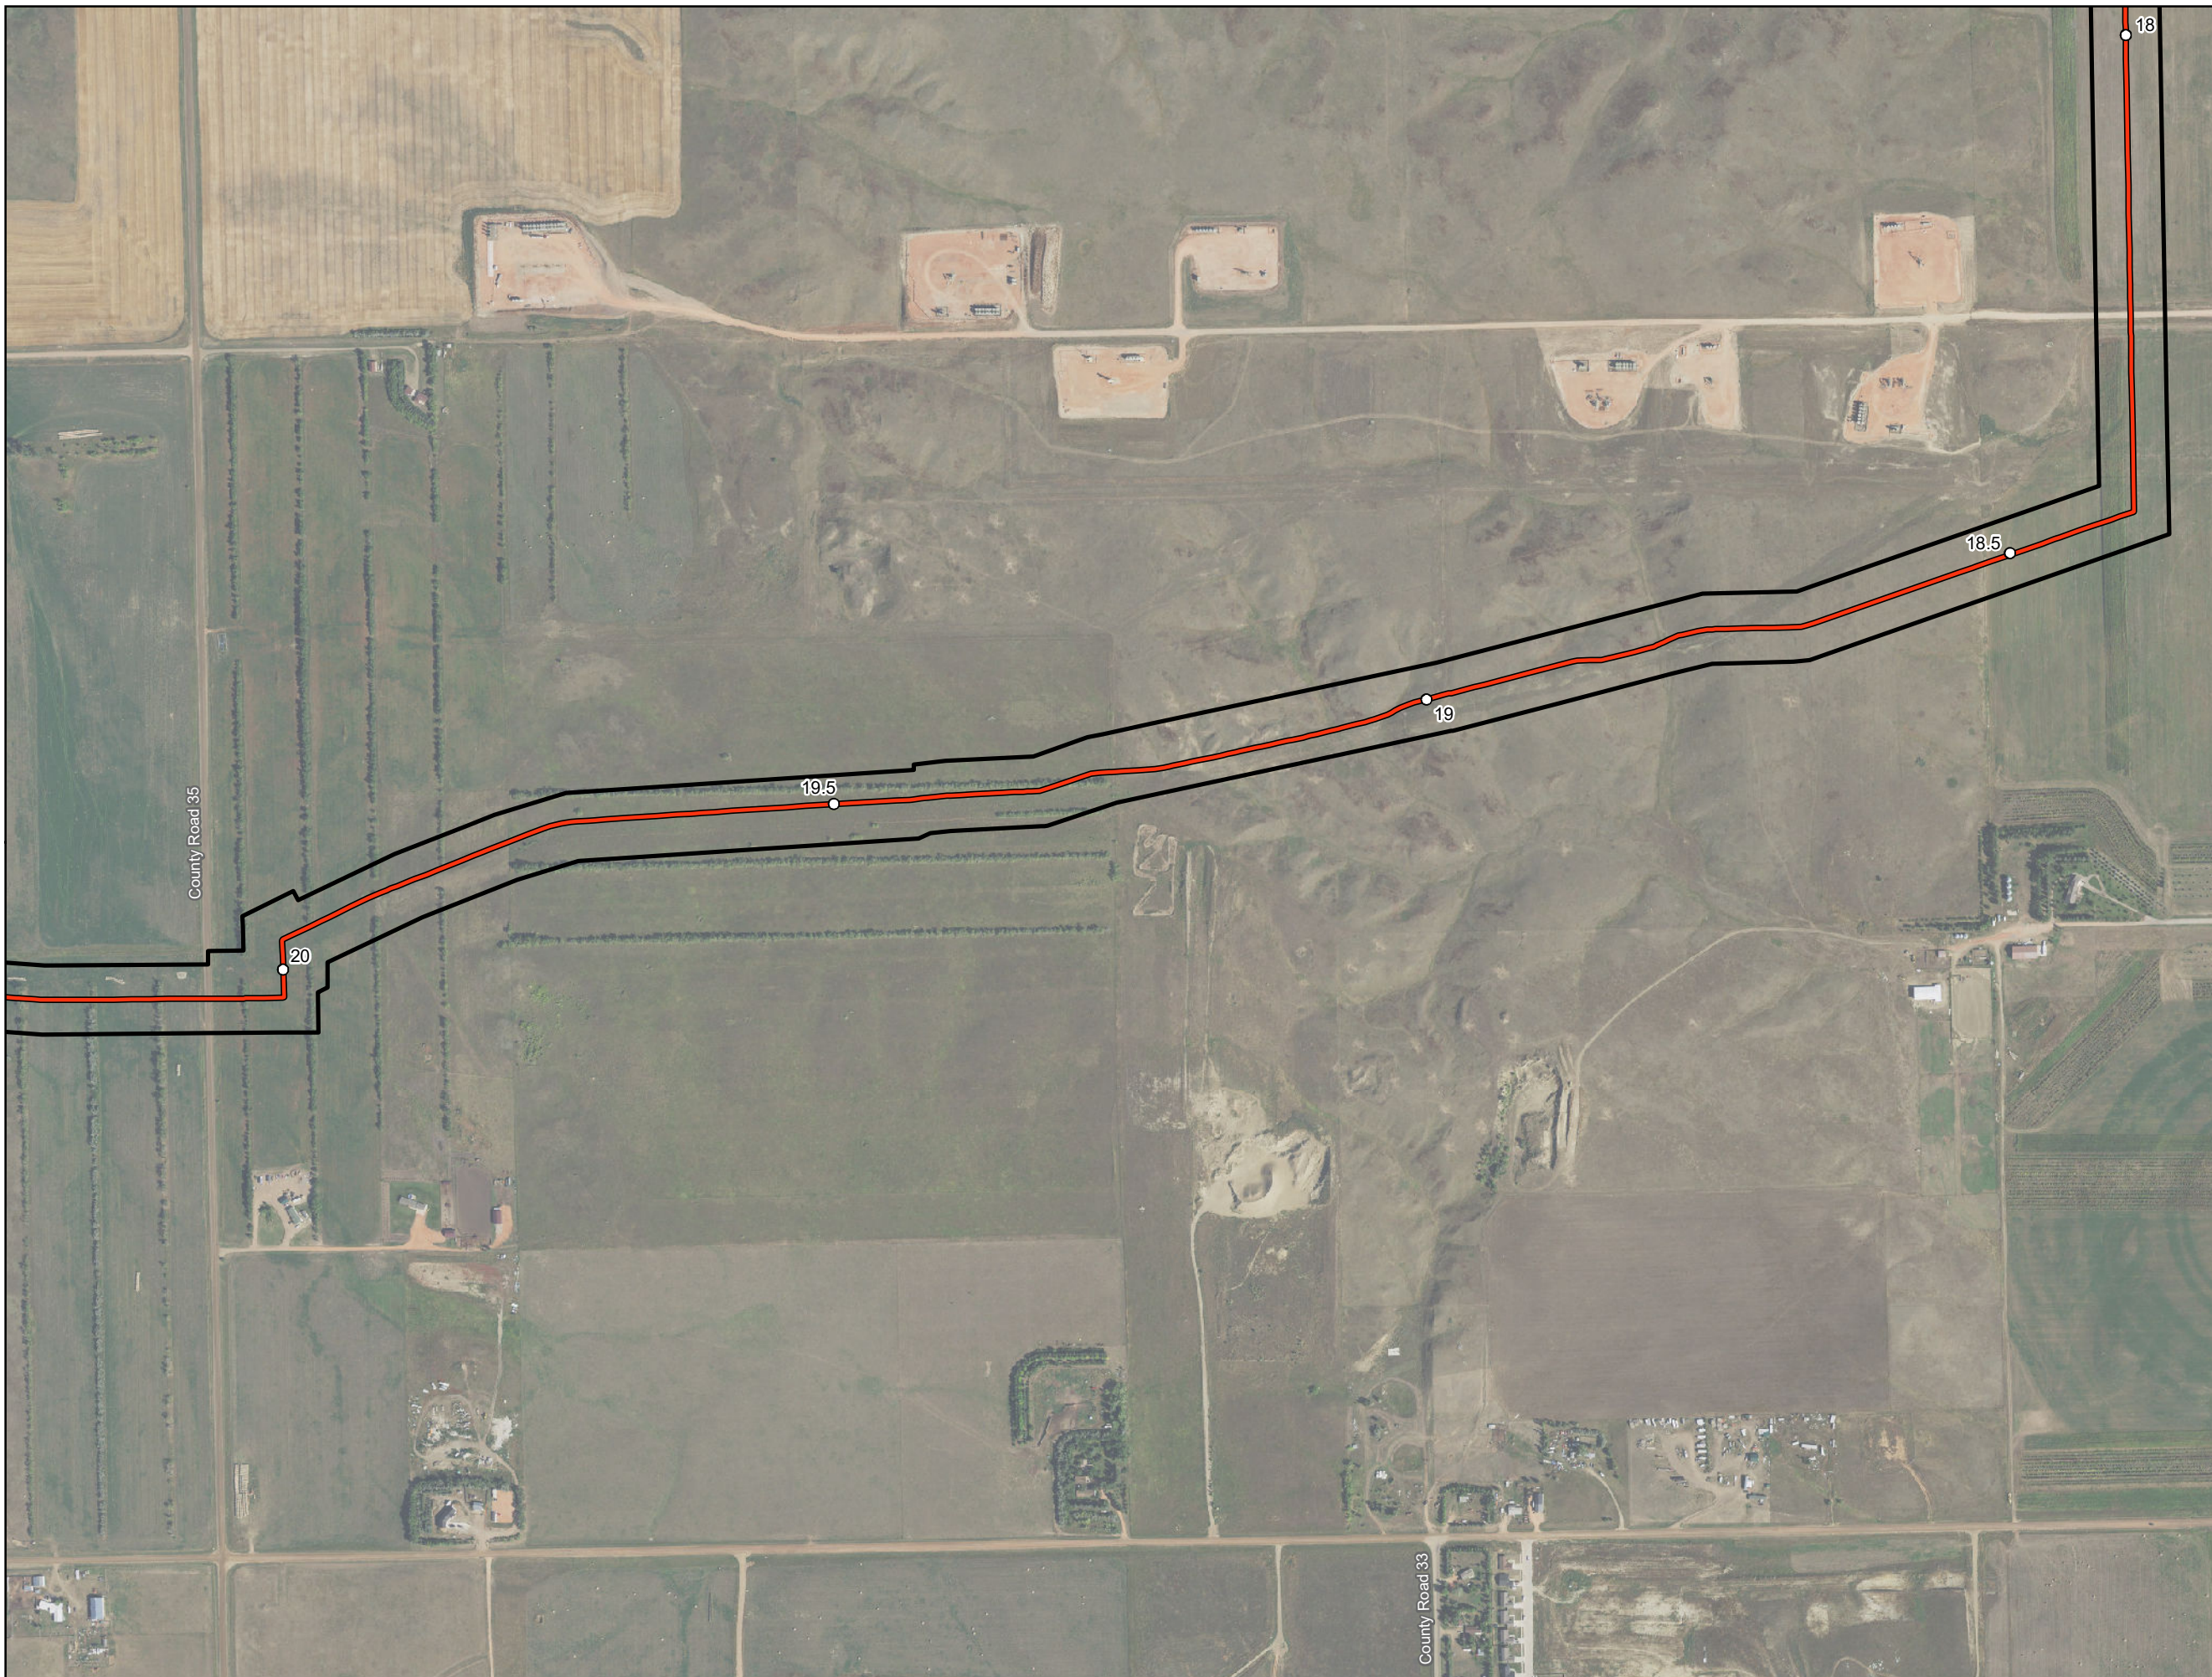

- Milepost
- As-Built Centerline
- Project Corridor

**ONEOK Bakken Pipeline, L.L.C.
Demicks Lake Pipeline Project**




**As-Built Centerline and
Certificated Corridor**

Page 10 of 38

McKenzie County, ND



Date: (1/20/2020) Source: Z:\Clients\MLP\Oneok\Demicks_Lake_Pipeline\Permitting\PSC\20200120_As_Built\DLF_PSC_As_Built_Centerline_Maps.mxd

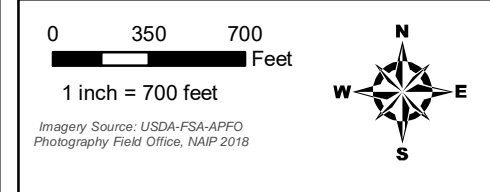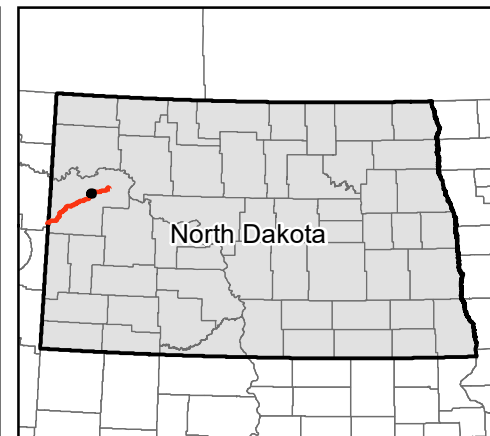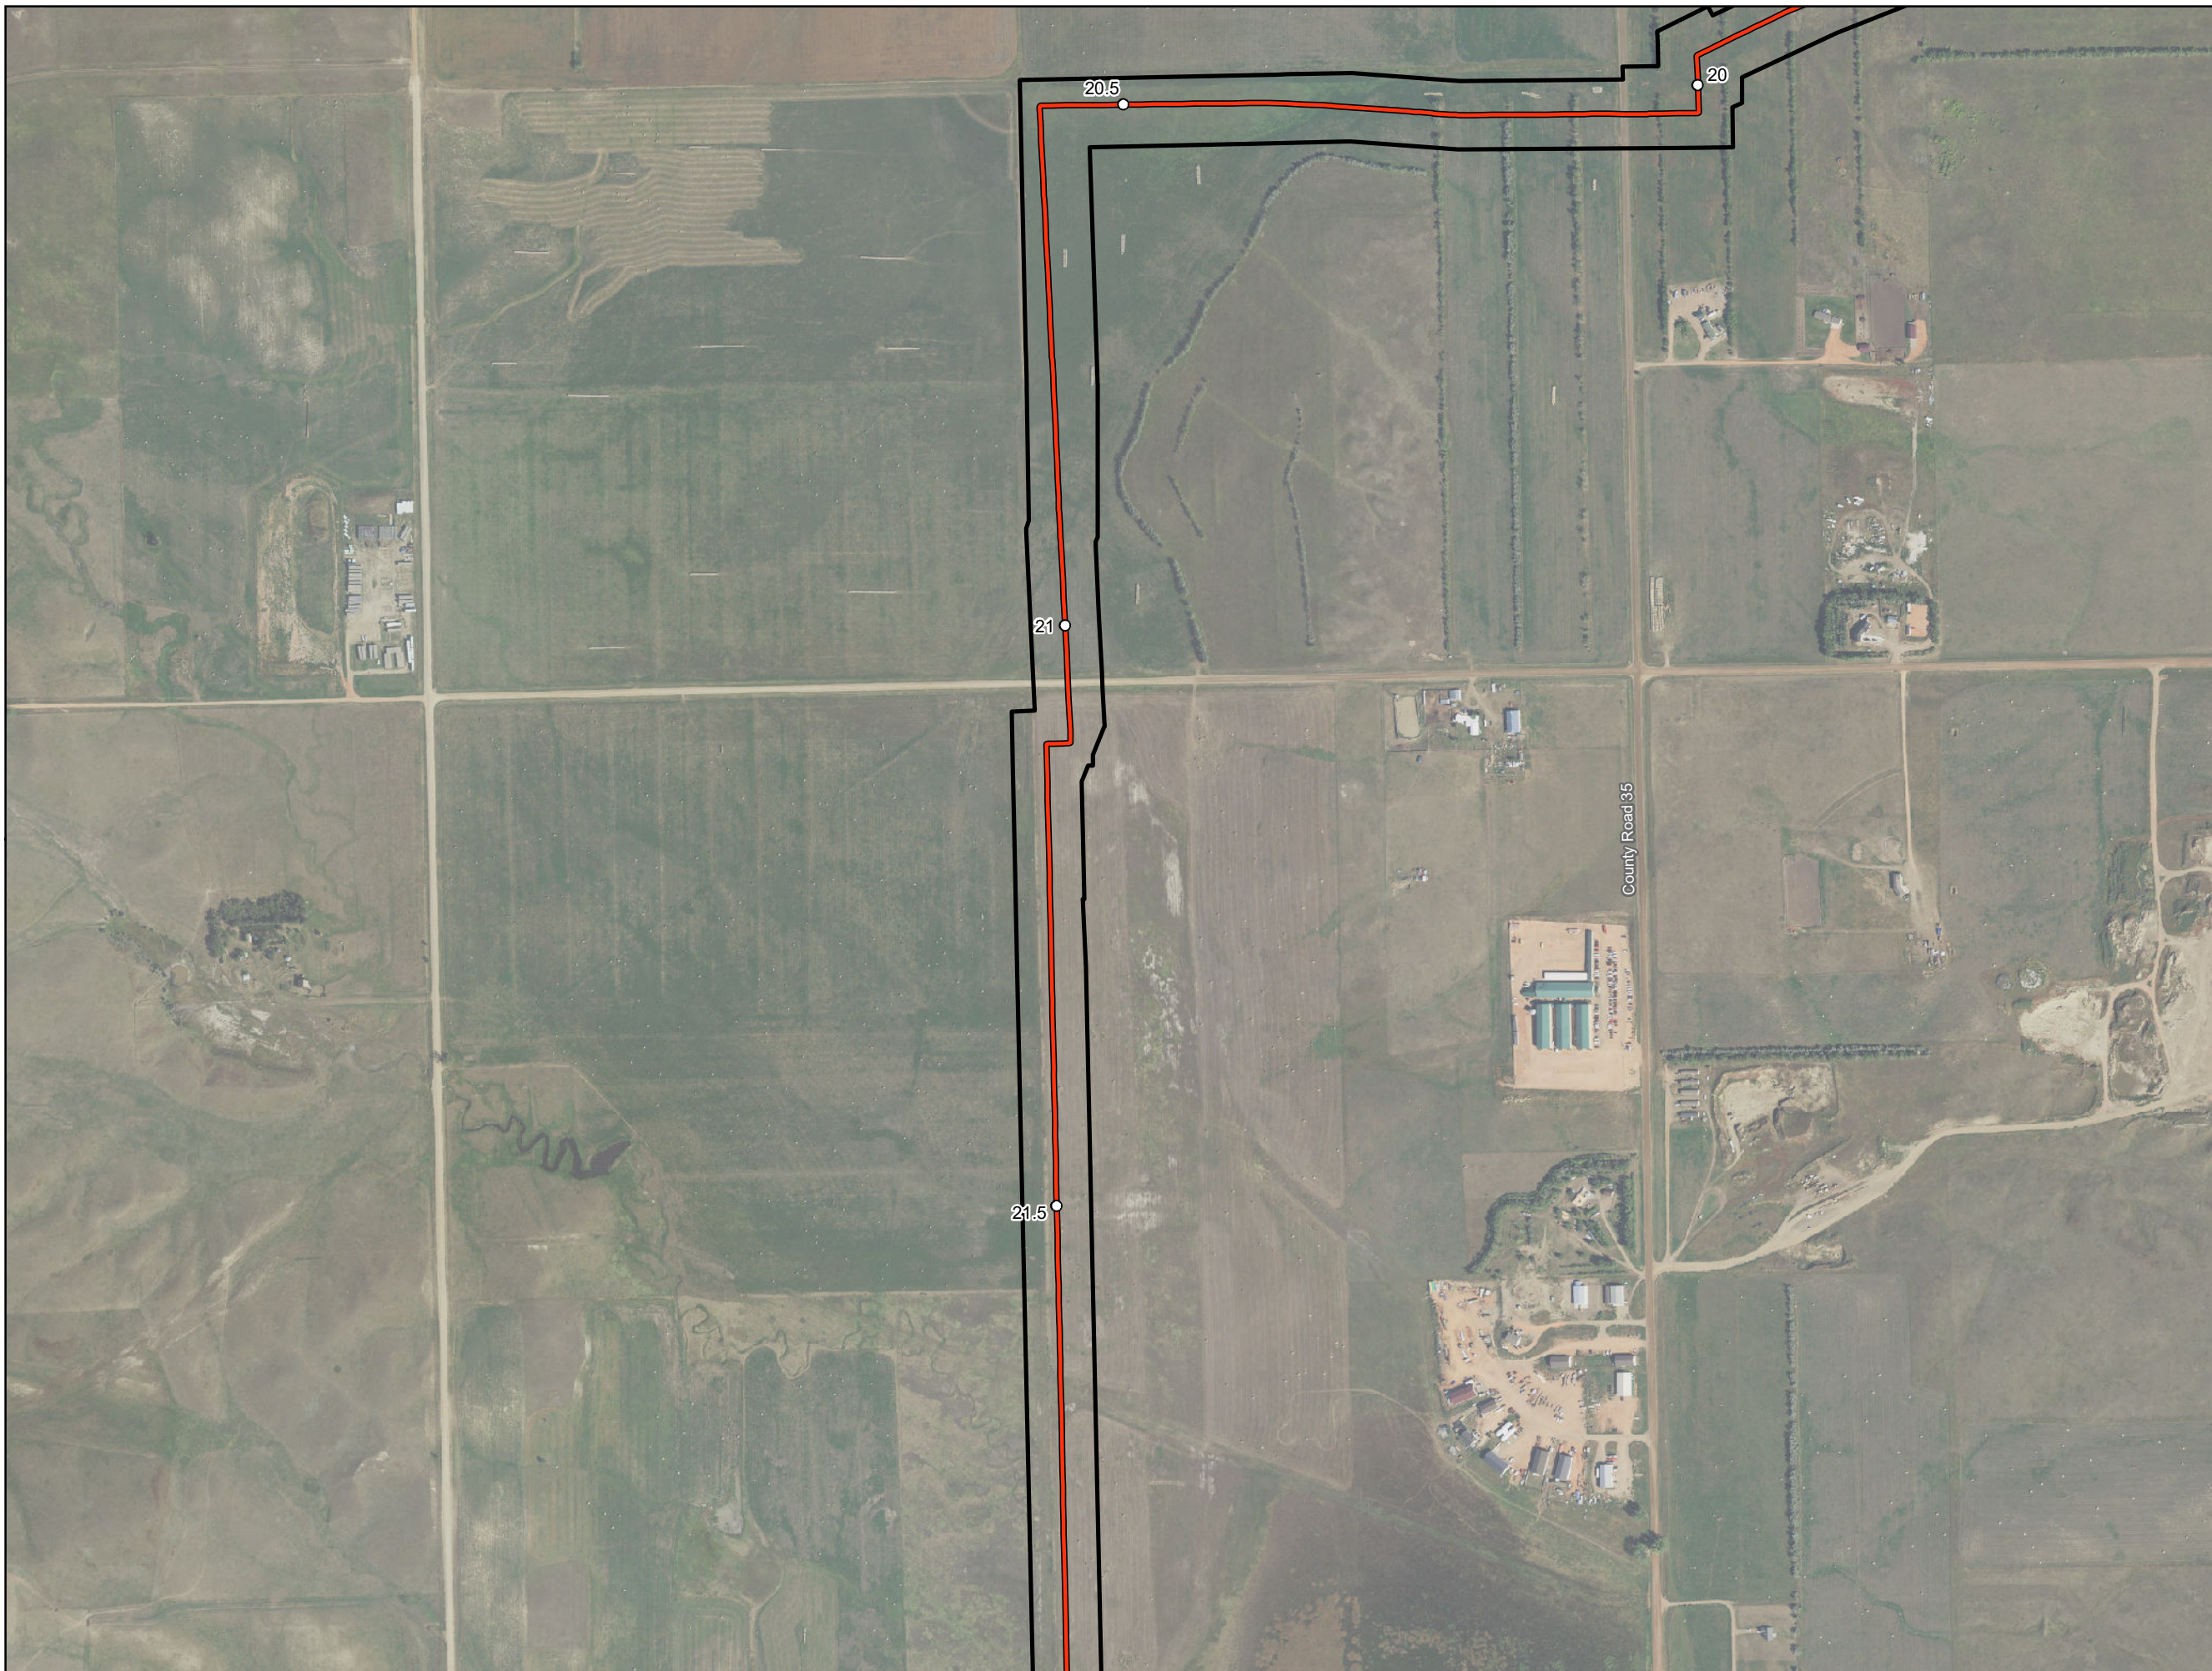

- Milepost
- As-Built Centerline
- Project Corridor




**ONEOK Bakken Pipeline, L.L.C.
Demicks Lake Pipeline Project**

**As-Built Centerline and
Certificated Corridor**

Page 11 of 38
McKenzie County, ND



Date: (1/20/2020) Source: Z:\Clients\M_P\Oneok\Demicks_Lake_Pipeline\Permitting\FSC\20200120_As_Built\DLF_PSC_As_Built_Centerline_Maps.mxd

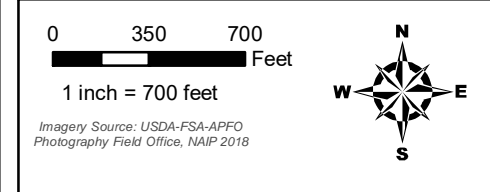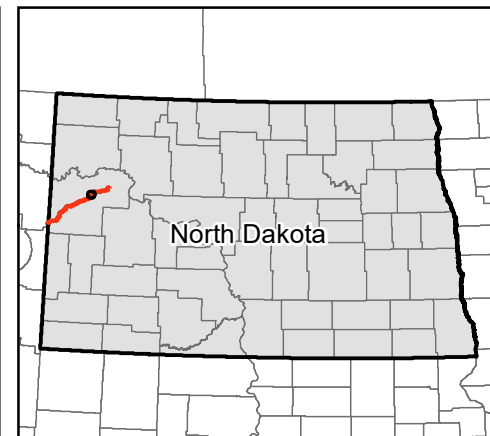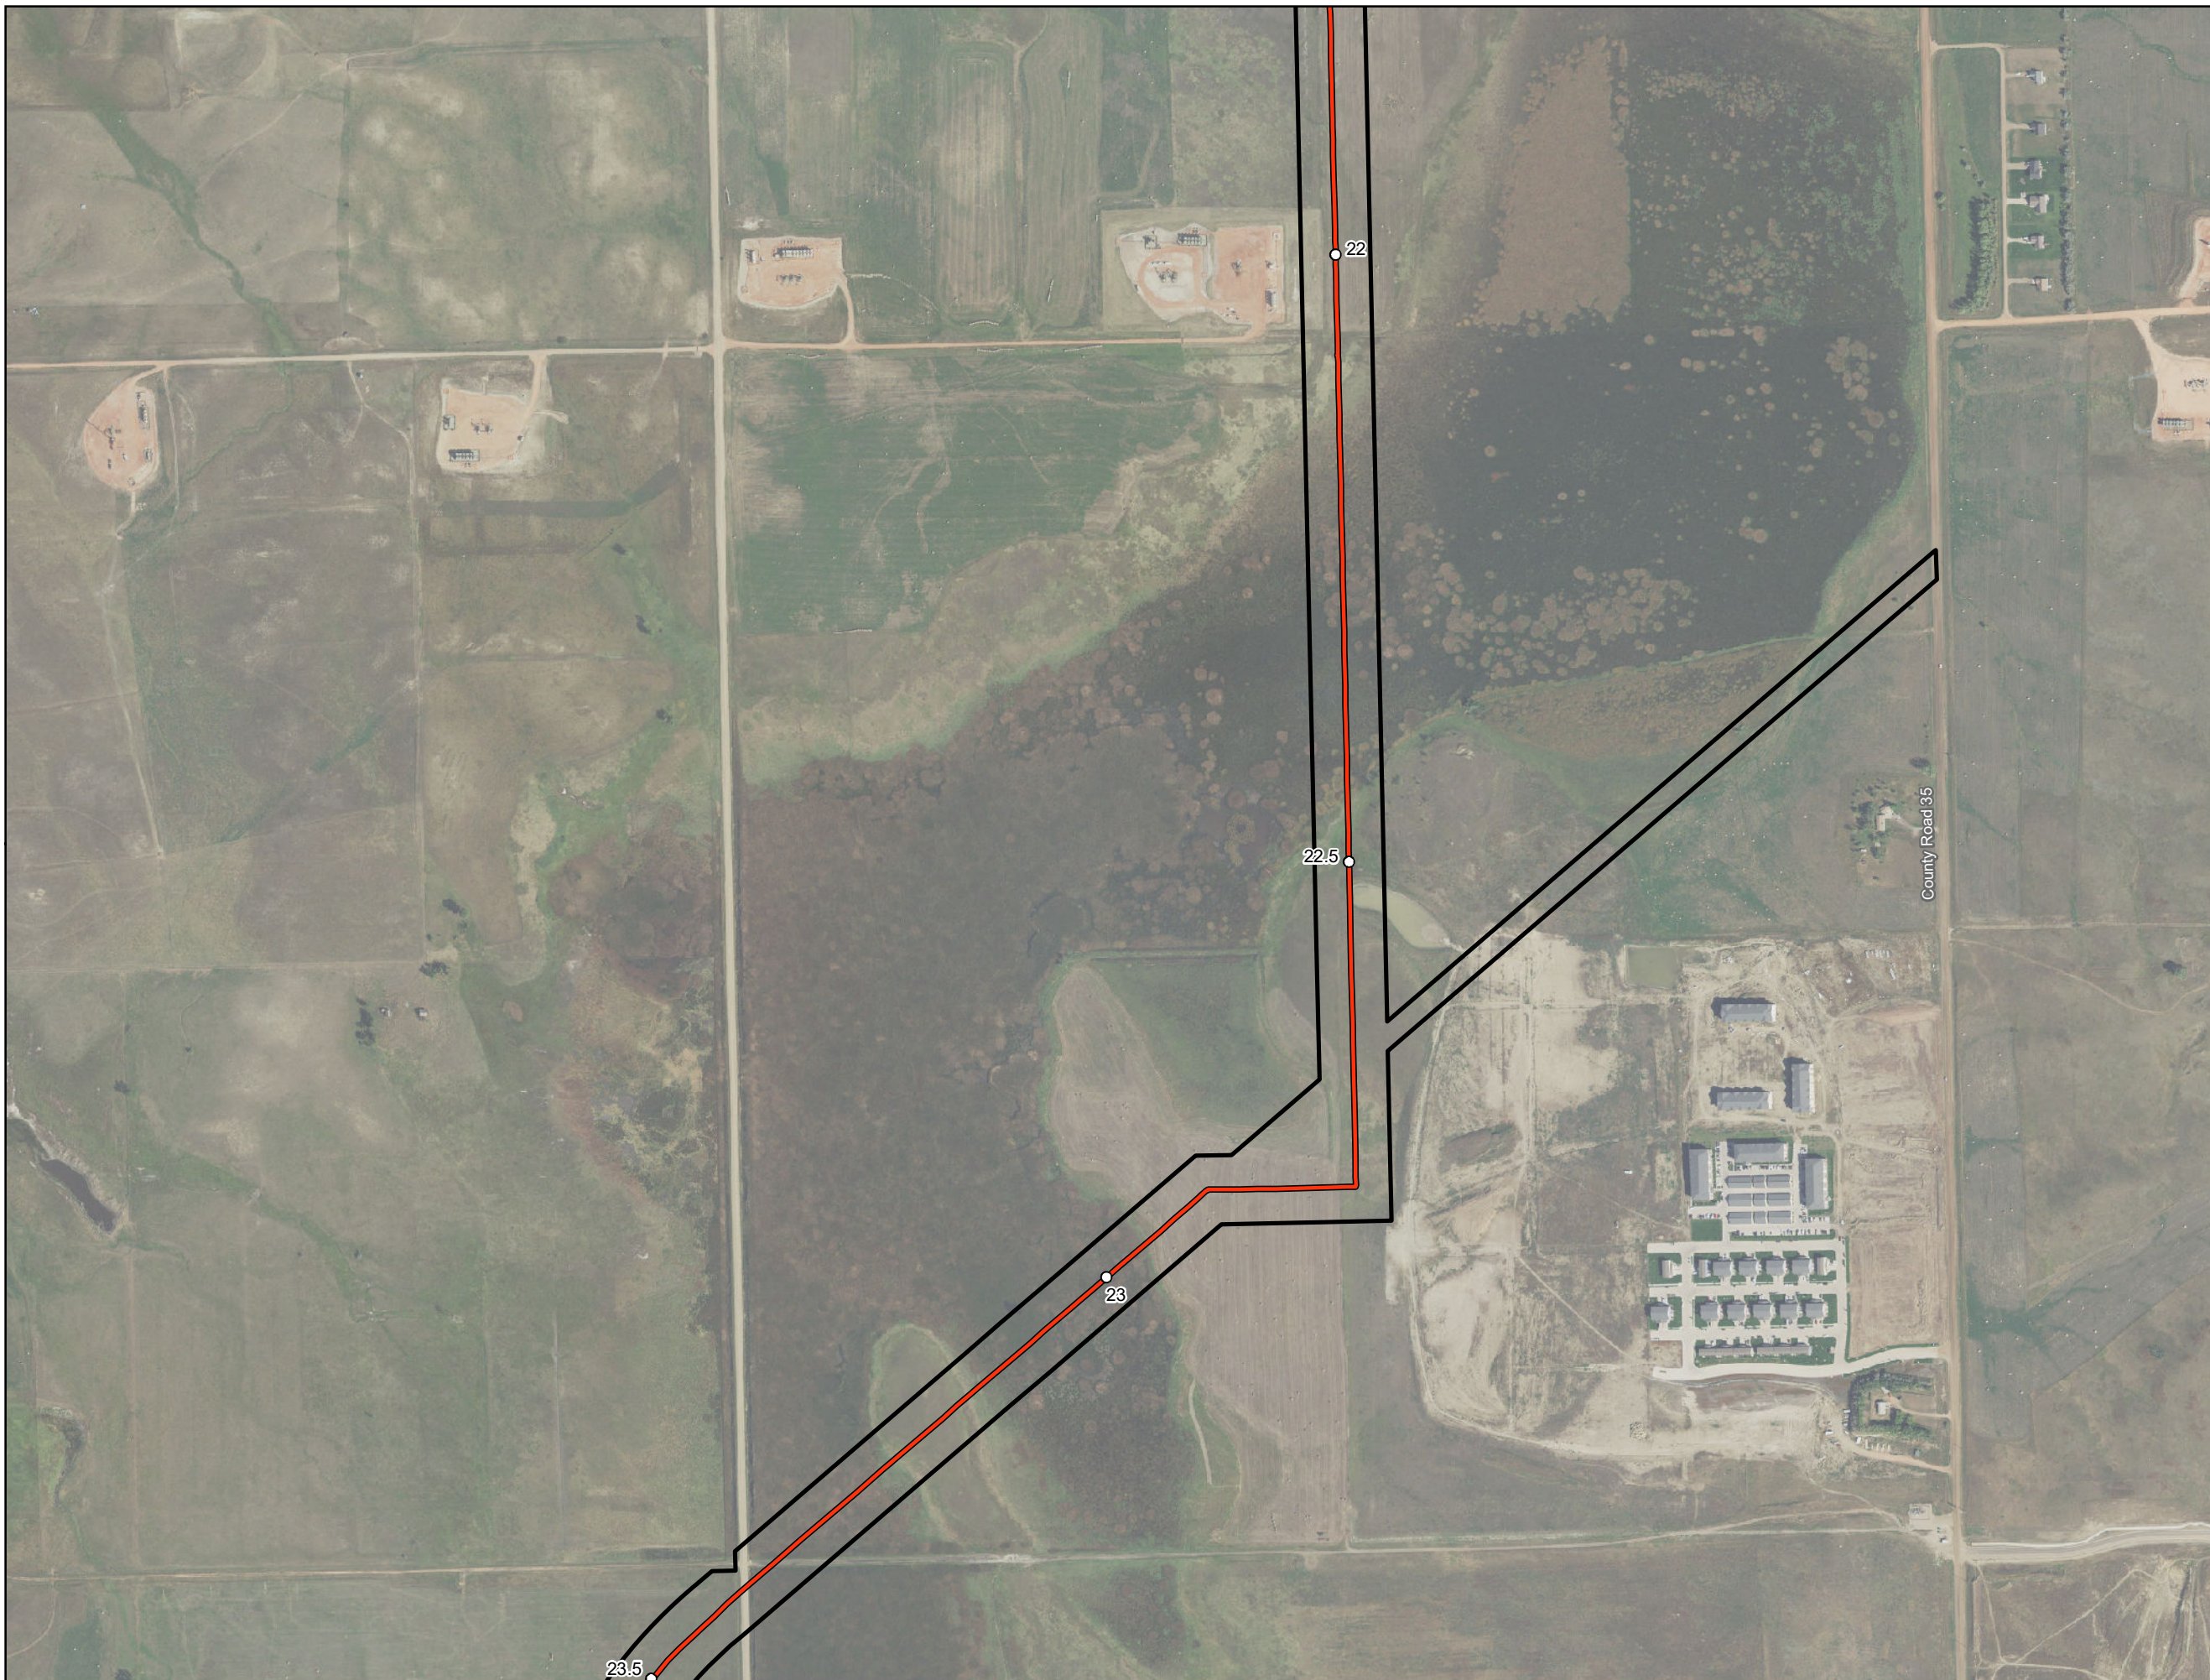




- Milepost
- As-Built Centerline
- Project Corridor

**ONEOK Bakken Pipeline, L.L.C.
Demicks Lake Pipeline Project**

**As-Built Centerline and
Certificated Corridor**

Page 12 of 38
McKenzie County, ND

Date: (1/20/2020) Source: Z:\Clients\M_P\Oneok\Demicks_Lake_Pipeline\Permitting\FSC\20200120_As_Built\DLF_PSC_As_Built_Centerline_Maps.mxd

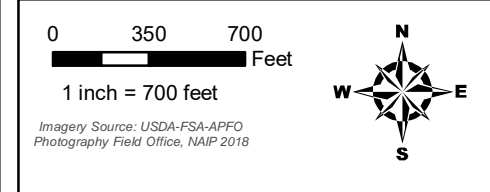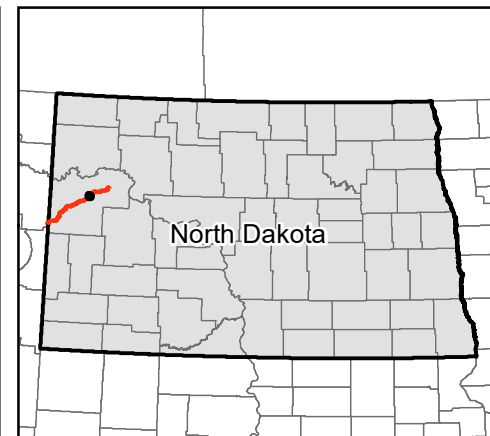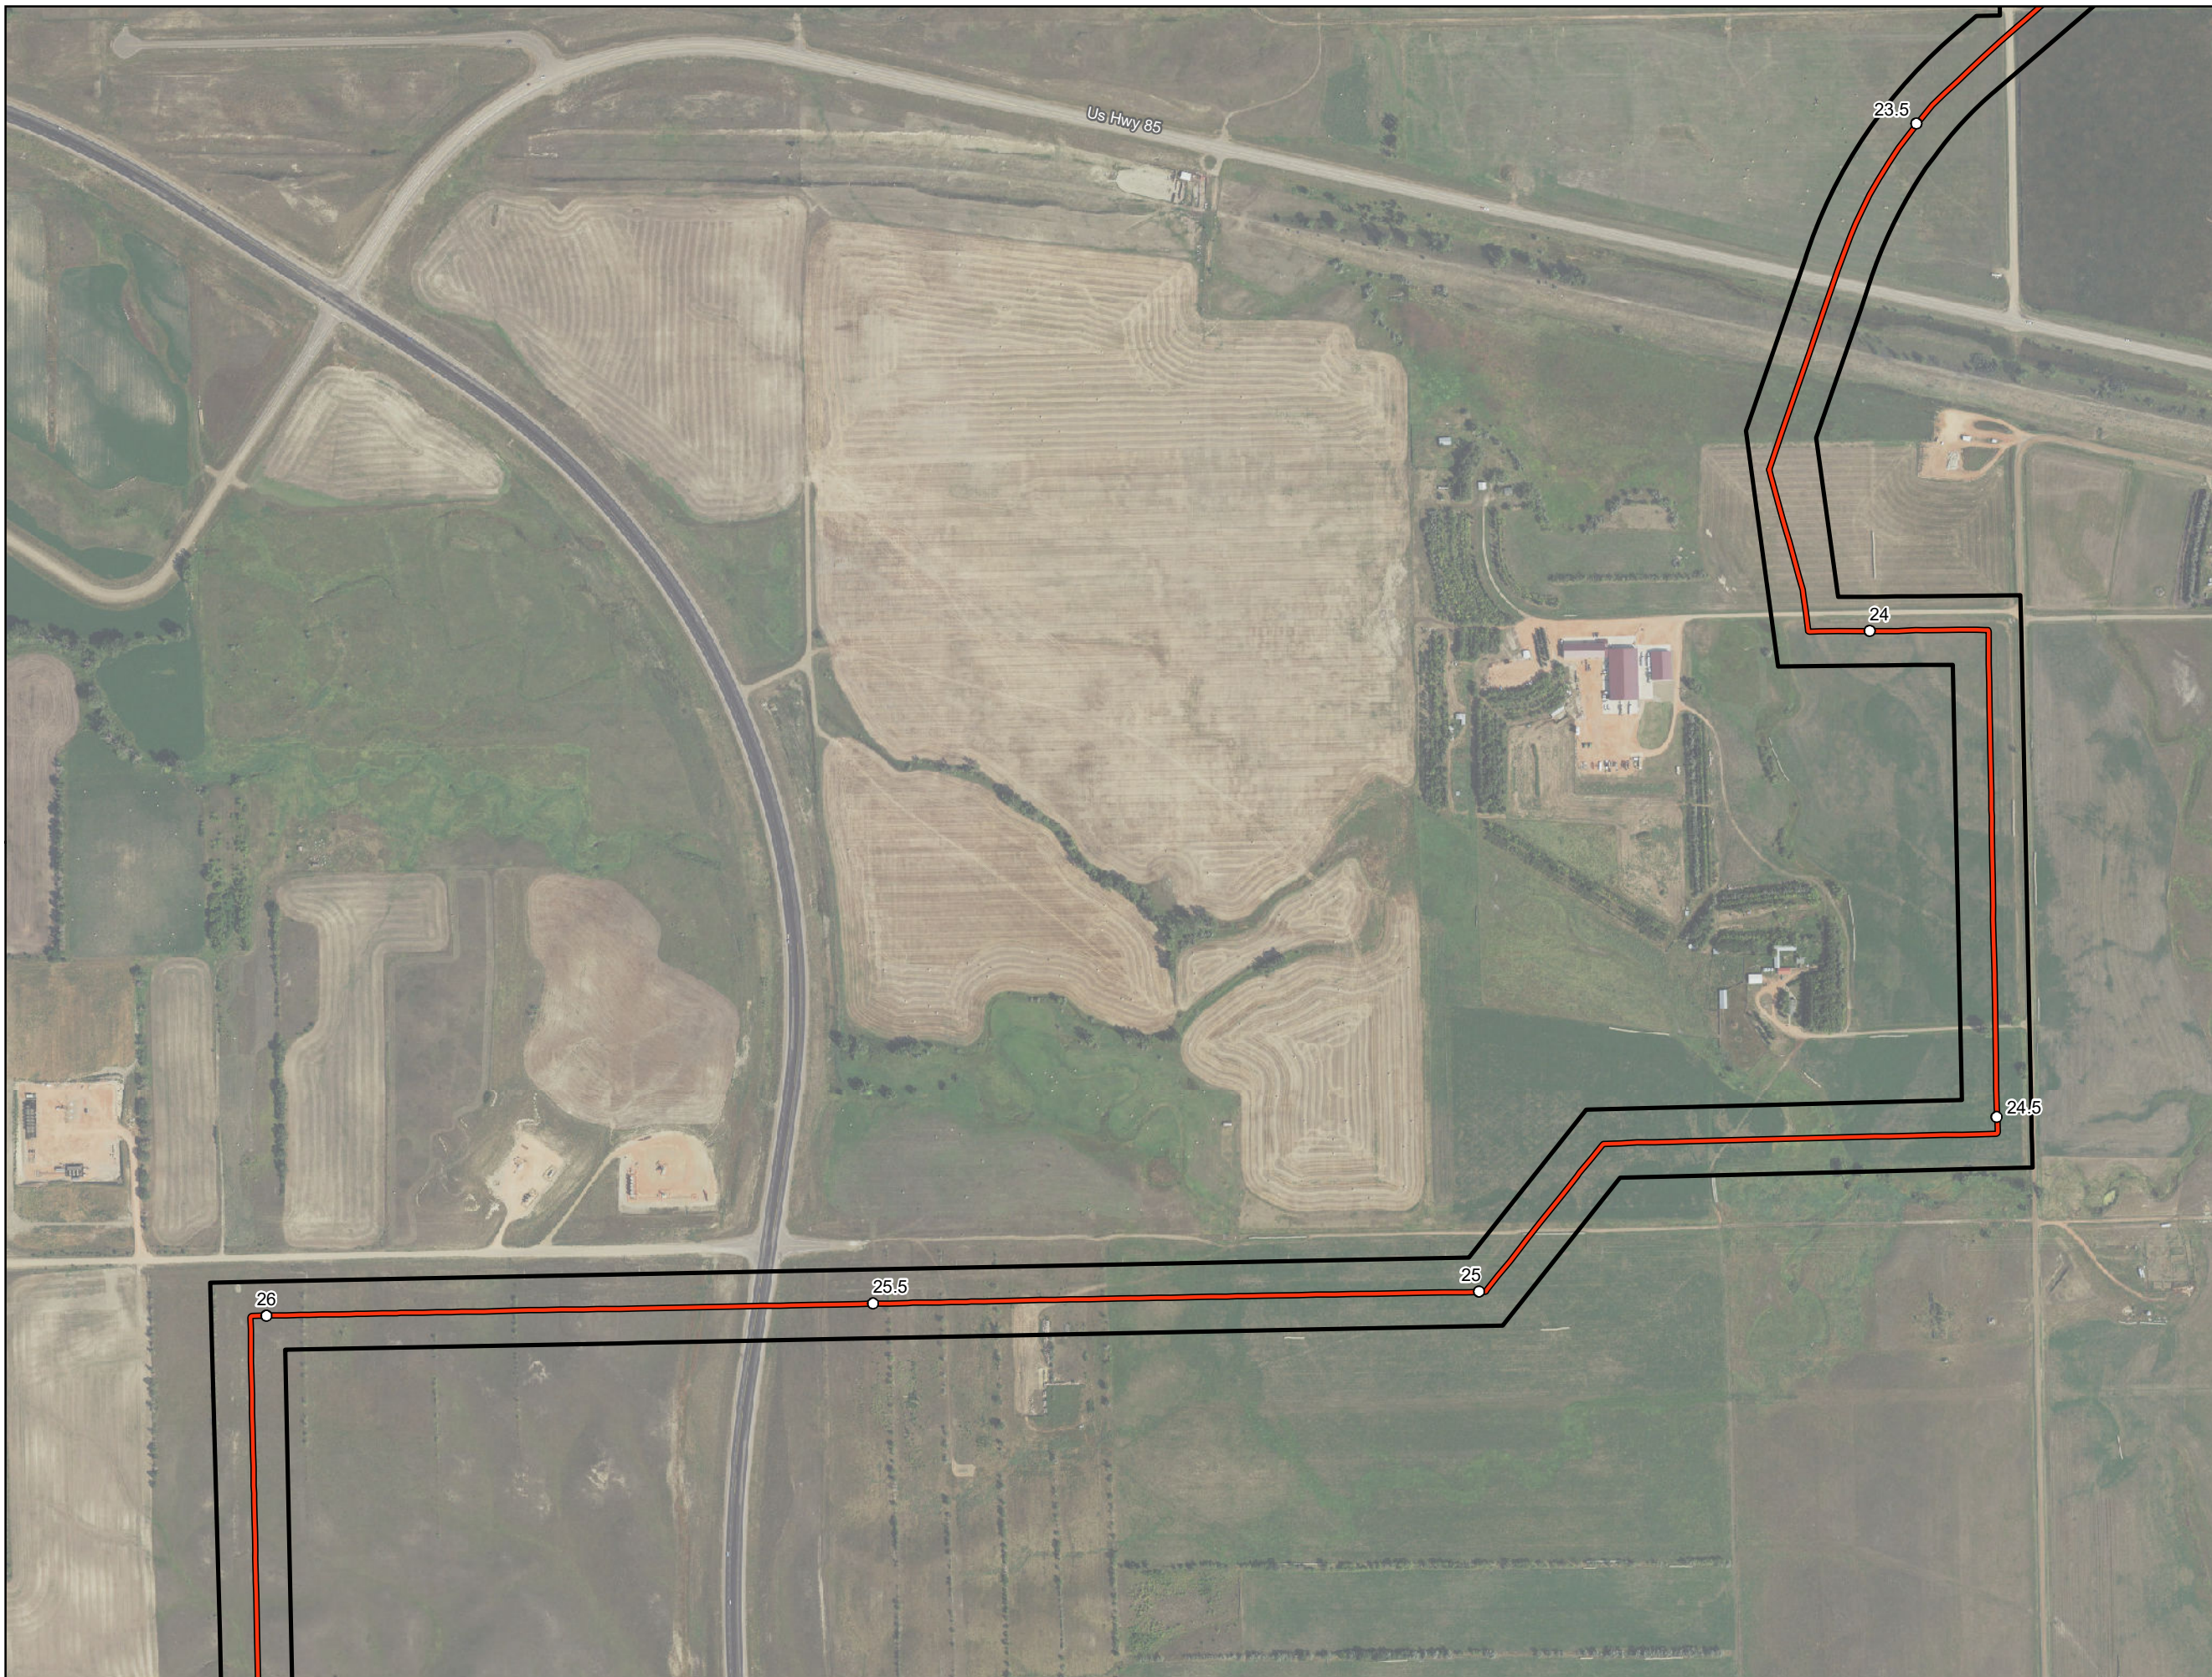

Imagery Source: USDA-FSA-APFO
Photography Field Office, NAIP 2018



- Milepost
- As-Built Centerline
- Project Corridor

**ONEOK Bakken Pipeline, L.L.C.
Demicks Lake Pipeline Project**

**As-Built Centerline and
Certificated Corridor**

Page 13 of 38
McKenzie County, ND

Date: (1/20/2020) Source: Z:\Clients\MLP\Oneok\Demicks_Lake_Pipeline\Permitting\FSC\20200120_As_Built\DLF_PSC_As_Built_Centerline_Maps.mxd

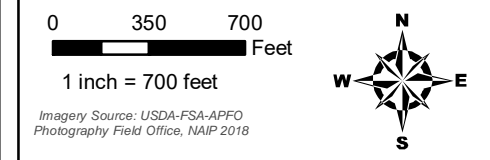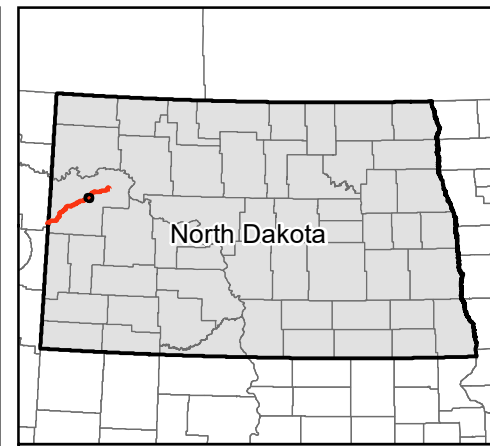

Imagery Source: USDA-FSA-APFO
Photography Field Office, NAIP 2018

- Milepost
- As-Built Centerline
- Project Corridor

**ONEOK Bakken Pipeline, L.L.C.
Demicks Lake Pipeline Project**



**As-Built Centerline and
Certificated Corridor**

Page 14 of 38

McKenzie County, ND



Date: (1/20/2020) Source: Z:\Clients\MLP\Oneok\Demicks_Lake_Pipeline\Permitting\PSC\20200120_As_Built\DLF_PSC_As_Built_Centerline_Maps.mxd

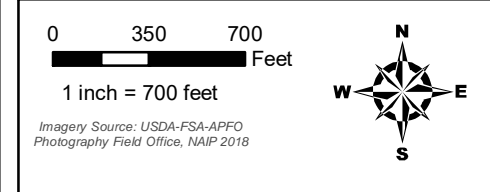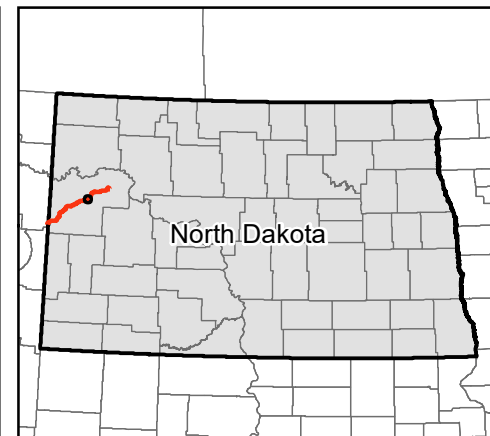

Imagery Source: USDA-FSA-APFO
Photography Field Office, NAIP 2018

- Milepost
- As-Built Centerline
- Project Corridor




**ONEOK Bakken Pipeline, L.L.C.
Demicks Lake Pipeline Project**

**As-Built Centerline and
Certificated Corridor**

Page 15 of 38
McKenzie County, ND



Date: (1/20/2020) Source: Z:\Clients\M_L\Oneok\Demicks_Lake_Pipeline\Permitting\FSC\20200120_As_Built\DLF_PSC_As_Built_Centerline_Maps.mxd

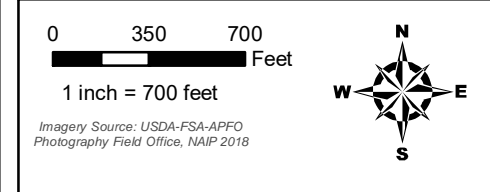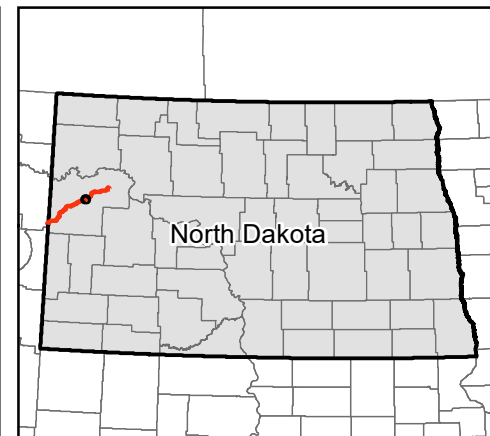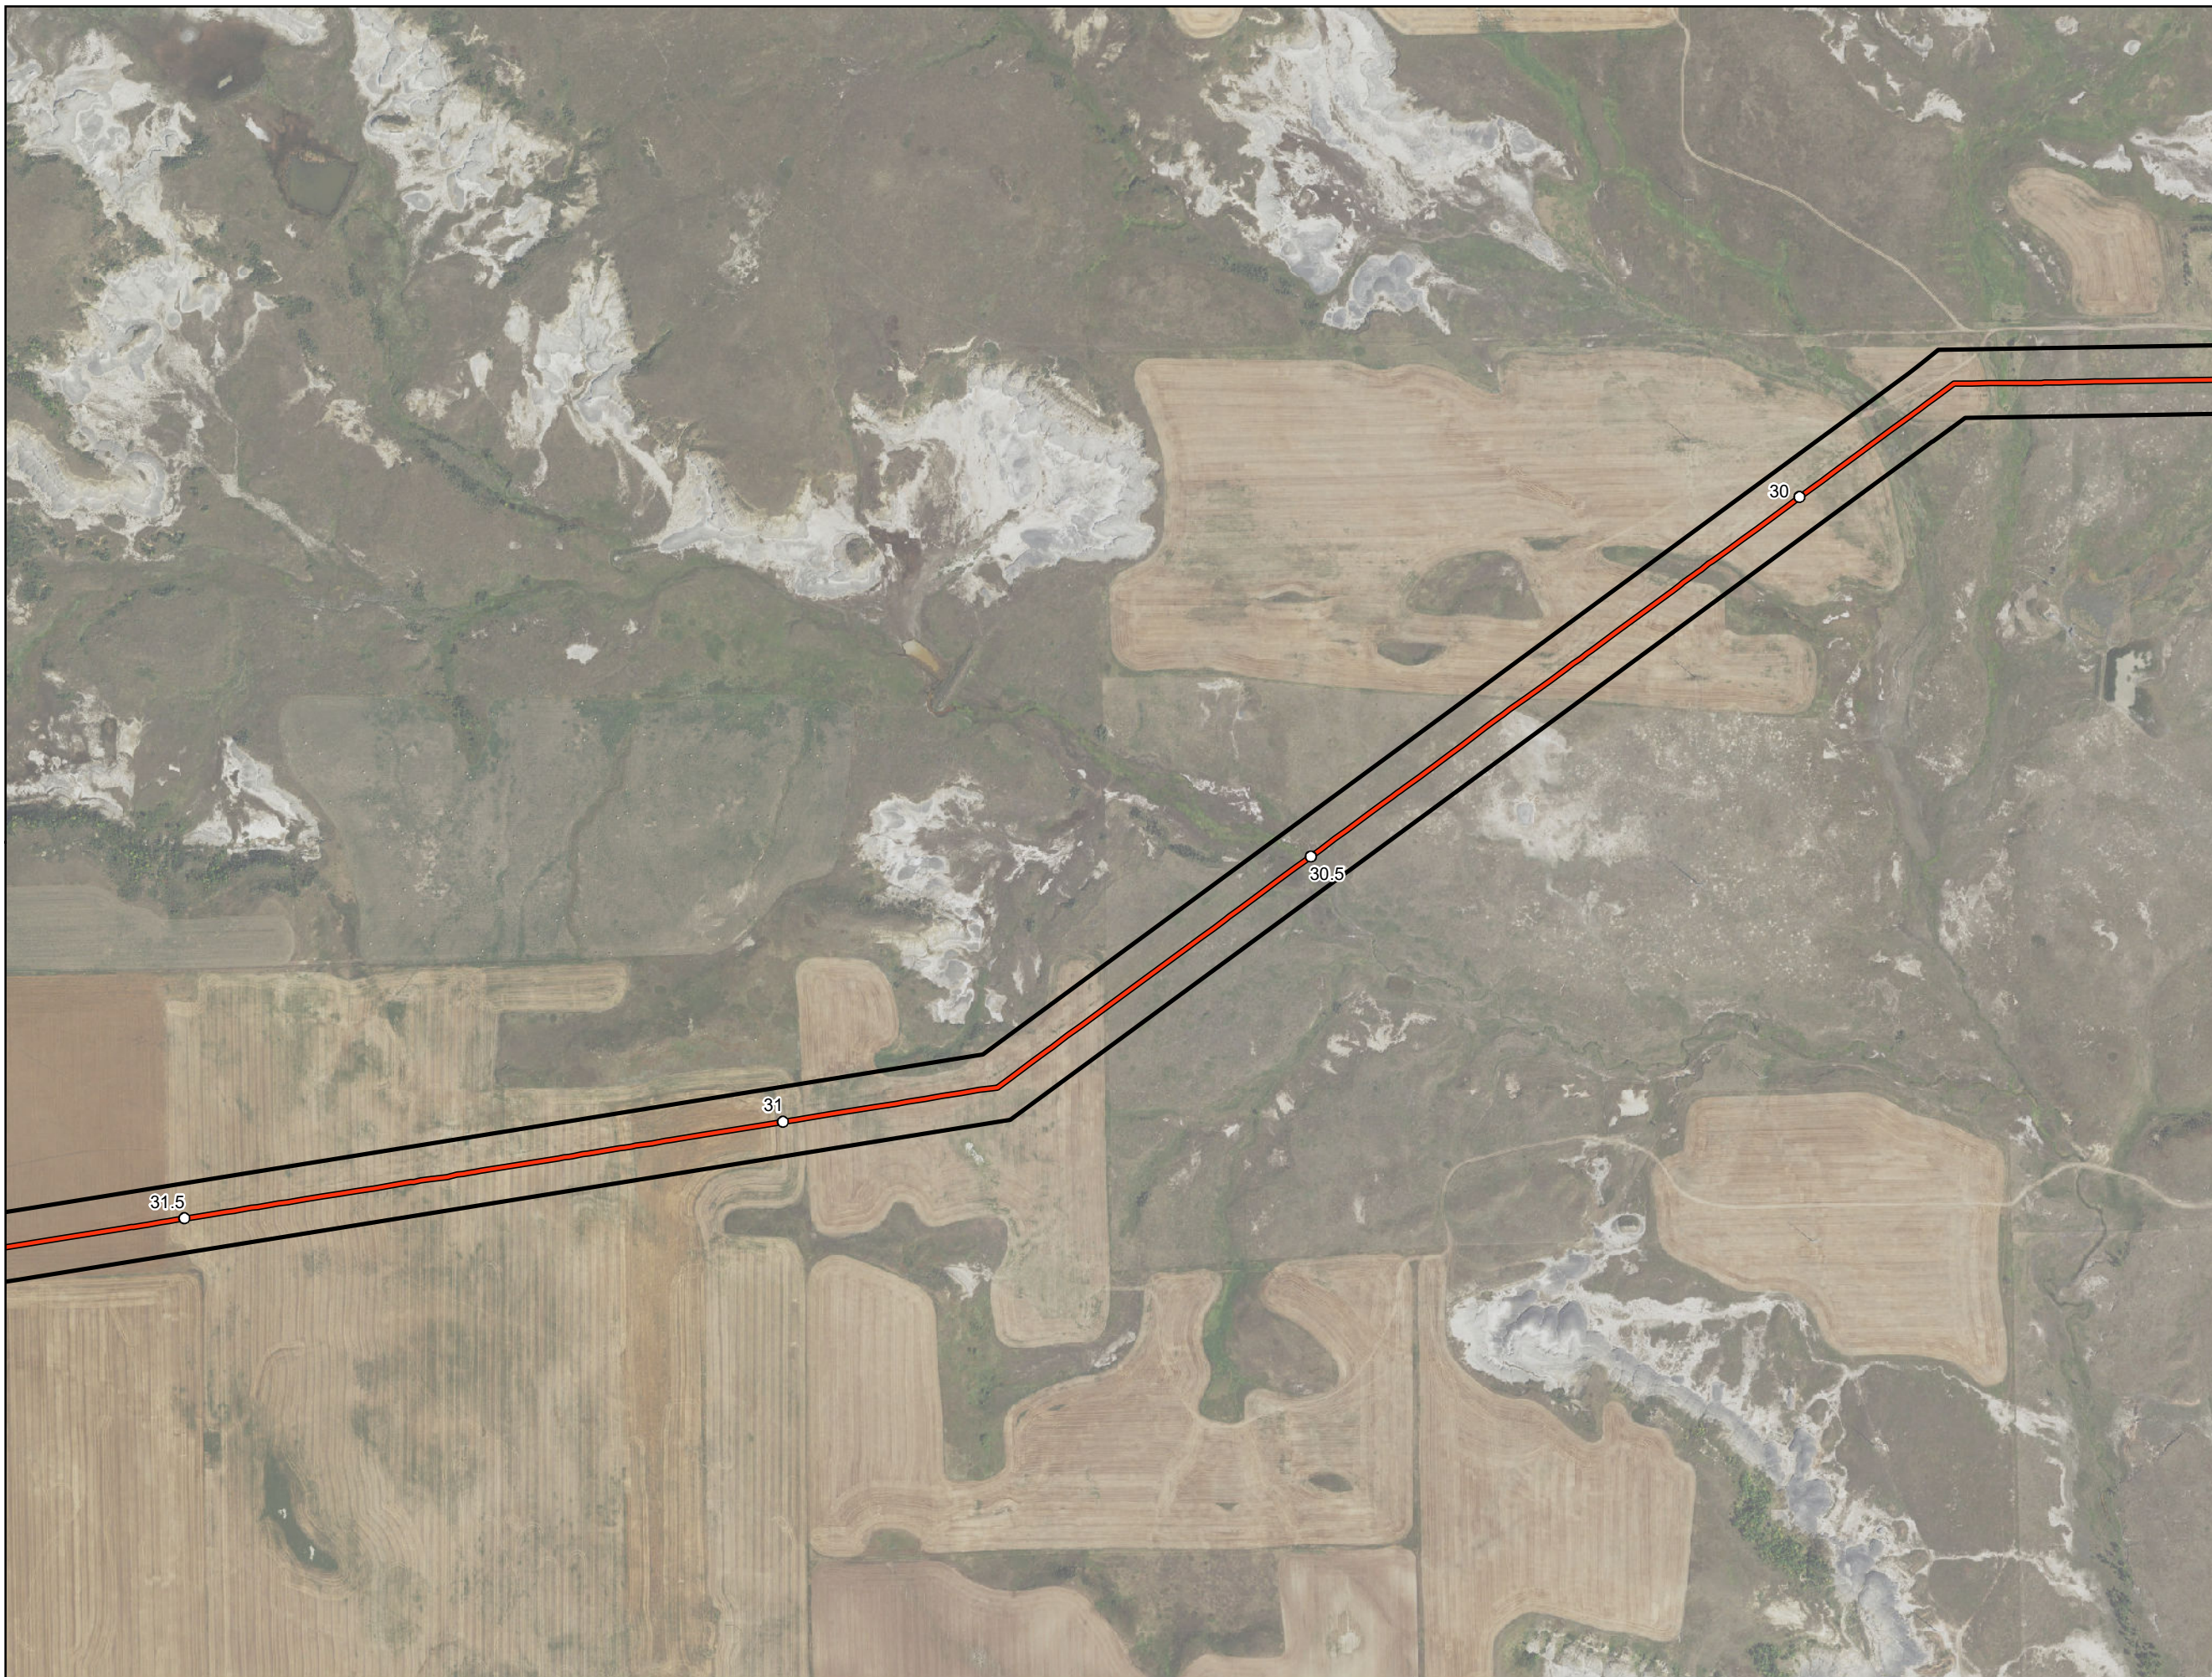

Imagery Source: USDA-FSA-APFO
Photography Field Office, NAIP 2018

- Milepost
- As-Built Centerline
- Project Corridor

**ONEOK Bakken Pipeline, L.L.C.
Demicks Lake Pipeline Project**




**As-Built Centerline and
Certificated Corridor**

Page 16 of 38

McKenzie County, ND



Date: (1/20/2020) Source: Z:\Clients\MLP\Oneok\Demicks_Lake_Pipeline\Permitting\PSC\20200120_As_Built\DLF_PSC_As_Built\Centerline_Maps.mxd

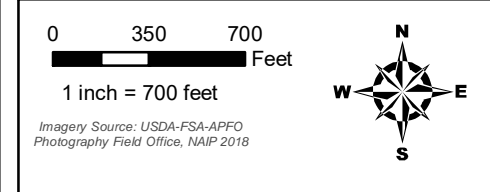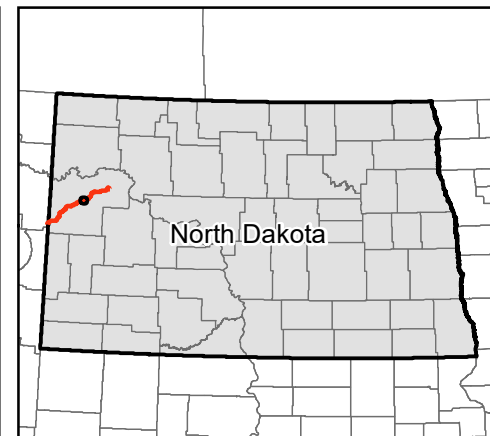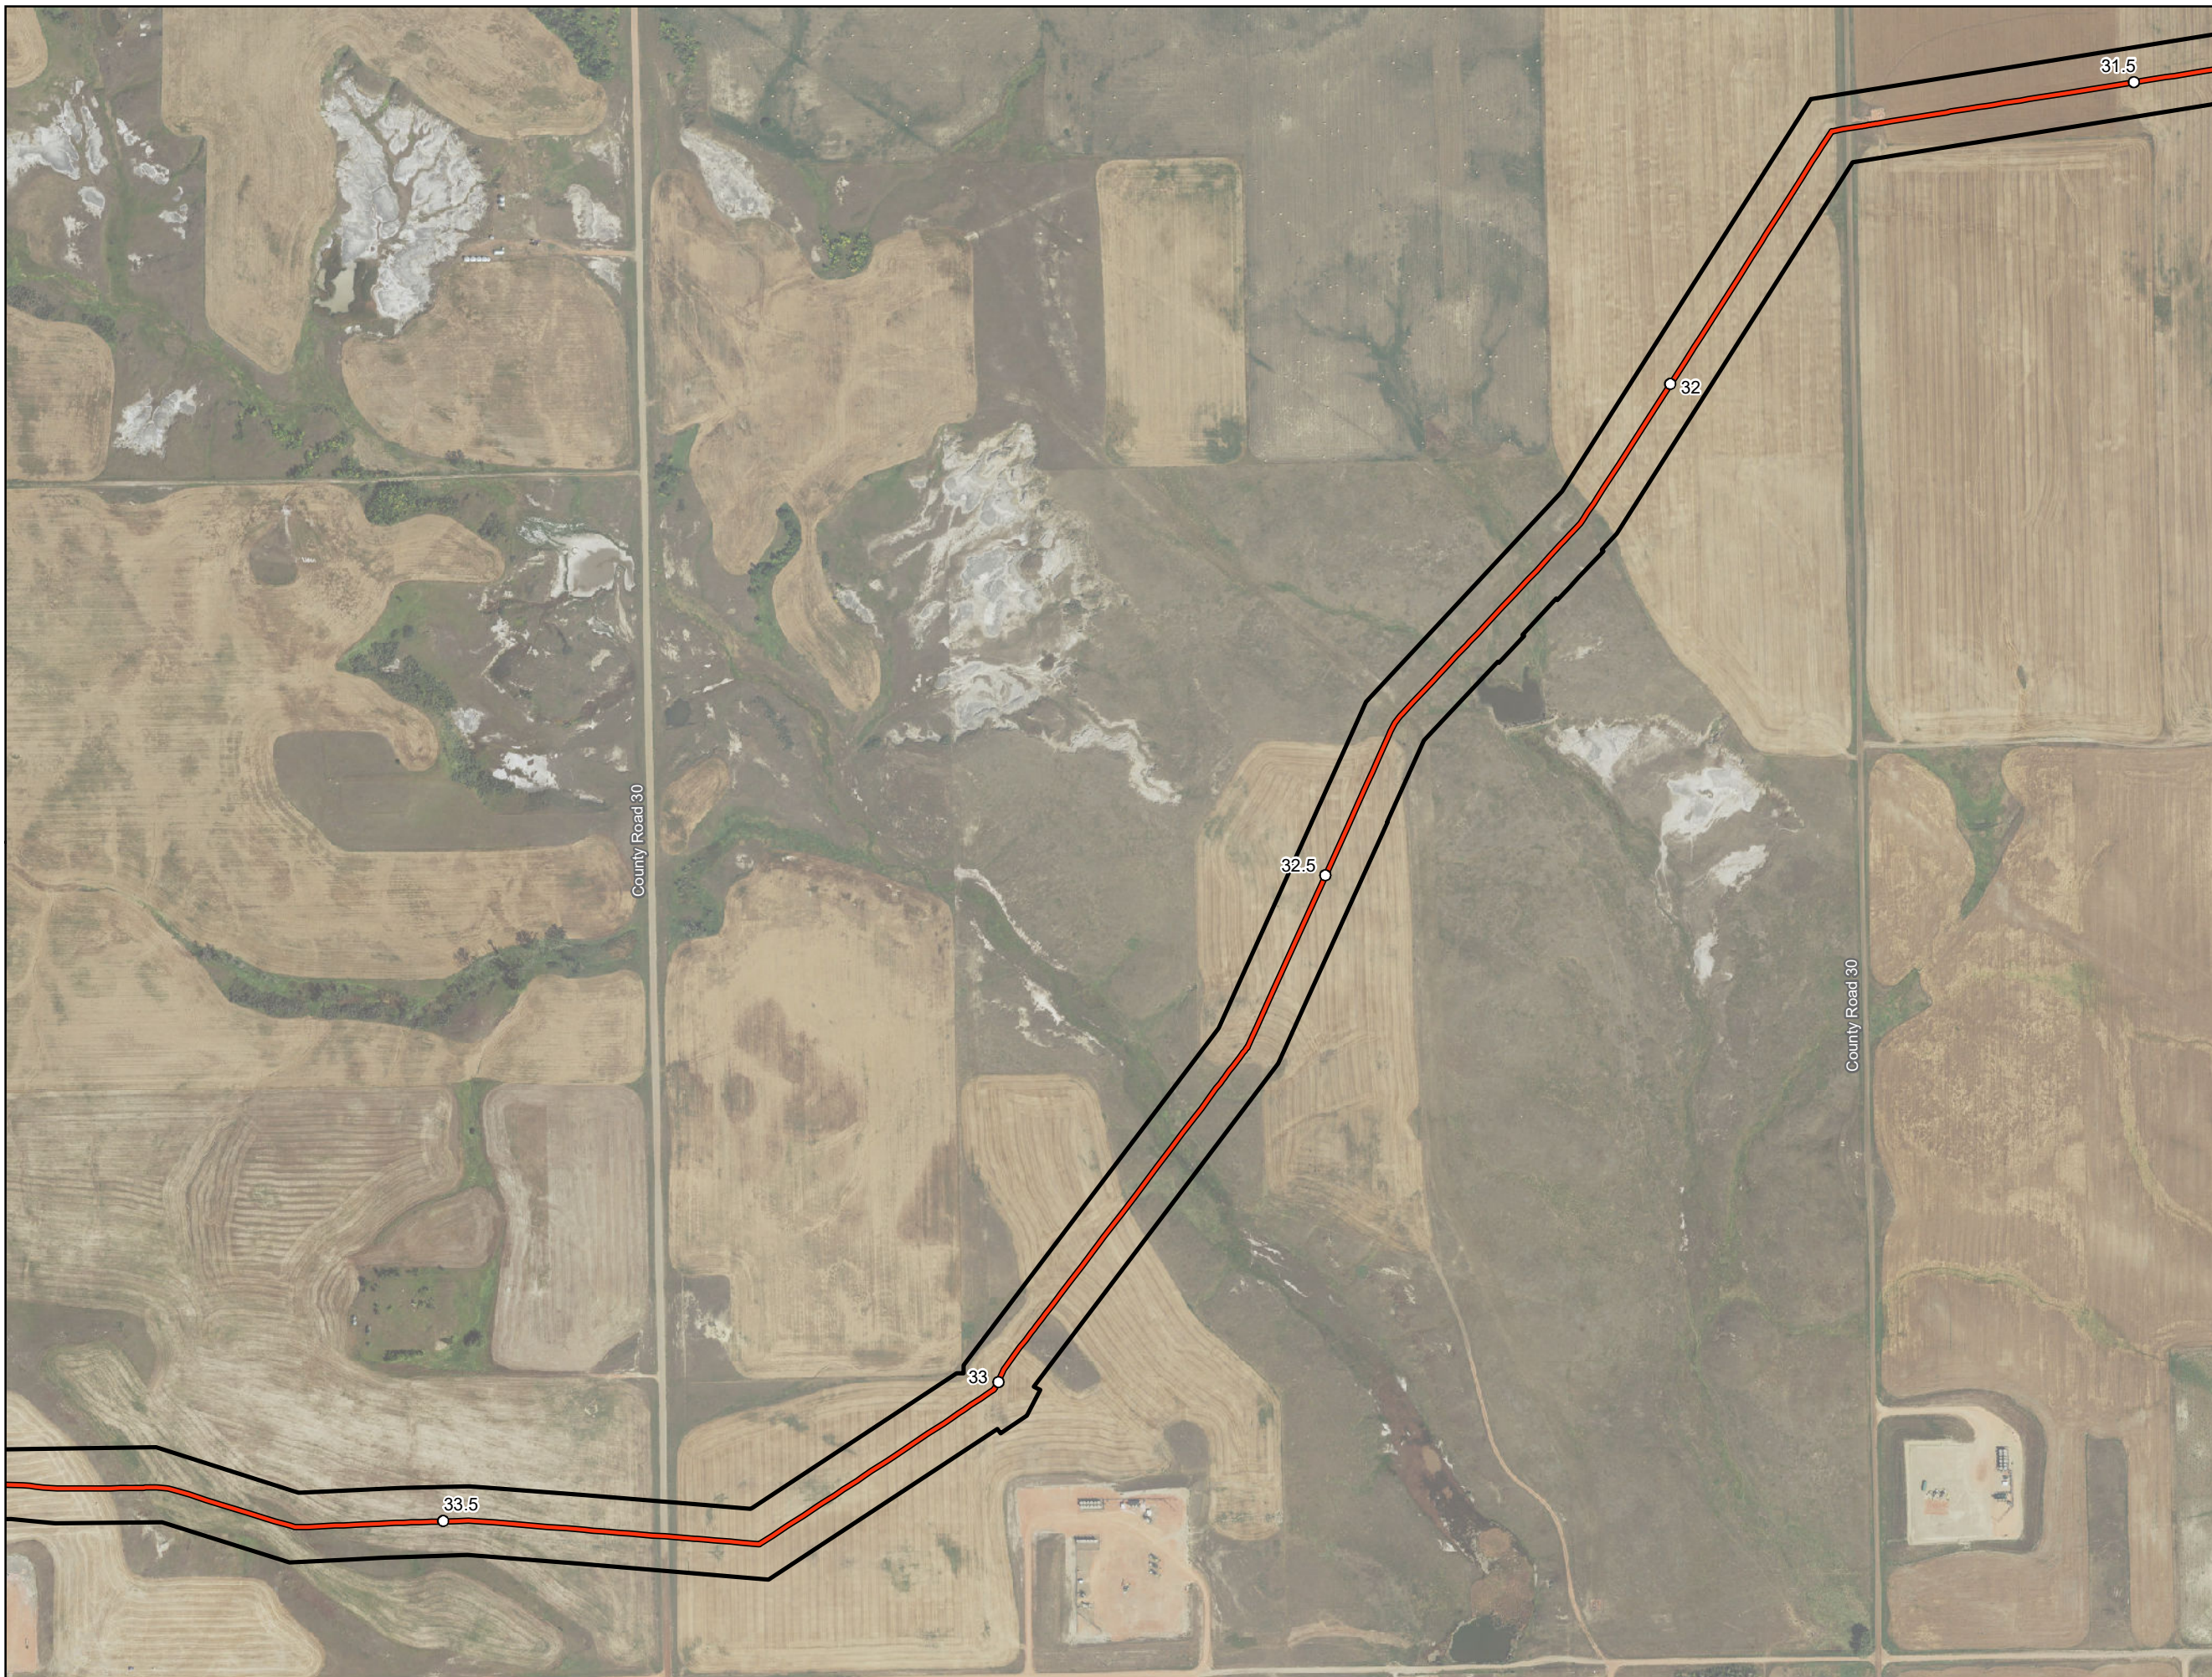

Imagery Source: USDA-FSA-APFO
Photography Field Office, NAIP 2018

- Milepost
- As-Built Centerline
- Project Corridor

**ONEOK Bakken Pipeline, L.L.C.
Demicks Lake Pipeline Project**




**As-Built Centerline and
Certificated Corridor**

Page 17 of 38

McKenzie County, ND



Source: (1/20/2020) Z:\Clients\MLP\Oneok\Demicks_Lake_Pipeline\Permitting\PSC\20200120_As_Built\DLF_PSC_As_Built_Centerline_Maps.mxd

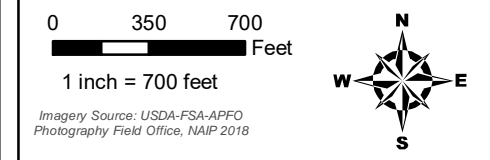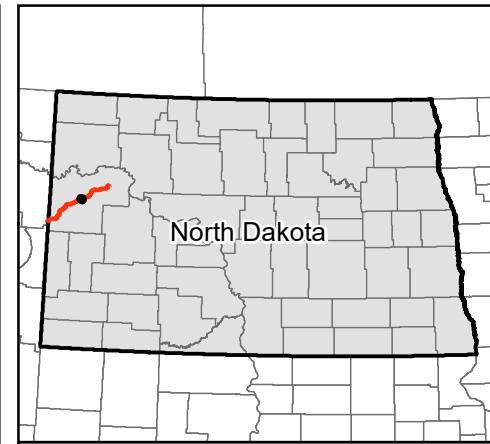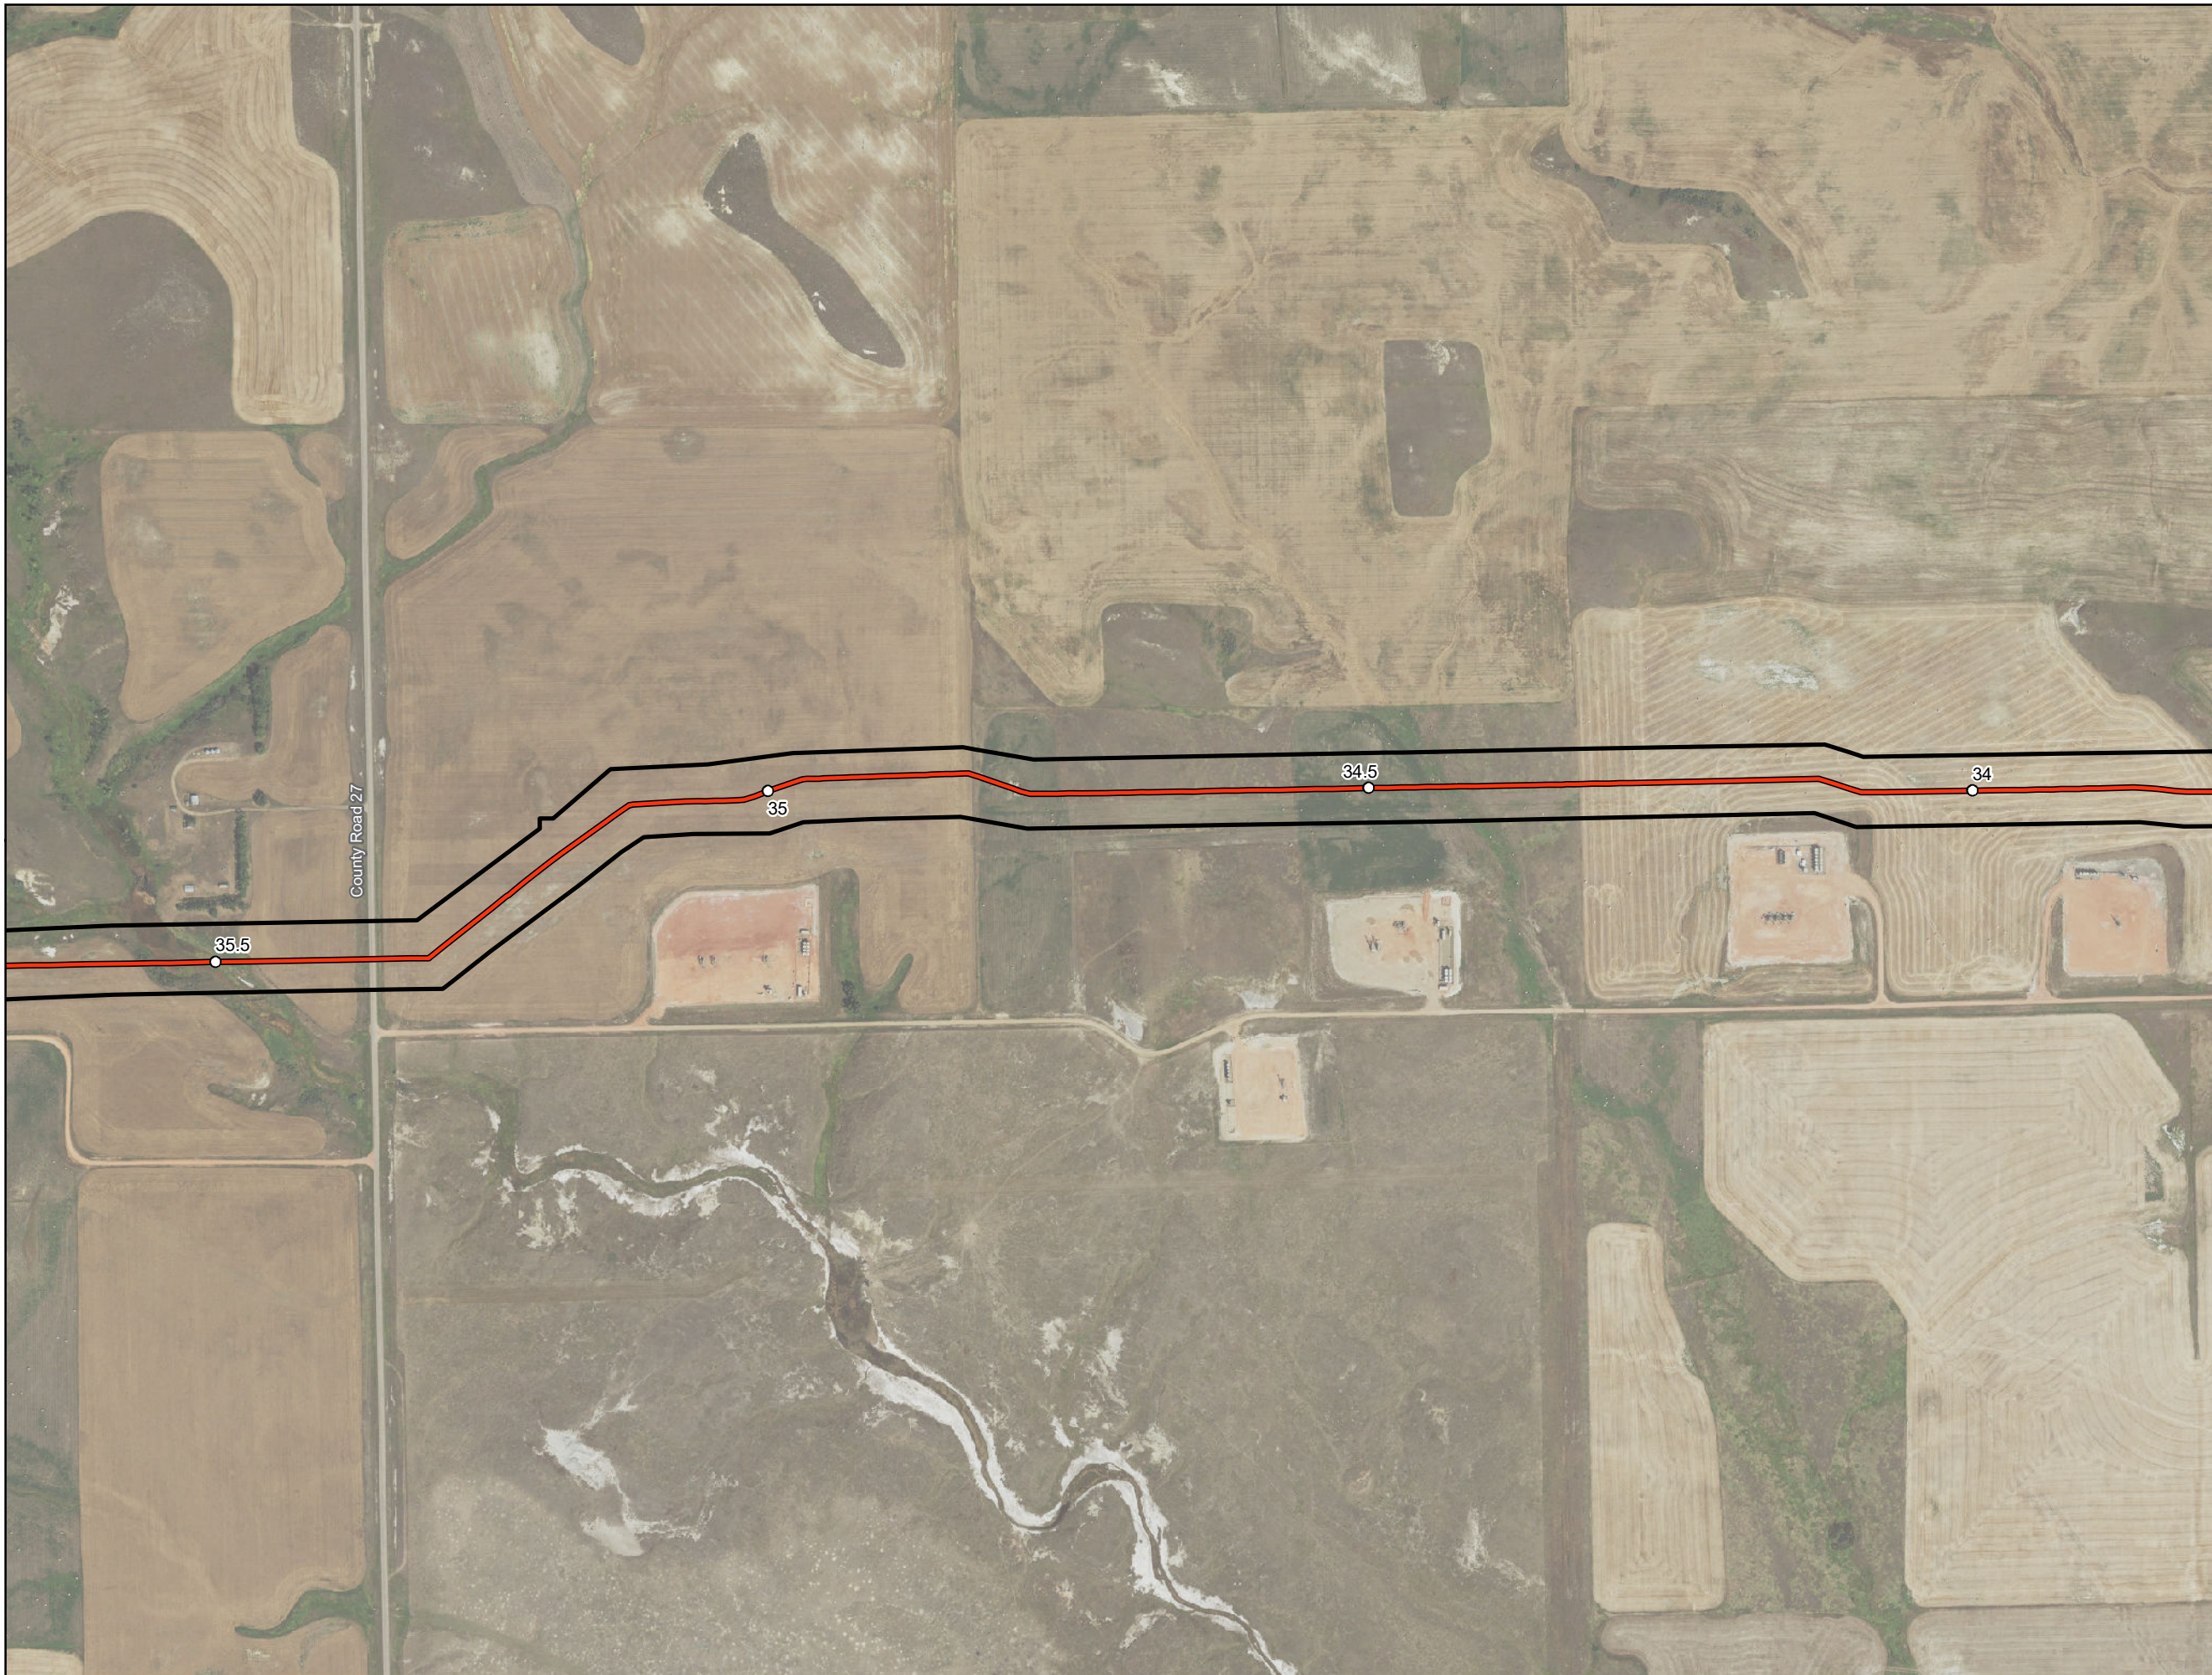

- Milepost
- As-Built Centerline
- Project Corridor

**ONEOK Bakken Pipeline, L.L.C.
Demicks Lake Pipeline Project**




**As-Built Centerline and
Certificated Corridor**

Page 18 of 38

McKenzie County, ND



Date: (1/20/2020) Source: Z:\Clients\MLP\Oneok\Demicks_Lake_Pipeline\Permitting\PSC\20200120_As_Built\DLF_PSC_As_Built_Centerline_Maps.mxd

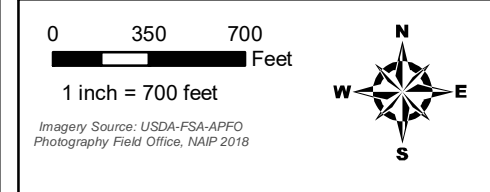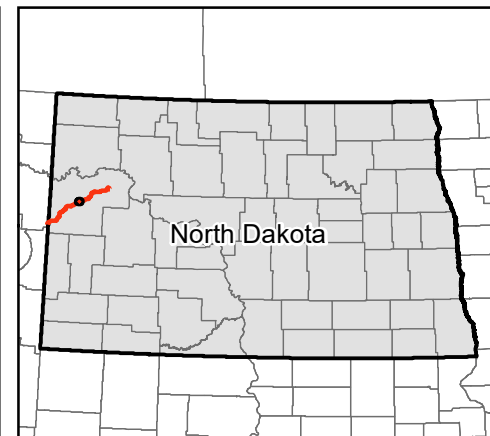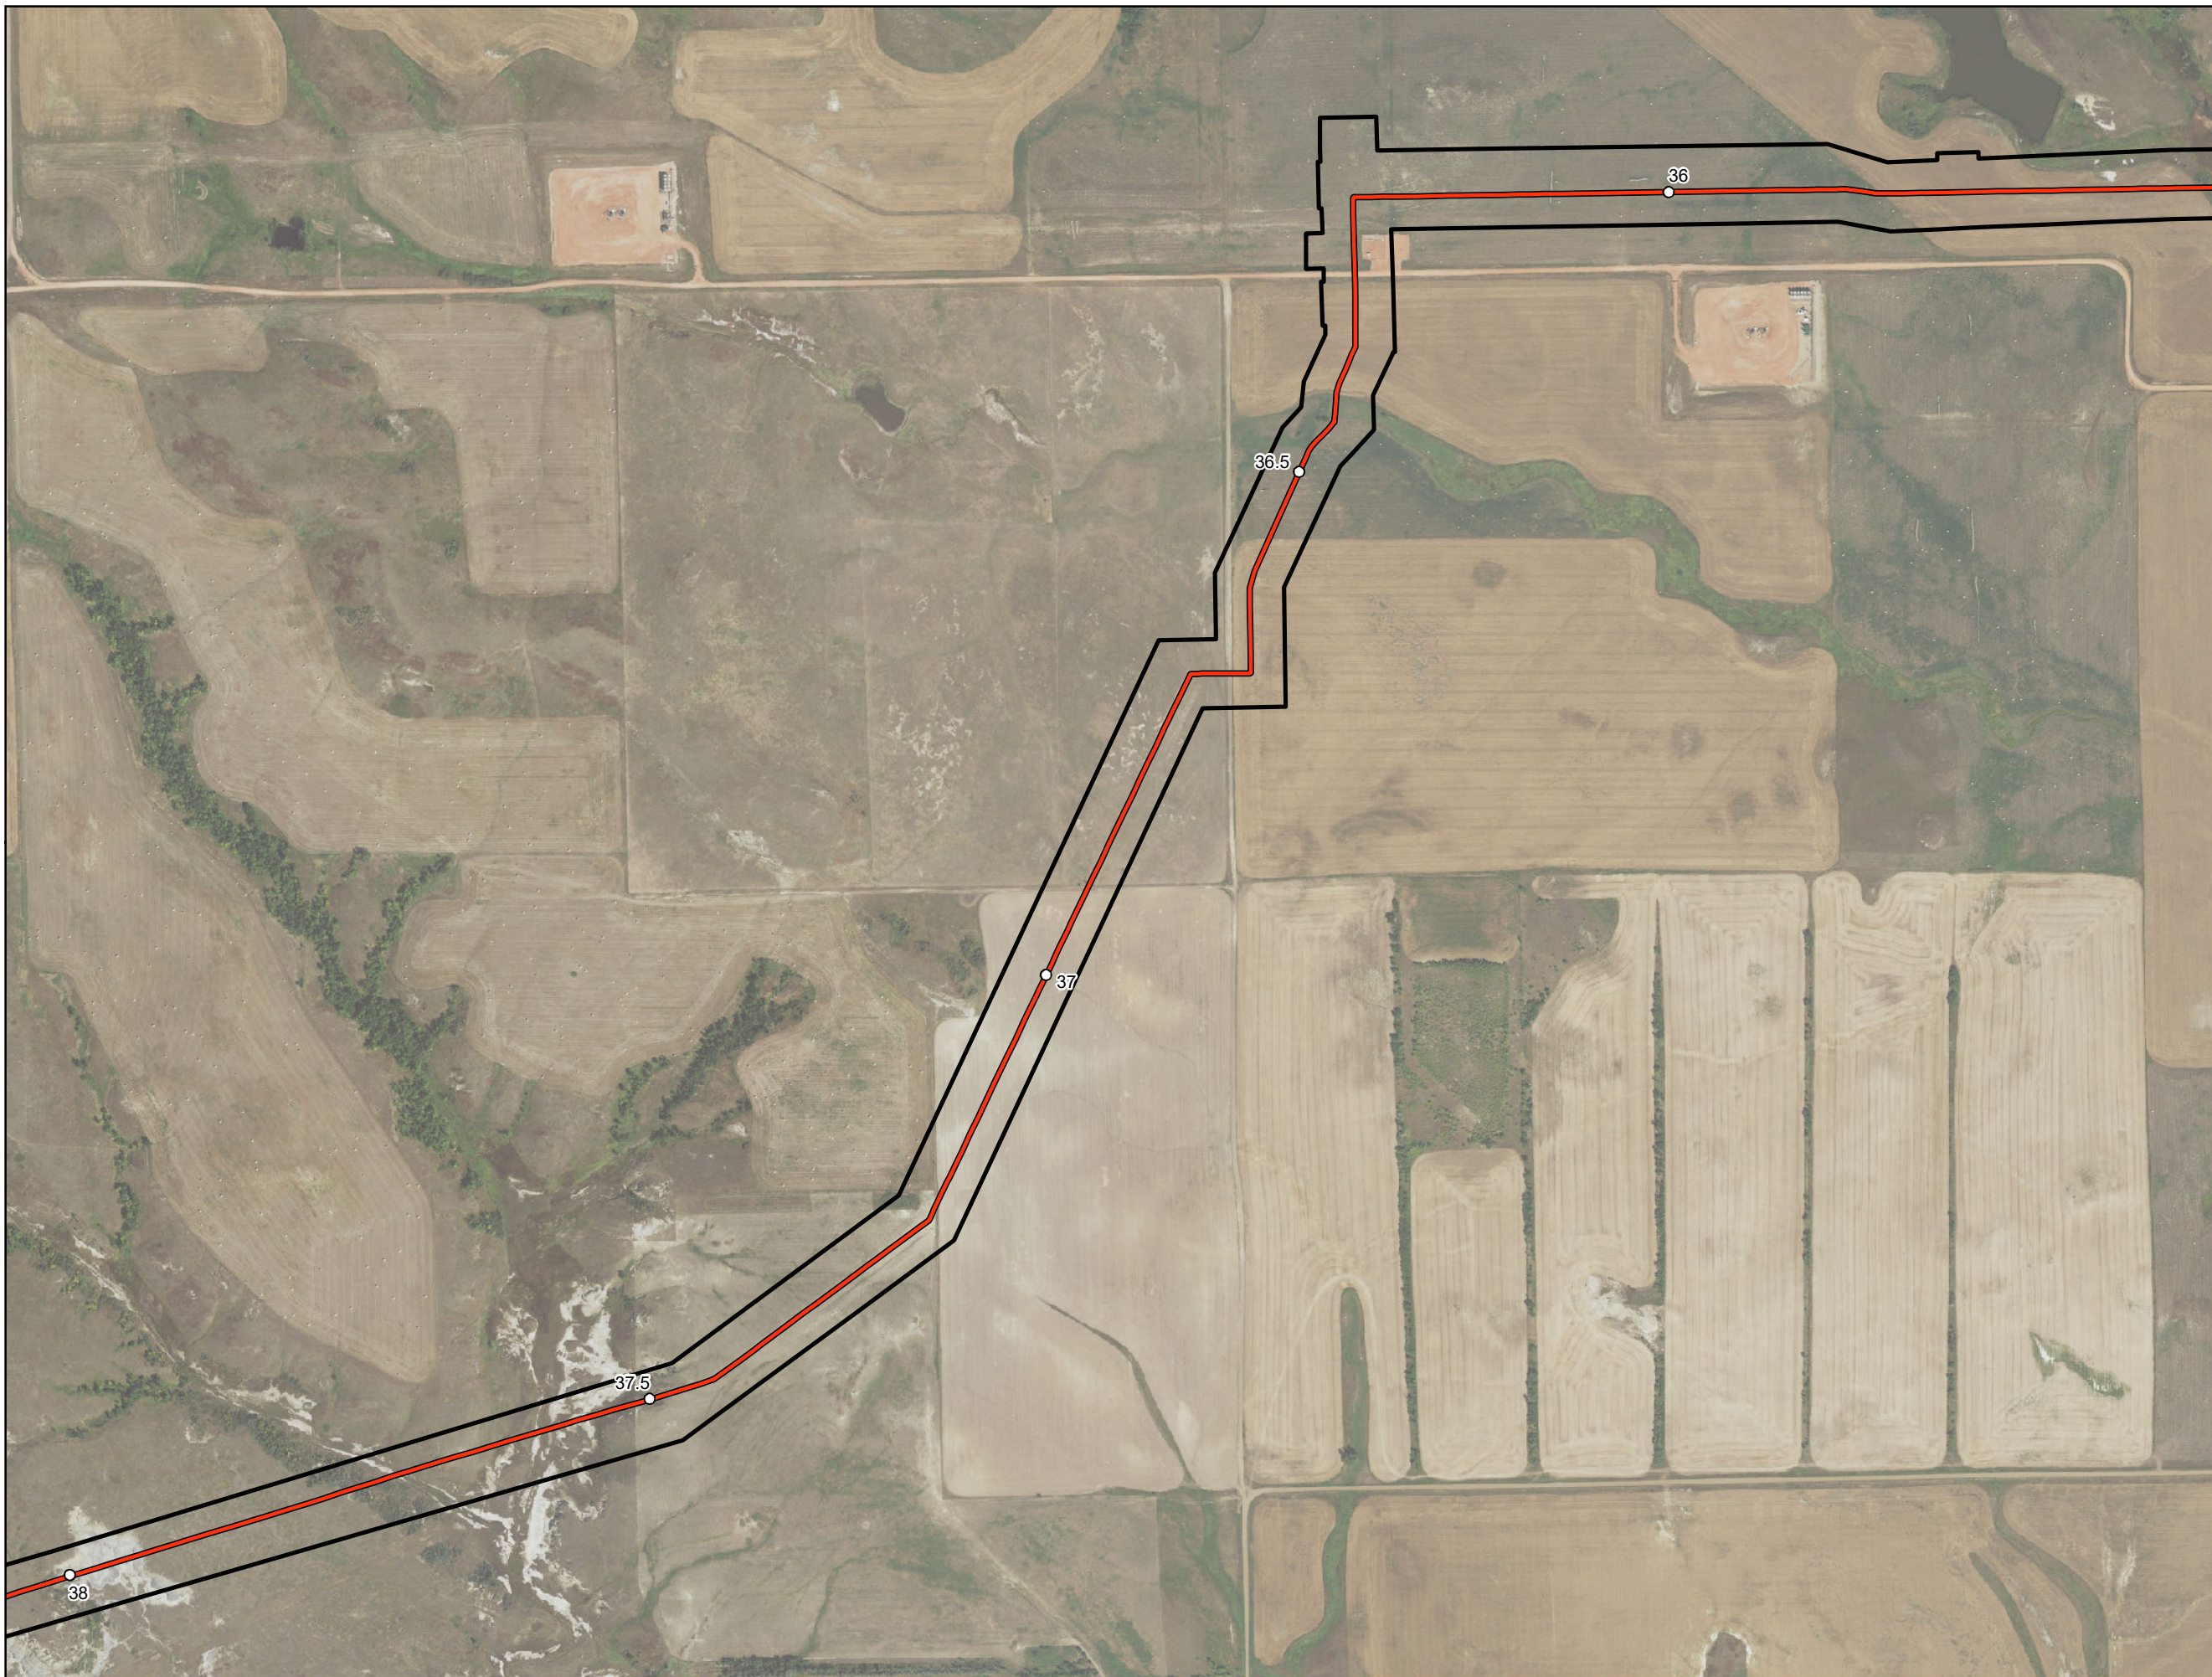

Imagery Source: USDA-FSA-APFO
Photography Field Office, NAIP 2018

- Milepost
- As-Built Centerline
- Project Corridor




**ONEOK Bakken Pipeline, L.L.C.
Demicks Lake Pipeline Project**

**As-Built Centerline and
Certificated Corridor**

Page 19 of 38
McKenzie County, ND



Date: (1/20/2020) Source: Z:\Clients\M_L\Oneok\Demicks_Lake_Pipeline\Permitting\PSC\20200120_As_Built\DLF_PSC_As_Built\Centerline_Maps.mxd

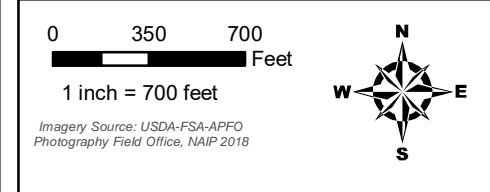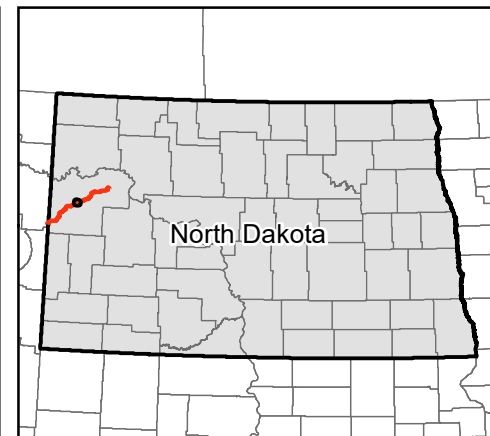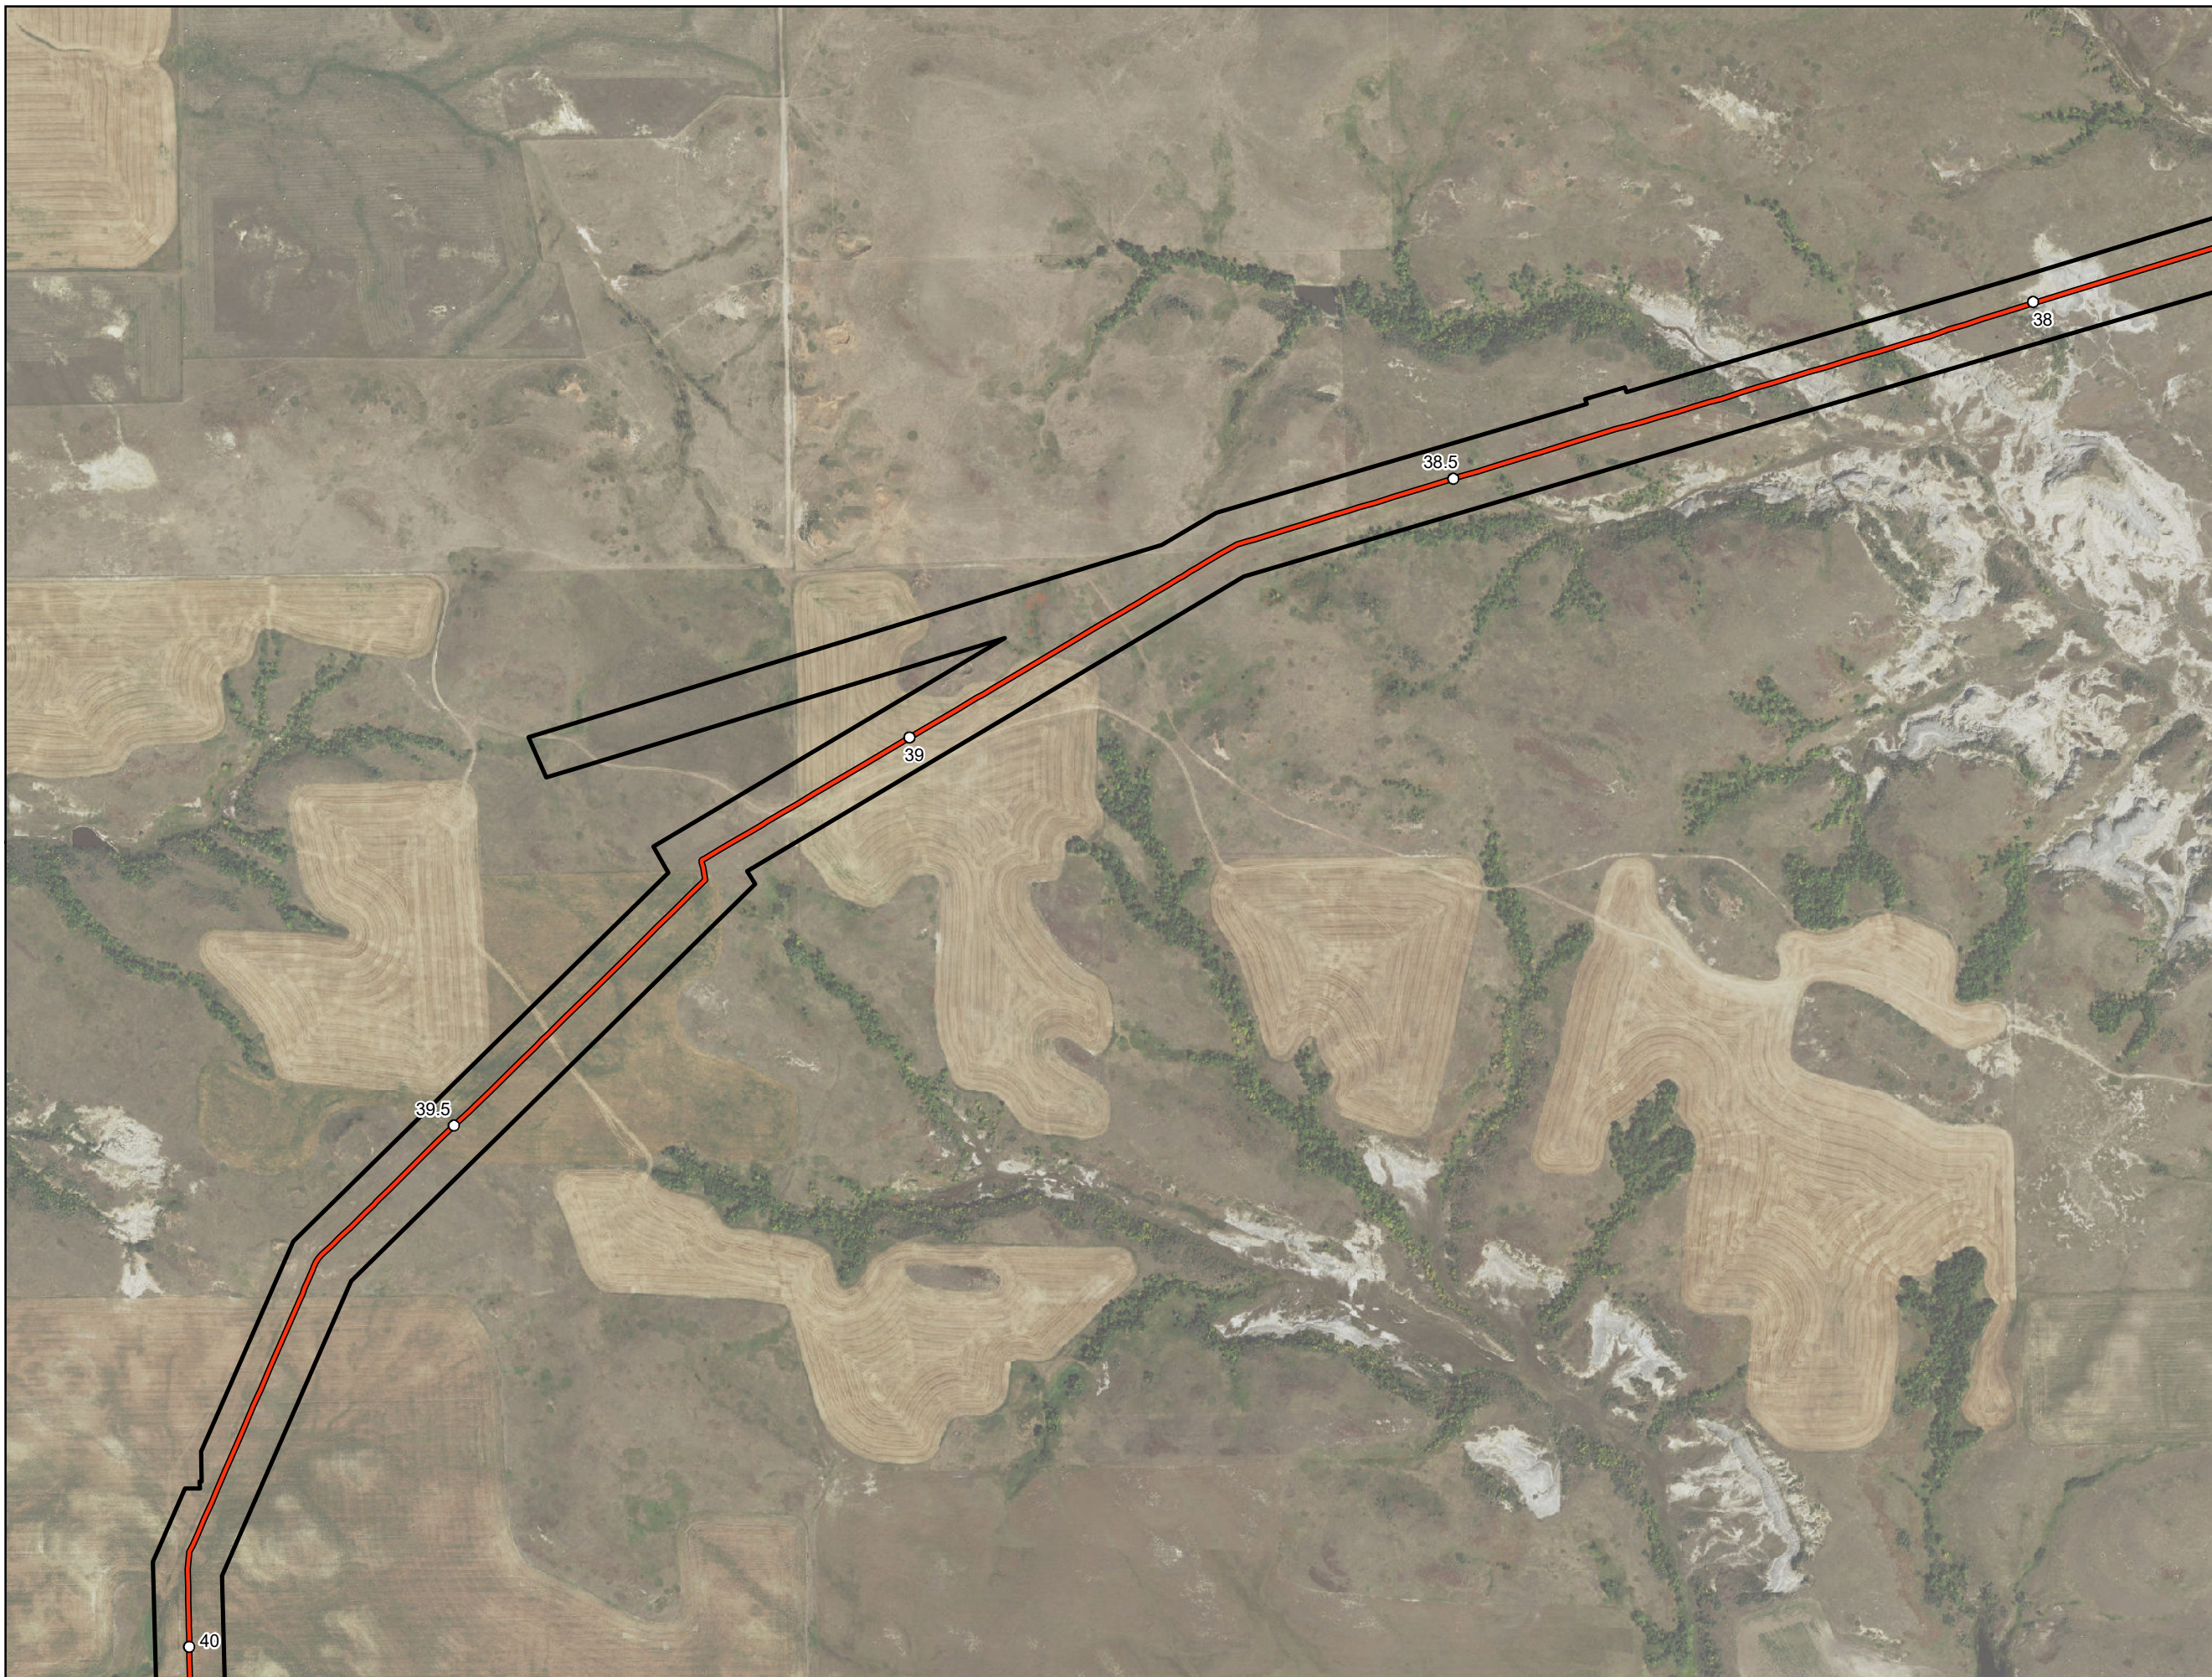




- Milepost
- As-Built Centerline
- Project Corridor

**ONEOK Bakken Pipeline, L.L.C.
Demicks Lake Pipeline Project**

**As-Built Centerline and
Certificated Corridor**

Page 20 of 38
McKenzie County, ND

Source: Z:\Clients\M_L\Oneok\Demicks_Lake_Pipeline\Permitting\PSC\20200120_As_Built\DLF_PSC_As_Built_Centerline_Maps.mxd

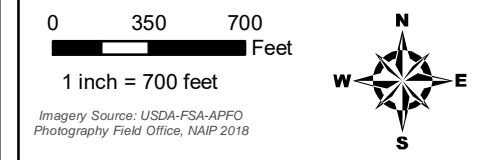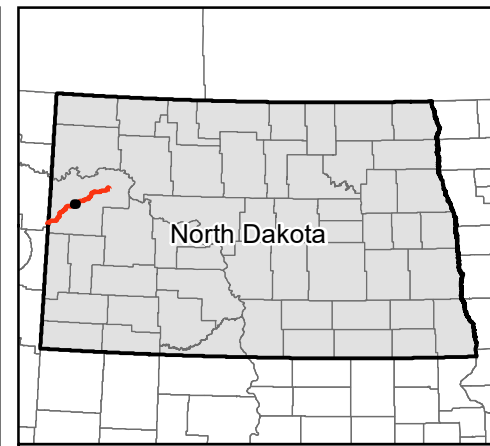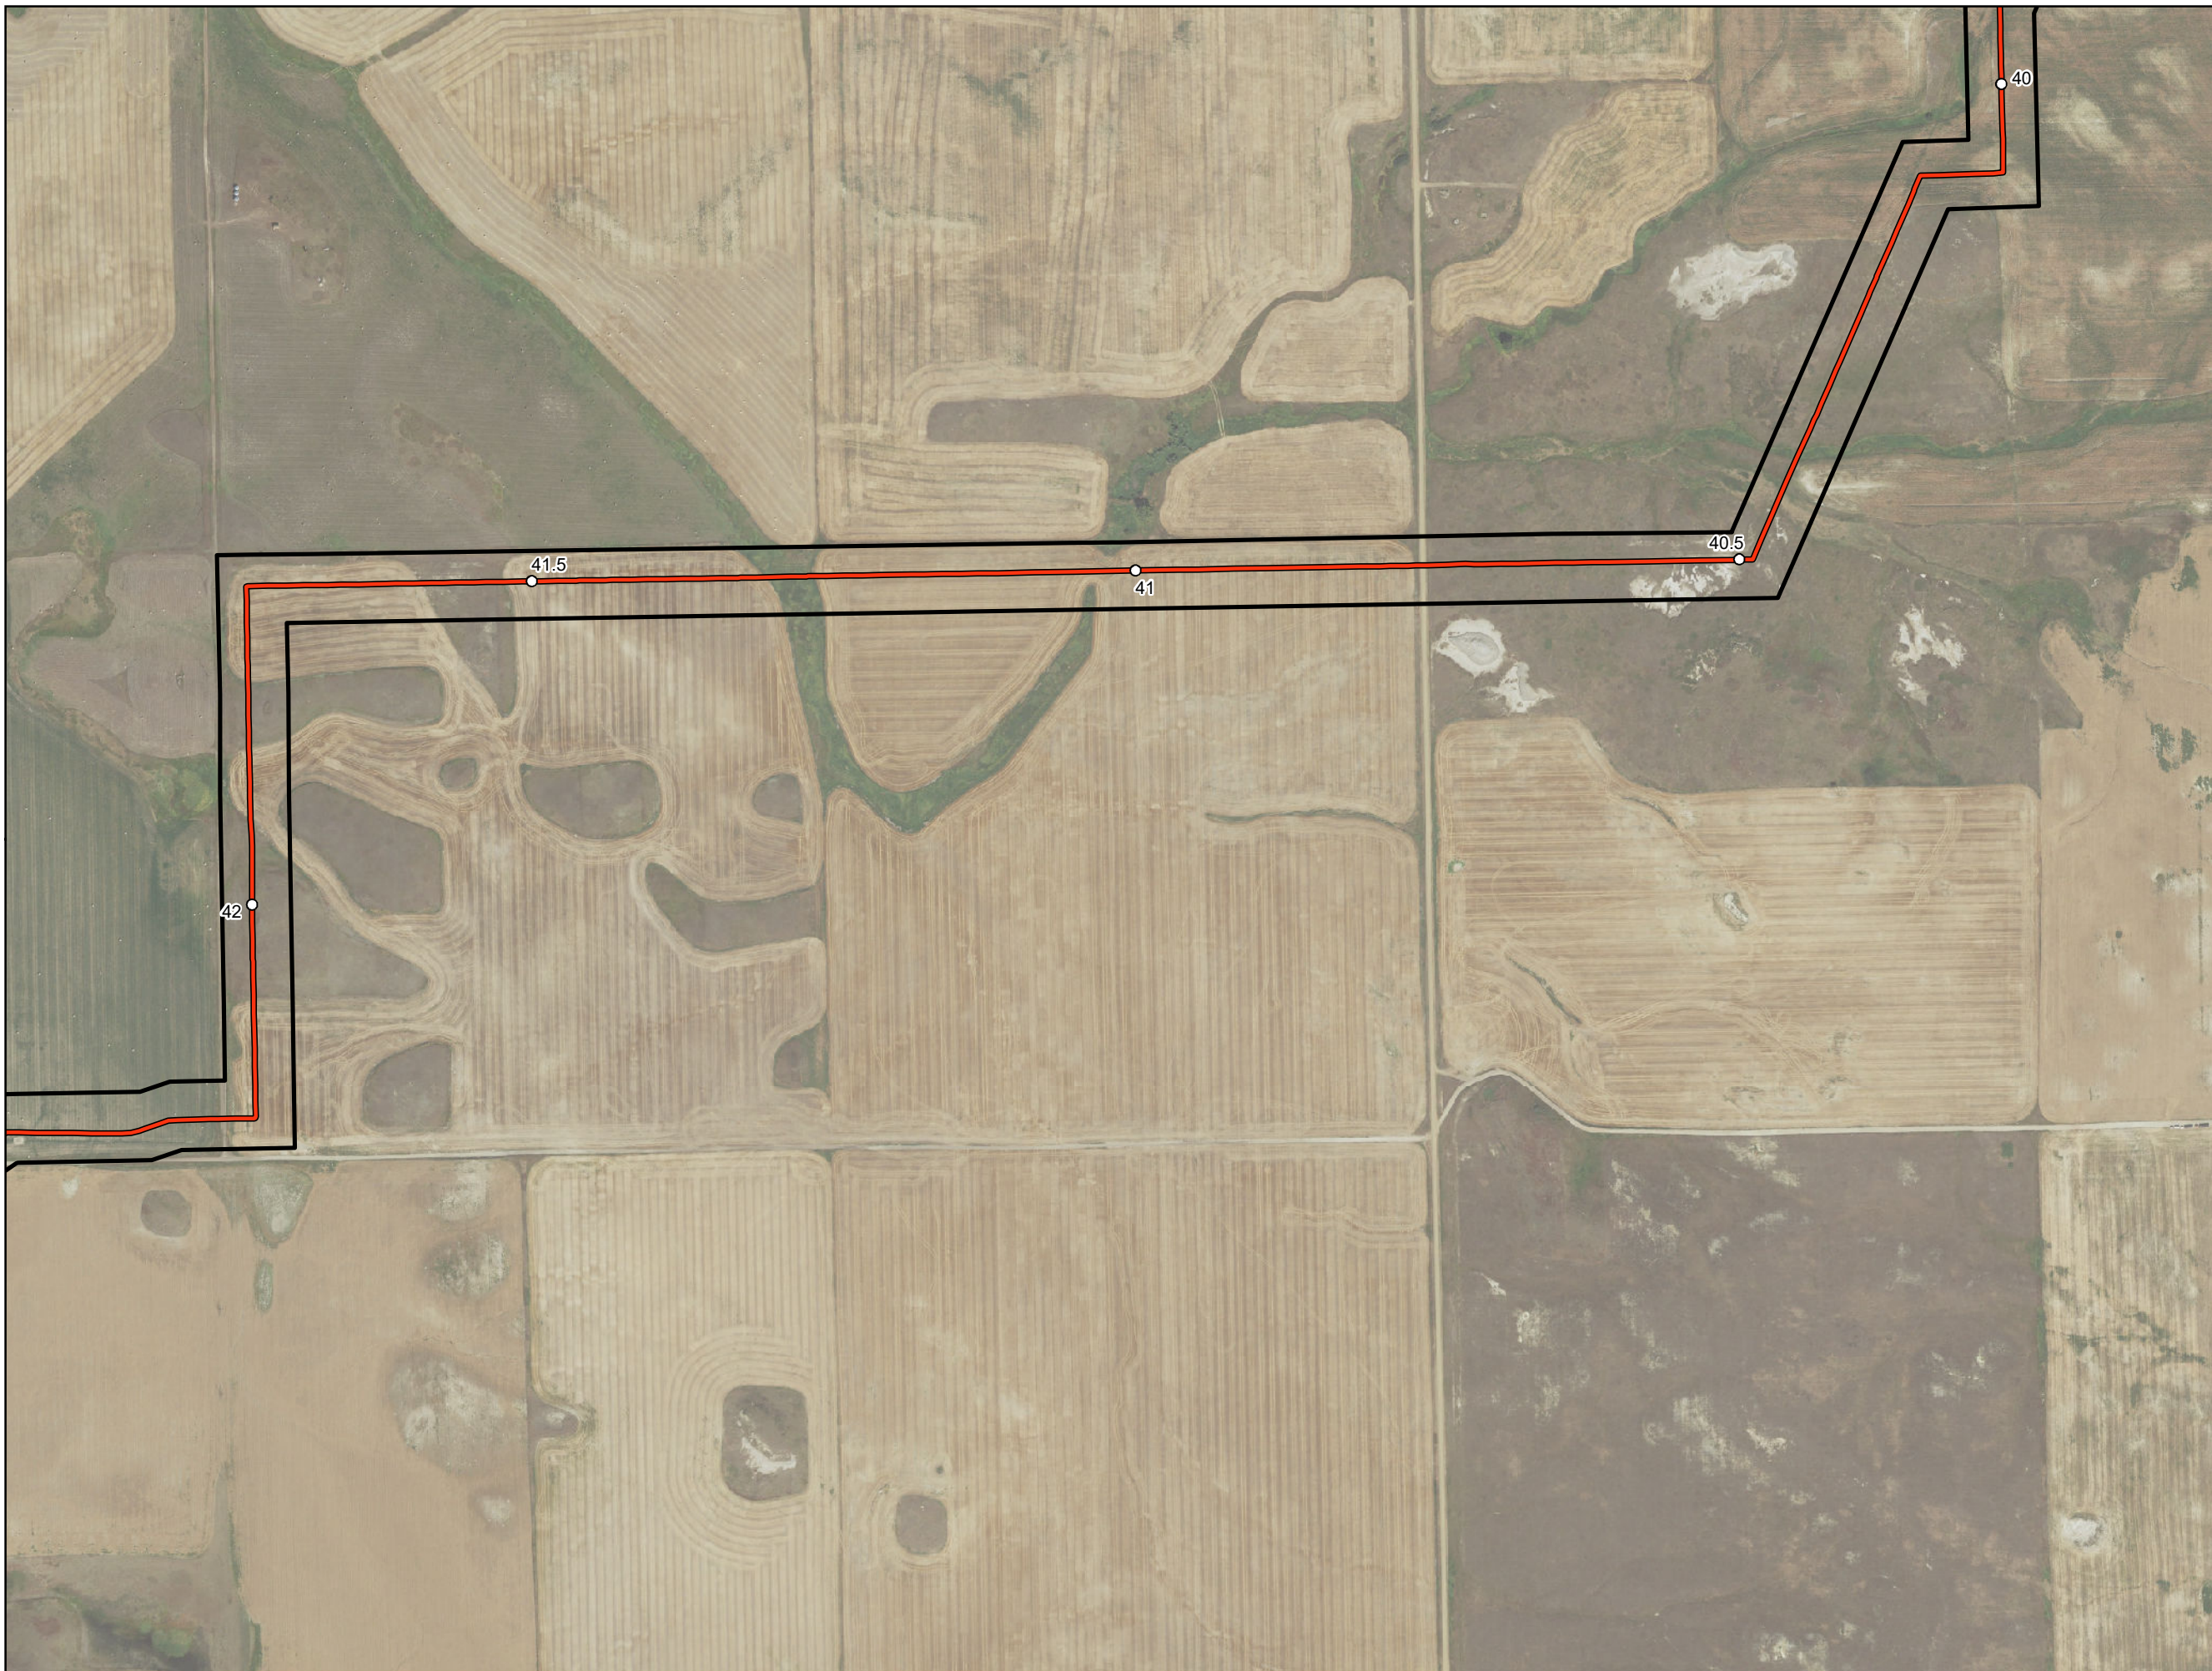

- Milepost
- As-Built Centerline
- Project Corridor




**ONEOK Bakken Pipeline, L.L.C.
Demicks Lake Pipeline Project**

**As-Built Centerline and
Certificated Corridor**

Page 21 of 38
McKenzie County, ND



Date: (1/20/2020) Source: Z:\Clients\M_L\Oneok\Demicks_Lake_Pipeline\Permitting\PSC\20200120_As_Built\DLF_PSC_As_Built_Centerline_Maps.mxd

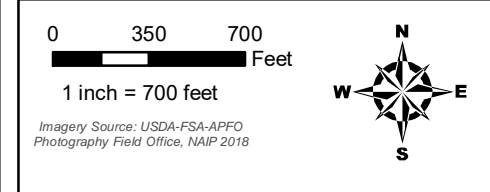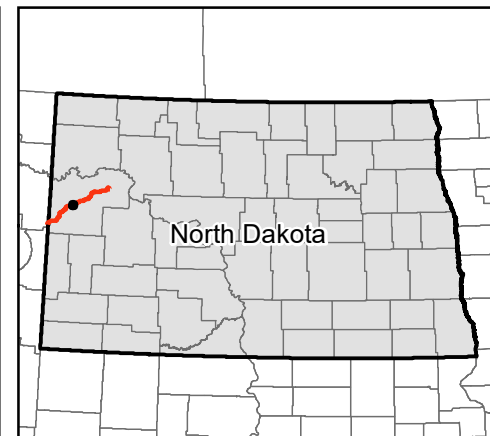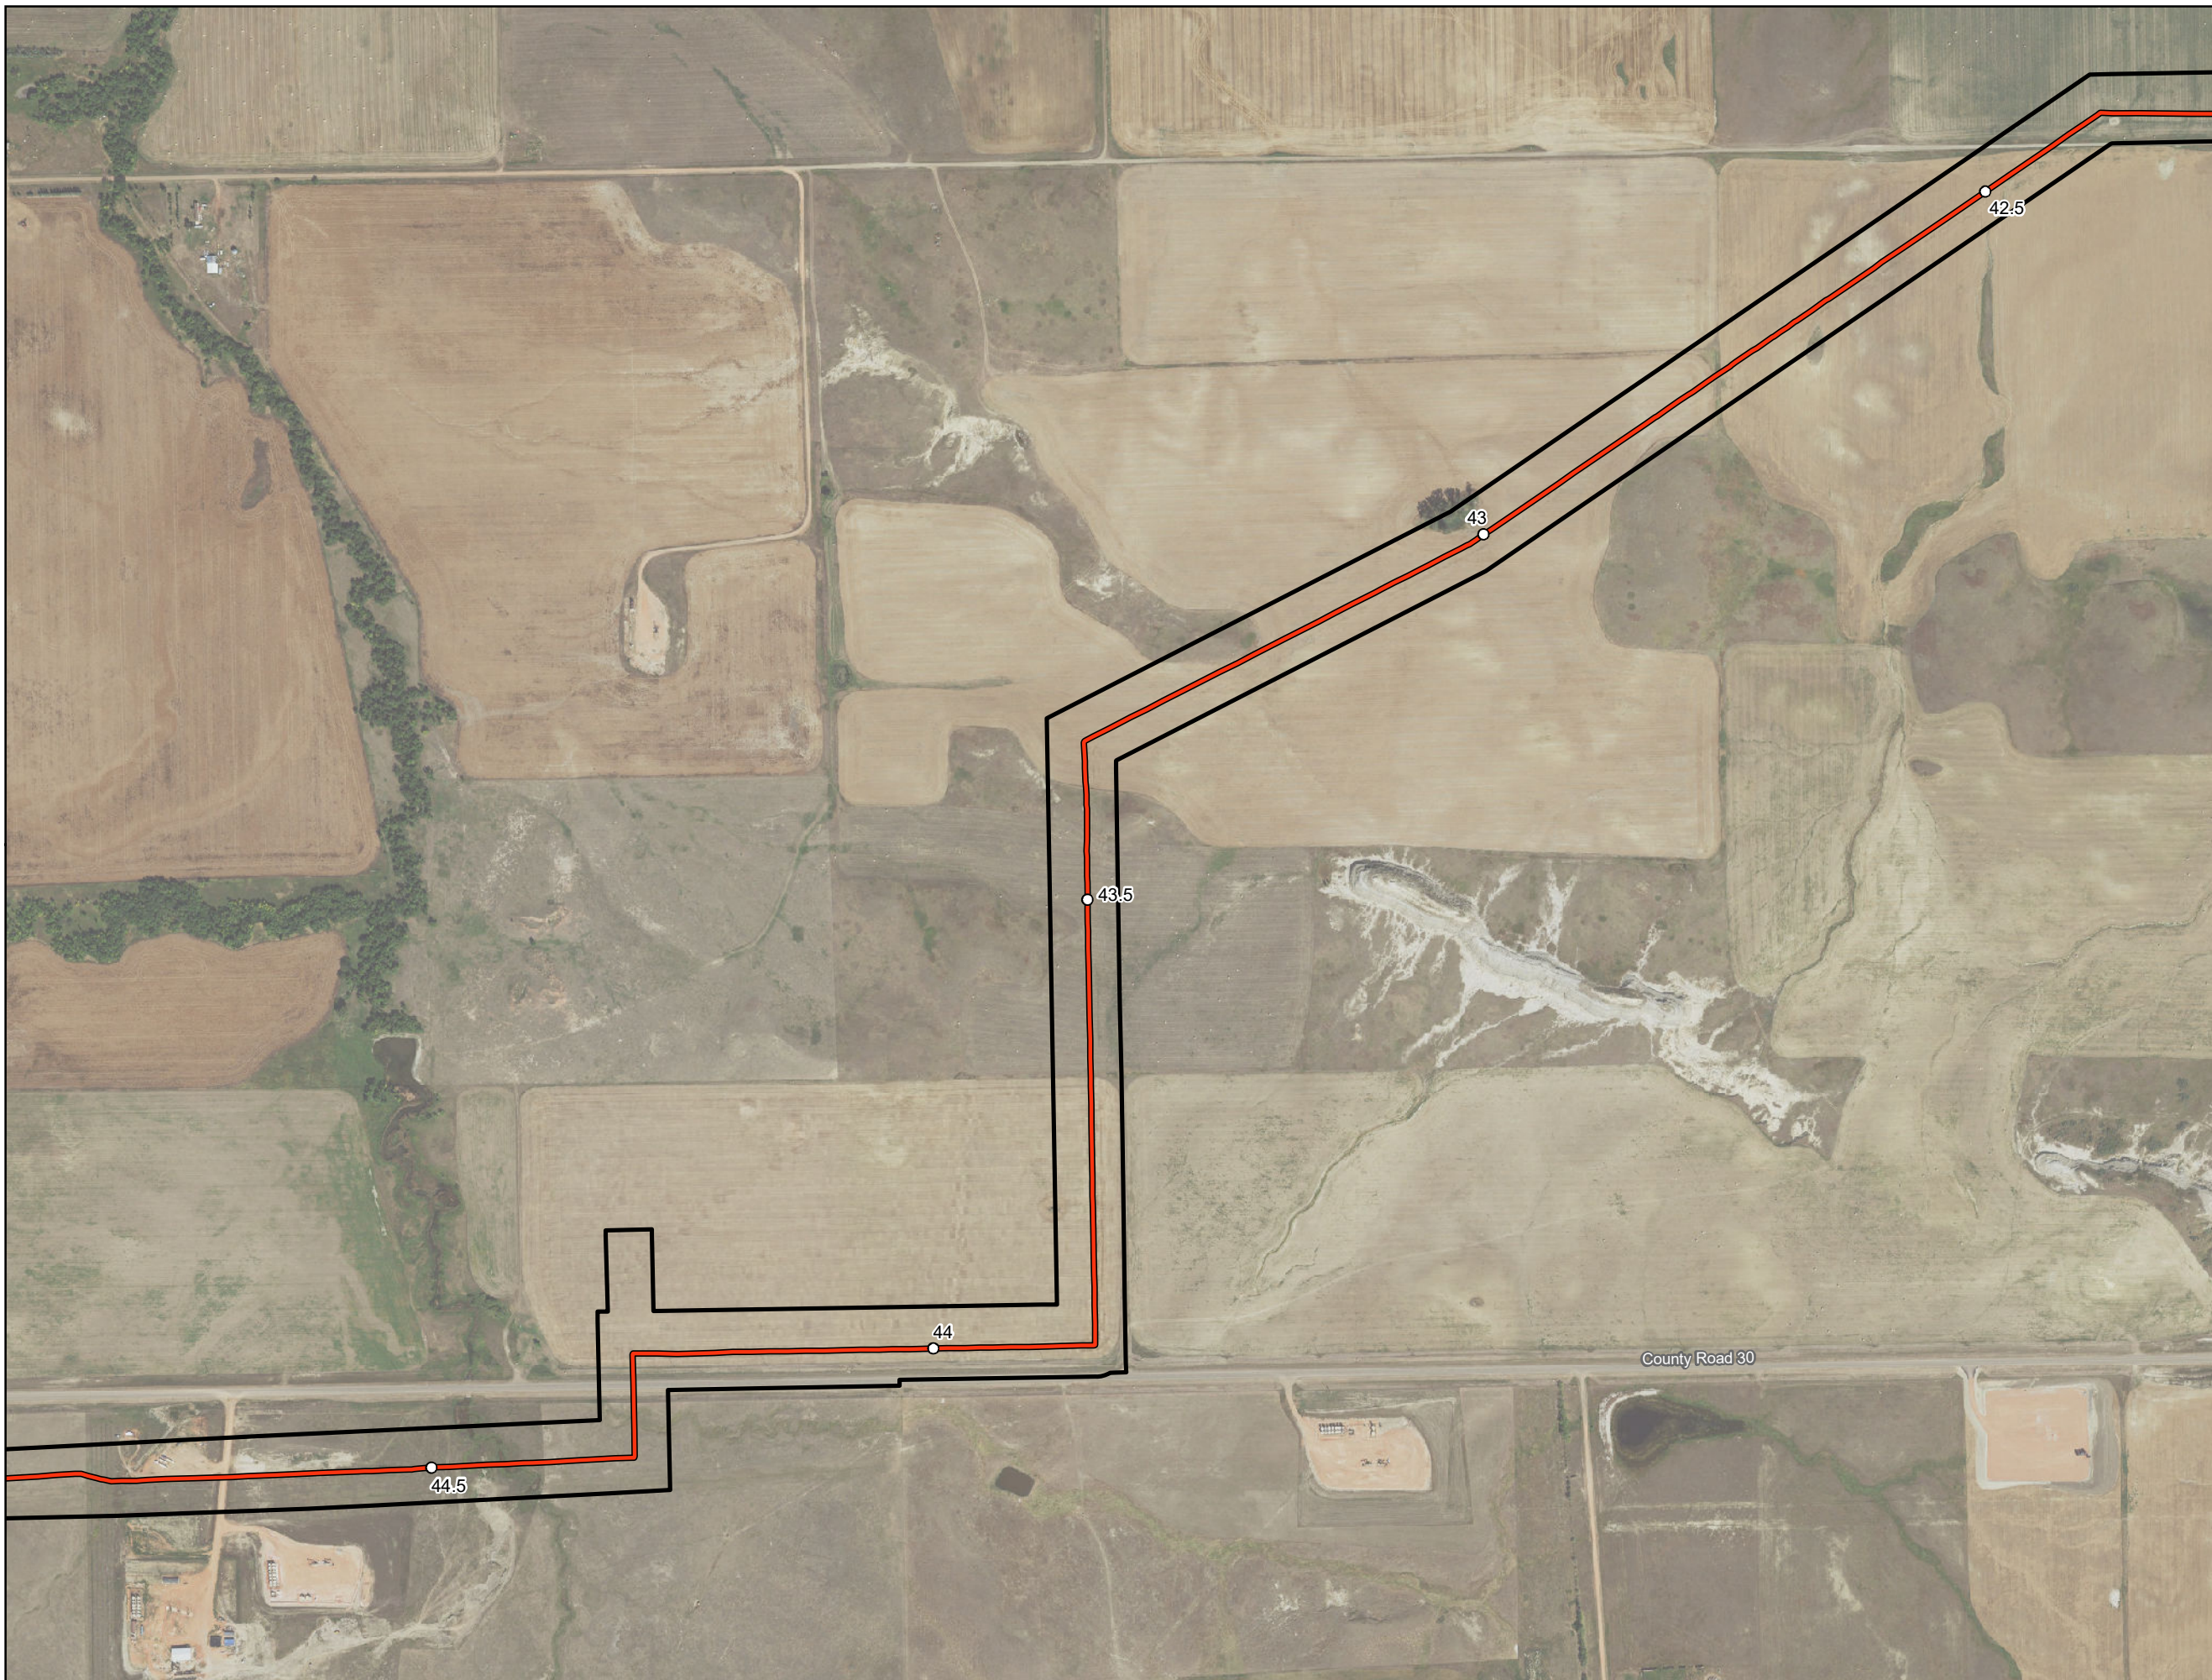

Imagery Source: USDA-FSA-APFO
Photography Field Office, NAIP 2018

- Milepost
- As-Built Centerline
- Project Corridor

**ONEOK Bakken Pipeline, L.L.C.
Demicks Lake Pipeline Project**




**As-Built Centerline and
Certificated Corridor**

Page 22 of 38

McKenzie County, ND



Date: (1/20/2020) Source: Z:\Clients\MLP\Oneok\Demicks_Lake_Pipeline\Permitting\PSC\20200120_As_Built\DLP_PSC_As_Built_Centerline_Maps.mxd

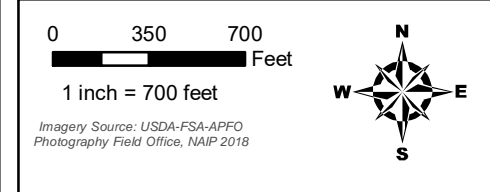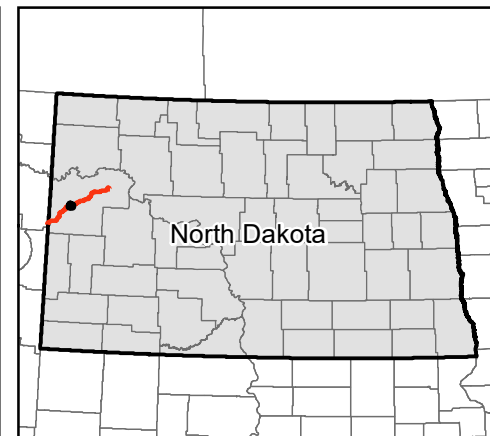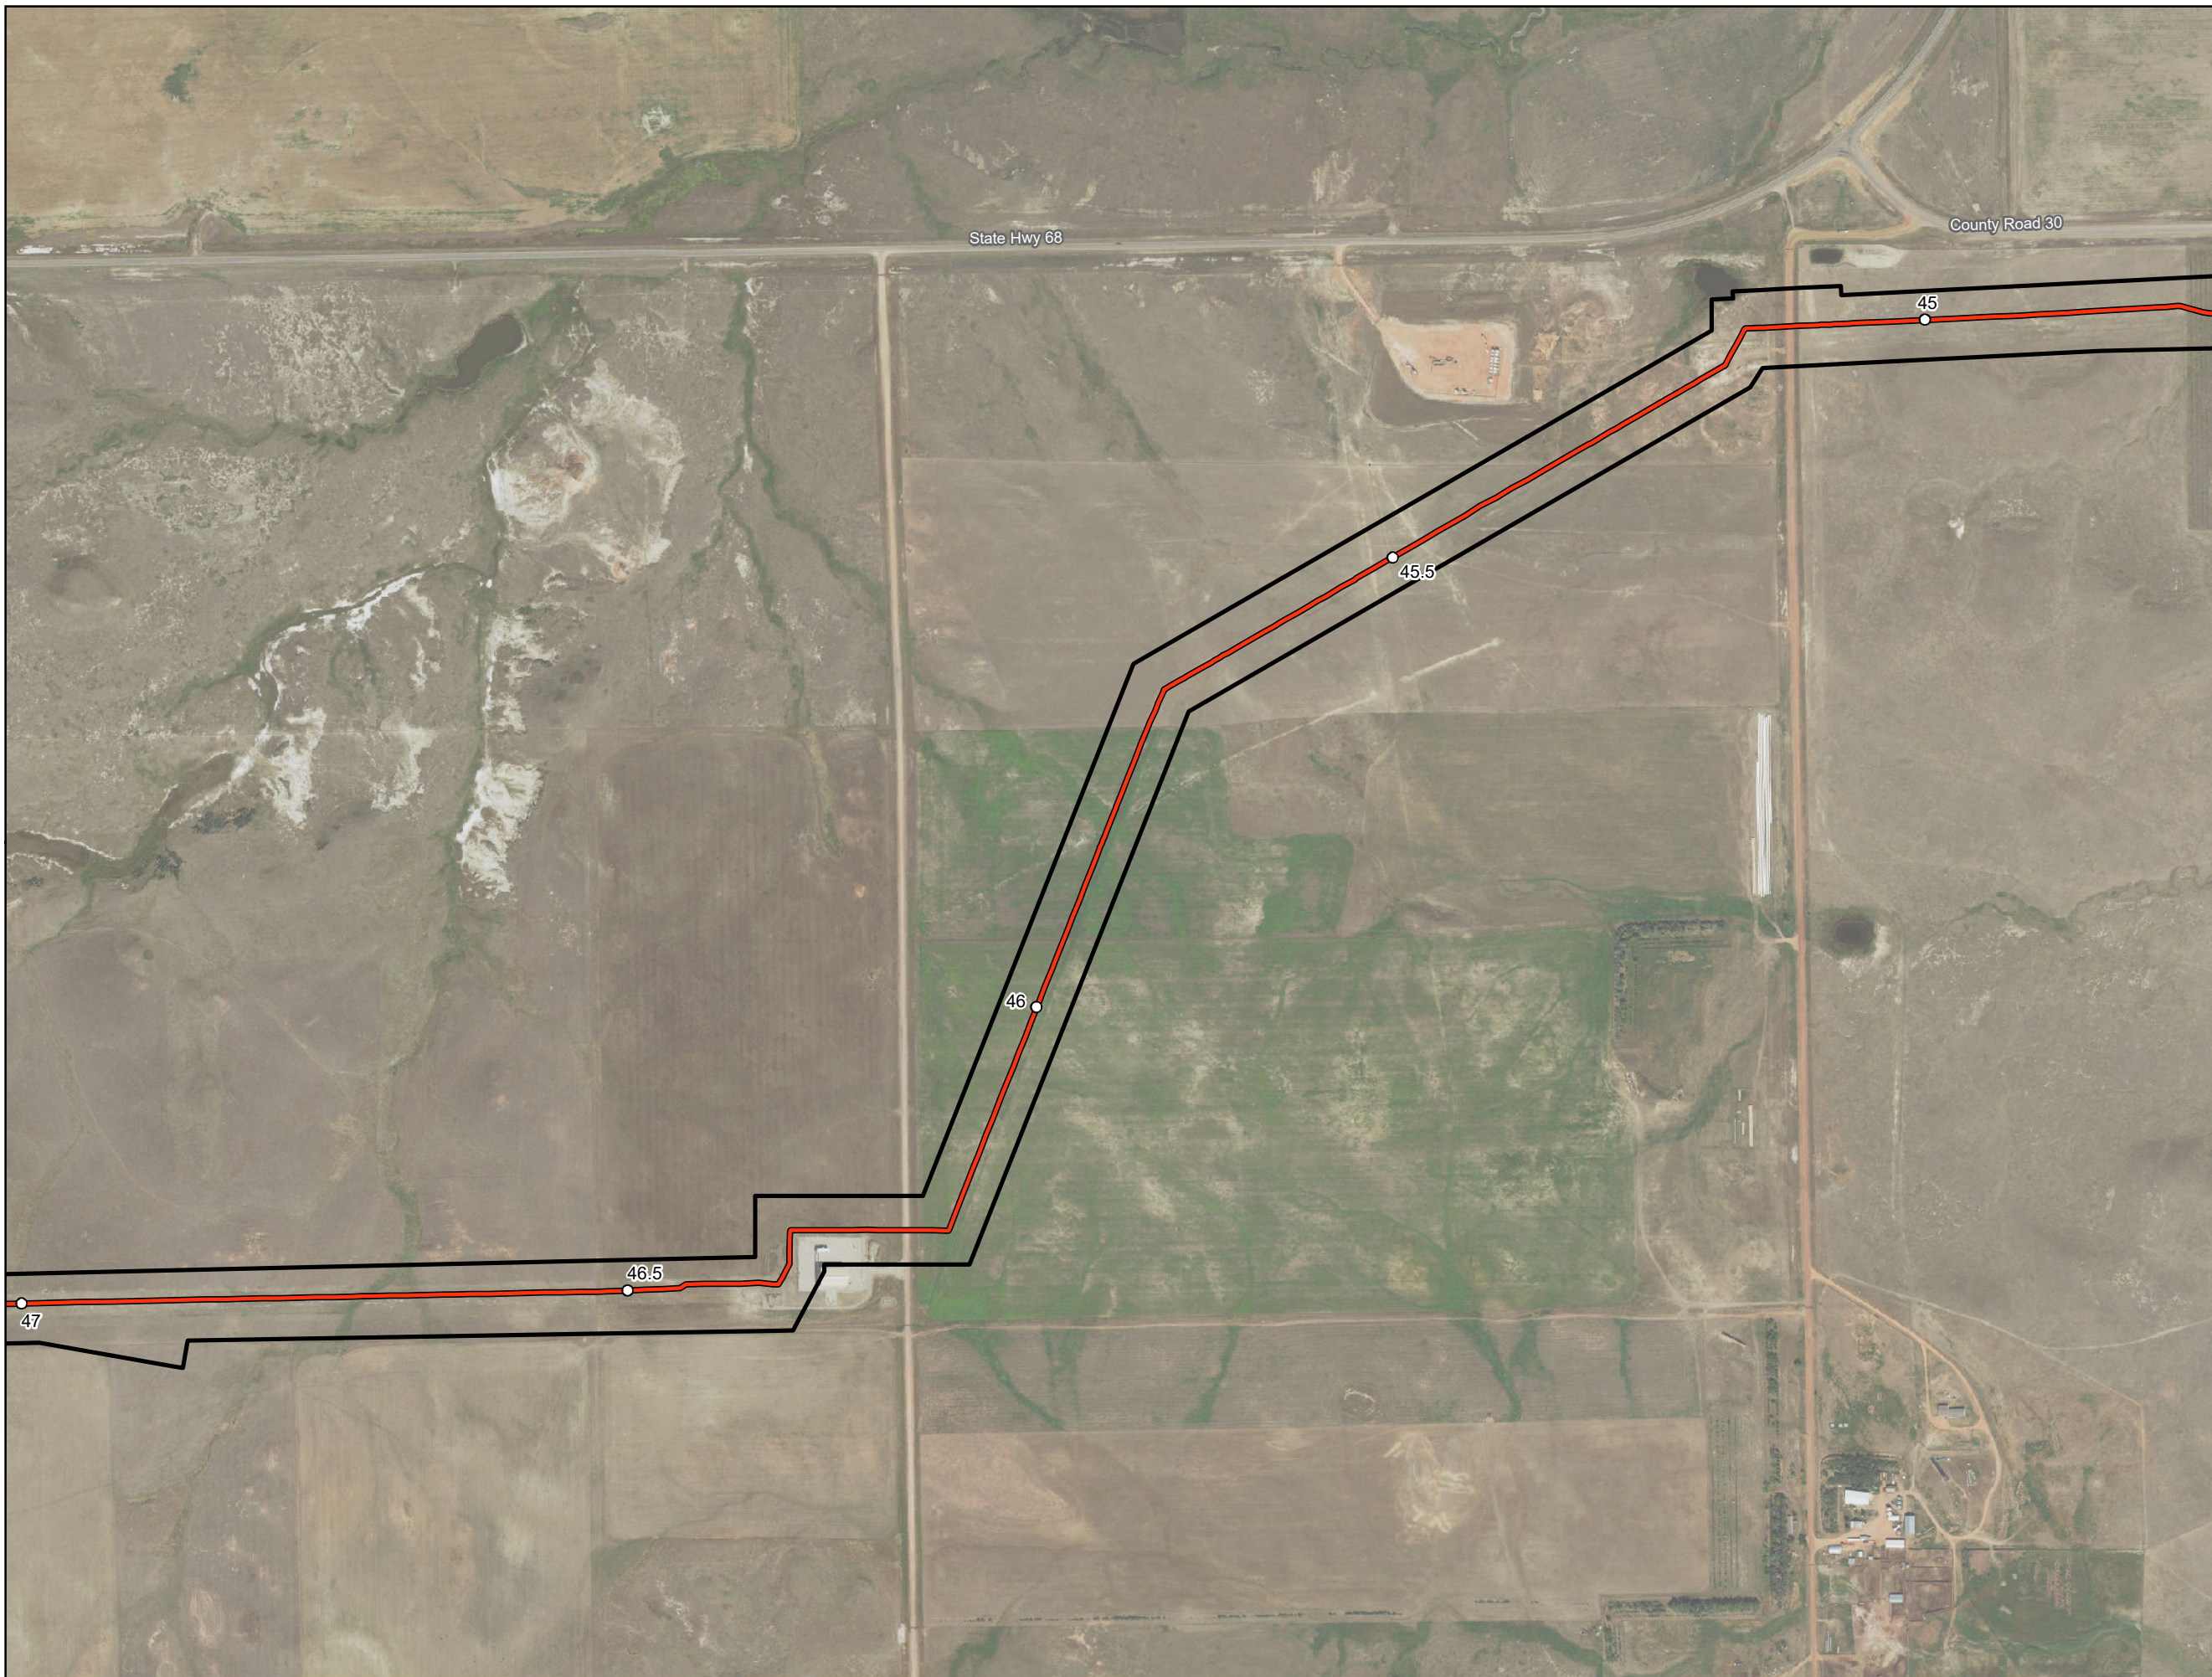

- Milepost
- As-Built Centerline
- Project Corridor

**ONEOK Bakken Pipeline, L.L.C.
Demicks Lake Pipeline Project**



**As-Built Centerline and
Certificated Corridor**

Page 23 of 38

McKenzie County, ND



Date: (1/20/2020) Source: Z:\Clients\M_P\Oneok\Demicks_Lake_Pipeline\Permitting\FSC\20200120_As_Built\DLF_PSC_As_Built_Centerline_Maps.mxd

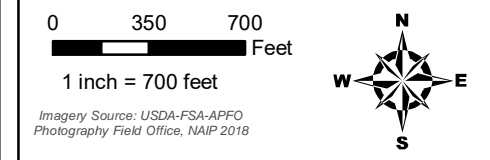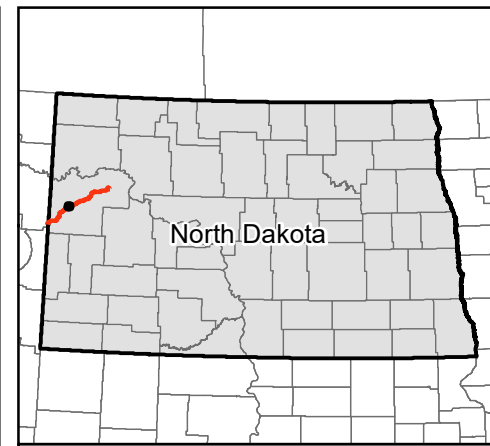

Imagery Source: USDA-FSA-APFO
Photography Field Office, NAIP 2018

- Milepost
- As-Built Centerline
- Project Corridor

**ONEOK Bakken Pipeline, L.L.C.
Demicks Lake Pipeline Project**



**As-Built Centerline and
Certificated Corridor**

Page 24 of 38

McKenzie County, ND



Source: Z:\Clients\MLP\Oneok\Demicks_Lake_Pipeline\Permitting\FSC\20200120_As_Built\DLF_PSC_As_Built_Centerline_Maps.mxd

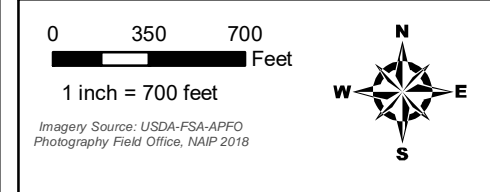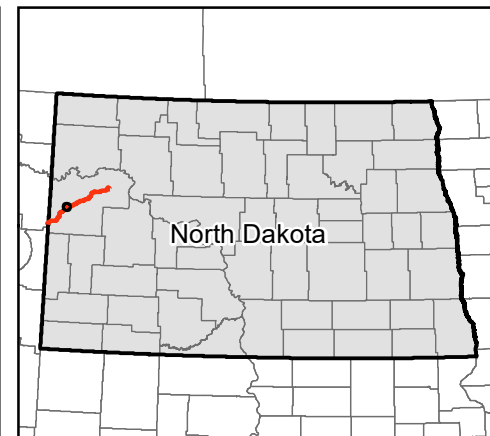

- Milepost
- As-Built Centerline
- Project Corridor



**ONEOK Bakken Pipeline, L.L.C.
Demicks Lake Pipeline Project**

**As-Built Centerline and
Certificated Corridor**

Page 25 of 38
McKenzie County, ND



Date: (1/20/2020) Source: Z:\Clients\M_L\Oneok\Demicks_Lake_Pipeline\Permitting\FSC\20200120_As_Built\DLF_PSC_As_Built_Centerline_Maps.mxd

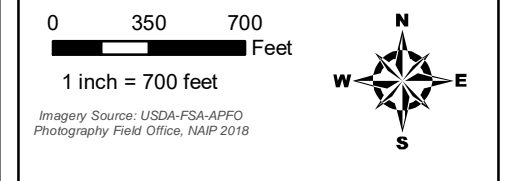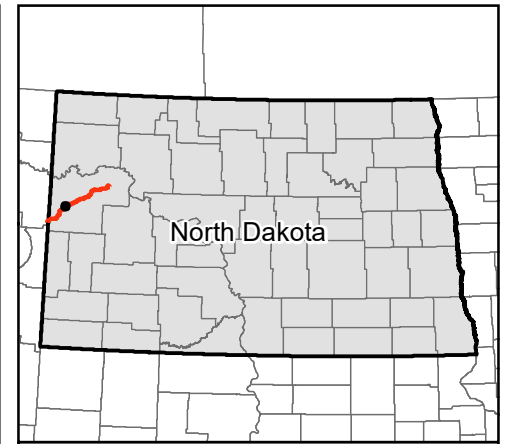

Imagery Source: USDA-FSA-APFO
Photography Field Office, NAIP 2018

- Milepost
- As-Built Centerline
- Project Corridor




**ONEOK Bakken Pipeline, L.L.C.
Demicks Lake Pipeline Project**

**As-Built Centerline and
Certificated Corridor**

Page 26 of 38
McKenzie County, ND



Date: (1/20/2020) Source: Z:\Clients\MLP\Oneok\Demicks_Lake_Pipeline\Permitting\FSC\20200120_As_Built\DLF_PSC_As_Built_Centerline_Maps.mxd

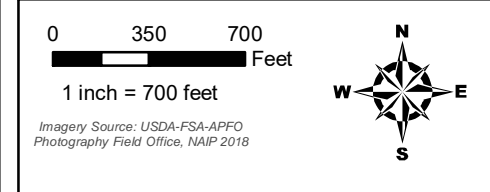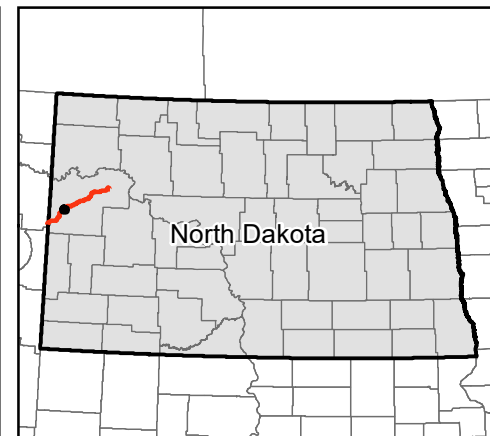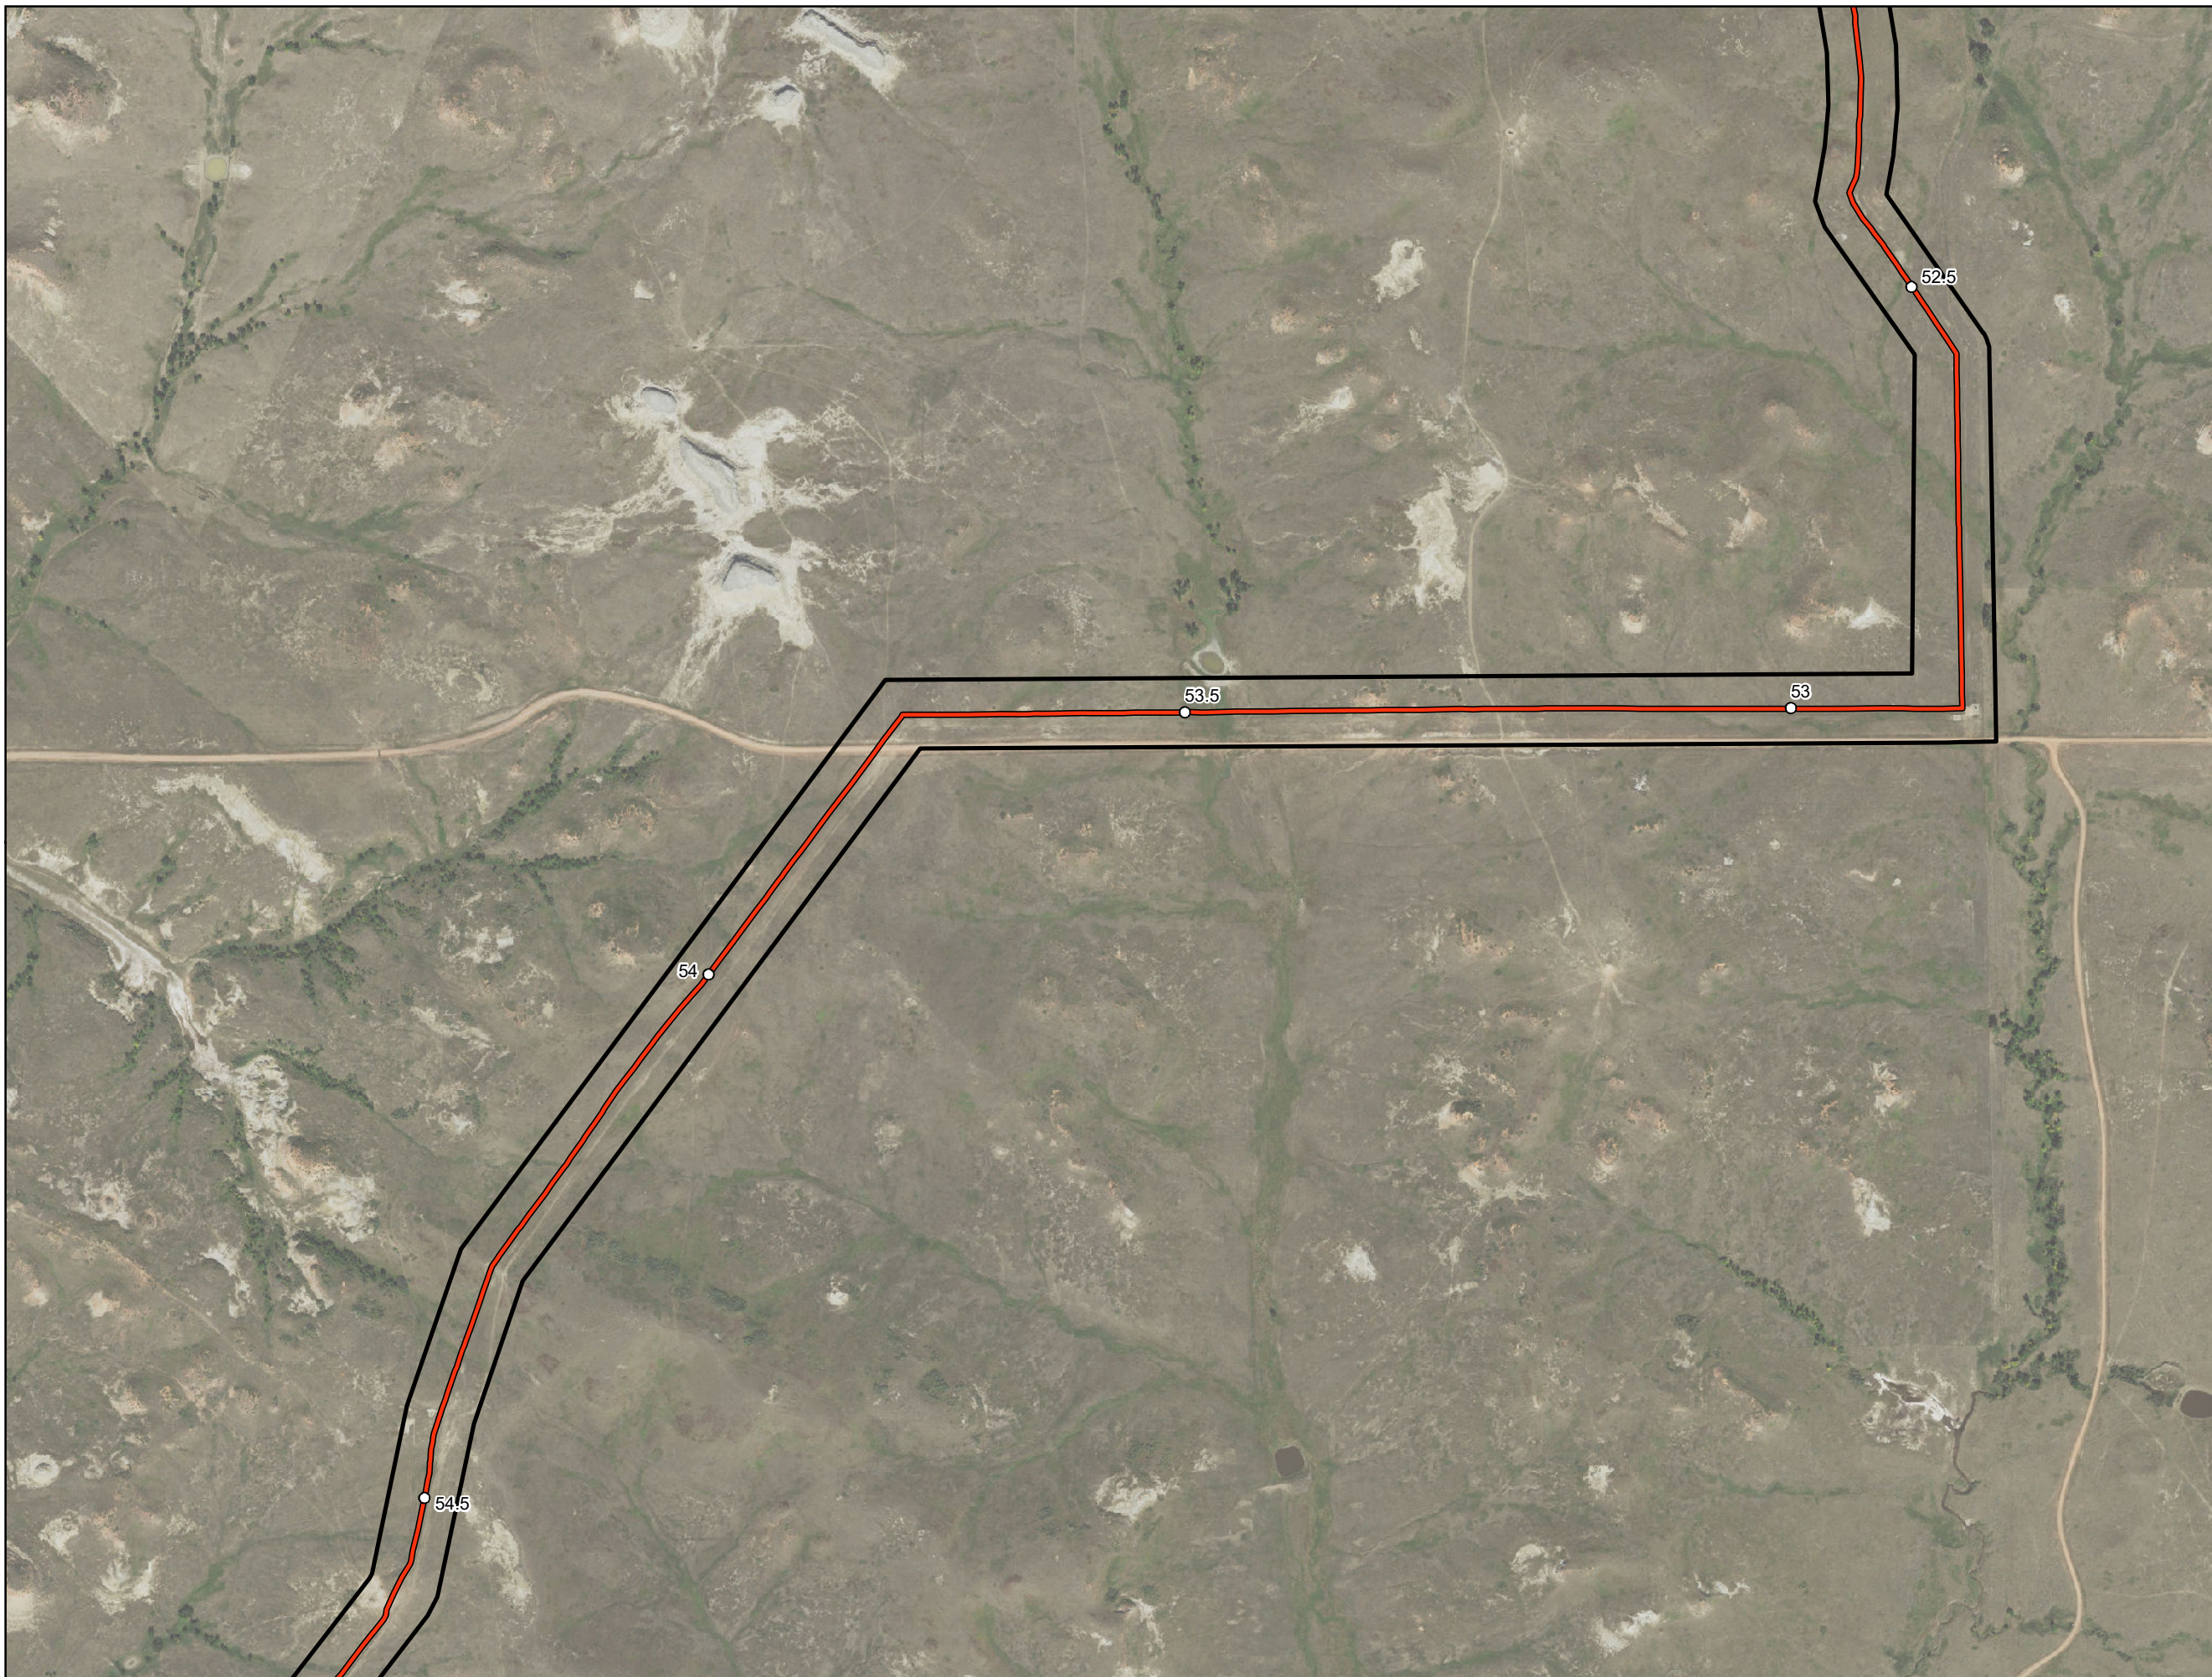

- Milepost
- As-Built Centerline
- Project Corridor



**ONEOK Bakken Pipeline, L.L.C.
Demicks Lake Pipeline Project**

**As-Built Centerline and
Certificated Corridor**

Page 27 of 38
McKenzie County, ND



Date: (1/20/2020) Source: Z:\Clients\MLP\Oneok\Demicks_Lake_Pipeline\Permitting\PS\20200120_As_Built\DLF_PSC_As_Built_Centerline_Maps.mxd

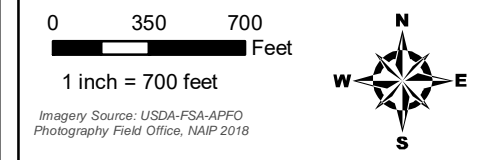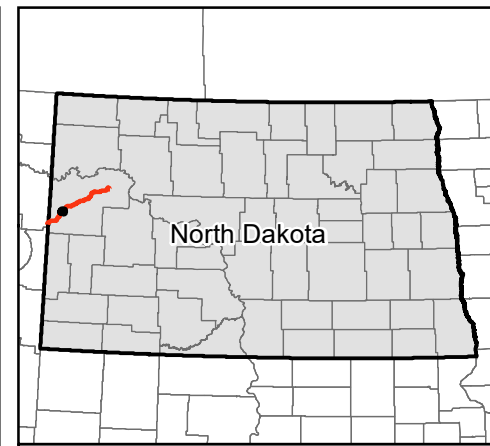

Imagery Source: USDA-FSA-APFO
Photography Field Office, NAIP 2018

- Milepost
- As-Built Centerline
- Project Corridor

**ONEOK Bakken Pipeline, L.L.C.
Demicks Lake Pipeline Project**



**As-Built Centerline and
Certificated Corridor**

Page 28 of 38

McKenzie County, ND



Date: (1/20/2020) Source: Z:\Clients\MLP\Oneok\Demicks_Lake_Pipeline\Permitting\FSC\20200120_As_Built\DLF_PSC_As_Built_Centerline_Maps.mxd

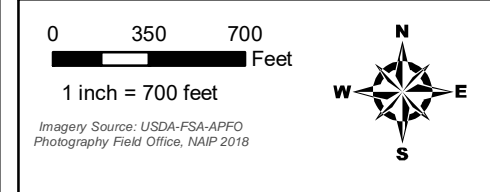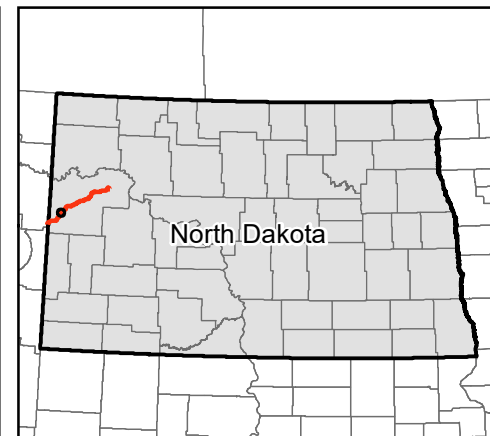

Imagery Source: USDA-FSA-APFO
Photography Field Office, NAIP 2018

- Milepost
- As-Built Centerline
- Project Corridor

**ONEOK Bakken Pipeline, L.L.C.
Demicks Lake Pipeline Project**



**As-Built Centerline and
Certificated Corridor**

Page 29 of 38

McKenzie County, ND



Source: Z:\Clients\MLP\Oneok\Demicks_Lake_Pipeline\Permitting\FSC\20200120_As_Built\DLF_PSC_As_Built_Centerline_Maps.mxd

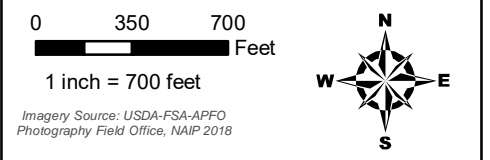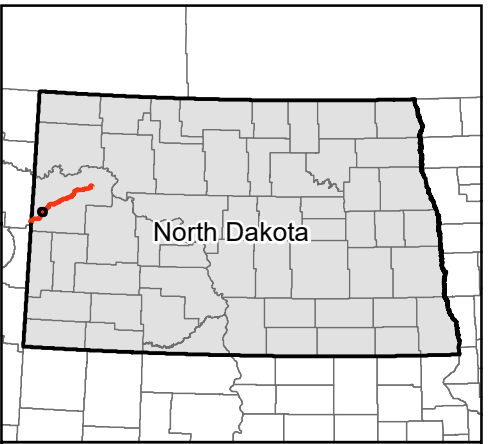

Imagery Source: USDA-FSA-APFO
Photography Field Office, NAIP 2018

- Milepost
- As-Built Centerline
- Project Corridor

**ONEOK Bakken Pipeline, L.L.C.
Demicks Lake Pipeline Project**



**As-Built Centerline and
Certificated Corridor**

Page 30 of 38

McKenzie County, ND



Date: (1/20/2020) Source: Z:\Clients\MLP\Oneok\Demicks_Lake_Pipeline\Permitting\FSC\20200120_As_Built\DLF_PSC_As_Built_Centerline_Maps.mxd

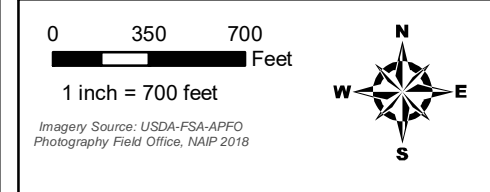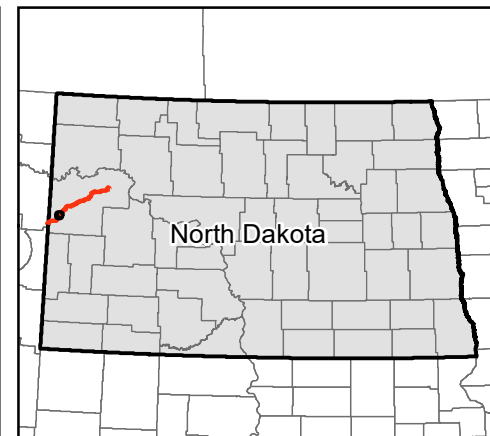

- Milepost
- As-Built Centerline
- Project Corridor




**ONEOK Bakken Pipeline, L.L.C.
Demicks Lake Pipeline Project**

**As-Built Centerline and
Certificated Corridor**

Page 31 of 38
McKenzie County, ND



Date: (1/20/2020) Source: Z:\Clients\M_L\Oneok\Demicks_Lake_Pipeline\Permitting\FSC\20200120_As_Built\DLF_PSC_As_Built_Centerline_Maps.mxd

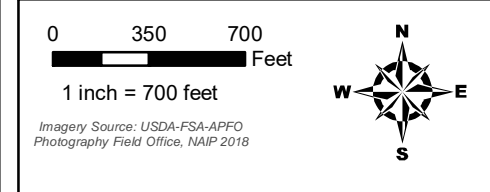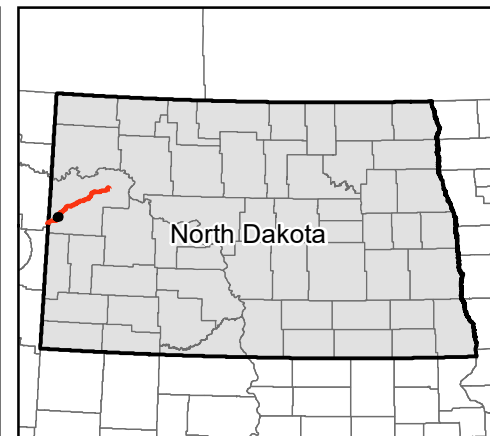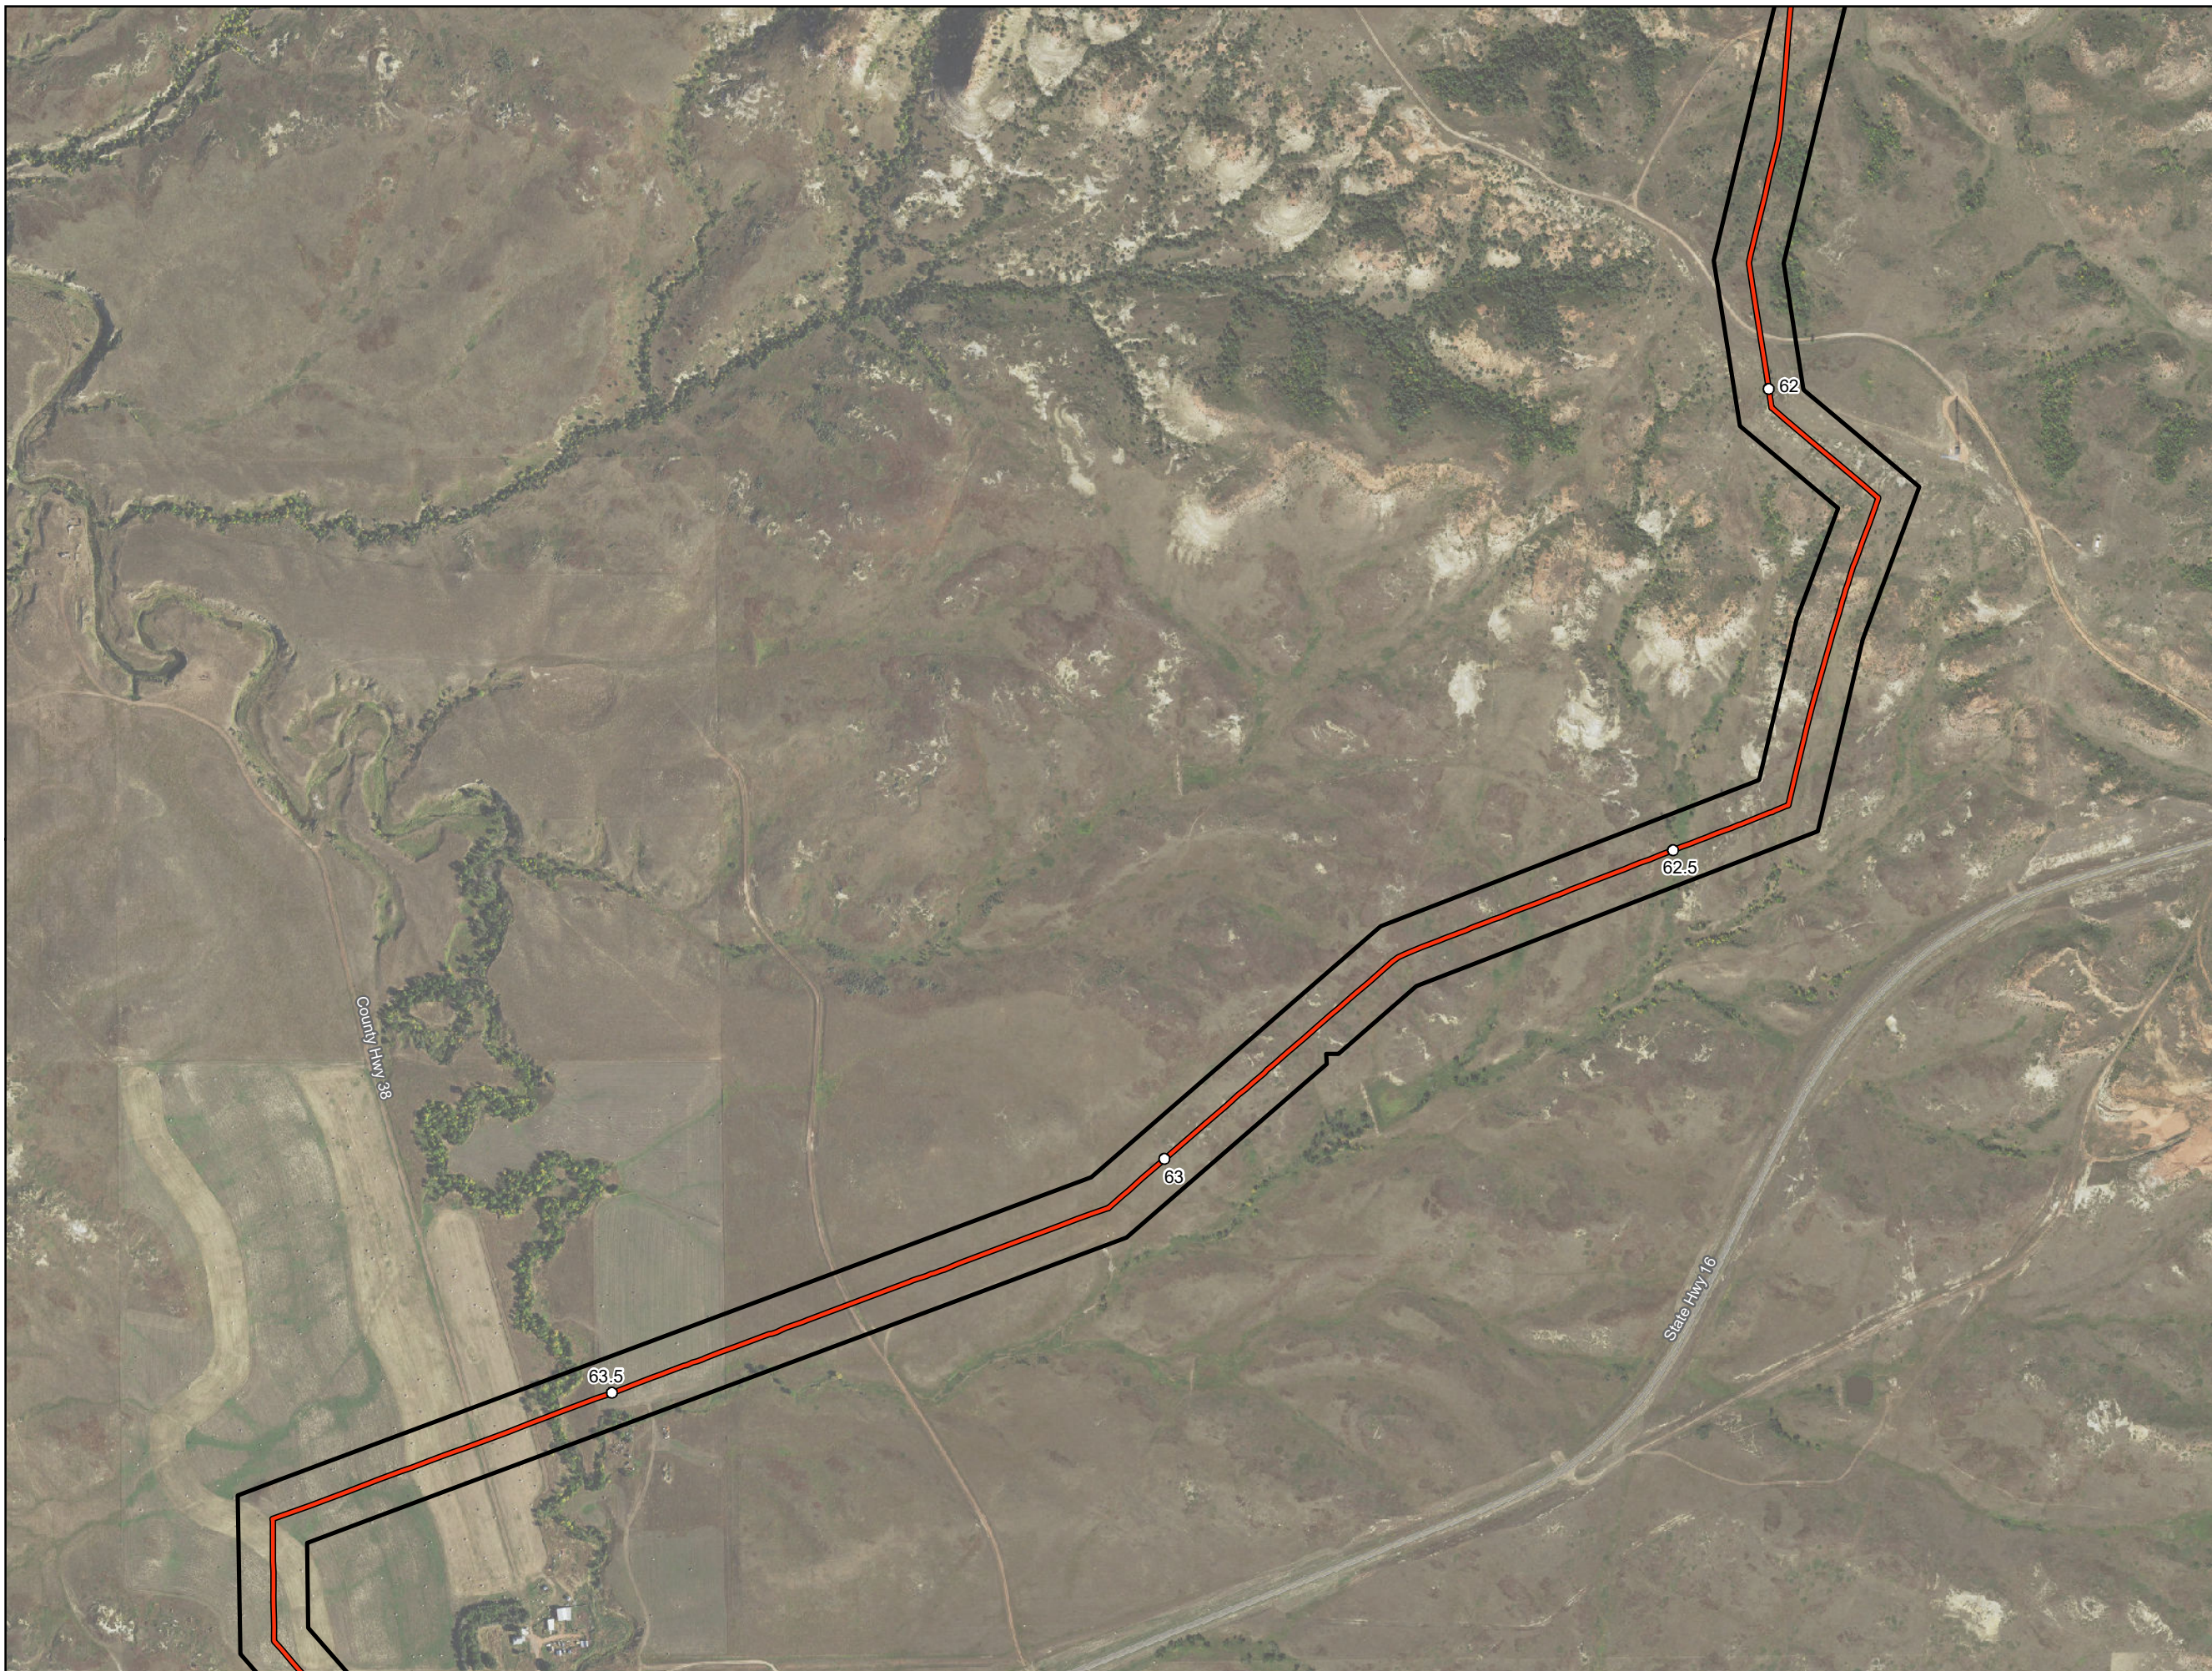

Imagery Source: USDA-FSA-APFO
Photography Field Office, NAIP 2018

- Milepost
- As-Built Centerline
- Project Corridor


**ONEOK Bakken Pipeline, L.L.C.
Demicks Lake Pipeline Project**

**As-Built Centerline and
Certificated Corridor**

Page 32 of 38
McKenzie County, ND



Date: (1/20/2020) Source: Z:\Clients\M_P\Oneok\Demicks_Lake_Pipeline\Permitting\PSC\20200120_As_Built\DLF_PSC_As_Built_Centerline_Maps.mxd

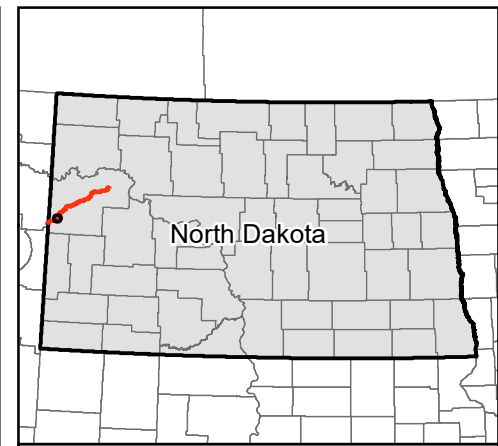

Imagery Source: USDA-FSA-APFO
Photography Field Office, NAIP 2018

- Milepost
- As-Built Centerline
- Project Corridor



**ONEOK Bakken Pipeline, L.L.C.
Demicks Lake Pipeline Project**

**As-Built Centerline and
Certificated Corridor**

Page 33 of 38
McKenzie County, ND



Date: (1/20/2020) Source: Z:\Clients\MLP\Oneok\Demicks_Lake_Pipeline\Permitting\FSC\20200120_As_Built\DLF_PSC_As_Built_Centerline_Maps.mxd

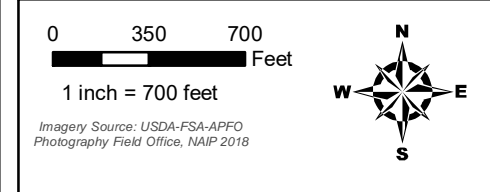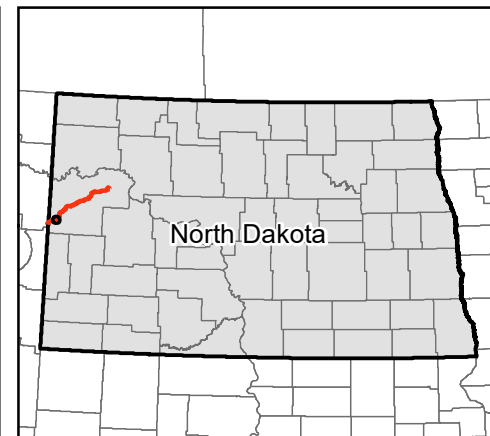




- Milepost
- As-Built Centerline
- Project Corridor

**ONEOK Bakken Pipeline, L.L.C.
Demicks Lake Pipeline Project**

**As-Built Centerline and
Certificated Corridor**

Page 34 of 38
McKenzie County, ND

Source: Z:\Clients\MLP\Oneok\Demicks_Lake_Pipeline\Permitting\FSC\20200120_As_Built\DLF_PSC_As_Built_Centerline_Maps.mxd

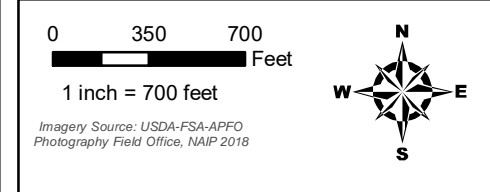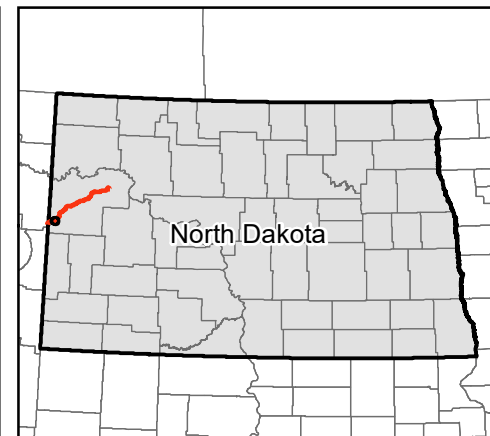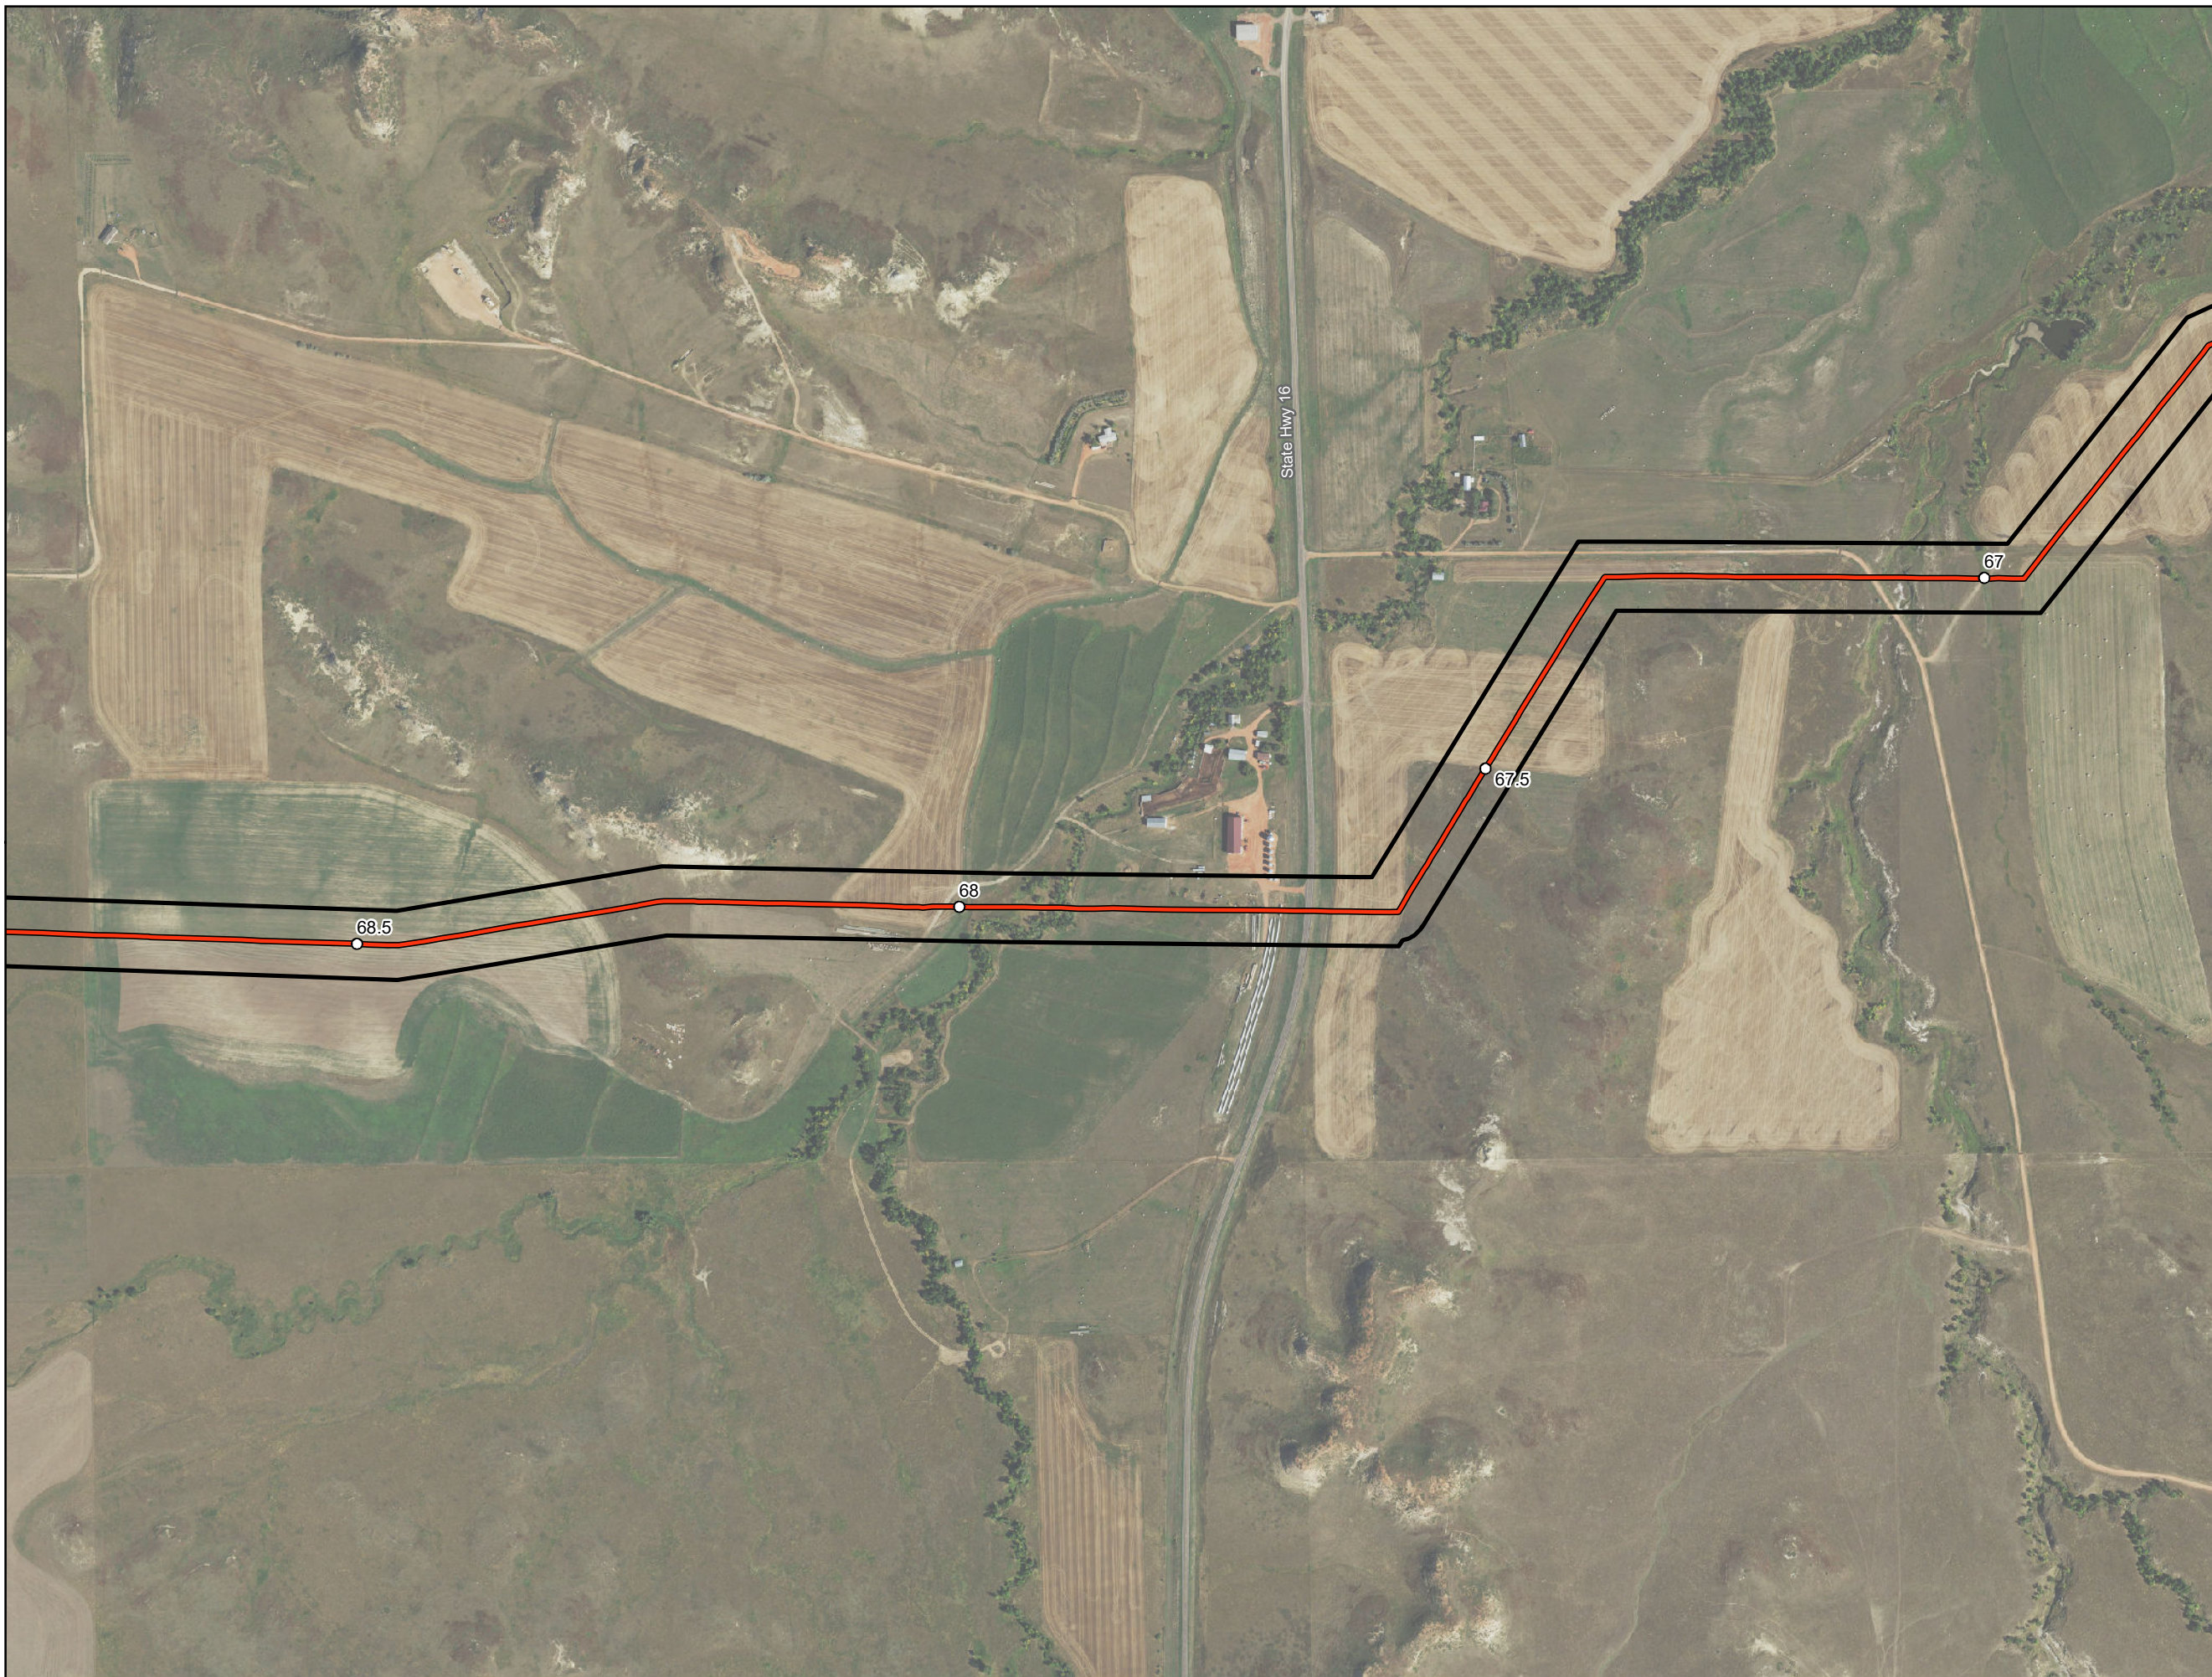

- Milepost
- As-Built Centerline
- Project Corridor




**ONEOK Bakken Pipeline, L.L.C.
Demicks Lake Pipeline Project**

**As-Built Centerline and
Certificated Corridor**

Page 35 of 38
McKenzie County, ND



Date: (1/20/2020) Source: Z:\Clients\M_L\Oneok\Demicks_Lake_Pipeline\Permitting\FSC\20200120_As_Built\DLF_PSC_As_Built_Centerline_Maps.mxd

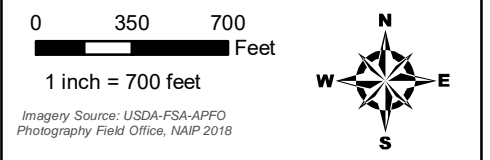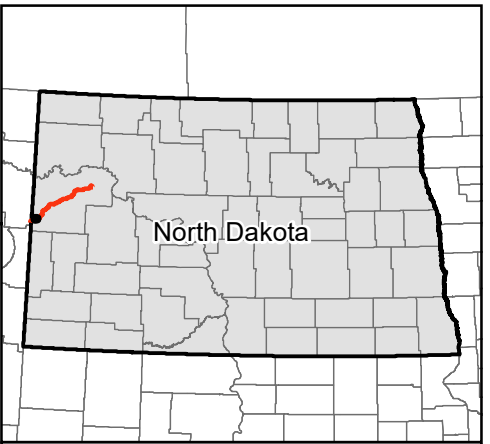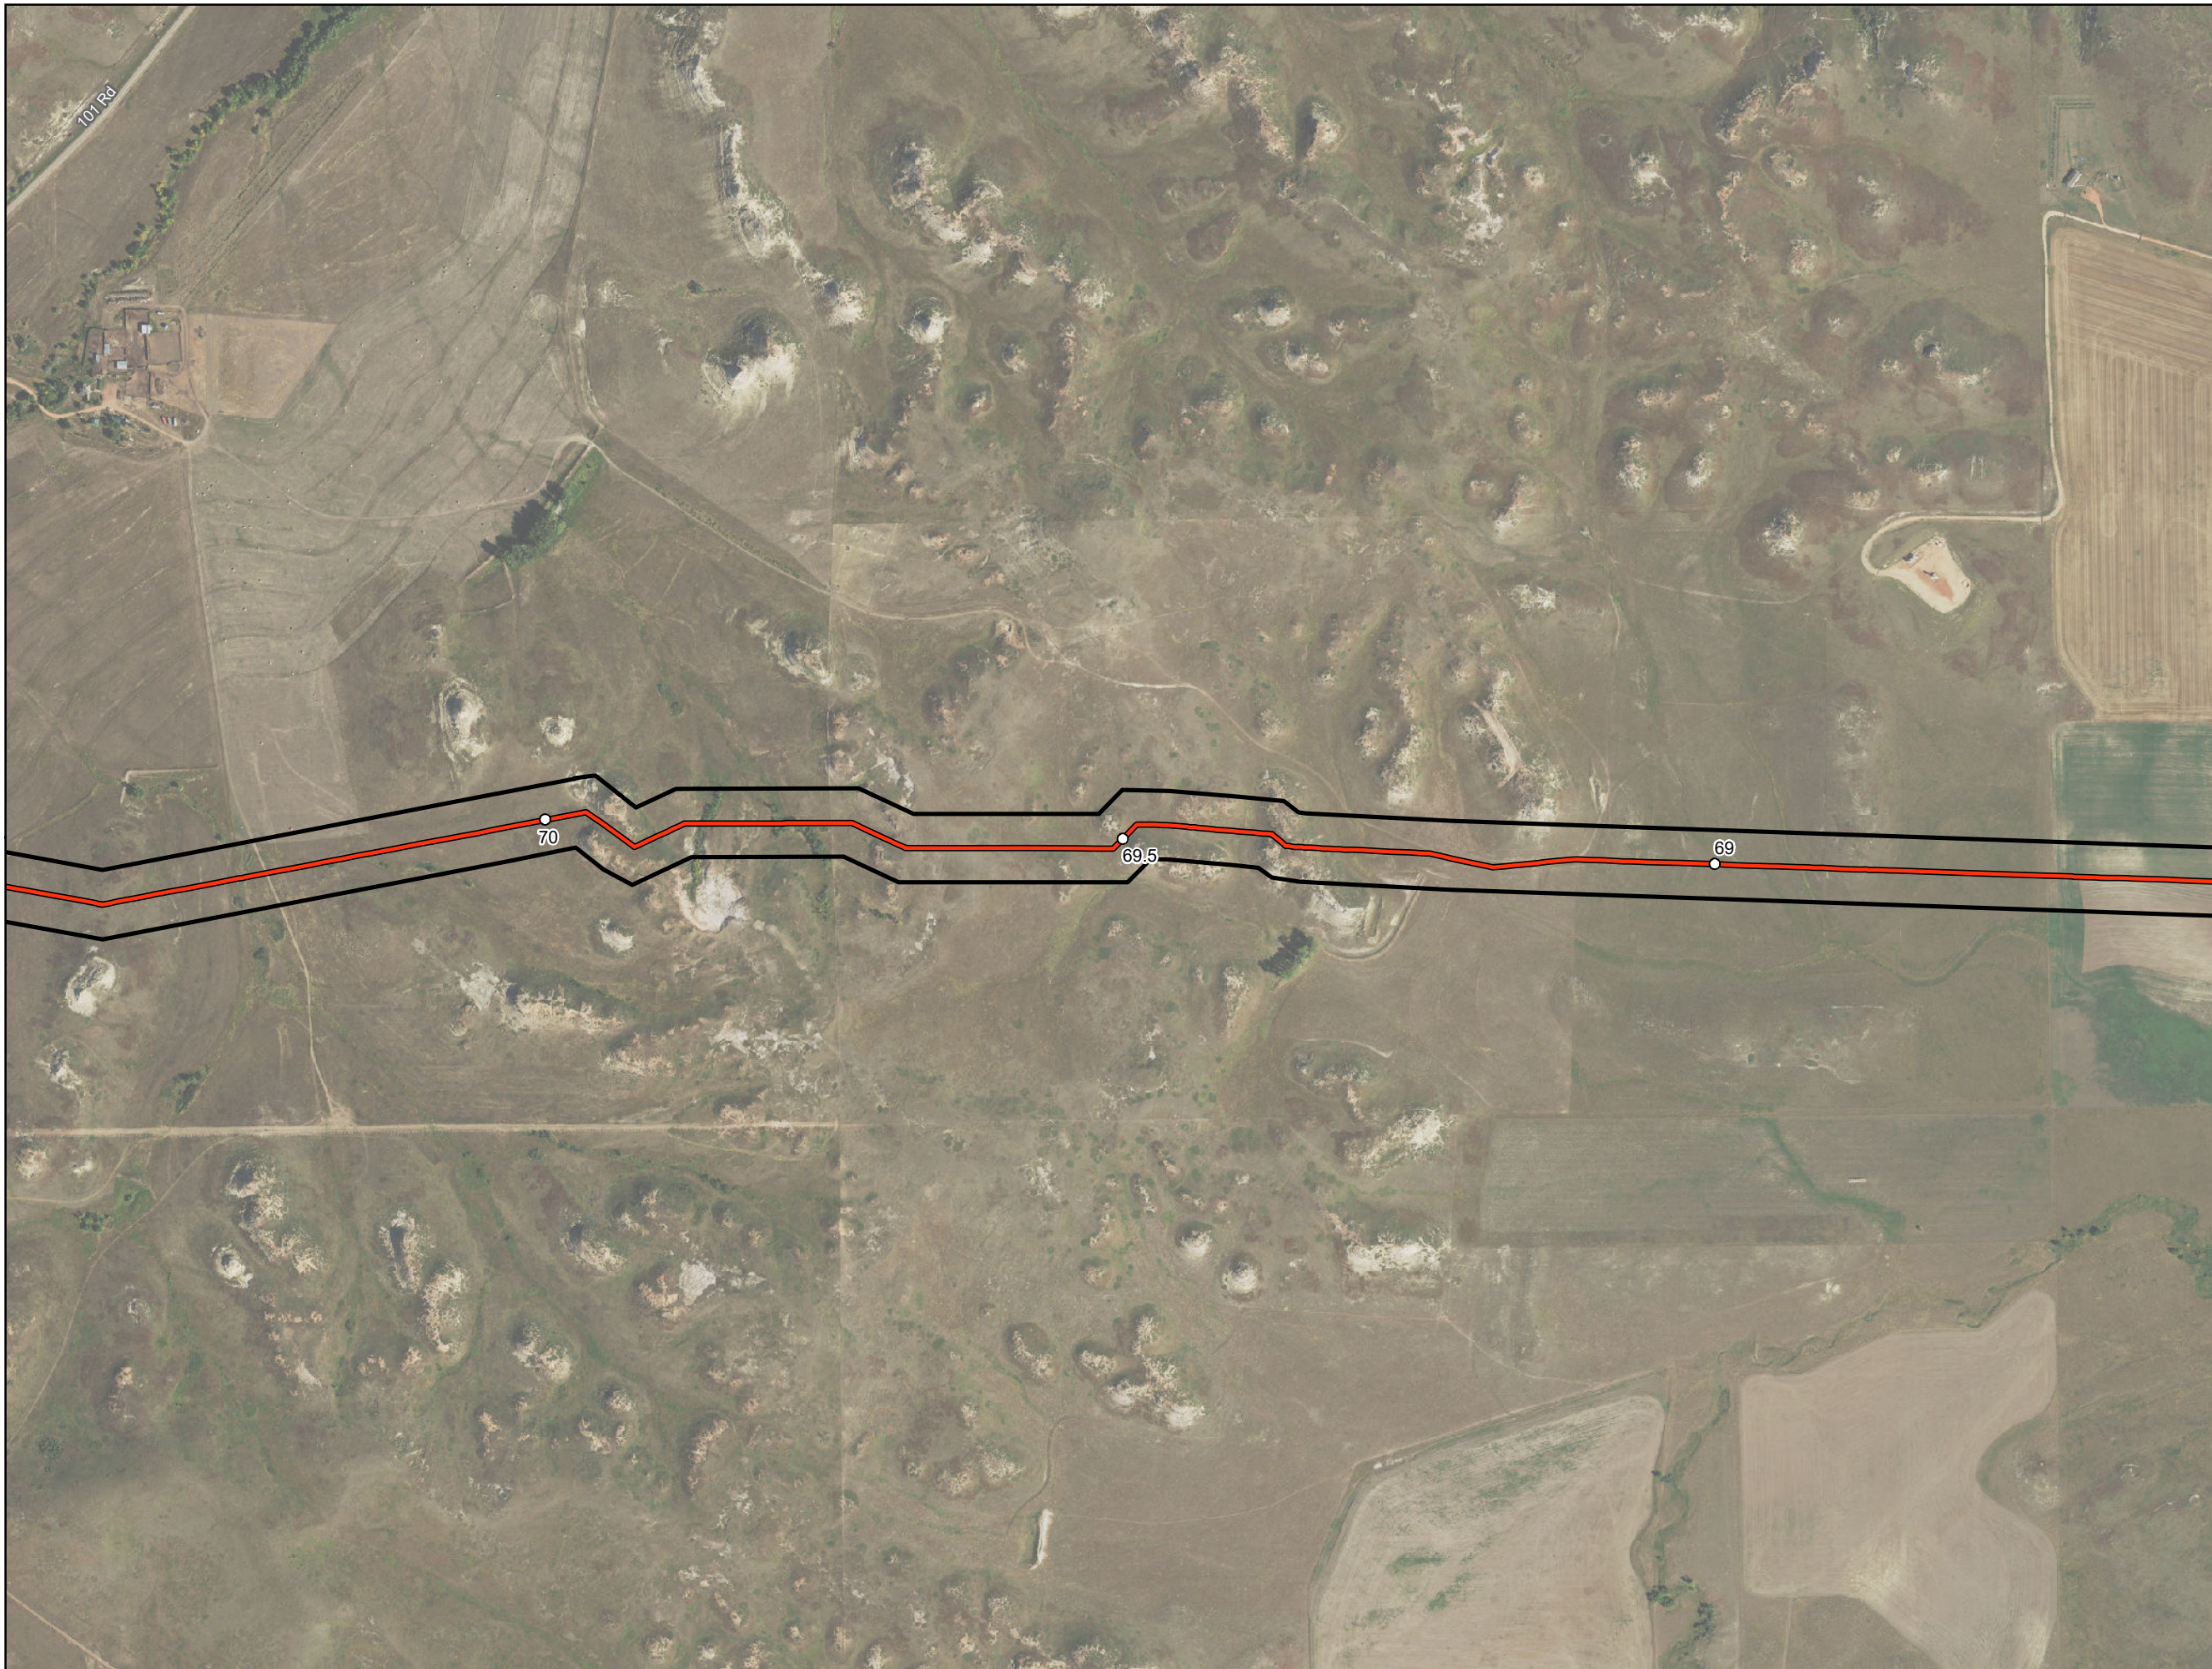

- Milepost
- As-Built Centerline
- Project Corridor




**ONEOK Bakken Pipeline, L.L.C.
Demicks Lake Pipeline Project**

**As-Built Centerline and
Certificated Corridor**

Page 36 of 38
McKenzie County, ND



Date: (1/20/2020) Source: Z:\Clients\M_L\Oneok\Demicks_Lake_Pipeline\Permitting\PSC\20200120_As_Built\DLF_PSC_As_Built_Centerline_Maps.mxd

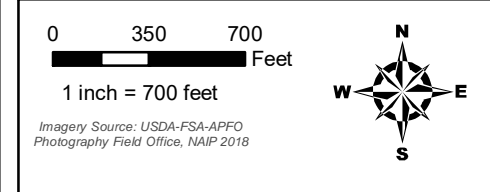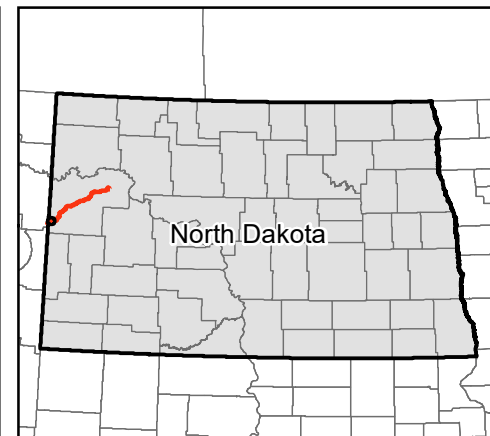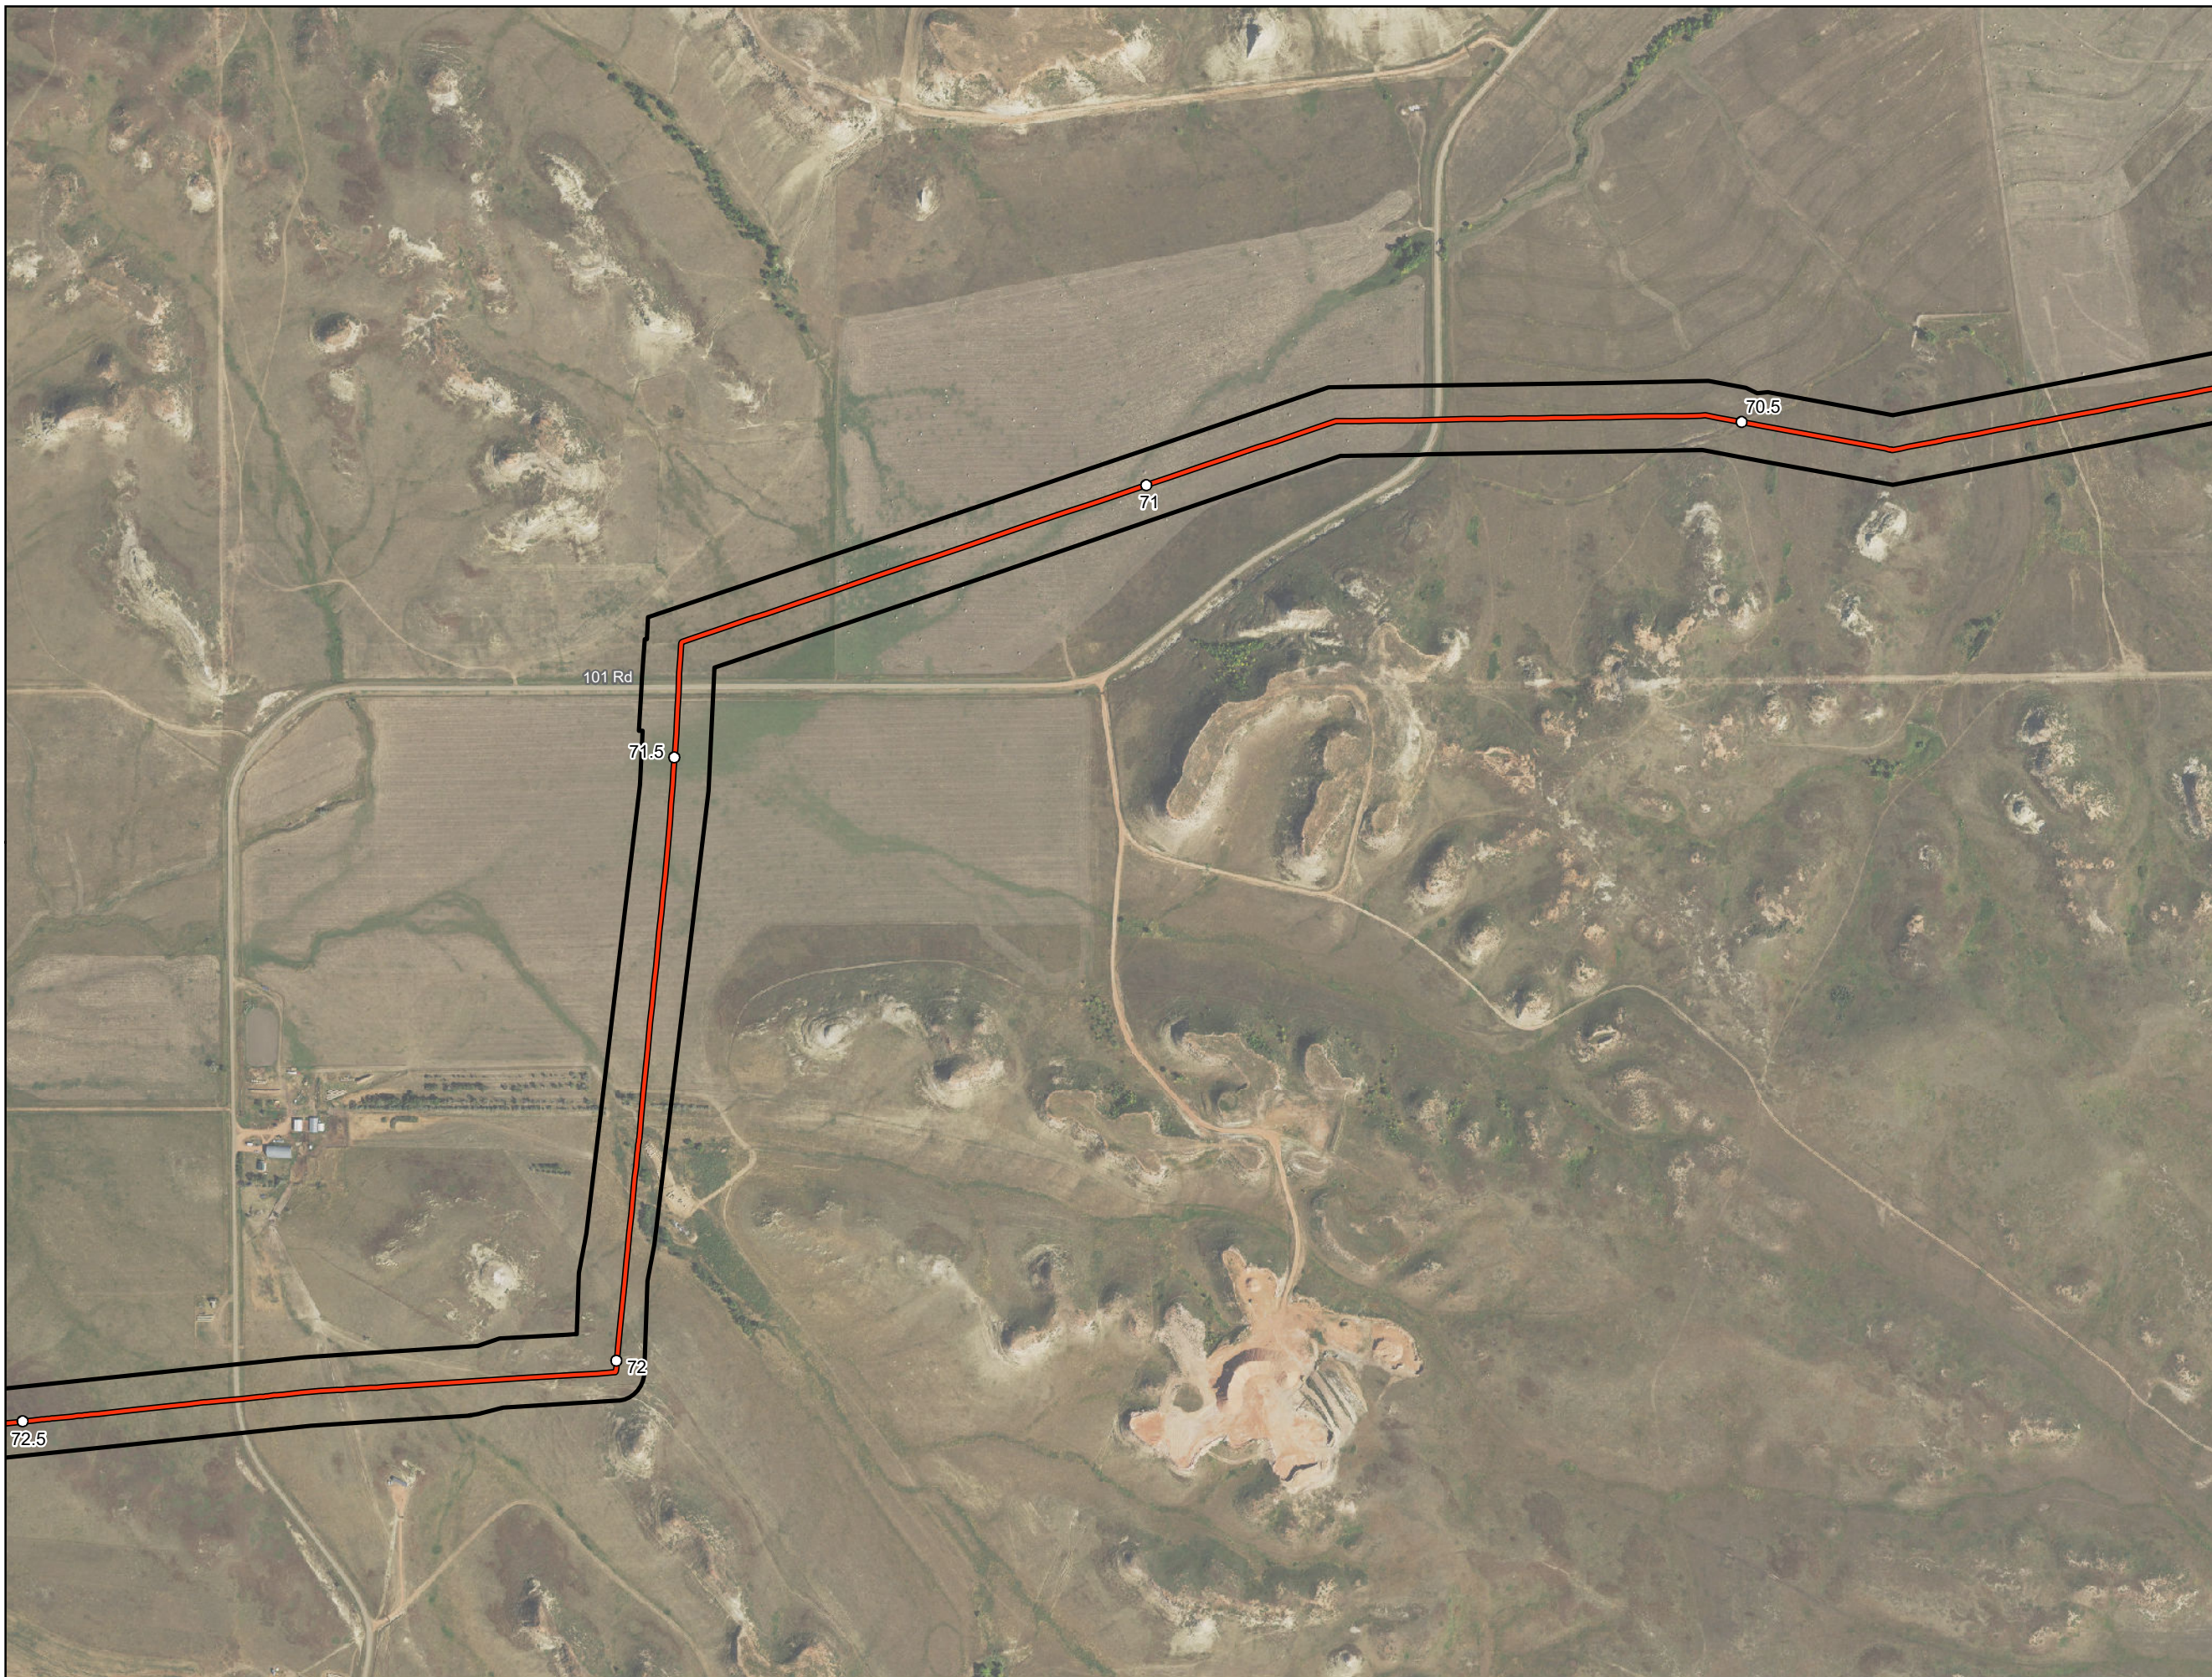

Imagery Source: USDA-FSA-APFO
Photography Field Office, NAIP 2018

- Milepost
- As-Built Centerline
- Project Corridor




**ONEOK Bakken Pipeline, L.L.C.
Demicks Lake Pipeline Project**

**As-Built Centerline and
Certificated Corridor**

Page 37 of 38
McKenzie County, ND



Date: (1/20/2020) Source: Z:\Clients\M_L\Oneok\Demicks_Lake_Pipeline\Permitting\PSC\20200120_As_Built\DLF_PSC_As_Built_Centerline_Maps.mxd

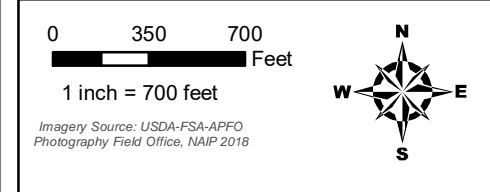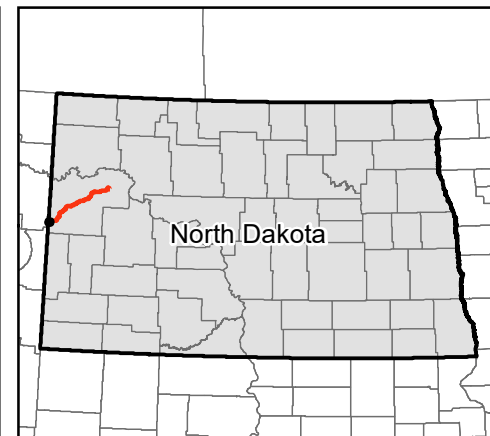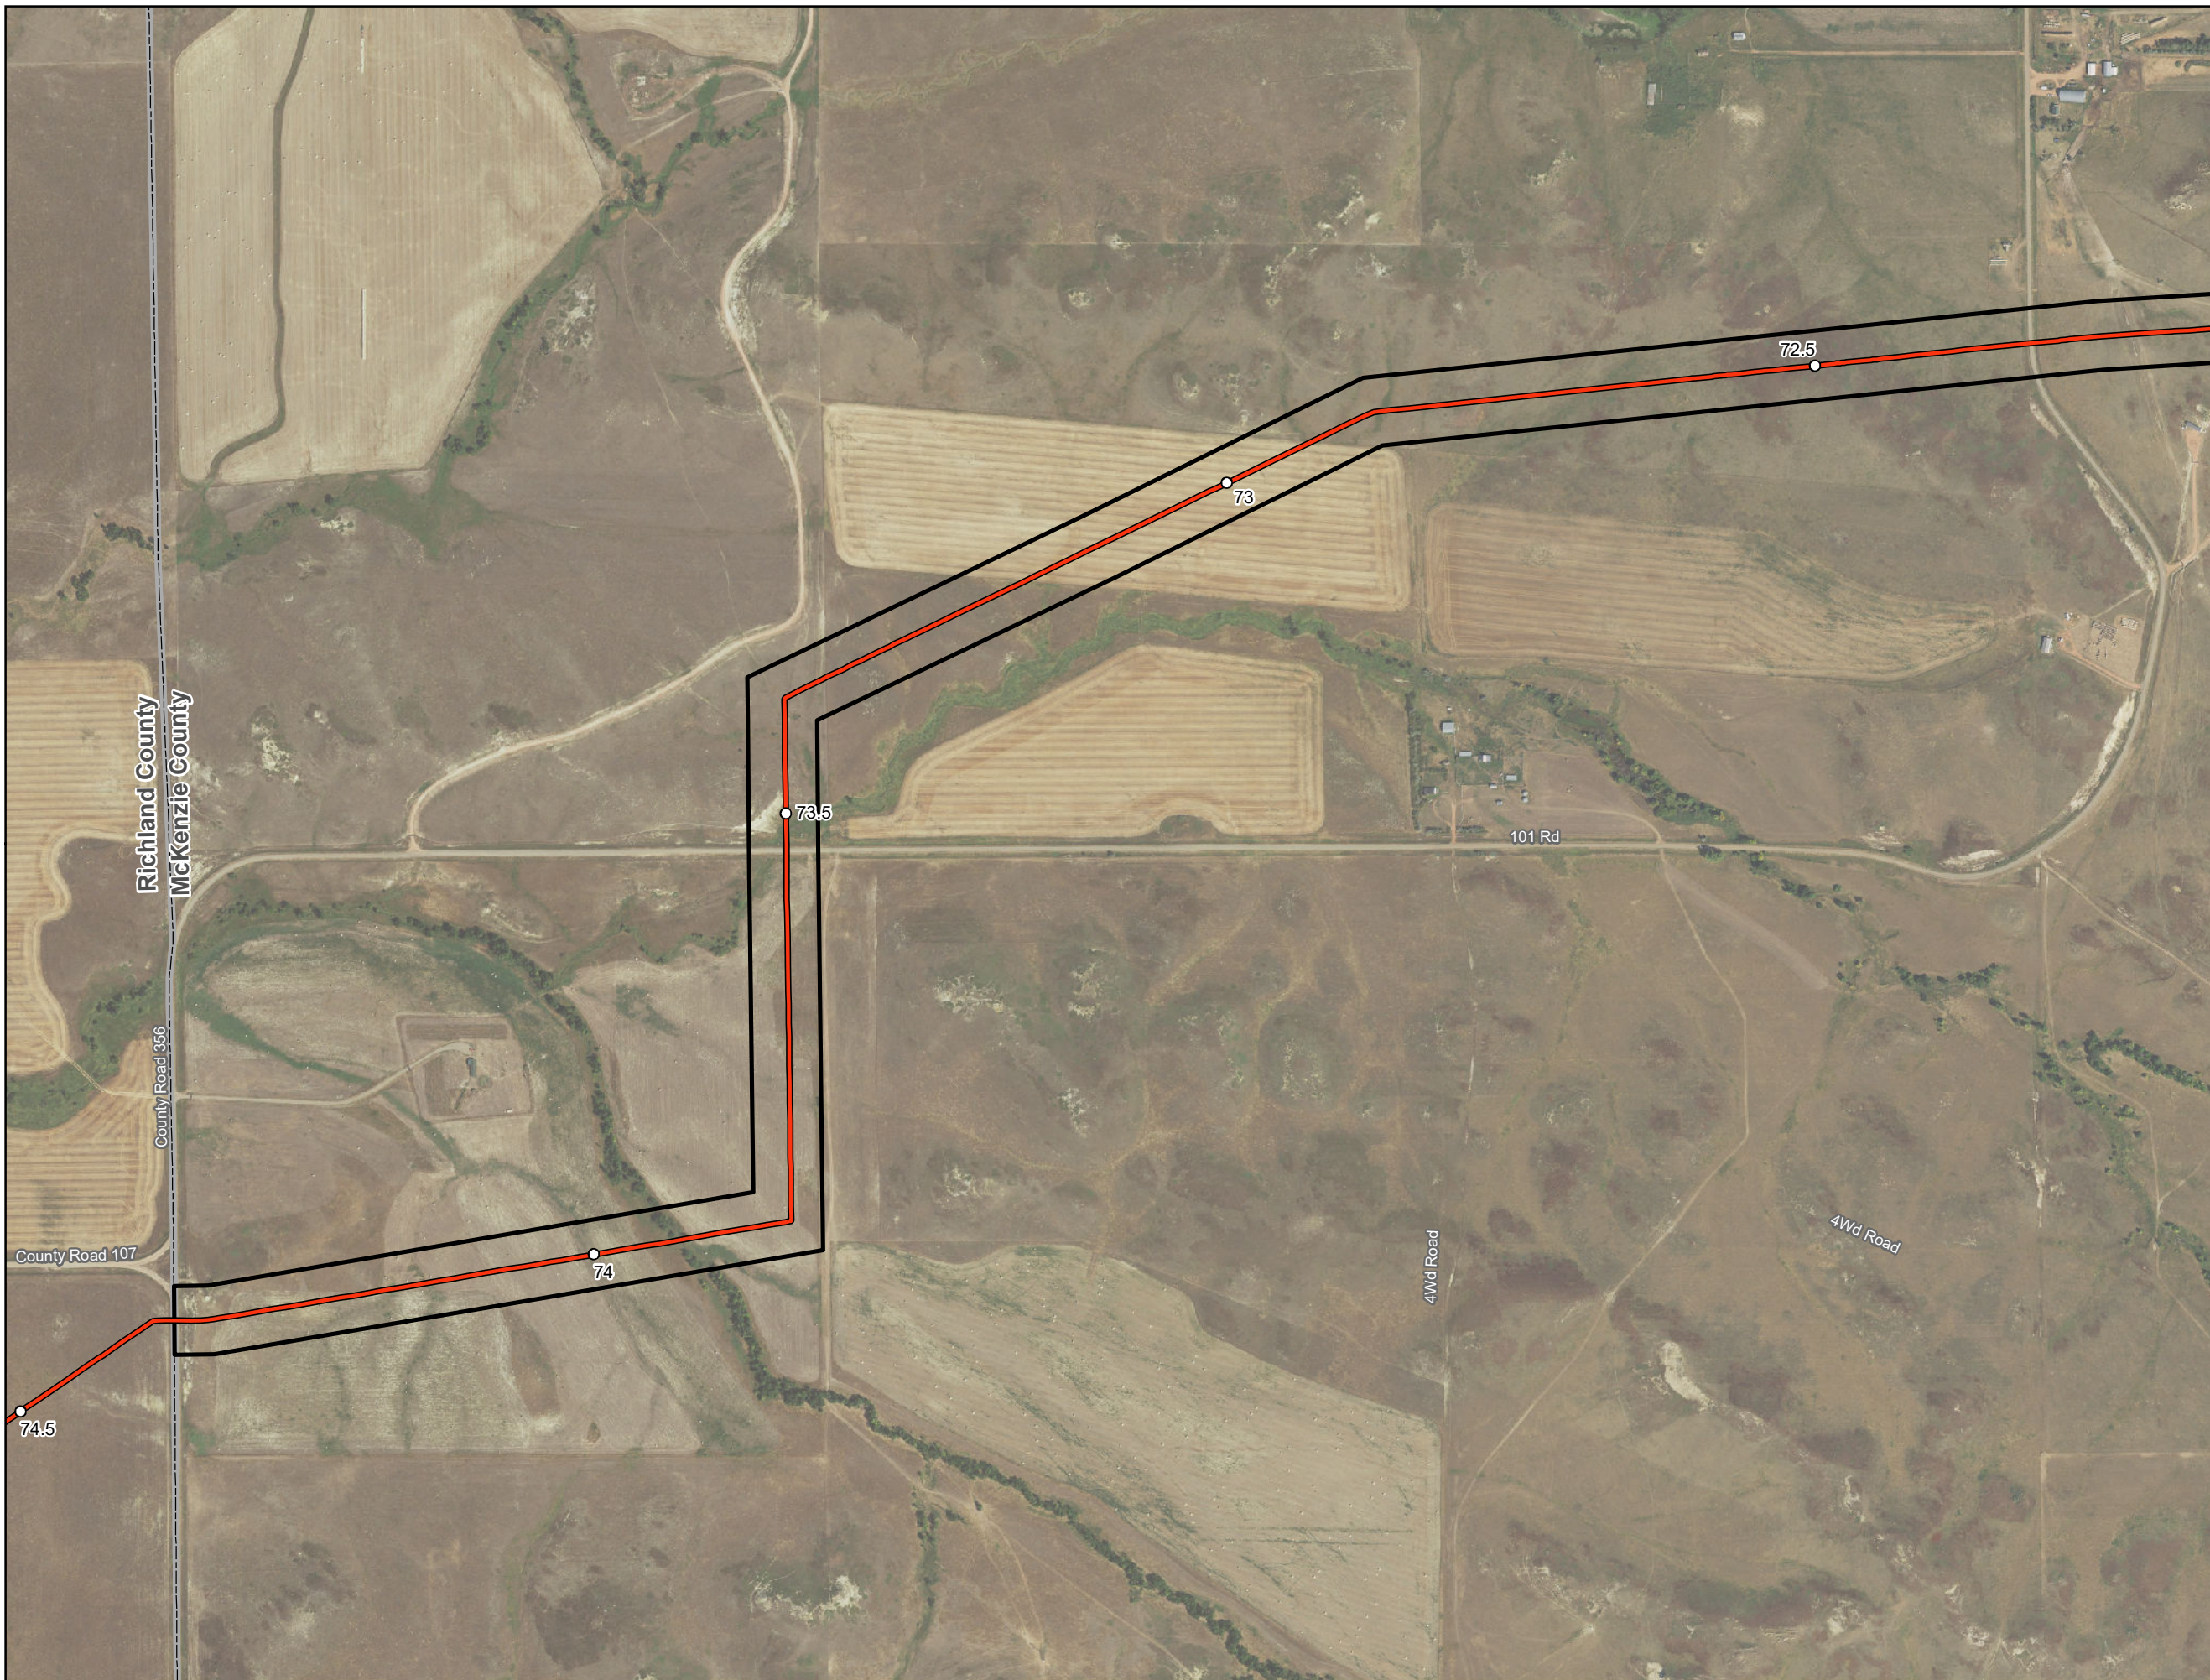

Imagery Source: USDA-FSA-APFO
Photography Field Office, NAIP 2018

- Milepost
- As-Built Centerline
- Project Corridor

**ONEOK Bakken Pipeline, L.L.C.
Demicks Lake Pipeline Project**

**As-Built Centerline and
Certificated Corridor**

Page 38 of 38
McKenzie County, ND



Source: Z:\Clients\MLP\Oneok\Demicks_Lake_Pipeline\Permitting\FSC\20200120_As_Built\DLF_PSC_As_Built_Centerline_Maps.mxd