

Imagery Source: USDA-FSA-APFO  
Aerial Photography Field Office

- Milepost
- As-Built Centerline
- ▭ Project Corridor

**ONEOK Bakken Pipeline, L.L.C.**  
**Little Missouri Lateral**  
**Pipeline Project**



**As-Built Centerline and**  
**Certificated Corridor**

Page 1 of 6

McKenzie County, ND



Date: (11/15/2019) Source: Z:\Clients\W\_\Oneok\Line\_Missouri\_Lateral\Permitting\PSC20191115\_As\_Built\Figures\MLC\_PSC\_As\_Built\_Centerline\_Maps\_Aerial.mxd

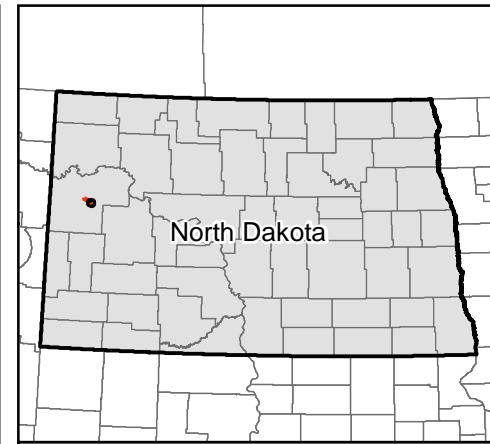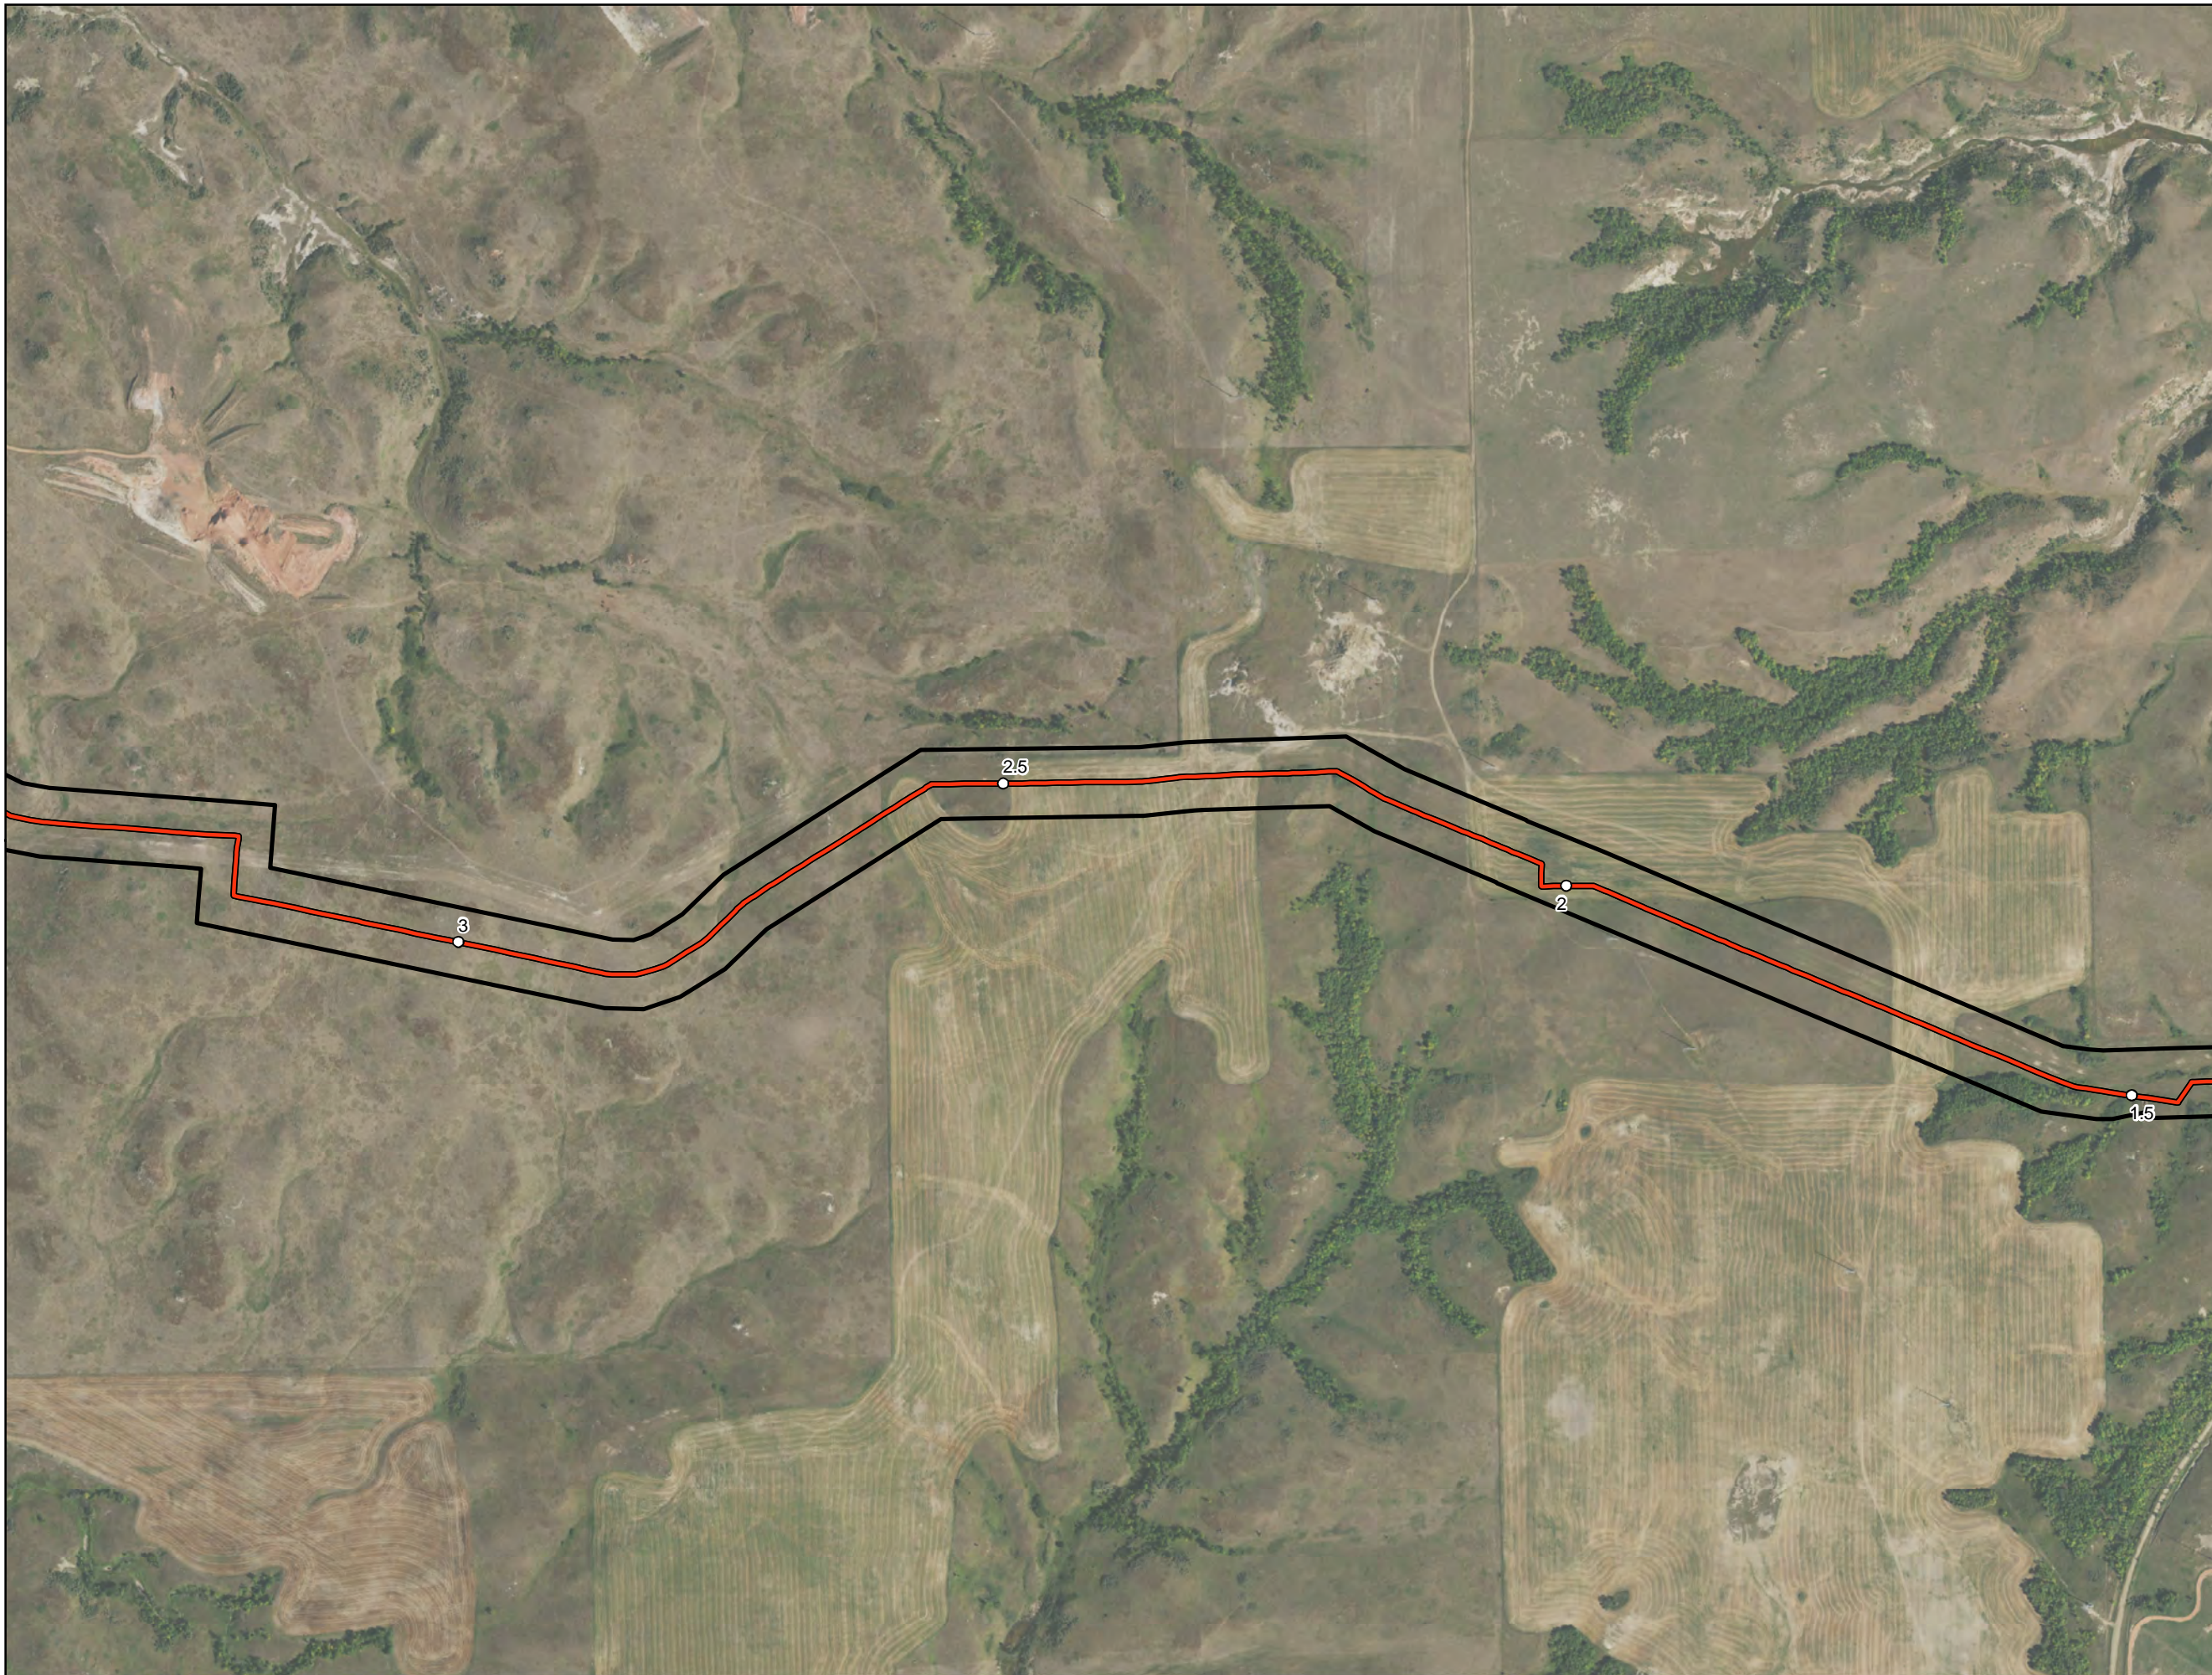

- Milepost
- As-Built Centerline
- ▭ Project Corridor

**ONEOK Bakken Pipeline, L.L.C.  
Little Missouri Lateral  
Pipeline Project**





**As-Built Centerline and  
Certificated Corridor**

Page 2 of 6

McKenzie County, ND



Date: (11/15/2019) Source: Z:\Clients\W\_F\Oneok\Line\_Missouri\_Lateral\Permitting\PSC20191115\_As\_Built\Figures\MLL\_PSC\_As\_Built\_Centerline\_Maps\_Aerial.mxd

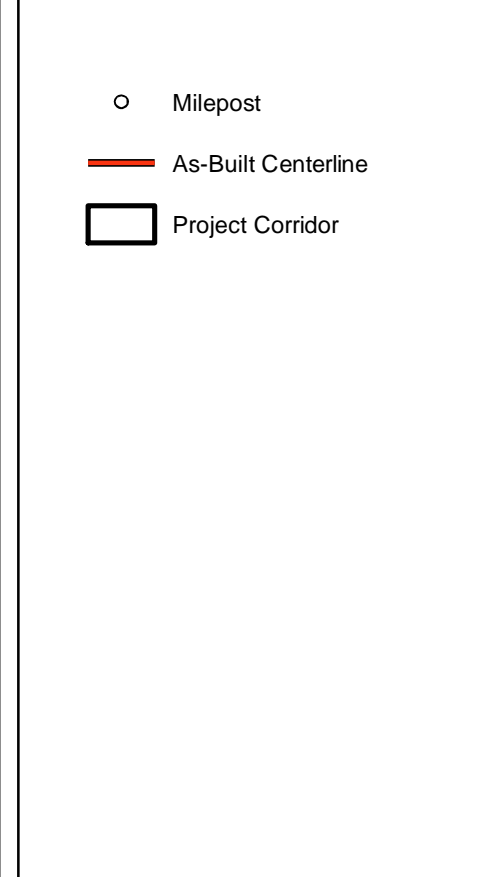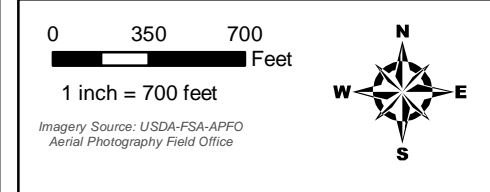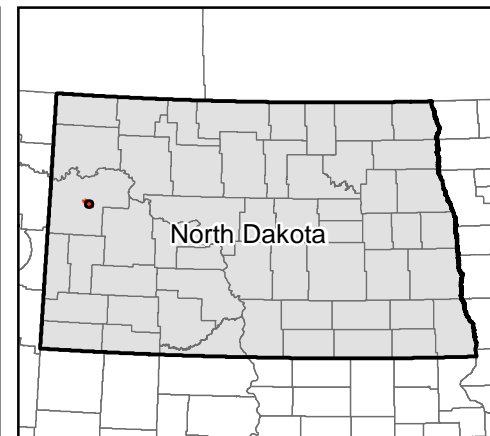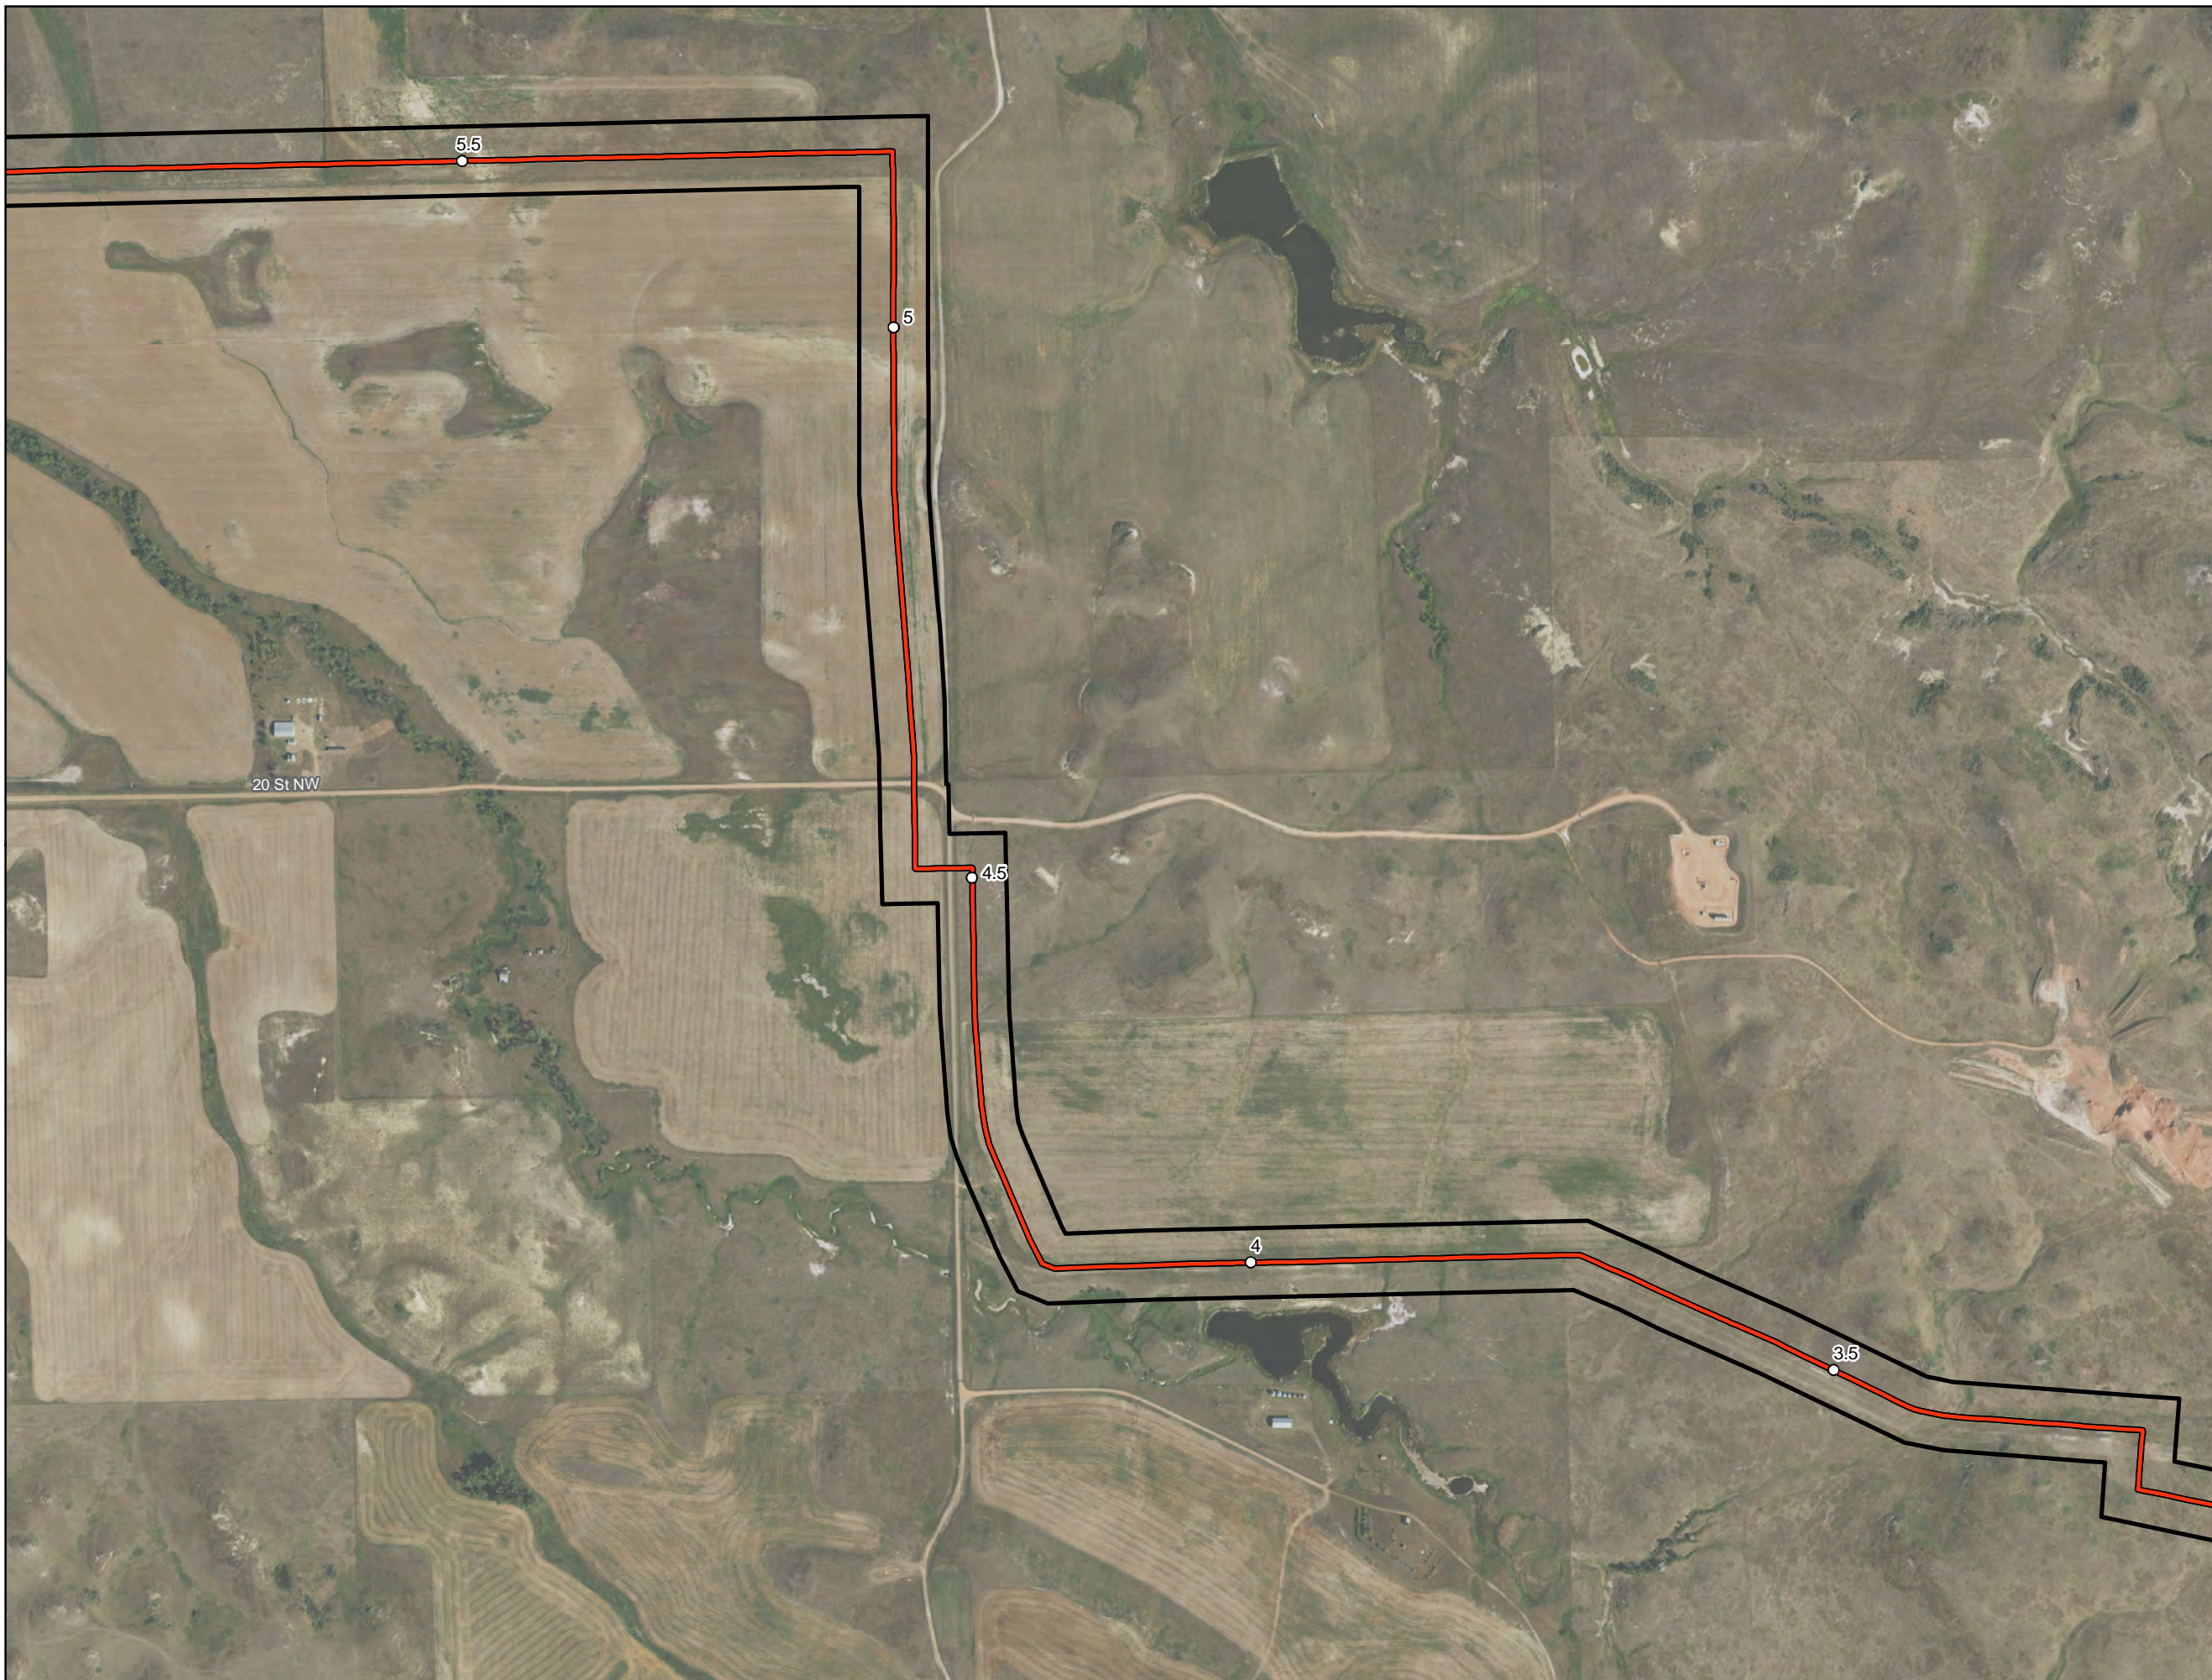

**ONEOK Bakken Pipeline, L.L.C.  
Little Missouri Lateral  
Pipeline Project**



**As-Built Centerline and  
Certificated Corridor**

Page 3 of 6

McKenzie County, ND



Date: (11/15/2019) Source: Z:\Clients\W\_F\Oneok\Line\_Missouri\_Lateral\Permitting\PSC\20191115\_As\_Built\Figures\MLL\_PSC\_As\_Built\_Centerline\_Maps\_Aerial.mxd

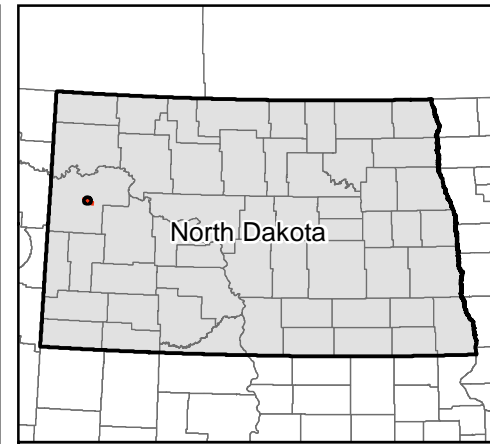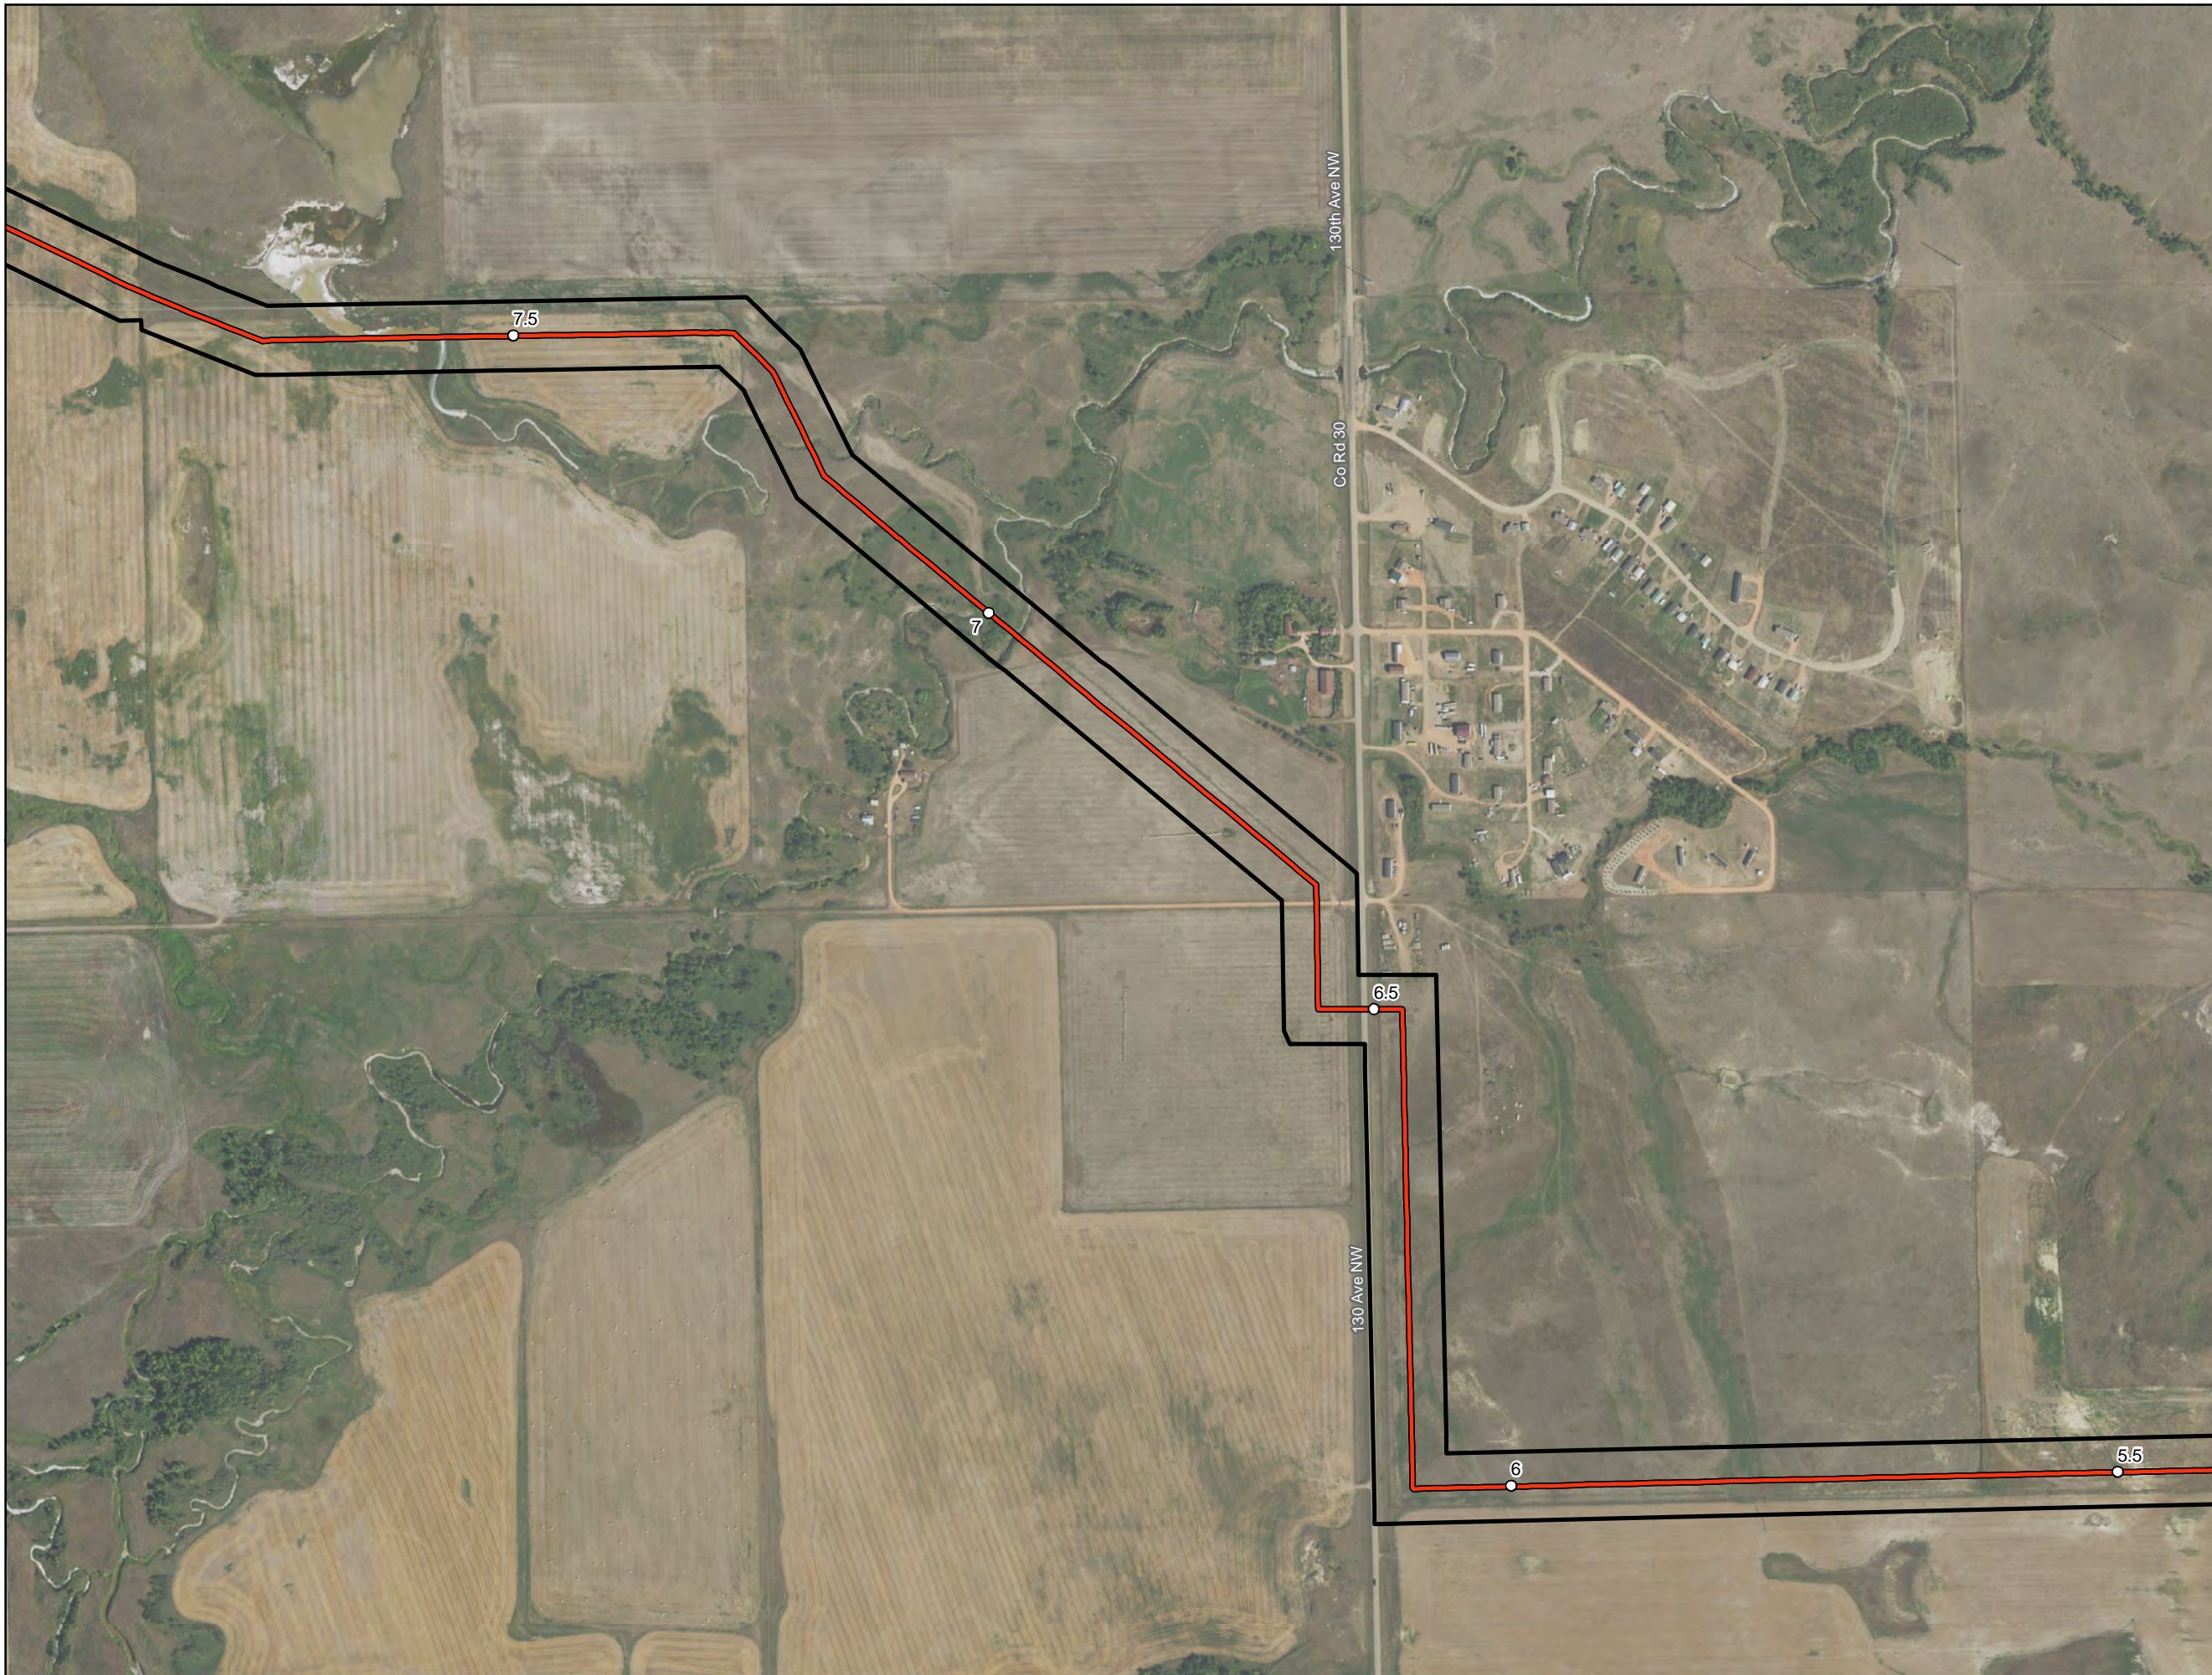

Imagery Source: USDA-FSA-APFO  
Aerial Photography Field Office

- Milepost
- As-Built Centerline
- ▭ Project Corridor

**ONEOK Bakken Pipeline, L.L.C.**  
**Little Missouri Lateral**  
**Pipeline Project**


**As-Built Centerline and**  
**Certificated Corridor**

Page 4 of 6

McKenzie County, ND



Date: (11/15/2019) Source: Z:\Clients\W\_\FOneok\Line\_Missouri\_Lateral\Permitting\PSC20191115\_As\_Built\Figures\MLL\_PSC\_As\_Built\_Centerline\_Maps\_Aerial.mxd

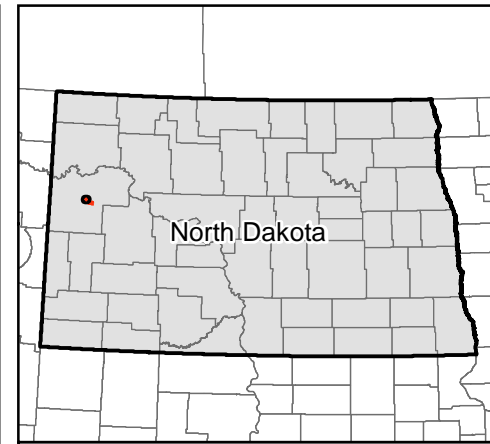

Imagery Source: USDA-FSA-APFO  
Aerial Photography Field Office

- Milepost
- As-Built Centerline
- ▭ Project Corridor

**ONEOK Bakken Pipeline, L.L.C.**  
**Little Missouri Lateral**  
**Pipeline Project**

**As-Built Centerline and**  
**Certificated Corridor**



Page 5 of 6

McKenzie County, ND



Date: (11/15/2019) Source: Z:\Clients\W\_F\Oneok\Line\_Missouri\_Lateral\Permitting\PSC\20191115\_As\_Built\Figures\MLL\_PSC\_As\_Built\_Centerline\_Maps\_Aerial.mxd

134th Ave NW

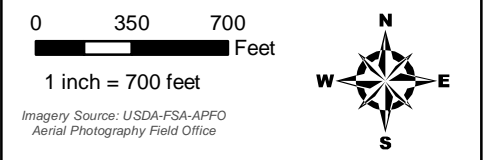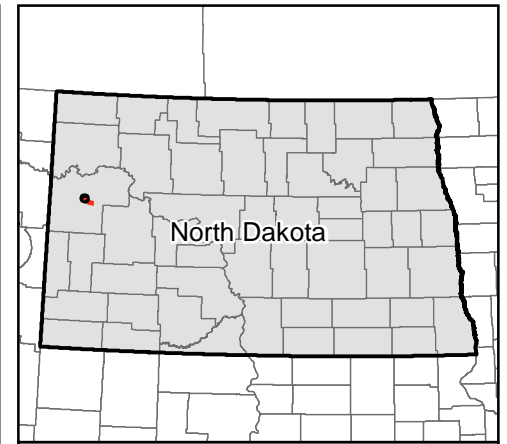

Imagery Source: USDA-FSA-APFO  
Aerial Photography Field Office

- Milepost
- As-Built Centerline
- ▭ Project Corridor

**ONEOK Bakken Pipeline, L.L.C.**  
**Little Missouri Lateral**  
**Pipeline Project**

**As-Built Centerline and**  
**Certificated Corridor**

Page 6 of 6

McKenzie County, ND



Source: Z:\Clients\W\_F\Oneok\Line\_Missouri\_Lateral\Permitting\PSC20191115\_As\_Built\Figures\MLL\_PSC\_As\_Built\_Centerline\_Maps\_Aerial.mxd