

## **-Info-Public Service Commission**

---

**From:** Schock, Victor F.  
**Sent:** Wednesday, October 23, 2019 2:06 PM  
**To:** -Info-Public Service Commission  
**Subject:** FW: PU-19-330  
**Attachments:** 2795\_001.pdf; Watford Utility Hit.pdf

Please file as a response in the above captioned docket.

Thanks,

Victor Schock

---

**From:** Kalan Wagner <k.wagner@wagnerconstructioninc.com>  
**Sent:** Wednesday, October 23, 2019 11:23 AM  
**To:** Schock, Victor F. <vschock@nd.gov>  
**Cc:** Marty Goulet <m.goulet@wagnerconstructioninc.com>; Paul Geving <p.geving@wagnerconstructioninc.com>  
**Subject:** PU-19-330

**CAUTION:** This email originated from an outside source. Do not click links or open attachments unless you know they are safe.

Victor,

Please see attached documents.

To summarize the incident:

Wagner had a utility located and potholed, the utility line and exposed.  
After excavating around the line exposing it the line got covered in soil and the operator accidentally hit it.

I attached the drawings show that the utility line should have been lowered to have the proper cover for the new road and ditch design.

When we struck the line we proceeded to dig the corrected line to a proper bury depth for the owner which was not in our contract with Watford City.

Our crew work together with MDU staff to correct this issue and bury it to a proper bury depth required with the new design. It is unfortunate that this was filed by them and request that they reconsider this claim as this should have been lowered and discovered in a plan review with the design team.

Victor are you able to facilitate a call all together on this in hopes to have MDU resend there Complaint.

Please call with any questions.

---

**Kalan Wagner** | President

Mobile: 218.240.9000 | Direct: 218.283.1867 | Fax: 218.283.1043



**Wagner Construction, Inc.**

3151 Highway 53, International Falls, MN 56649

Main: 218.283.3700 | [www.wagnerconstructioninc.com](http://www.wagnerconstructioninc.com)

---

THIS MESSAGE IS INTENDED FOR THE USE OF THE PERSON TO WHOM IT IS ADDRESSED. IT MAY CONTAIN INFORMATION THAT IS PRIVILEGED, CONFIDENTIAL AND EXEMPT FROM DISCLOSURE UNDER APPLICABLE LAW. If you are not the intended recipient, your use of this message for any purpose is strictly prohibited. If you have received this communication in error, please delete the message and notify the sender, so that we may correct our records. Thank you for your cooperation.

**From:** [lexi\\_wagcon@frontiernet.net](mailto:lexi_wagcon@frontiernet.net) <[lexi\\_wagcon@frontiernet.net](mailto:lexi_wagcon@frontiernet.net)>

**Sent:** Wednesday, October 23, 2019 10:53 AM

**To:** Kalan Wagner <[k.wagner@wagnerconstructioninc.com](mailto:k.wagner@wagnerconstructioninc.com)>

**Subject:** Attached Image

---

This transmission, email and any files transmitted with it, may be: (1) subject to the Attorney-Client Privilege, (2) an attorney work product, or (3) strictly confidential under federal or state law. If you are not the intended recipient of this message, you may not use, disclose, print, copy or disseminate this information. If you have received this transmission in error, notify the sender (only) and delete the message. This message may also be subject to disclosure under the North Dakota Open Records Laws.

**INCIDENT REPORT**



Today's Date: 8-20-19

Incident Date: 8-20-19

Incident Time: 8:09 pm

Employee Name: Paul Geving

Phone: 218-324-0304

Date Office Notified By Phone: 8-21-19

Time Office Notified: \_\_\_\_\_

Name of Person Contacted on Job Site: Paul Geving

Incident Type:  Utility Hit  Damaged Equip  Theft  Vandalism

Location: 10th st waford city, ND Job# 19103

Summary of Incident: excavating the ditch And struck a gas line

If Vandalism/Theft Police Notified: YES \_\_\_\_\_ NO \_\_\_\_\_ Office Name: \_\_\_\_\_ Case#: \_\_\_\_\_

If Equipment Damage: Unit # \_\_\_\_\_ Serial # \_\_\_\_\_ or VIN # \_\_\_\_\_

If Utility Hit/What Type: (Circle One)  Gas  Fiber  Electric  Phone  Cable TV  Other \_\_\_\_\_

Utility Company Name: M DU Utility Notified: yes

Utility Company On Site: YES \_\_\_\_\_ NO  GSOC Ticket # 19101611 Last Date Locate: 8-13

Utility Marked With: Paint  Flags

Do you feel we are at fault for this damage? YES  NO \_\_\_\_\_

Explain: Gas was marked and we dug potholes to locate the line  
But the operator lost track of where it was and struck the gas

If Off Marks, How far/What Direction(s): \_\_\_\_\_

**DON'T FORGET TO TAKE PICTURES- IF YOU CAN EMAIL THEM TO: [denise@wagnerconstructioninc.com](mailto:denise@wagnerconstructioninc.com)**

Date and Time Pictures were Taken: 8-20-19 9 pm

Pictures Taken By: Paul Geving

**On the back of this paper, please provide a sketch of the damaged area, including placement of marking and any witnesses names(s) and phone number(s).**

Signature: *Paul Geving* Date: 8-20-19






158

| SPEC CODE | BID ITEM                            | UNIT | QUANTITY |
|-----------|-------------------------------------|------|----------|
| 202 174   | REMOVAL OF PIPE ALL TYPES AND SIZES |      |          |
|           | STA 104+26 LT                       | LF   | 56       |
|           | STA 105+20 LT                       | LF   | 52       |
|           | STA 106+95 LT                       | LF   | 41       |
| 714 4097  | PIPE CONDUIT 15IN-STORM DRAIN       |      |          |
|           | 2A TO 2B                            | LF   | 30       |
| 714 4097  | PIPE CONDUIT 18IN-STORM DRAIN       |      |          |
|           | 2B TO 106+00, 30' LT                | LF   | 14       |
| 714 4112  | PIPE CONDUIT 30IN-STORM DRAIN       |      |          |
|           | STA 104+33 LT                       | LF   | 102      |
|           | STA 105+20 LT                       | LF   | 70       |
|           | STA 106+93 LT                       | LF   | 56       |
| 722 3510  | INLET-TYPE 2                        |      |          |
|           | 2B                                  | EA   | 1        |
| 722 4060  | INLET MOUNTABLE CURB-TYPE B         |      |          |
|           | 13A                                 | EA   | 1        |
|           | 2A                                  | EA   | 1        |
| 750 1000  | DRIVEWAY CONCRETE                   |      |          |
|           | STA 104+33 LT                       | SY   | 25.4     |
|           | STA 105+20 LT                       | SY   | 25.4     |
|           | STA 106+93 LT                       | SY   | 43.7     |

DESIGNED BY: GDC  
 DRAWN BY: GDC  
 DATE PRINTED: 03/18/19


| DATE     | REVISION                |
|----------|-------------------------|
| 03/18/19 | 1 PIPE LENGTH 104+33 LT |
|          | 2                       |
|          | 3                       |
|          | 4                       |

SHEET DESCRIPTION: PLAN AND PROFILE 10TH ST SW  
 PROJECT NAME: 10th ST SW & PARK AVE RECONSTRUCTION  
 PROJECT NO.: N16-W1011

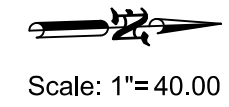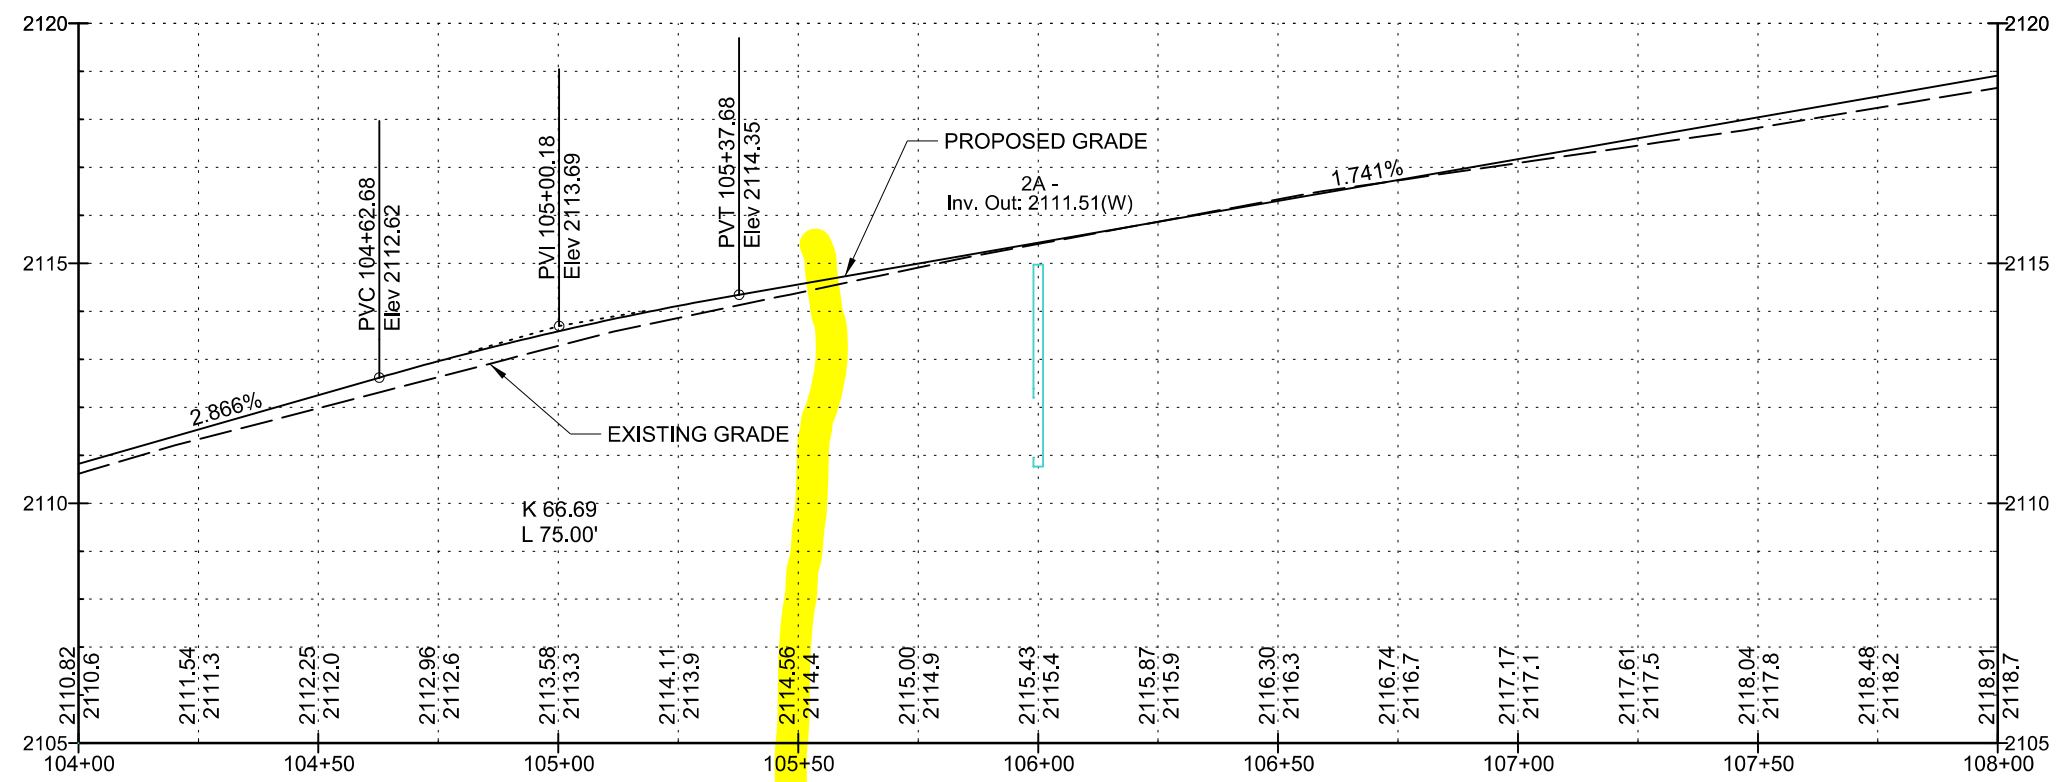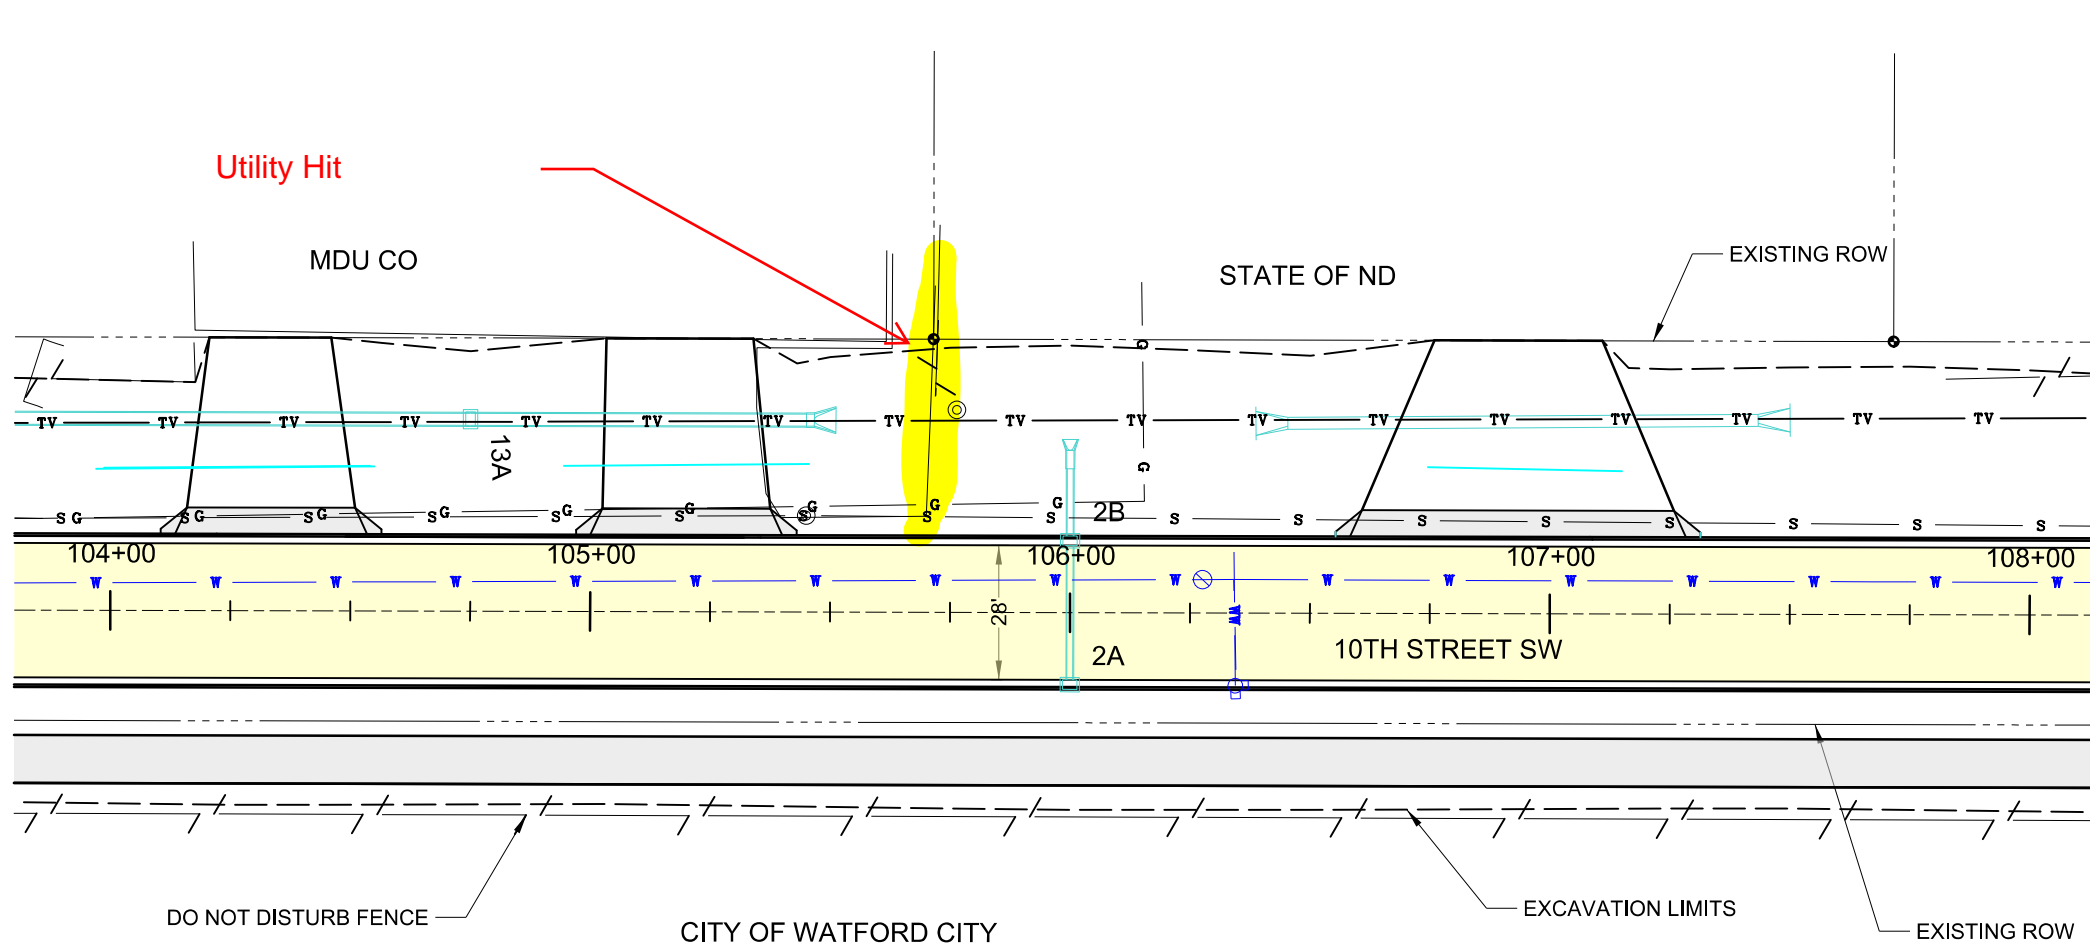

Scale: 1"= 40.00




This document was originally issued and sealed by  
 Gayle D Cox  
 Registration Number PE-10597,  
 on 03/18/19 and the original document is stored at the office of Brosz Engineering, Watford City, ND.

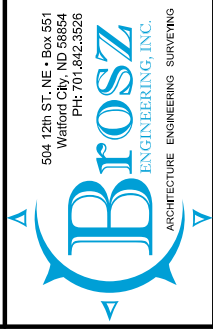

DESIGNED BY: GDC  
 DRAWN BY: GDC  
 DATE PRINTED: 02/28/19

| REVISION | DATE     |
|----------|----------|
| 1        | xx/xx/xx |
| 2        |          |
| 3        |          |
| 4        |          |

SHEET DESCRIPTION: CROSS SECTIONS 10TH ST SW  
 PROJECT NAME: 10th ST SW & PARK AVE RECONSTRUCTION  
 PROJECT NO.: N16-W1011

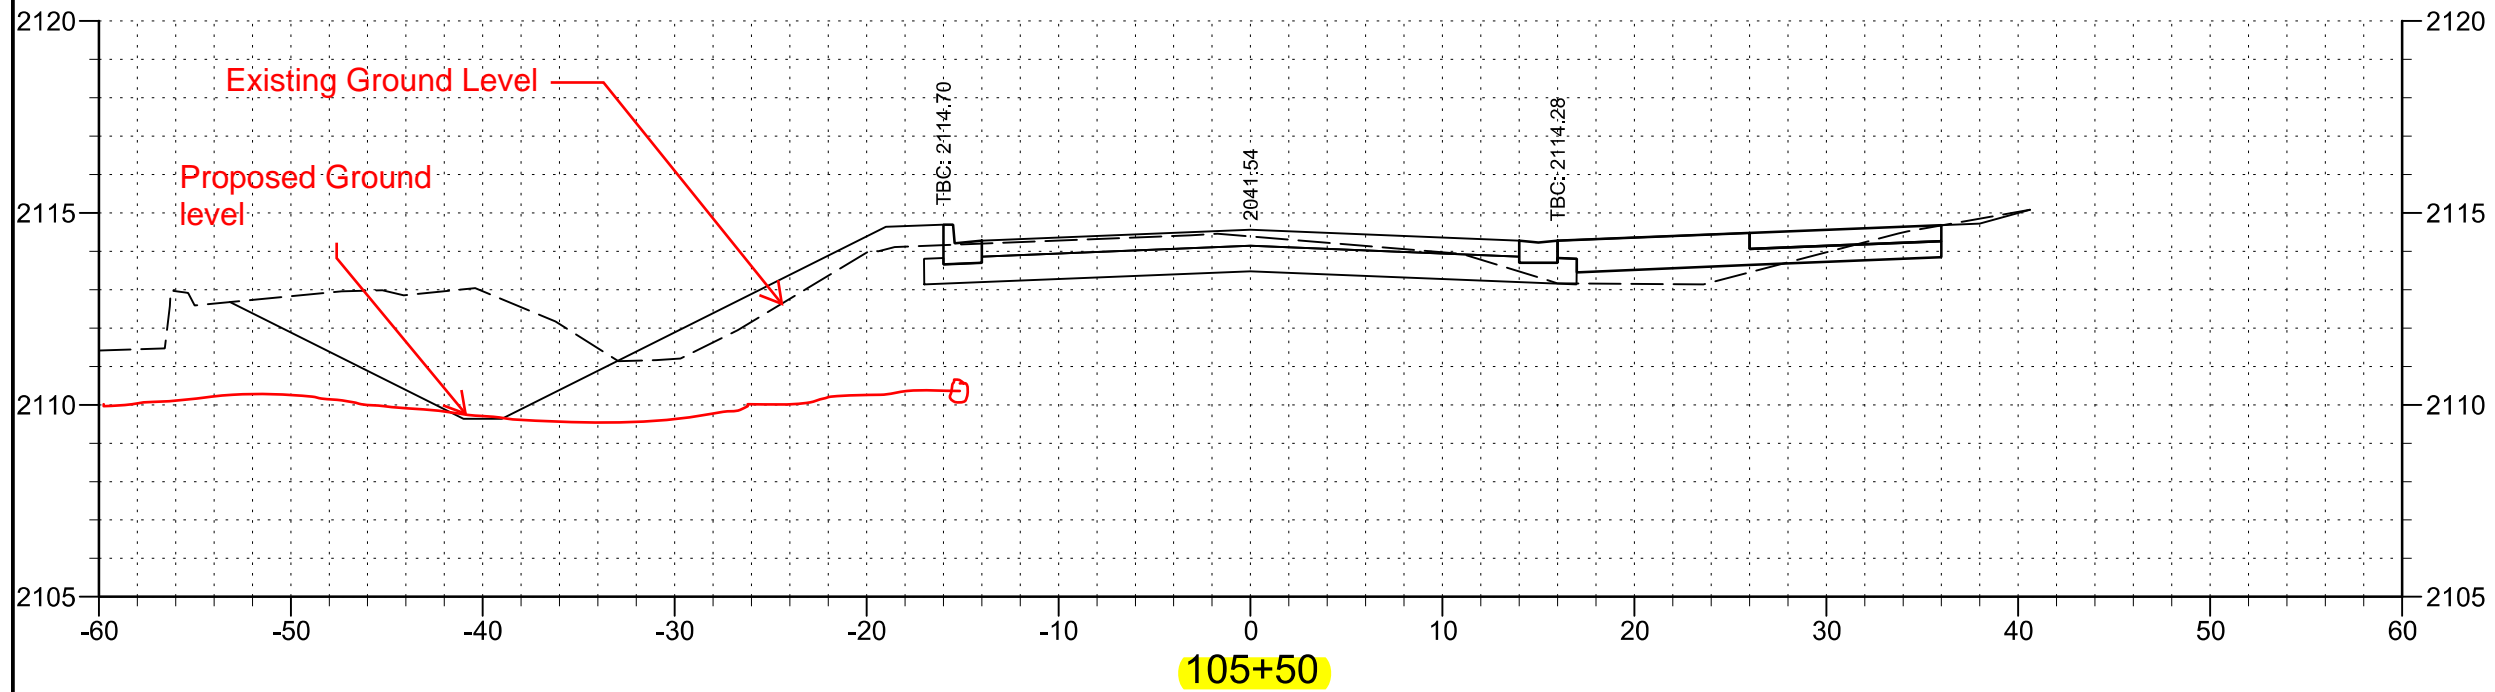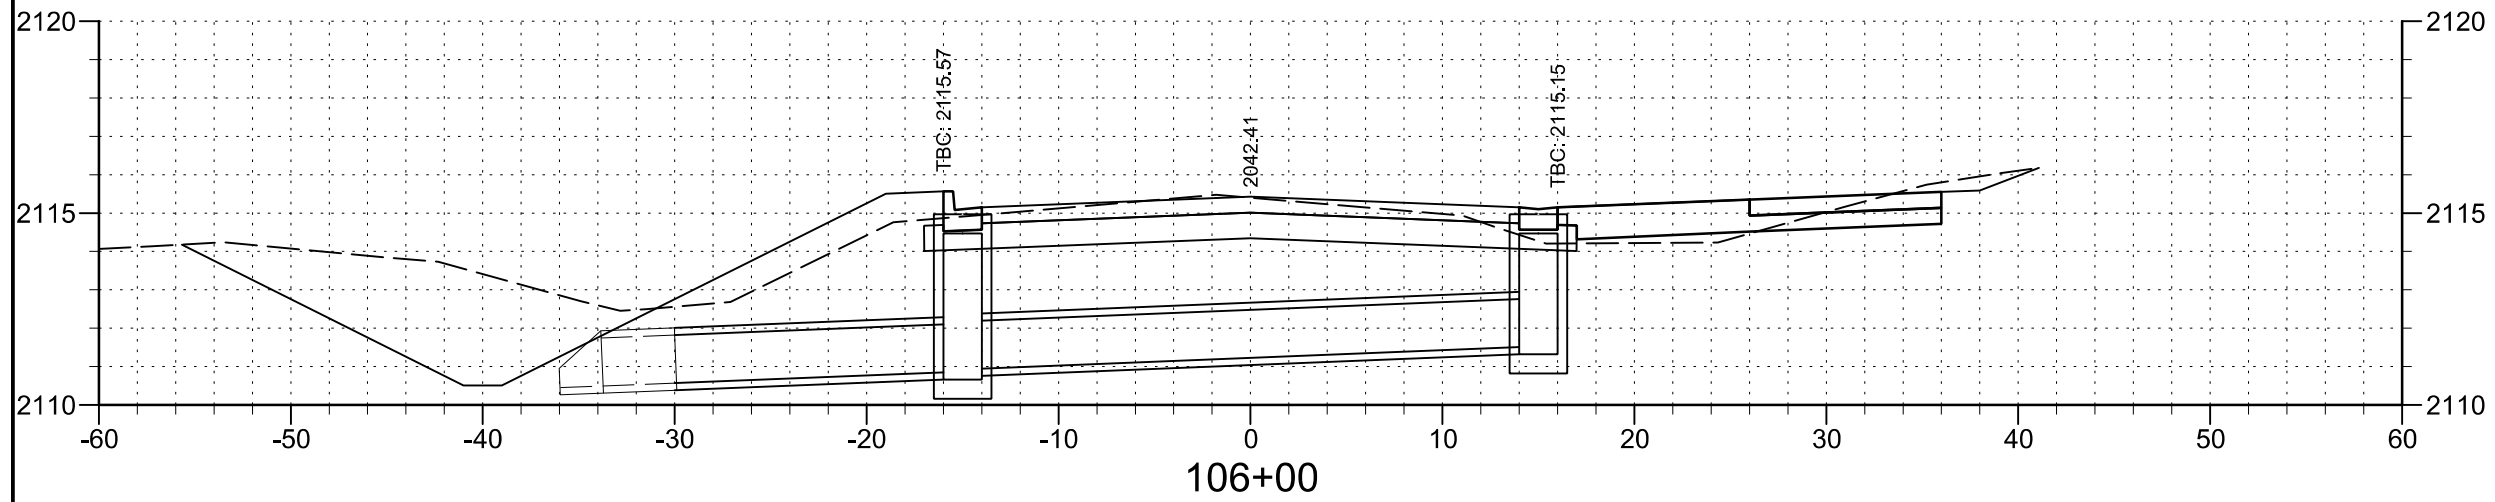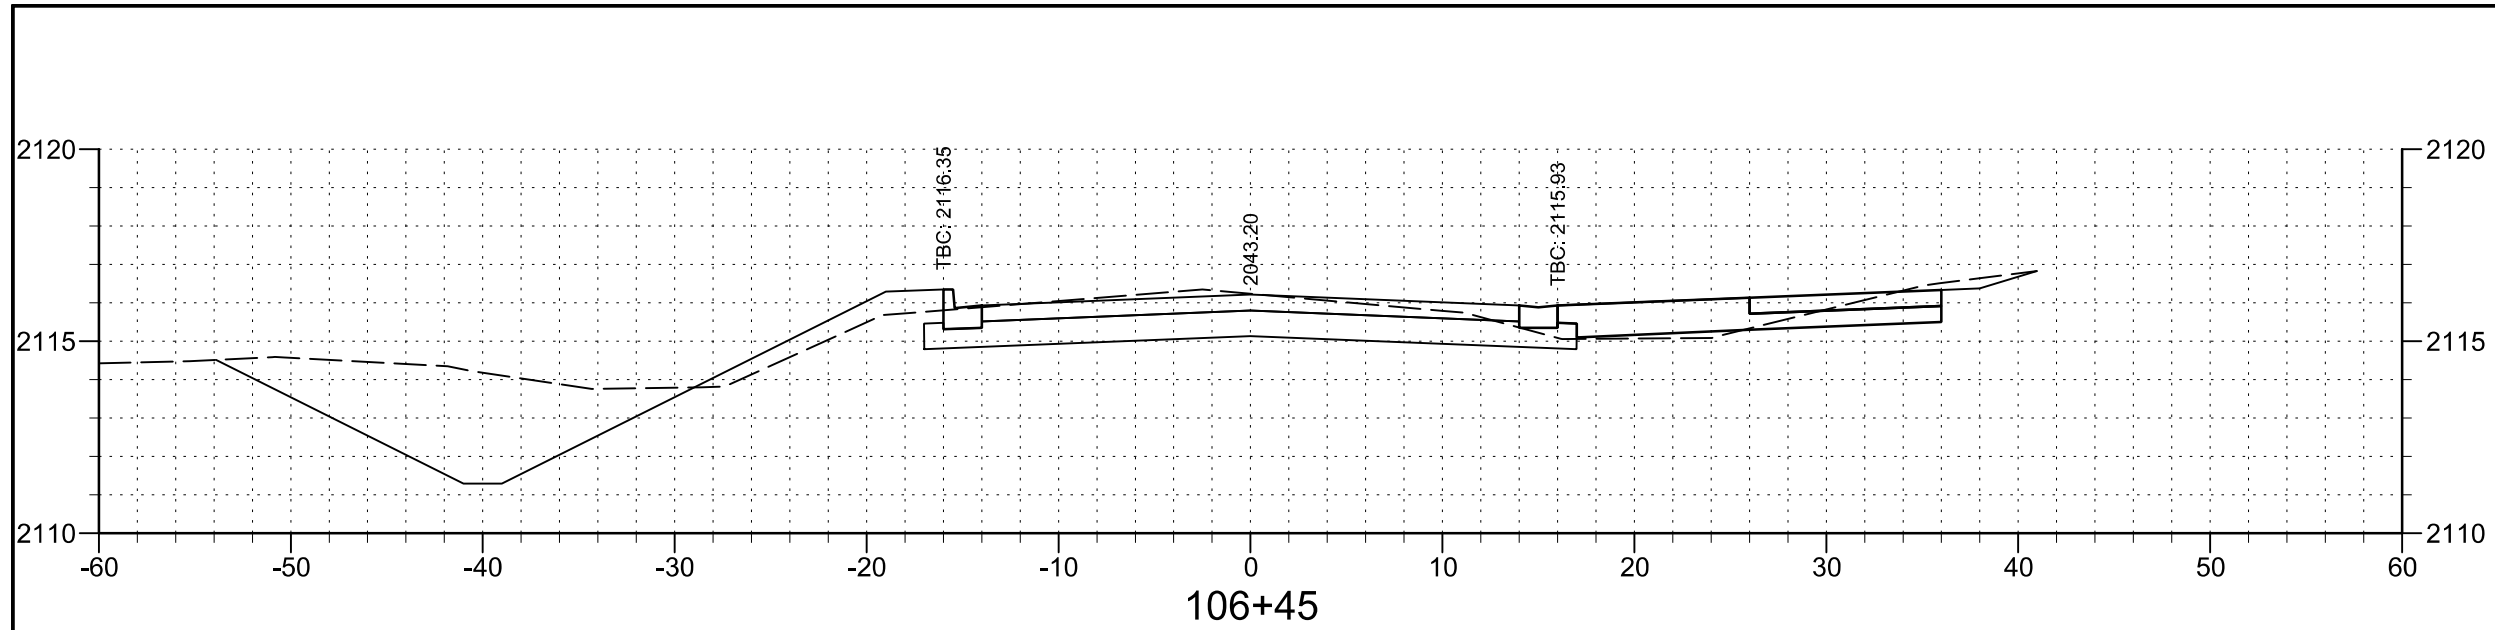

This document was originally issued and sealed by  
 Gayle D Cox  
 Registration Number  
 PE-10597,  
 on 02/28/19 and the original document is stored at the office of Brosz Engineering, Watford City, ND.

