


**APPENDIX A
SITE PLOT PLAN AND EQUIPMENT LISTS**

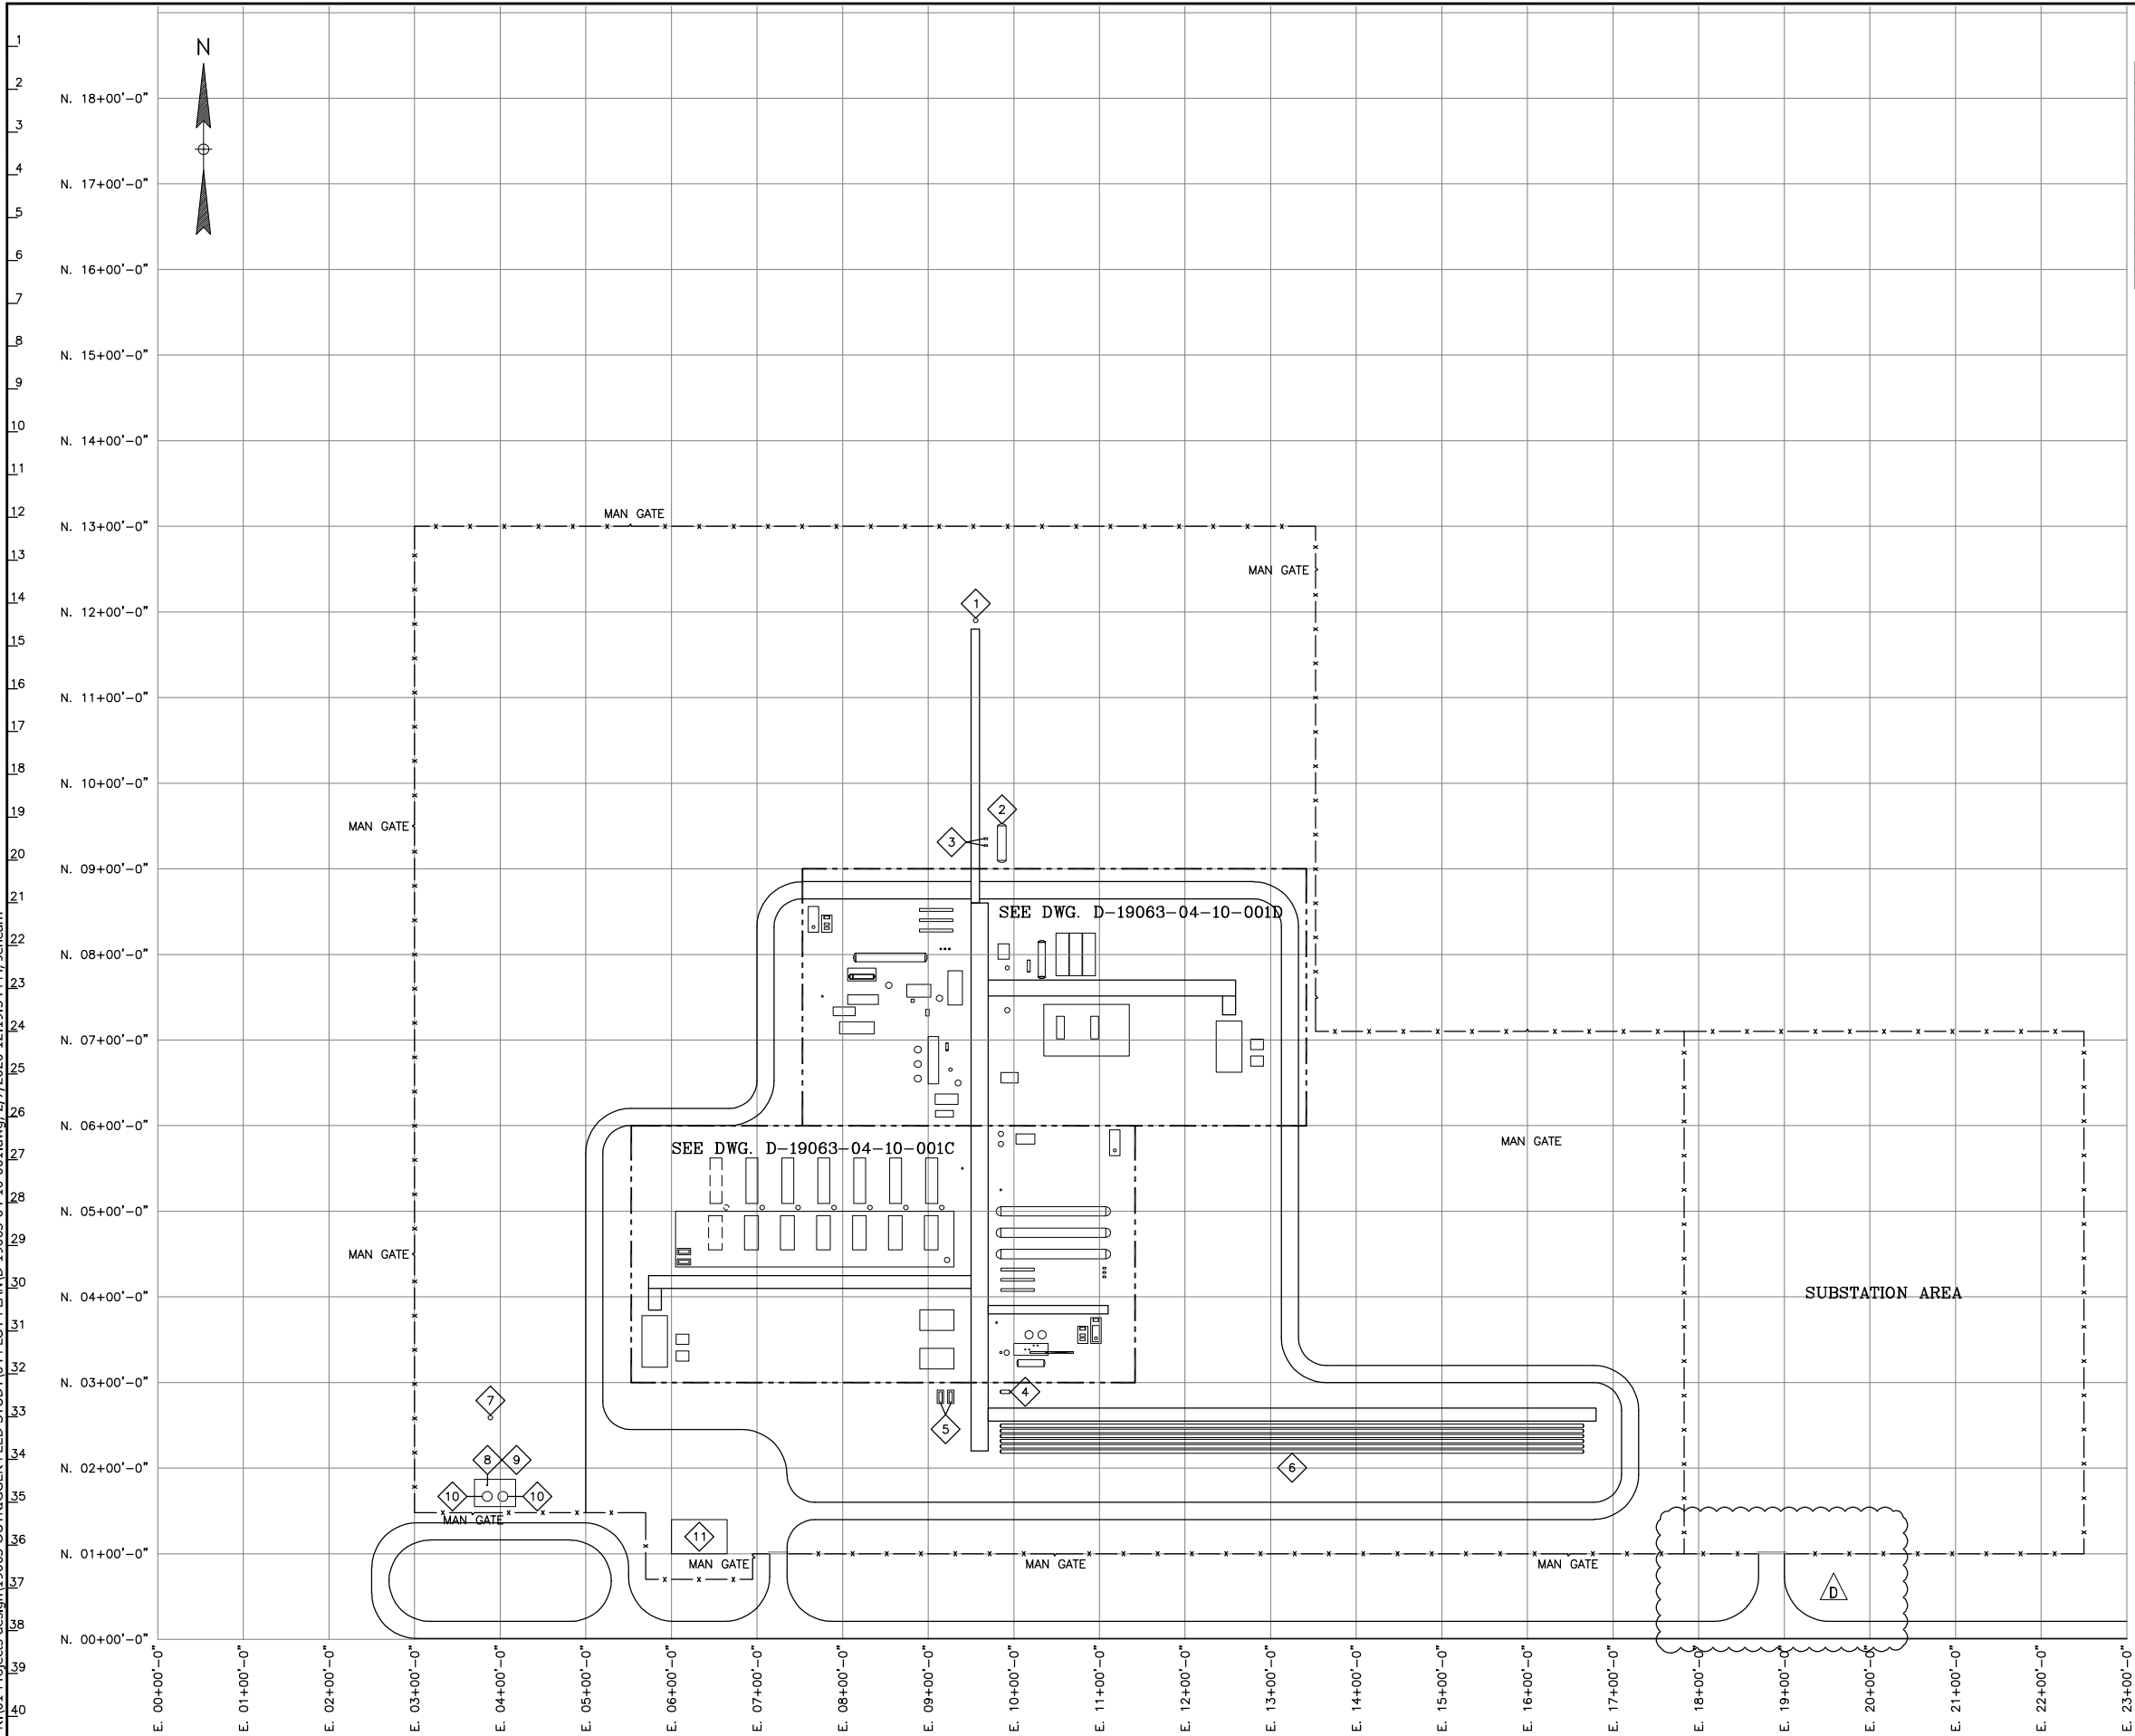

R:\01-Projects\design\19063_OUTRIGGER_FEED_STUDY\04_PLOT_PLAN\19063-04-10-001.dwg, 2/7/2020 12:19:34 PM, jehnam



MARK	DESCRIPTION
1	FLARE STACK
2	FLARE K.O. DRUM
3	FLARE K.O. DRUM PUMP
4	CLOSED DRAIN FLASH TANK
5	STABILIZER COMPRESSOR L.O. TANKS
6	HARP SLUG CATCHER
7	TANK FARM FLARE
8	TANK FARM FLARE K.O.
9	TANK FARM FLARE K.O. PUMP
10	SLOP TANK
11	CCR/WAREHOUSE

BCKK CONFIDENTIAL INFORMATION


OUTRIGGER ENERGY II, LLC.
SANDERSON PLANT

WILLIAMS COUNTY, NORTH DAKOTA

REV. DWG. No. D-19063-04-10-001B

OVERALL
PLOT
PLAN

BUSINESS CONFIDENTIAL
N. Dakota
Maplewood
(432) 685-6095

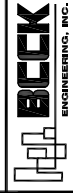

DESIGN	DRAWN	CHK.	Q. A.	CAD FILE	PLOT DATE	SCALE
JEH	JEH			D-19063-04-10-001	2/7/20	1"=100'-0"

NAME	DATE	C/S	ELECT.	INSTR.	PROCC.	MECH.	PIPING	PROJ. MGR.
JEH	12/19							
JEH	1/20							

REF. DWG. NUMBER	REFERENCE DWG. TITLE

DATE	REVISIONS
2/7/20	REVISED SUBSTATION ACCESS ROAD
2/7/20	REVISED SUBSTATION AREA
2/7/20	REVISED PER CLIENT COMMENTS
1/24/20	ISSUED FOR BID
	NO DATE

NO.	DATE	BY	DESCRIPTION
1		JEH	ISSUED FOR BID
2		JEH	ISSUED FOR BID
3		JEH	ISSUED FOR BID
4		JEH	ISSUED FOR BID
5		JEH	ISSUED FOR BID
6		JEH	ISSUED FOR BID
7		JEH	ISSUED FOR BID
8		JEH	ISSUED FOR BID
9		JEH	ISSUED FOR BID
10		JEH	ISSUED FOR BID
11		JEH	ISSUED FOR BID

R:\01-Projects\design\19063_OUTRIGGER_FEED_STUDY\04 PLOT PLAN\19063-04-10-001.dwg, 2/3/2020 2:33:13 PM, Jhearn




MARK	DESCRIPTION
38	DEHY INLET SCRUBBER
39	DEHY INLET COALESCING FILTER
40	DEHY VALVE SKID (402)
41	DEHYDRATOR
42	DEHYDRATOR DUST FILTER
43	REGEN GAS COMPRESSOR SKID (404)
44	REGEN GAS COOLER
45	REBOILER SKID (504)
46	GAS/GAS EXCHANGER
47	RSV SUBCOOLER HEAT EXCHANGER
48	RSV VALVE SKID (508)

MARK	DESCRIPTION
49	DEMETHANIZER
50	COLD SEPARATOR
51	PROPANE SUBCOOLER SKID (502)
52	PROPANE CHILLER SKID (501)
53	EXPANDER VALVE SKID (507)
54	EXPANDER/COMPRESSOR
55	BOOSTER COMPRESSOR VALVE SKID (506)
56	NGL SURGE TANK
57	NGL BOOSTER PUMP
58	NGL PIPE LINE PUMP
59	CRYO AREA SUMP W/PUMP

MARK	DESCRIPTION
60	PROPANE COMP. SUCTION SCRUBBER
61	PROPANE COMPRESSOR
62	PROPANE CONDENSER
63	PROPANE ACCUMULATOR
64	PROPANE VALVE SKID (801)
65	PROPANE ECONOMIZER
66	PROPANE COMPRESSOR BUILDING
67	TRANSFORMER
68	PDC #2 BUILDING
69	G.C. BUILDING
70	TRIM REBOILER HOT OIL PACKAGE
71	PROPANE STORAGE TANK

REF. DWG. D-19063-04-10-001B

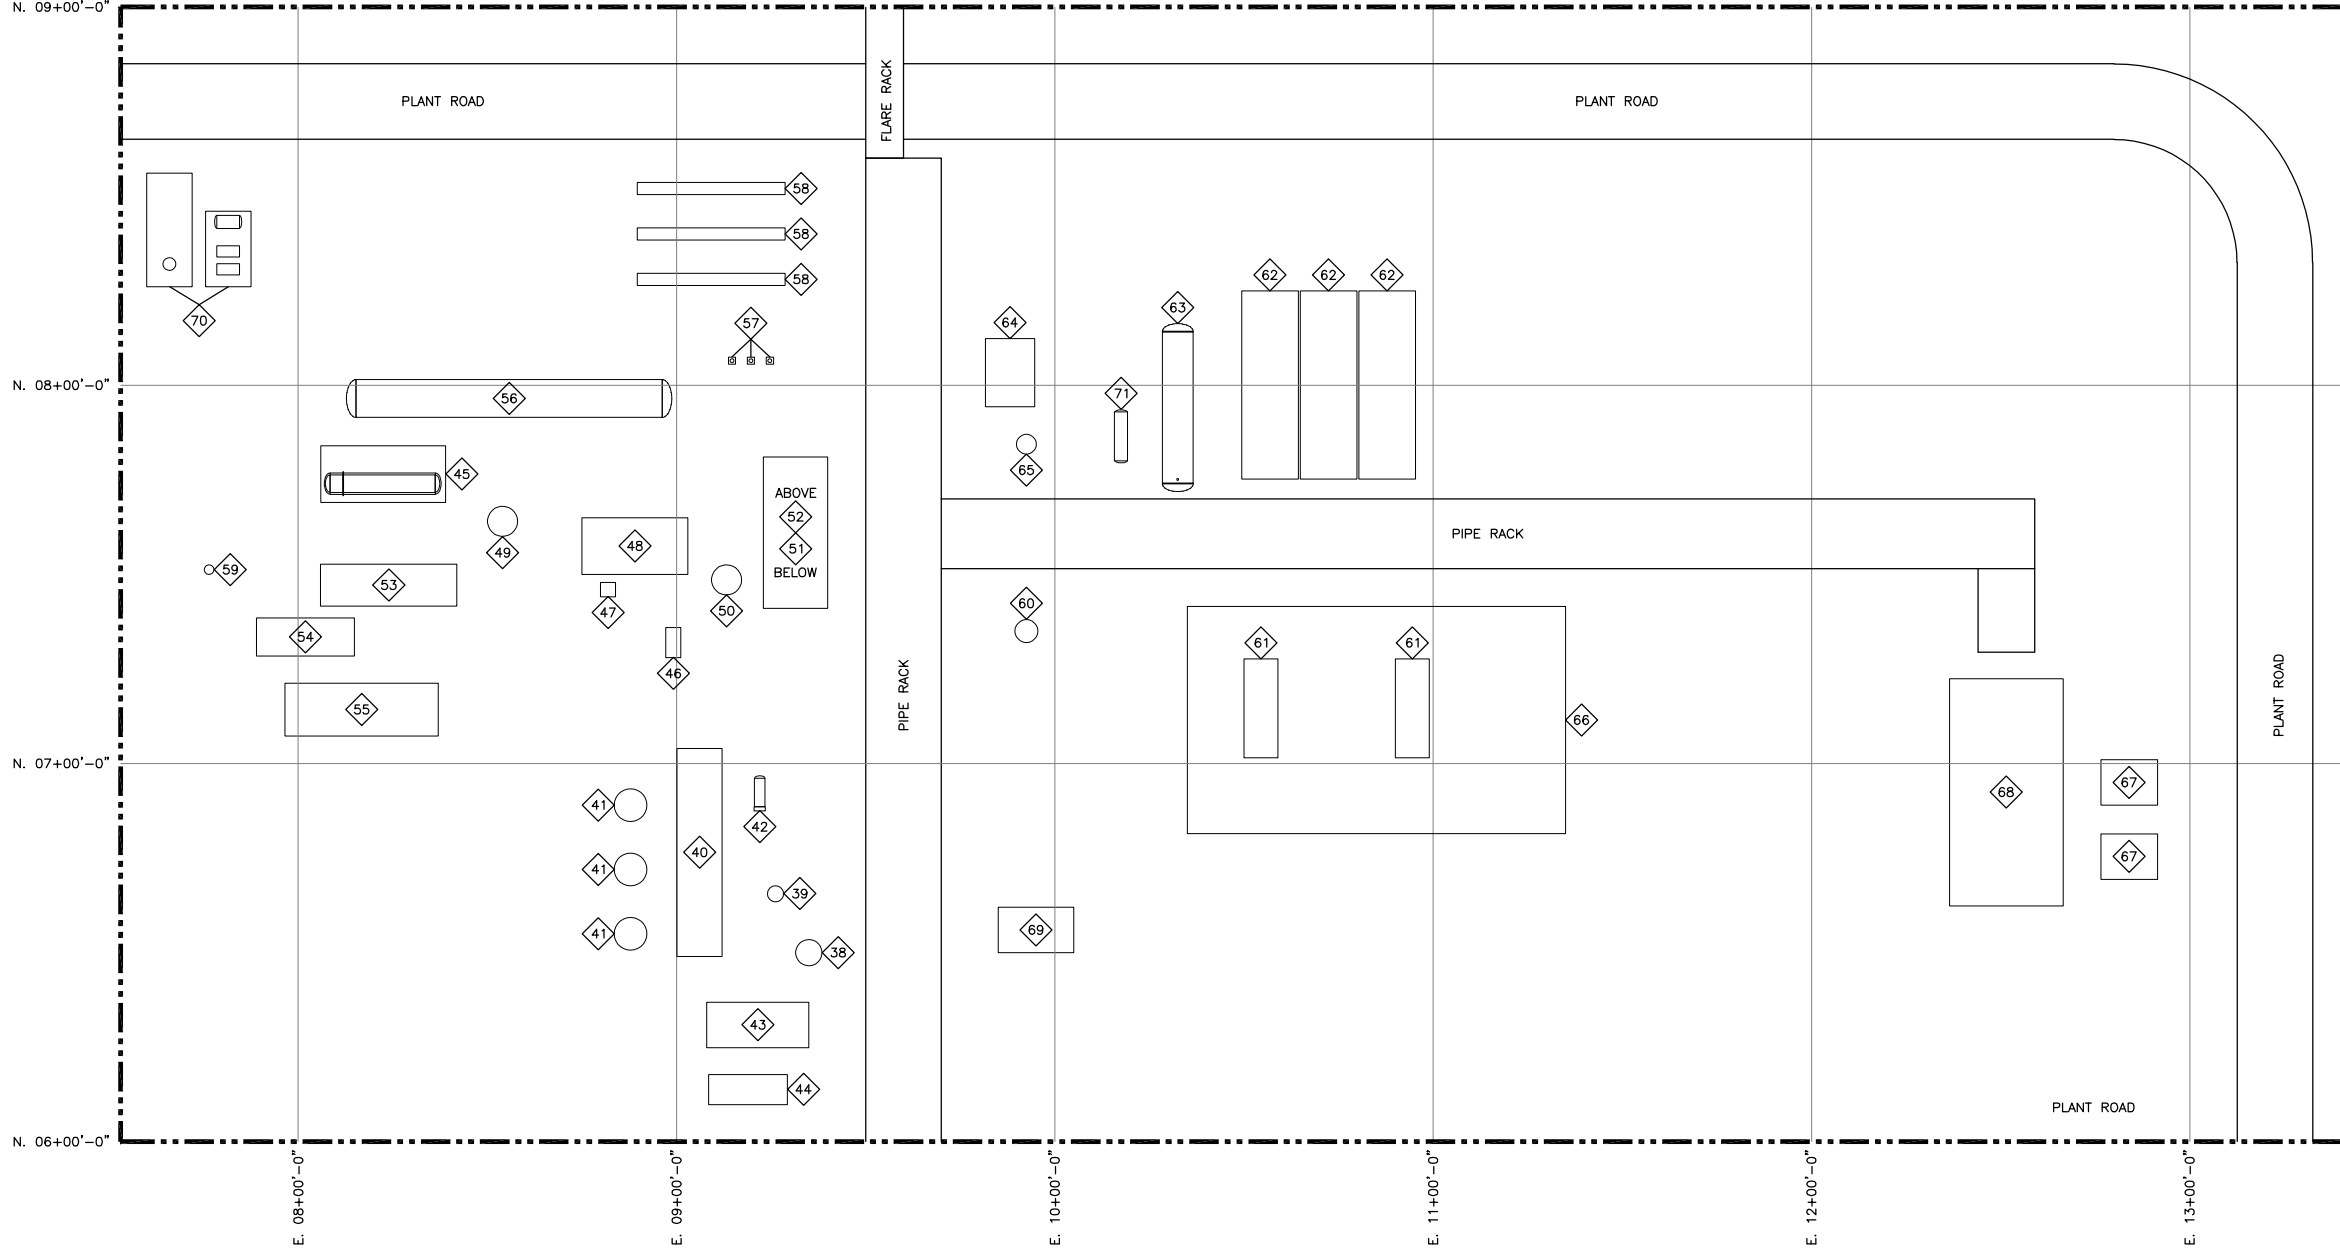

BCCK CONFIDENTIAL INFORMATION

OUTRIGGER ENERGY II, LLC.
SANDERSON PLANT
WILLIAMS COUNTY, NORTH DAKOTA
DWG. No. D-19063-04-10-001D

NORTH PROCESS AREA
PLOT
PLAN
BUSINESS CONFIDENTIAL
N. Twp. 57N, R. 70E
Meadow Lake, ND 58055
(432) 685-6095

DESIGN	DRAWN	CHK.	Q. A.	CAD FILE	PLT DATE	SCALE
JEH	JEH			D-19063-04-10-001	2/3/20	1"=25'-0"

NAME	DATE	REF. DWG. NUMBER	REFERENCE DWG. TITLE
JEH	12/19		
JEH	1/20		


REV.	DATE	BY	DESCRIPTION
B	2/3/20	JEH	REVISED PER CLIENT COMMENTS
A	1/24/20	JEH	ISSUED FOR BID
			REVISIONS



MARK	DESCRIPTION
12	RESIDUE COMPRESSOR COOLER
13	FUTURE RESIDUE COOLER
14	CONVERTER / SILENCER
15	FUTURE CONVERTER / SILENCER
16	RESIDUE COMPRESSOR
17	FUTURE RESIDUE COMPRESSOR
18	COMPRESSOR COOLANT TANK
19	RESIDUE COMPRESSOR BUILDING
20	RESIDUE COMPRESSOR AREA SUMP W/PUMP
21	INSTRUMENT AIR COMPRESSOR PACKAGE
22	AIR RECEIVERS
23	REGEN GAS HEATER
24	FUEL GAS SCRUBBER

MARK	DESCRIPTION
25	STABILIZER PRODUCT STORAGE TANK
26	STABILIZER PRODUCT BOOSTER PUMP
27	STABILIZER PRODUCT PIPELINE PUMP
28	STABILIZER SAYBOLT FILTER
29	STABILIZER SKID
30	STABILIZER THREE PHASE SEPARATOR
31	STABILIZER COLUMN/SURGE TANK
32	STABILIZER REBOILER
33	STABILIZER AREA SUMP W/PUMP
34	STABILIZER HOT OIL PACKAGE
35	STABILIZER OVERHEAD COMPRESSOR
36	TRANSFORMER
37	PDC #2 BUILDING

REF. DWG. D-19063-04-10-001B

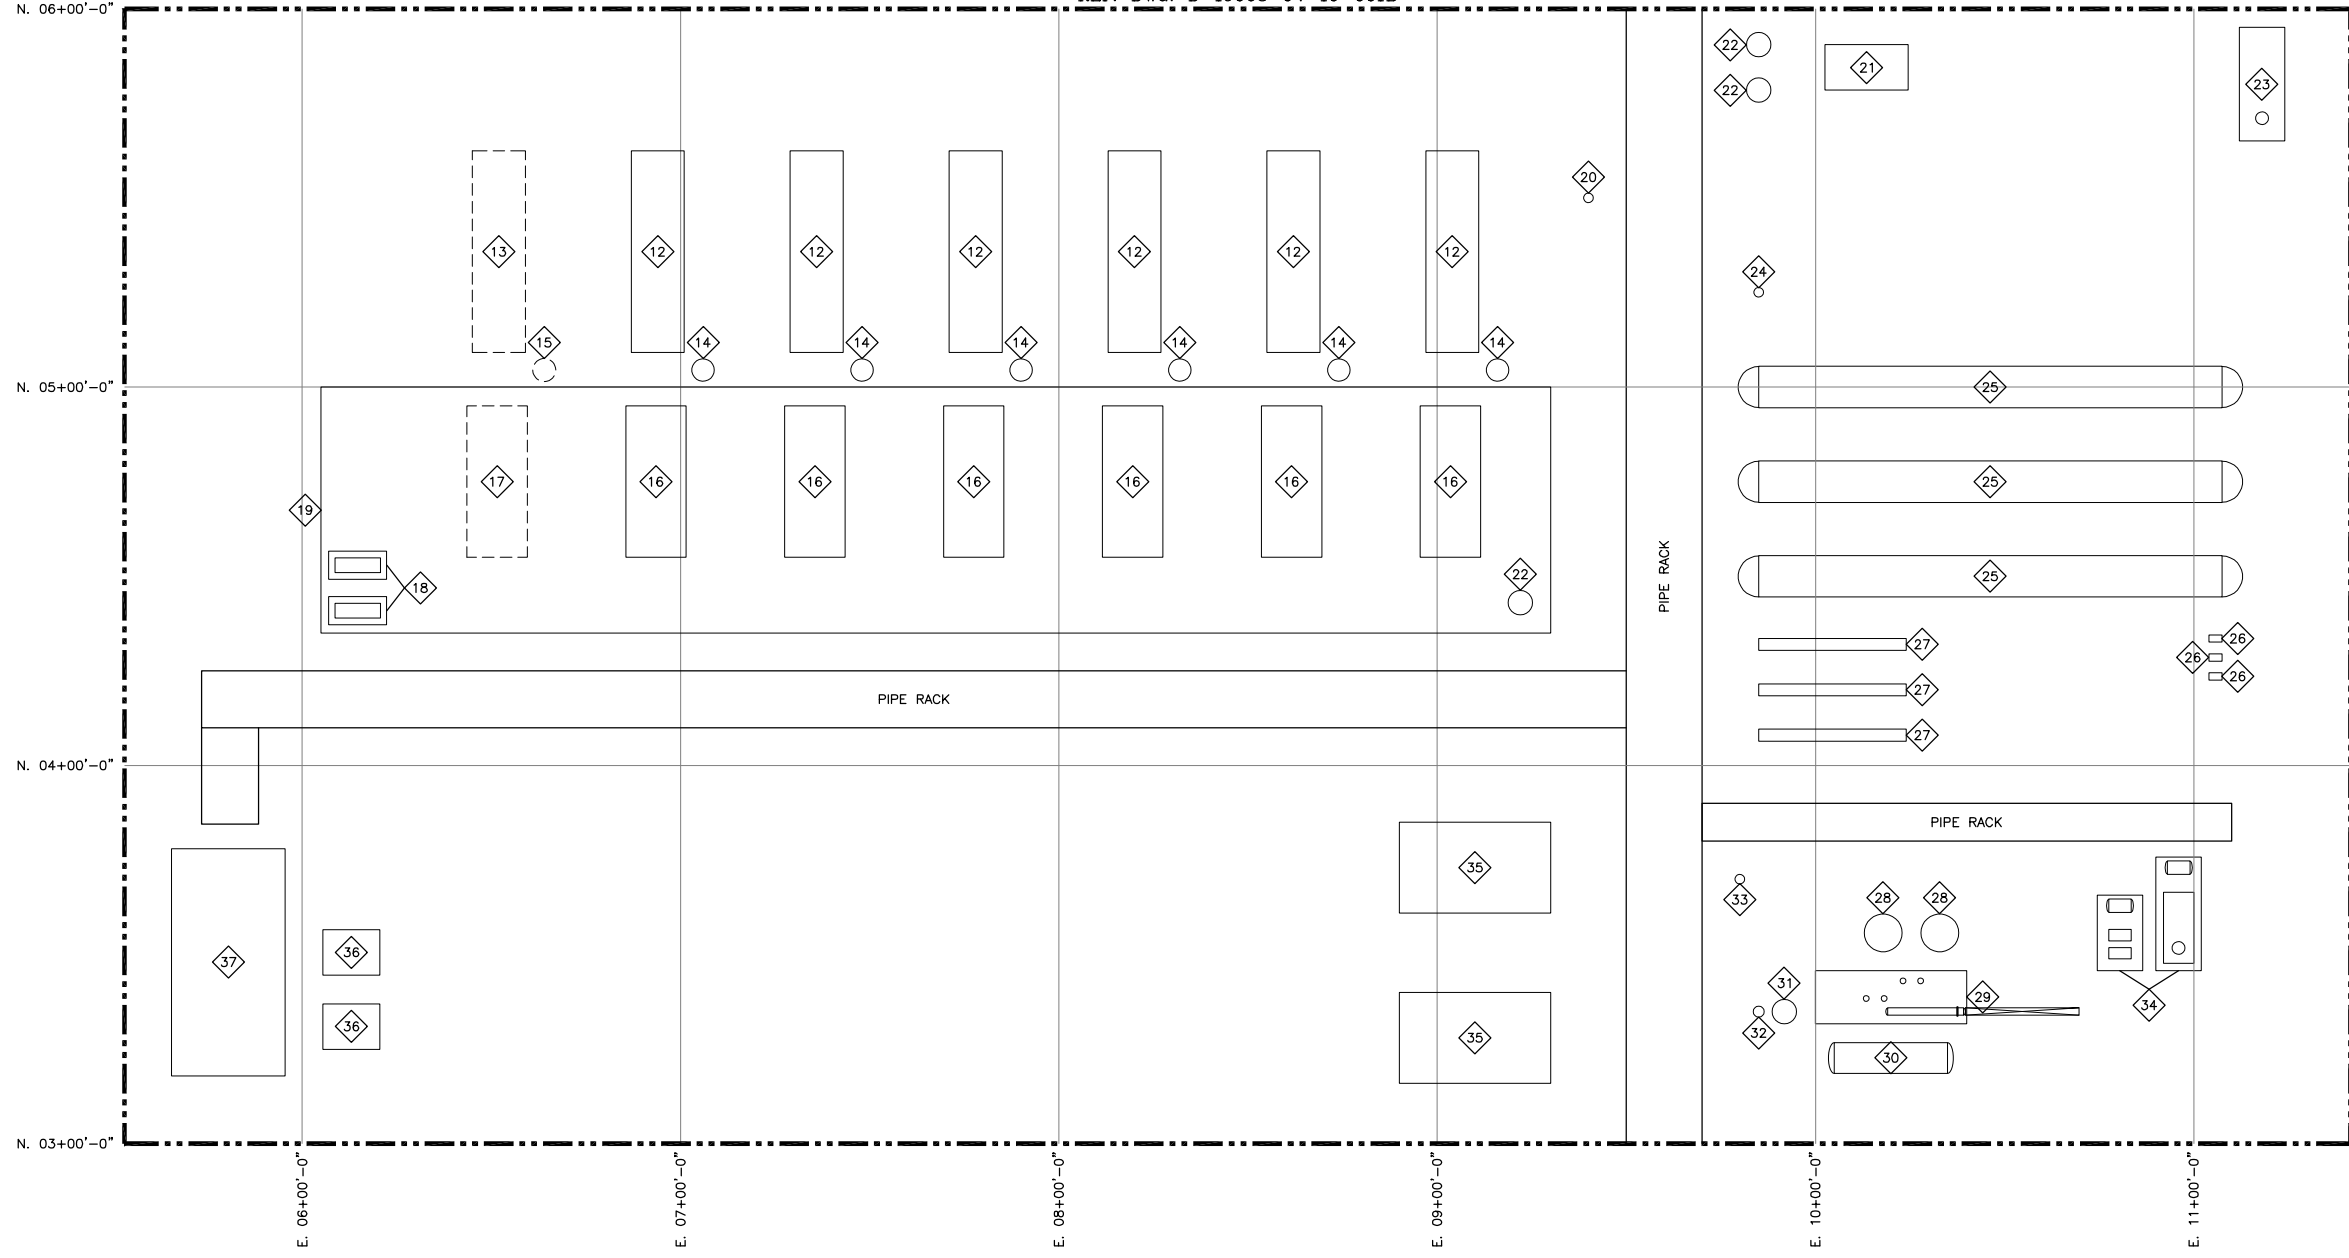

BCCK CONFIDENTIAL INFORMATION

OUTRIGGER ENERGY II, LLC.
SANDERSON PLANT

WILLIAMS COUNTY, NORTH DAKOTA

REV. DWG. No. D-19063-04-10-001C

SOUTH PROCESS AREA
PLOT
PLAN

BUSINESS CONFIDENTIAL
N. Texas 79706
Midland (432) 685-6095



REV.	DATE	BY	CHK.	APP.	DESCRIPTION
B	1/24/20	JCH	RWD	JCH	ISSUED FOR BID
A	1/24/20	JCH	RWD	JCH	REVISED PER CLIENT COMMENTS
B	2/3/20	JCH	RWD	JCH	REVISED PER CLIENT COMMENTS

NO.	DATE	NO.	DATE	NO.	DATE
1		1		1	
2		2		2	
3		3		3	
40		40		40	