

MDU Heskett Station Water Line – Final Construction Project Report

Case No. PU-22-34

1 February 2023

Project Overview – The MDU Heskett Station water line is a new construction waterline that will tie into the City of Mandan water main to supply fire protection and service water to the Heskett Combustion Turbine site.

Monthly Progress – Carstensen Contracting Incorporated (CCI) has completed 100% of main waterline. All connections on MDU property have been completed and the line was isolated from the Heskett intake. The permanent water meter has been installed and is operational only needing the City of Mandan to program with their Sensus representative. At this time the Project is complete although the BMP's will remain in place until the grass has been established in the spring.

Environmental – BMPs were inspected and maintained as detailed in the SWPPP. No Environmental concerns to note.

Cultural Impacts – No items to report.

Damage to UG Facilities – No Items to report


Landowner/Public Issues or Complaints – No items to report.

Permitting – No items to report.

Extraordinary Events – No items to report.

Safety – No items to report.

Additional Information – Attached is a map showing the location of the water line as built. As built GIS shape files were submitted electronically on February 1, 2023.

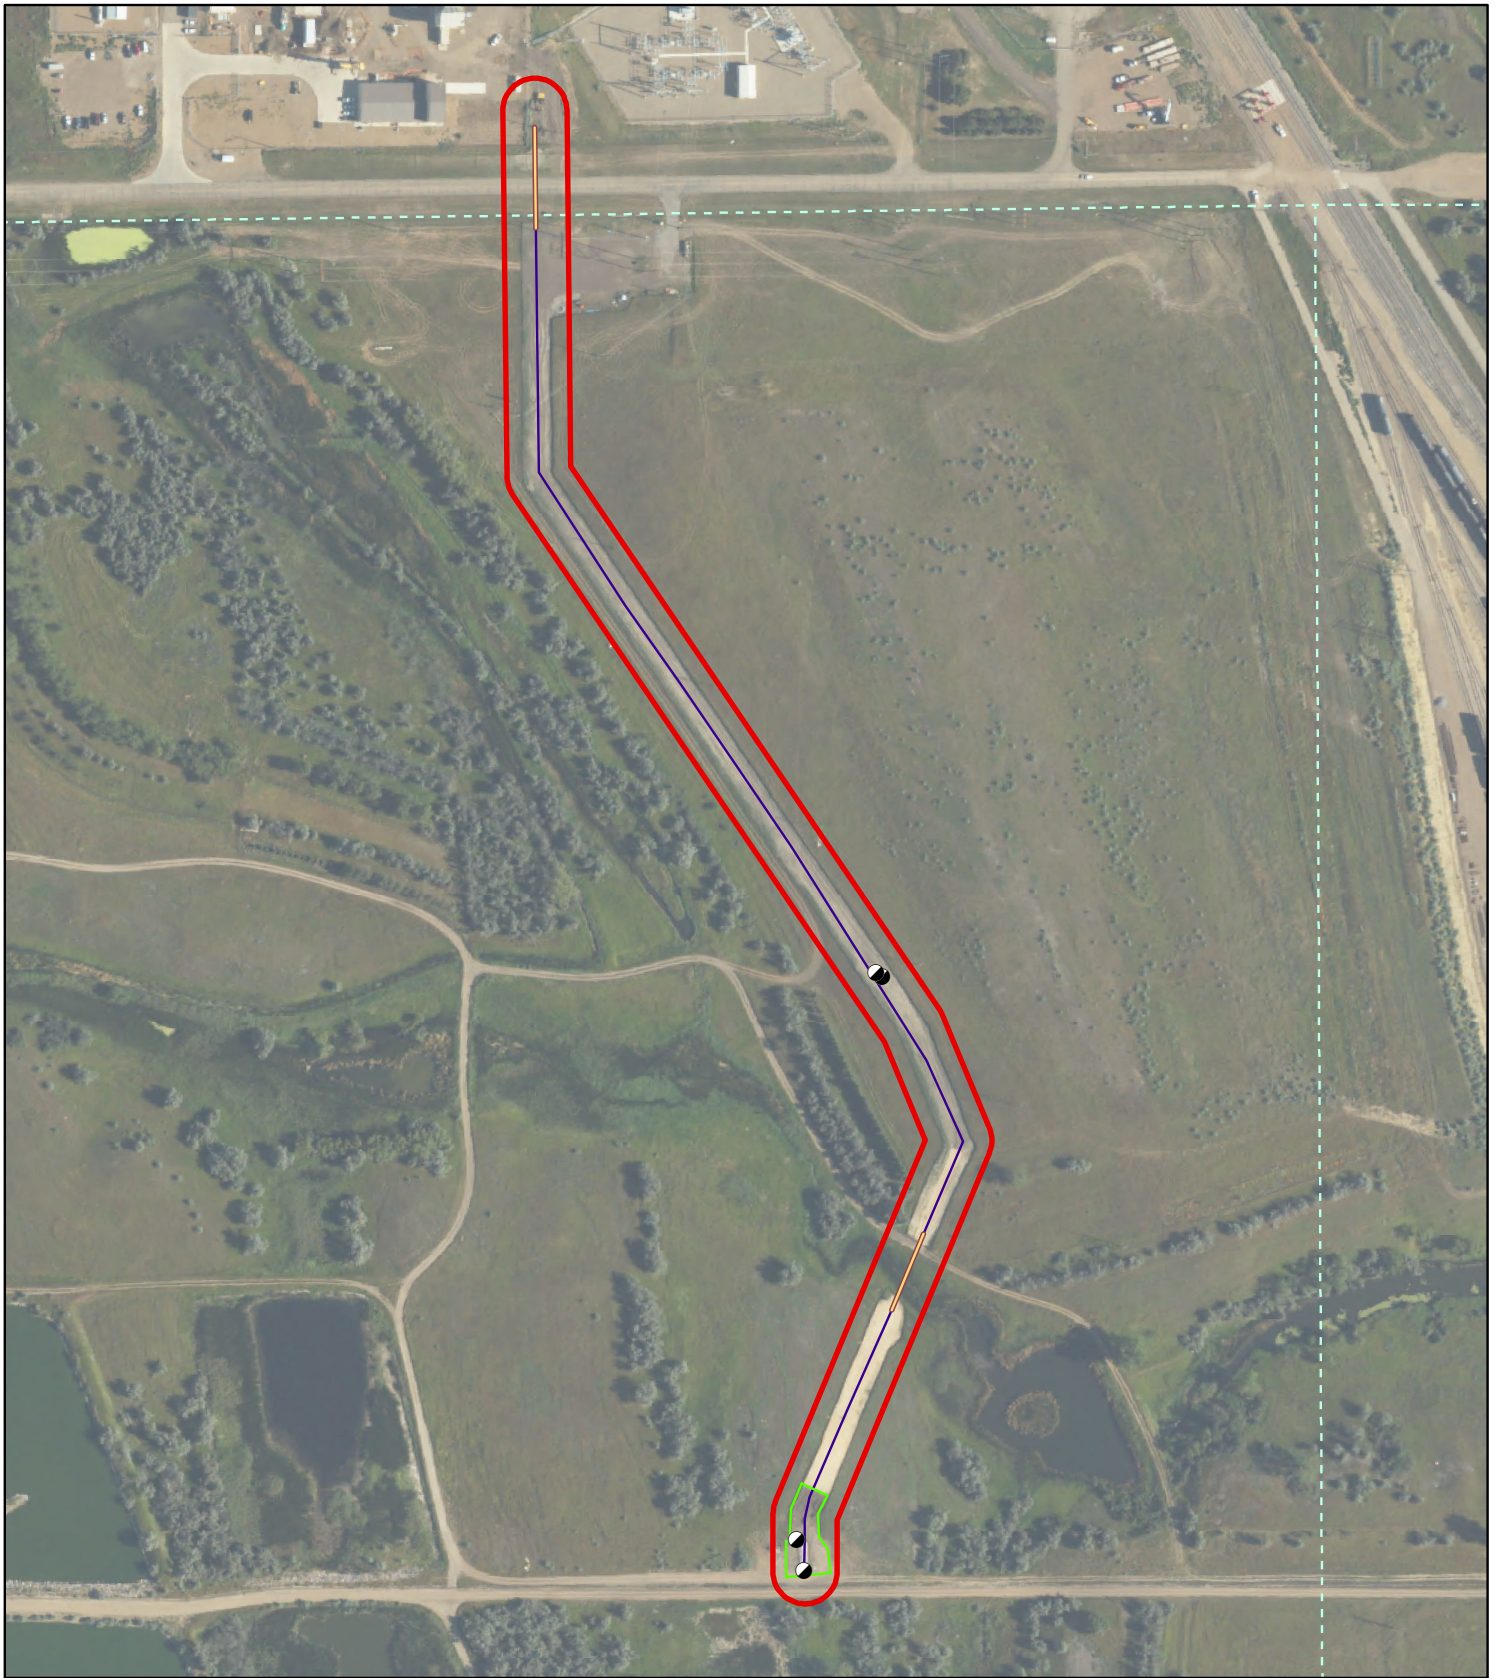

Project Data Projection: North Dakota
State Plane, South Zone, NAD83, US Feet

Imagery Source: ©2022 NAIP-FSA-USDA



KLJ Project Number: 2109-01109

Date Created: 12/13/2022

Created By: jeffprice

Heskett Fire Water Line Montana-Dakota Utilities Co. Morton County, ND

Exhibit 11: As-Built

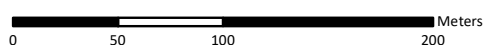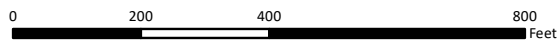

1:3,600

- As-Built Line
- Gravel Pad
- HDD Bore
- Valve
- 100' Corridor