


EXHIBIT C
(cont'd)

APH Farms

Section 10-T140N-R83W

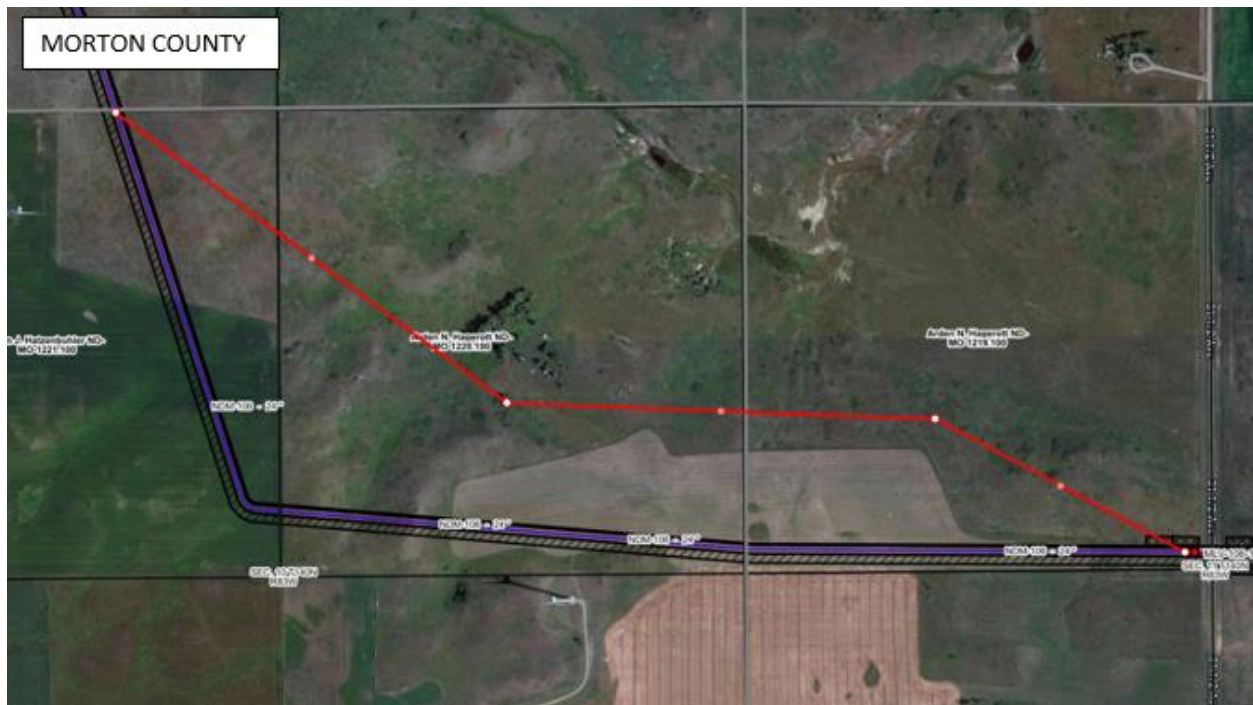

LO #56
PU-22-391

714 PU-22-391 Filed 07/01/2024 Pages: 1
LO Exhibit LO-56 - Summit Re-Route Map (Dkt.
#603)
Knoll Leibel, LLP, on behalf of the Intervenor