

March 27, 2023

Via Electronic Mail & Hand Delivery

Mr. Steve Kahl
Executive Director
North Dakota Public Service Commission
600 E. Boulevard, Dept. 408
Bismarck, ND 58505-0480
ndpsc@nd.gov

In re: Alexander Connector, LLC
Certification Relating to N.D.C.C. § 49-22.1-01(3)(a)
Case No. PU-15-232
Our File No. 131097-000002

Dear Mr. Kahl:

On behalf of Alexander Connector, LLC, enclosed for filing in the above-referenced matter are eight copies of the Certification Relating to N.D.C.C. § 49-22.1-01(3)(a).

Please feel free to call should you have any questions or would like to discuss. Thank you.

Sincerely,



Casey A. Furey

CAF/lh
Enc.

cc: Wade Mann (via email)
John Schuh (via email)
Brian Johnson (via email)

BEFORE THE STATE OF NORTH DAKOTA
PUBLIC SERVICE COMMISSION

Alexander Connector, LLC
12-inch Crude Oil Pipeline – McKenzie County
Siting Exclusion Certification

Case No. PU-15-232

CERTIFICATION RELATING TO N.D.C.C. § 49-22.1-01(3)(a)

STATE OF TEXAS

ss.

DECLARATION OF
TRAVIS ROBY

COUNTY OF HARRIS

The undersigned, Travis Roby, hereby states as follows:


1. I am the Chief Executive Officer of Alexander Connector, LLC (“Alexander Connector”), with authority to bind Alexander Connector to the following, and hereby certify the below information is true and correct to the best of my knowledge and belief.
2. On October 14, 2015, in Case No. PU-15-232, the North Dakota Public Service Commission (“Commission”) approved Findings of Fact, Conclusions of Law and Order issuing NST Express, LLC (n/k/a Alexander Connector) Certificate of Corridor Compatibility No. 173 (“Certificate”) and Route Permit No. 185 (“Permit”) for an approximate 23-mile, 12-inch diameter crude oil pipeline and associated facilities in McKenzie County, North Dakota (the “Pipeline”). Case No. PU-15-232, Docket No. 35. The Pipeline originates at a gathering facility approximately nine miles north of Alexander, North Dakota and terminates at a crude terminal located approximately 0.5 miles north of East Fairview, North Dakota.
3. On September 7, 2022, the Commission reissued the Certificate and Permit consistent with NST Express, LLC’s name change to Alexander Connector. Case No. PU-22-345.
4. Alexander Connector proposes to install a new blend facility (the “Blend Facility”) within the 42-acre site referred to as the Alexander Terminal that was permitted under the Certificate. The Blend Facility will consist of two 3,000-barrel crude tanks, one 90,000-gallon bullet, pump skids, and interconnecting pipe. Light and/or heavy hydrocarbons will be trucked in and offloaded into their respective tanks. These hydrocarbons will be mixed with the crude from the two existing 80,000-barrel tanks. This will take place downstream of the 80,000-barrel tanks before the Alexander Connector custody transfer meter. Exhibit A attached hereto is a plot plan depicting the location of the Blend Facility within the certificated corridor.
5. The Blend Facility will optimize storage at Alexander Terminal and segregate lighter and heavy hydrocarbons from being stored in the existing 80,000-barrel tanks.



6. Activities for installation of the Blend Facility will not affect a known exclusion or avoidance area.
7. The activities are for improvements to system operations associated with the existing liquid transmission facility.
8. Alexander Connector will continue to comply with all applicable conditions and protections in siting laws and rules and Commission orders previously issued for the Pipeline.
9. Alexander Connector intends to begin activities for the construction of the Blend Facility on or around April 1, 2023.

I declare, under the penalty of perjury under the law of North Dakota, that the foregoing is true and correct.

Singed on this 27th day of March 2023, at Harris County, Texas, United States of America.

Alexander Connector, LLC

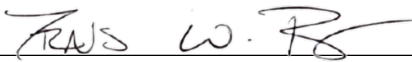By: 
Travis Roby
Chief Executive Officer

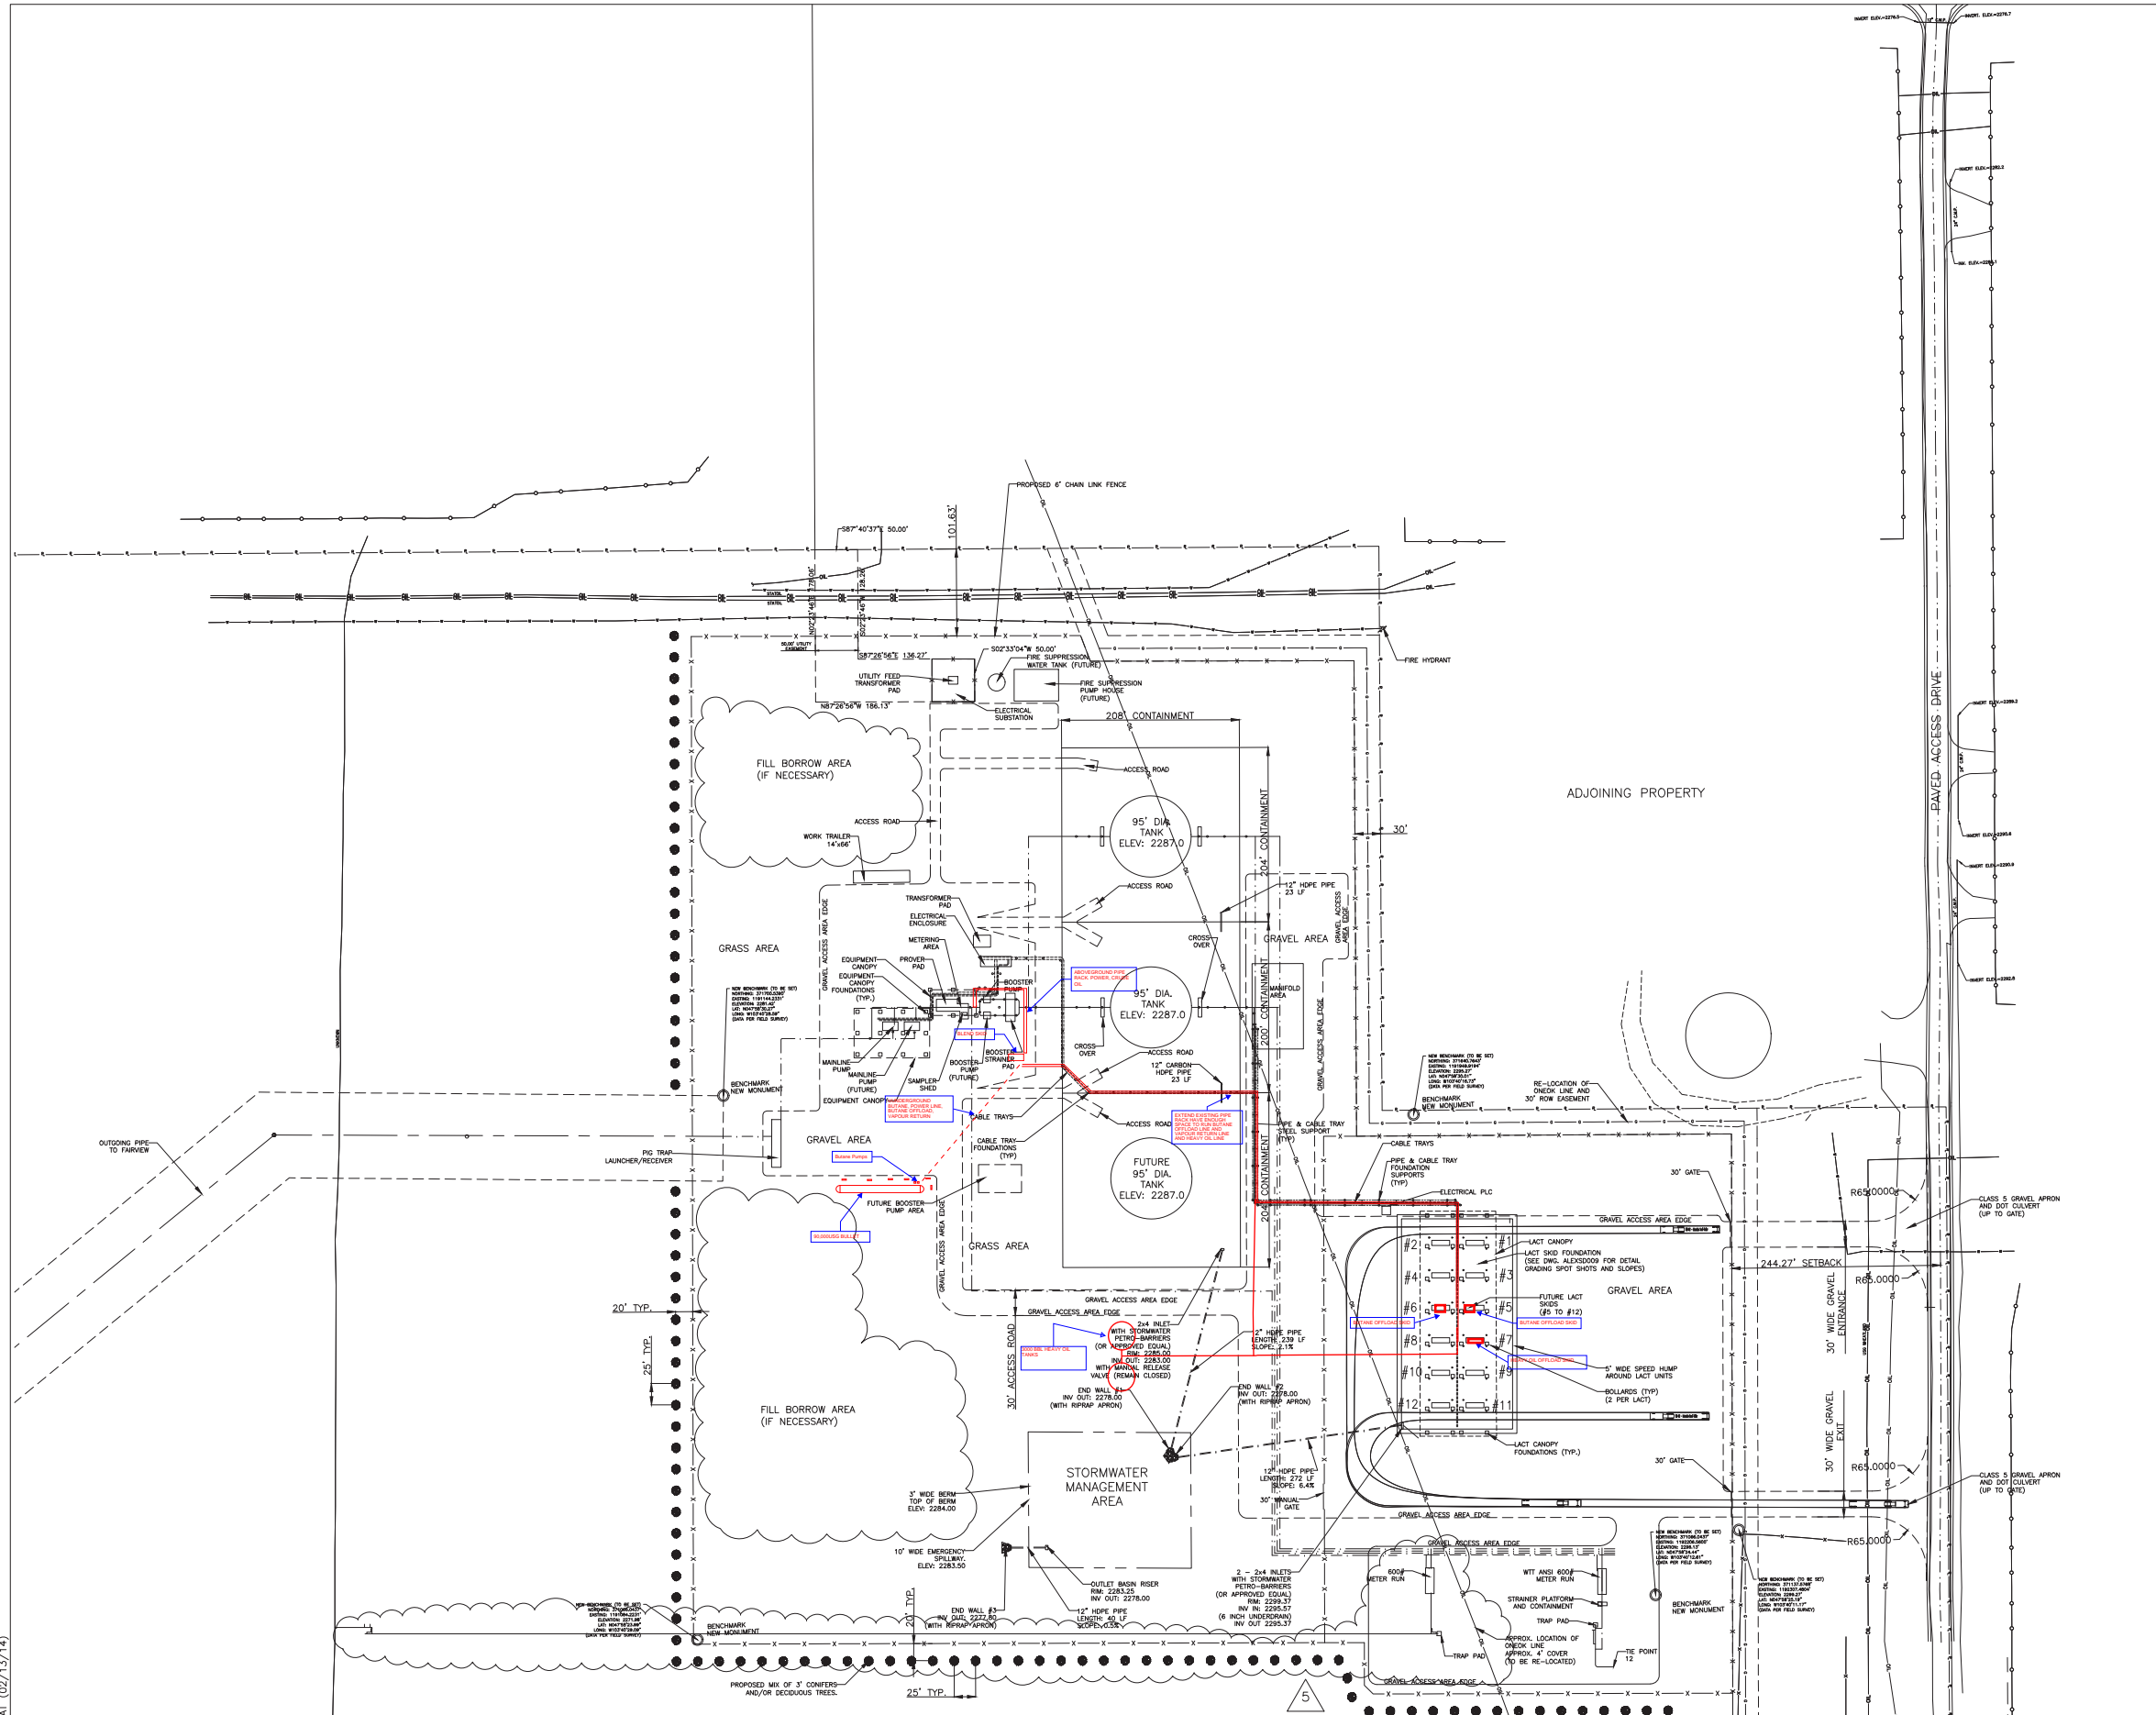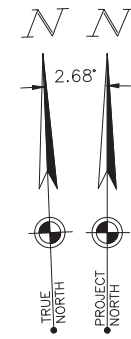

NO	LOC	DESCRIPTION OF REVISION	BY	DATE	APPR	DATE
4		REISSUED FOR CONSTRUCTION	TEE	6/3/16	EWP	6/3/16
3		REISSUED FOR CONSTRUCTION	JLR	4/6/16	EWP	4/6/16
2		ISSUED FOR PERMIT	TEE	3/3/16	EWP	3/3/16
1		RE-ISSUED FOR CONSTRUCTION - ADJUST ONEOK LINE	TEE	2/24/16	EWP	2/24/16
5		REISSUED FOR CONSTRUCTION	TEE	10/13/16	EWP	10/24/16

NO LOC DESCRIPTION OF REVISION BY DATE APPR DATE

DRAWN: JLR		SCALE: 1"=100'	DATE: 7/30/2015		
			REV 5		
APPROVED: EWP		CHECKED: TEE	NO. ALEXCA0001		
			PROJECT NUMBER: 20-2402		

CSD ENGINEERS
L.L.C.
PROJECT NUMBER: 20-2402

/R2014/FORMAT (02/13/14)