

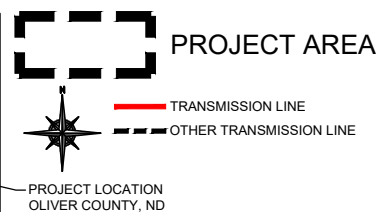


MINNKOTA POWER COOPERATIVE PROJECT TUNDRA MILTON R. YOUNG LINE REROUTE 69KV TRANSMISSION LINE VICINITY MAP—OLIVER COUNTY, ND

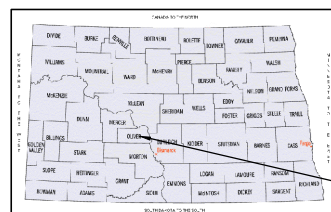

G:\2022\22.12030\Transmission\SPEC\4-Appendix I - Vicinity Map\Project Tundra MRY 69kV Line Reroute_Vicinity Map.dwg

REV.	01/05/2026	ORIGINAL ISSUE-AS BUILT	CMA
DATE		DESCRIPTION	BY
MINNKOTA POWER COOPERATIVE PROJECT TUNDRA MILTON R. YOUNG REROUTE 69kV Transmission Line			
VICINITY MAP			
DRAWN BY:	ARP	SCALE:	PROJECT NO.
CHECKED BY:	CMA	AS SHOWN	R22.12030
APPROVED BY:	CMA	DATE:	SHEET VICINITY MAP
		07/26/23	

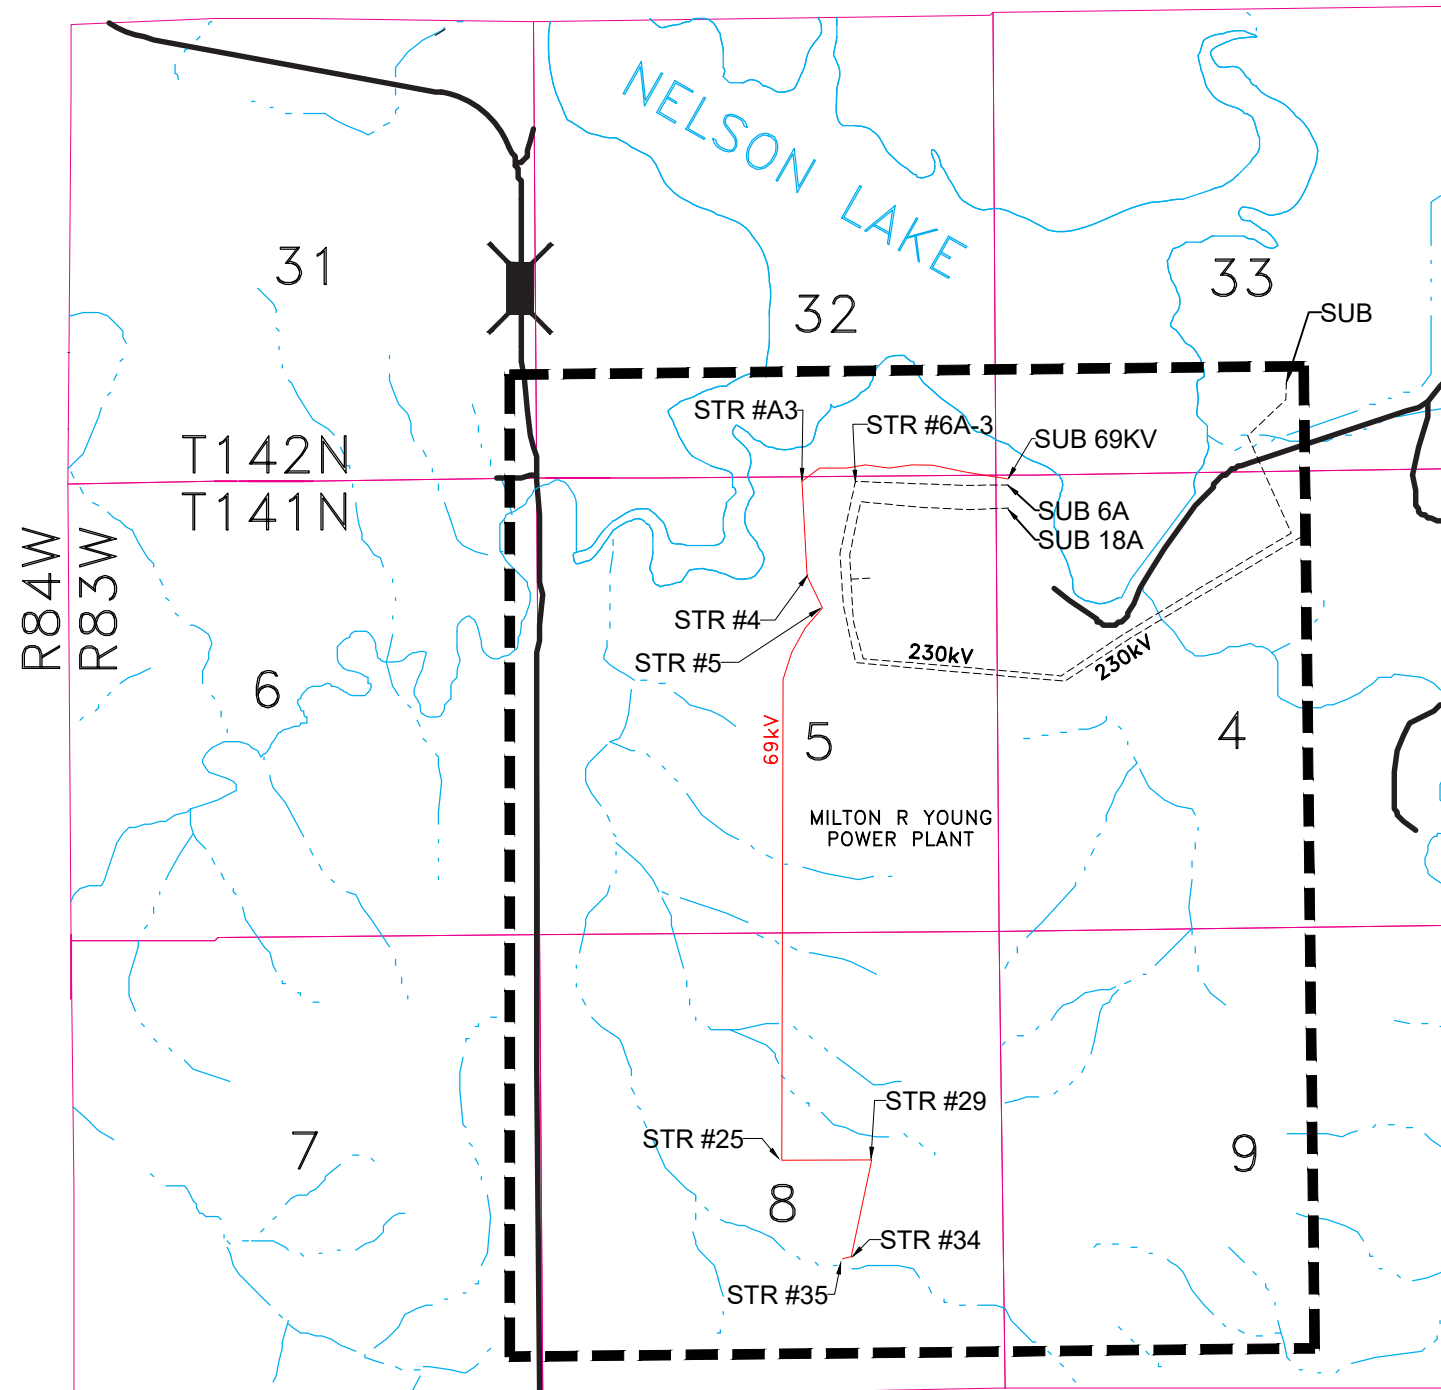