
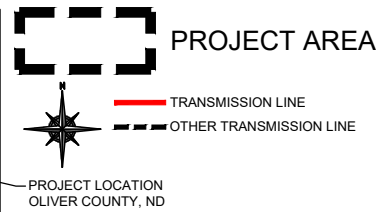
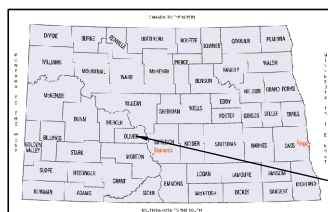
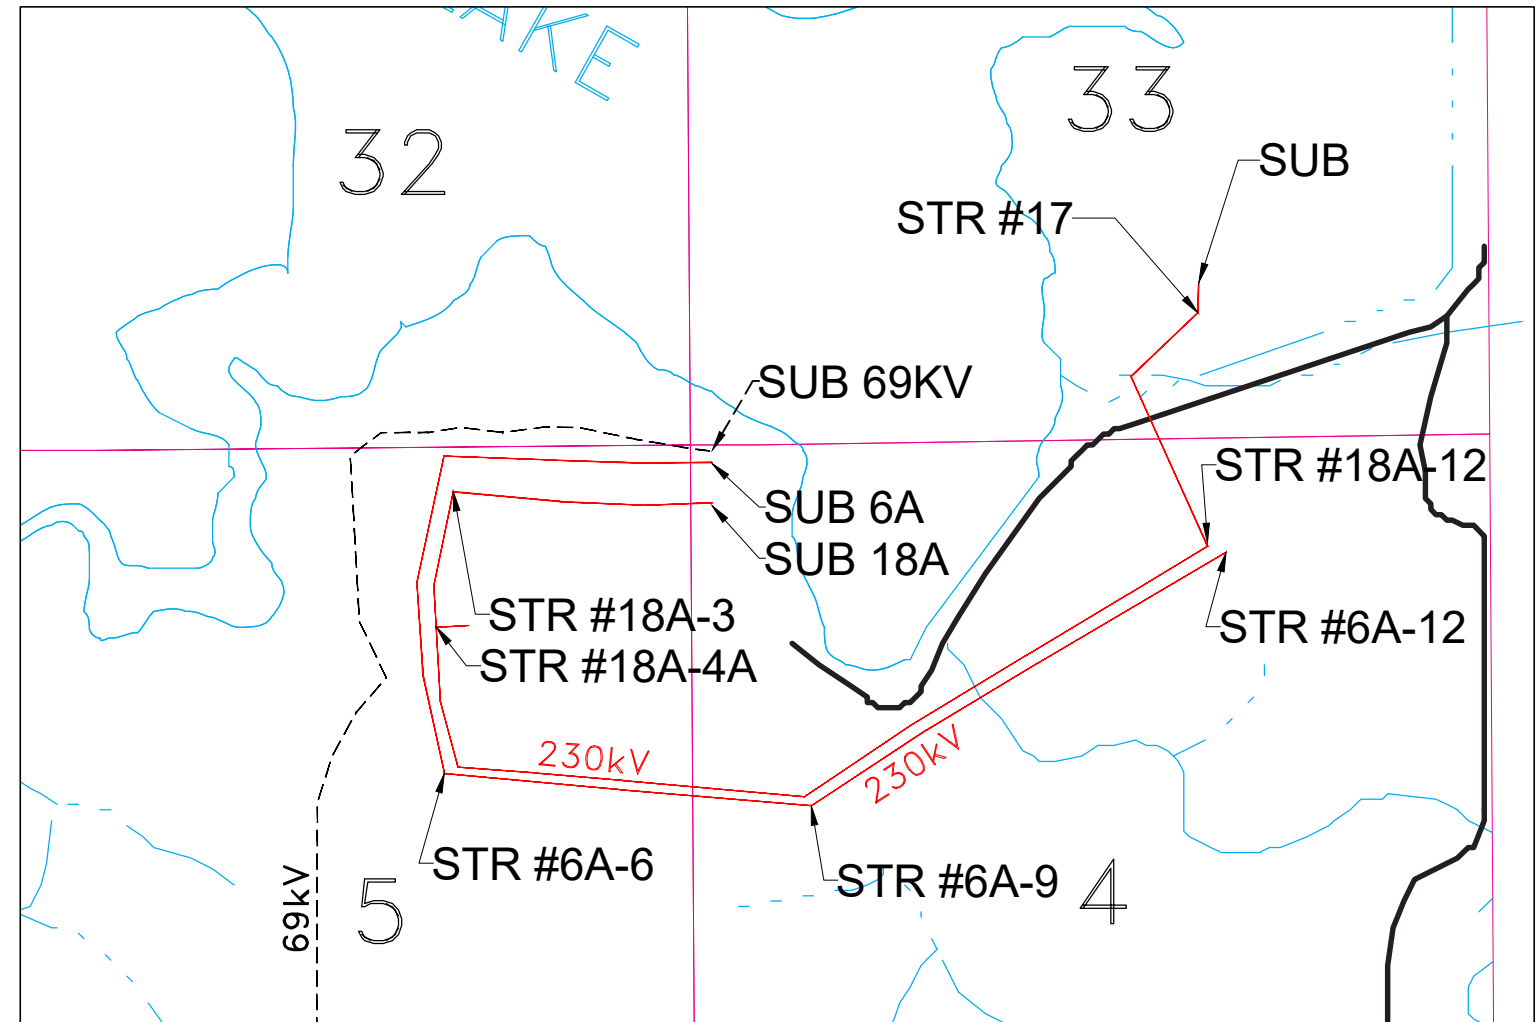


# MINNKOTA POWER COOPERATIVE PROJECT TUNDRA MILTON R. YOUNG LINE REROUTES 230KV TRANSMISSION LINES VICINITY MAP-OLIVER COUNTY, ND

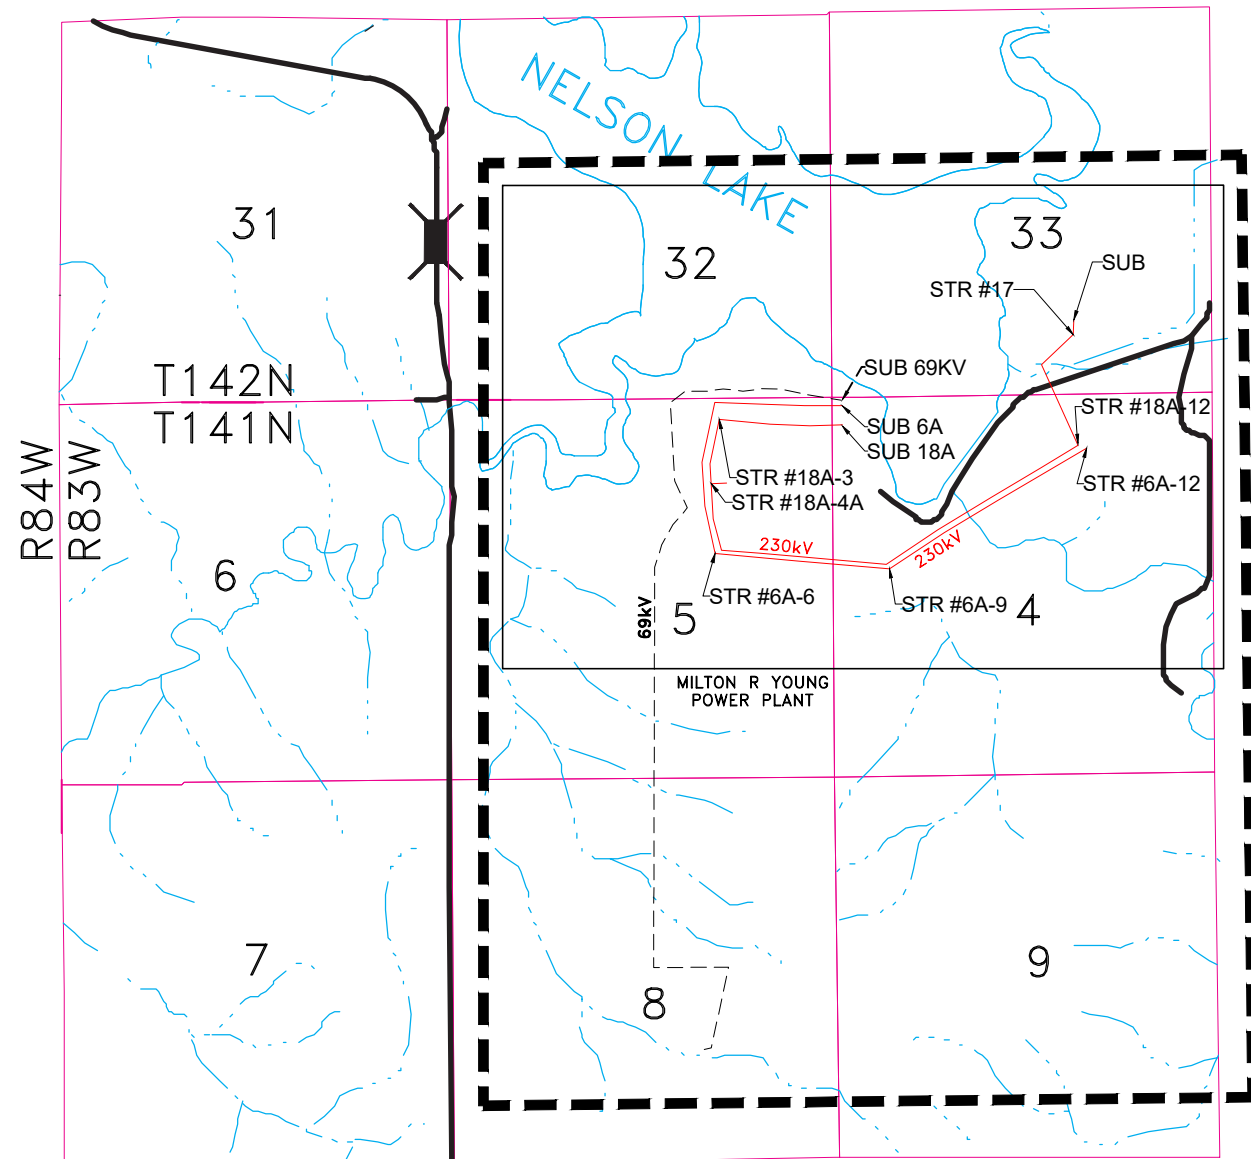

G:\2022\22.12030\Transmission\SPEC\4-Appendix 1 - Vicinity Map\Project Tundra MRY 230kV Line Reroutes\_Vicinity Map.dwg

REV.	DATE	DESCRIPTION	BY
01/05/2026		ORIGINAL ISSUE-AS BUILT	CMA

<b>MINNKOTA POWER COOPERATIVE</b>	
<b>PROJECT TUNDRA MILTON R. YOUNG</b>	
<b>REROUTES 230kV Transmission Lines</b>	
<b>VICINITY MAP</b>	
DRAWN BY: <b>ARP</b>	SCALE: <b>AS SHOWN</b>
CHECKED BY: <b>CMA</b>	PROJECT NO. <b>R22.12030</b>
APPROVED BY: <b>CMA</b>	DATE: <b>07/26/23</b>
	SHEET <b>VICINITY MAP</b>

