



ONEOK, INC. 6" TIOGA EXTENSION WILLIAMS COUNTY, NORTH DAKOTA



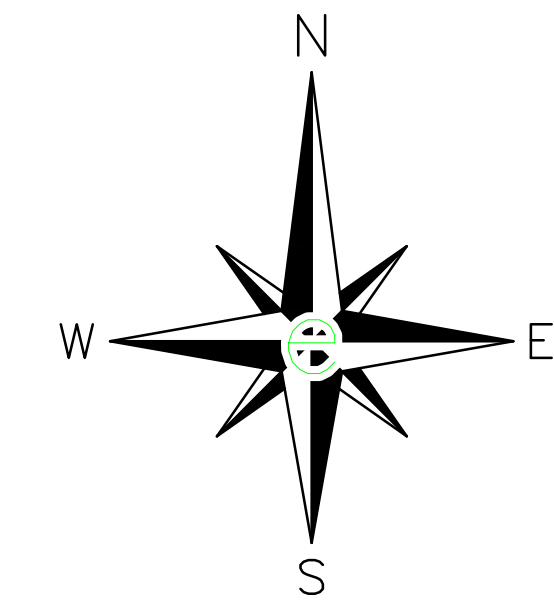


ENCOMPASS ENERGY SERVICES
14800 ST. MARY'S LANE, SUITE 230
HOUSTON, TEXAS 77079

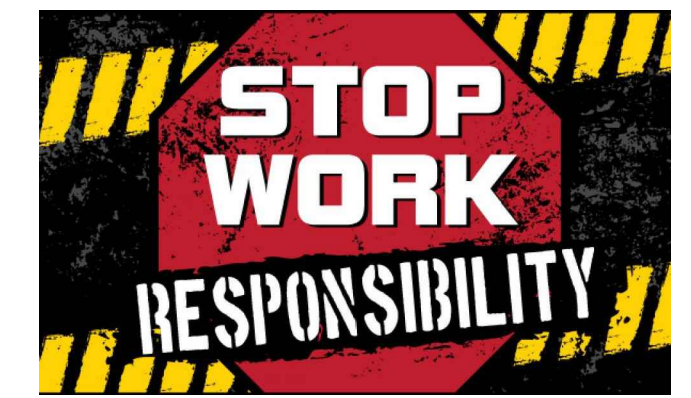

PROJECT OVERVIEW

LEGEND

-  AS-BUILT CENTERLINE
-  PSC CORRIDOR

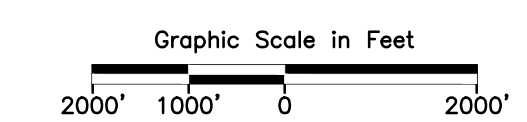

- GENERAL NOTES:
1. THIS INFORMATION WAS PREPARED BASED ON SURVEYED CENTERLINE.
 2. COORDINATES SHOWN ARE BASED ON NAD83, STATE PLANE, US SURVEY FEET, NORTH DAKOTA NORTH ZONE.

DRAWING MAKES NO WARRANTY (EXPRESS, IMPLIED, OR OTHERWISE) THAT THE INFORMATION CONTAINED HEREIN IS ACCURATE OR COMPLETE AS TO ANY AND ALL SUBSURFACE CONDITIONS AND CONFIRMATION. ANY RELIANCE THE CONTRACTOR PLACES ON THE INFORMATION CONTAINED HEREIN IS DONE AT IT'S OWN RISK AND EXPENSE. IT IS THE SOLE RESPONSIBILITY OF THE CONTRACTOR TO CONTACT THE STATE'S "ONE CALL" SYSTEM PRIOR TO ANY EXCAVATION.