
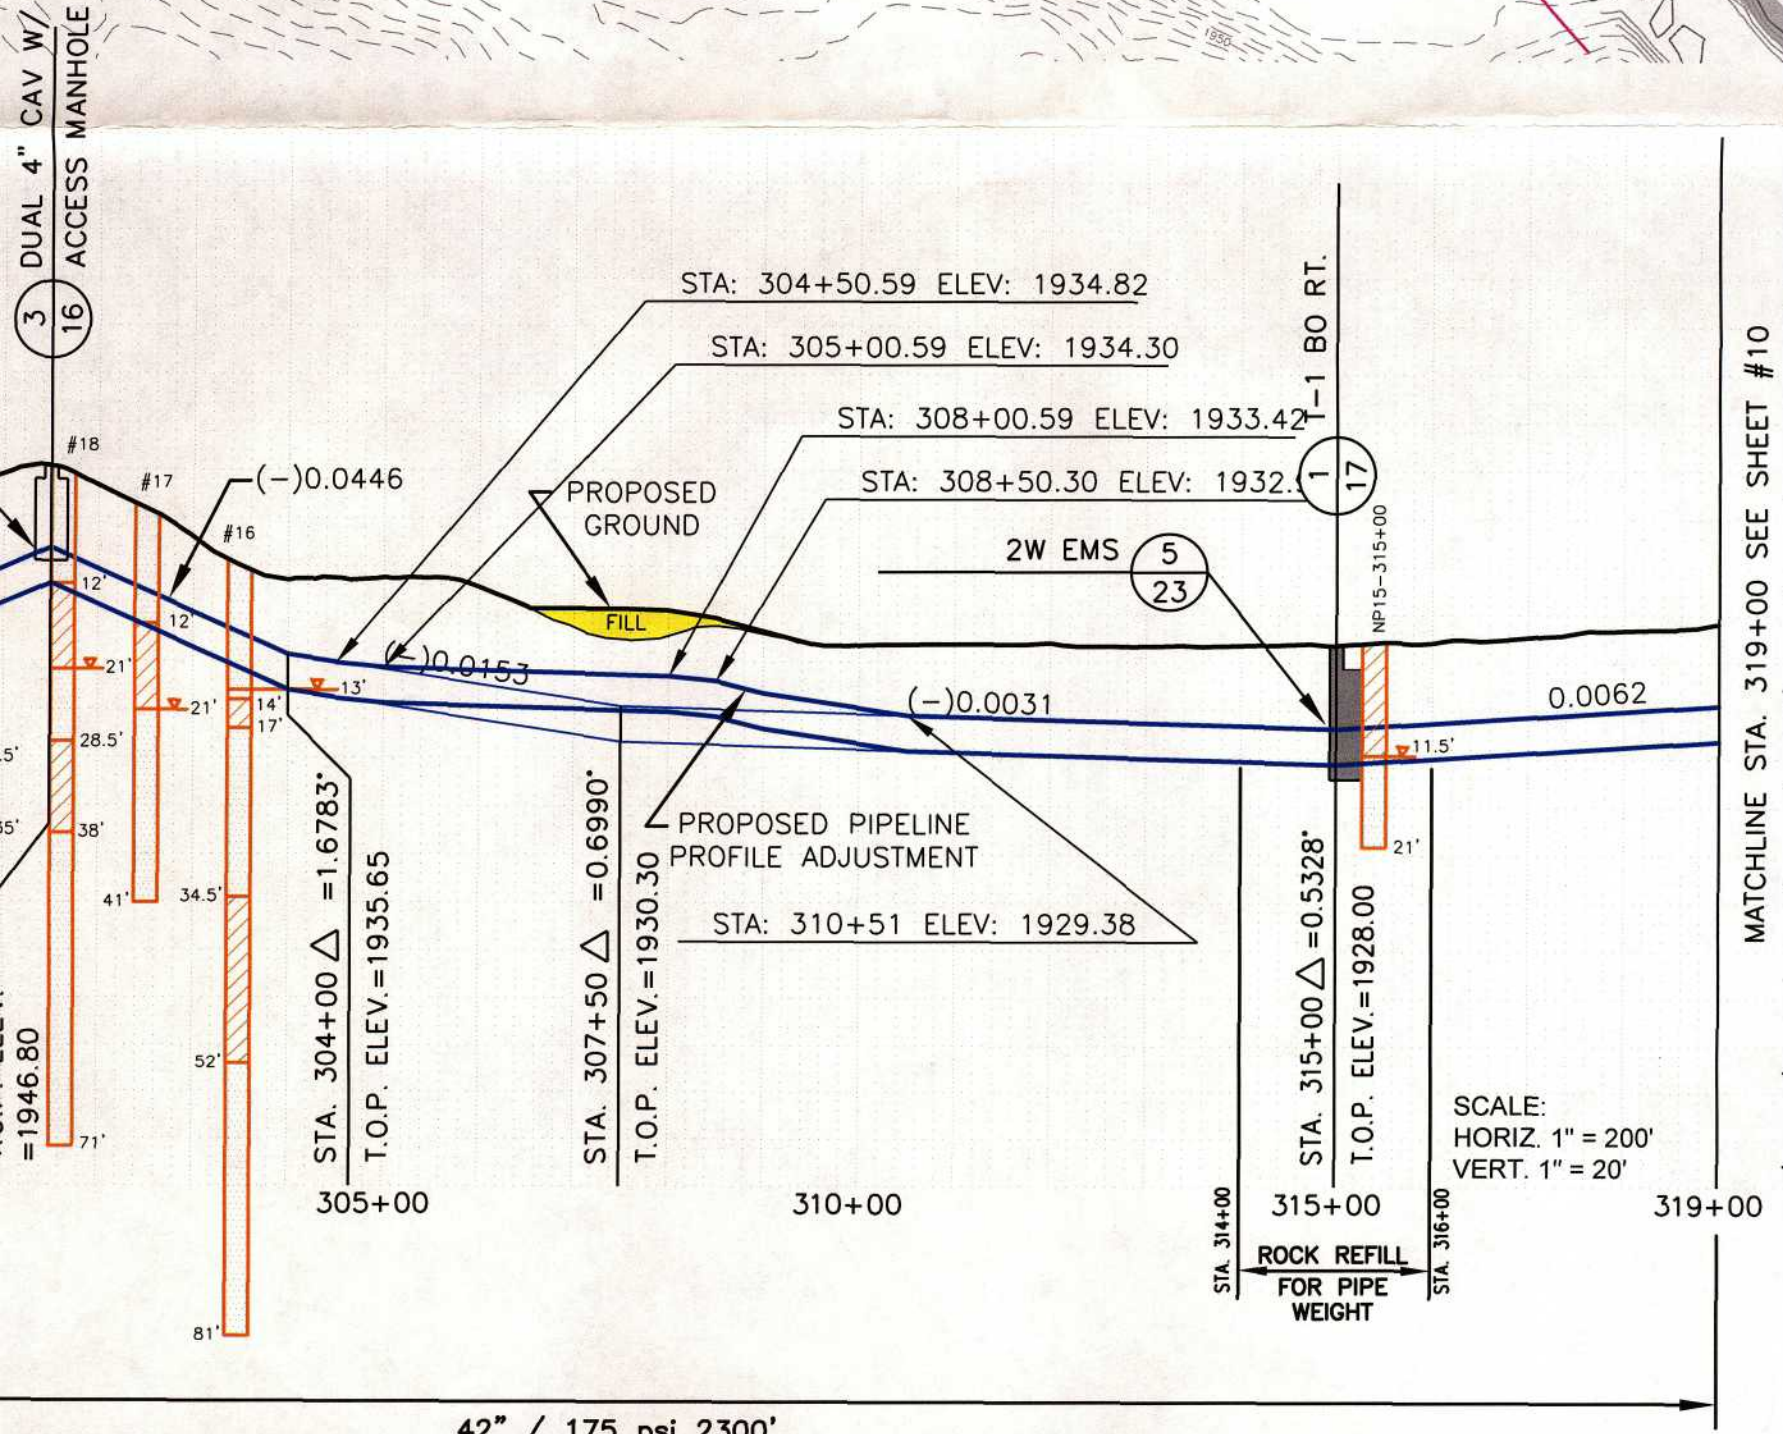


Coteau Properties Company
 Marc Schreifer (Tenant)
 T145N R88W SEC 2

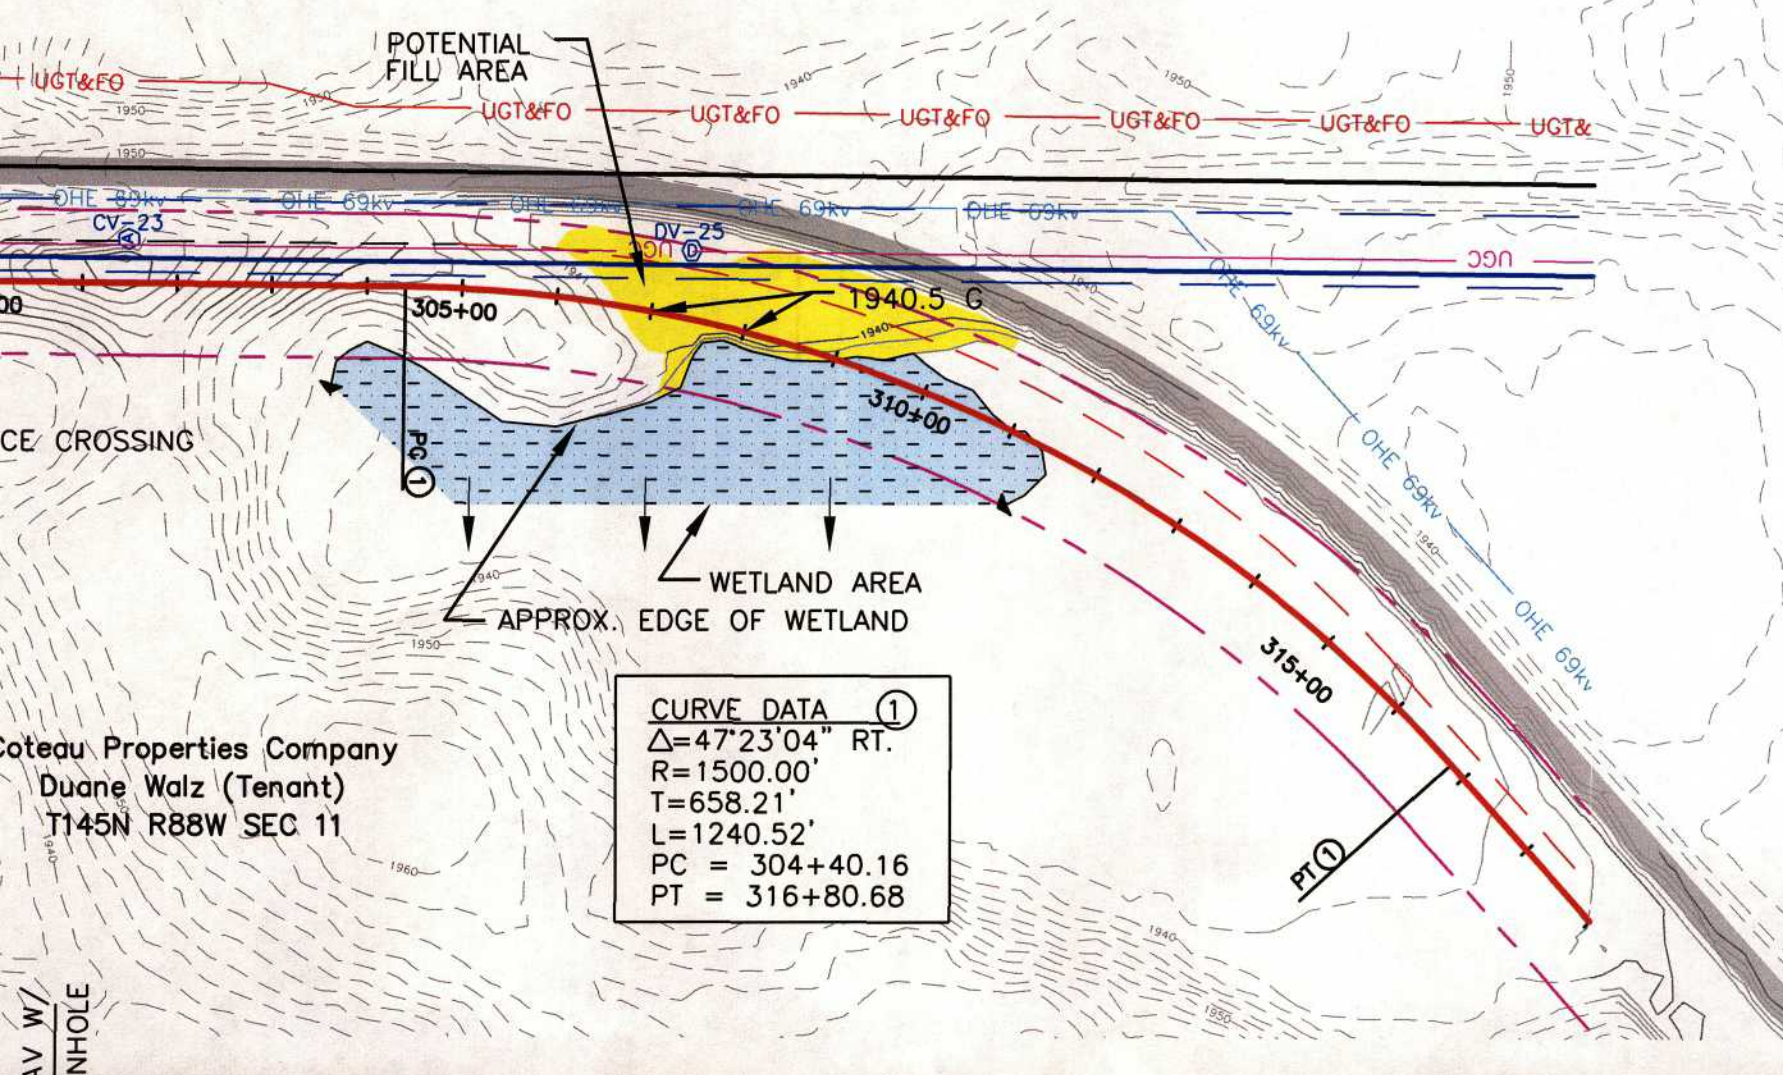

42" / 175 psi 2300'

MATCHLINE STA. 319+00 SEE SHEET #10

AVS Raw Water Pipeline Replacement

Sta. 255+00 to Sta. 319+00