


Layout Comparison Map

Rugby Wind Project



- ### Legend
- Permitted GE Layout
 - Proposed G87/S88 Turbines
 - 🏠 Homes
 - Existing Transmission Line
 - ~ Rivers/Streams
 - Roads
 - Substation
 - Site Boundary
 - Taxlots
 - Section Line
- Site Control
- Leased
 - School
 - No Lease

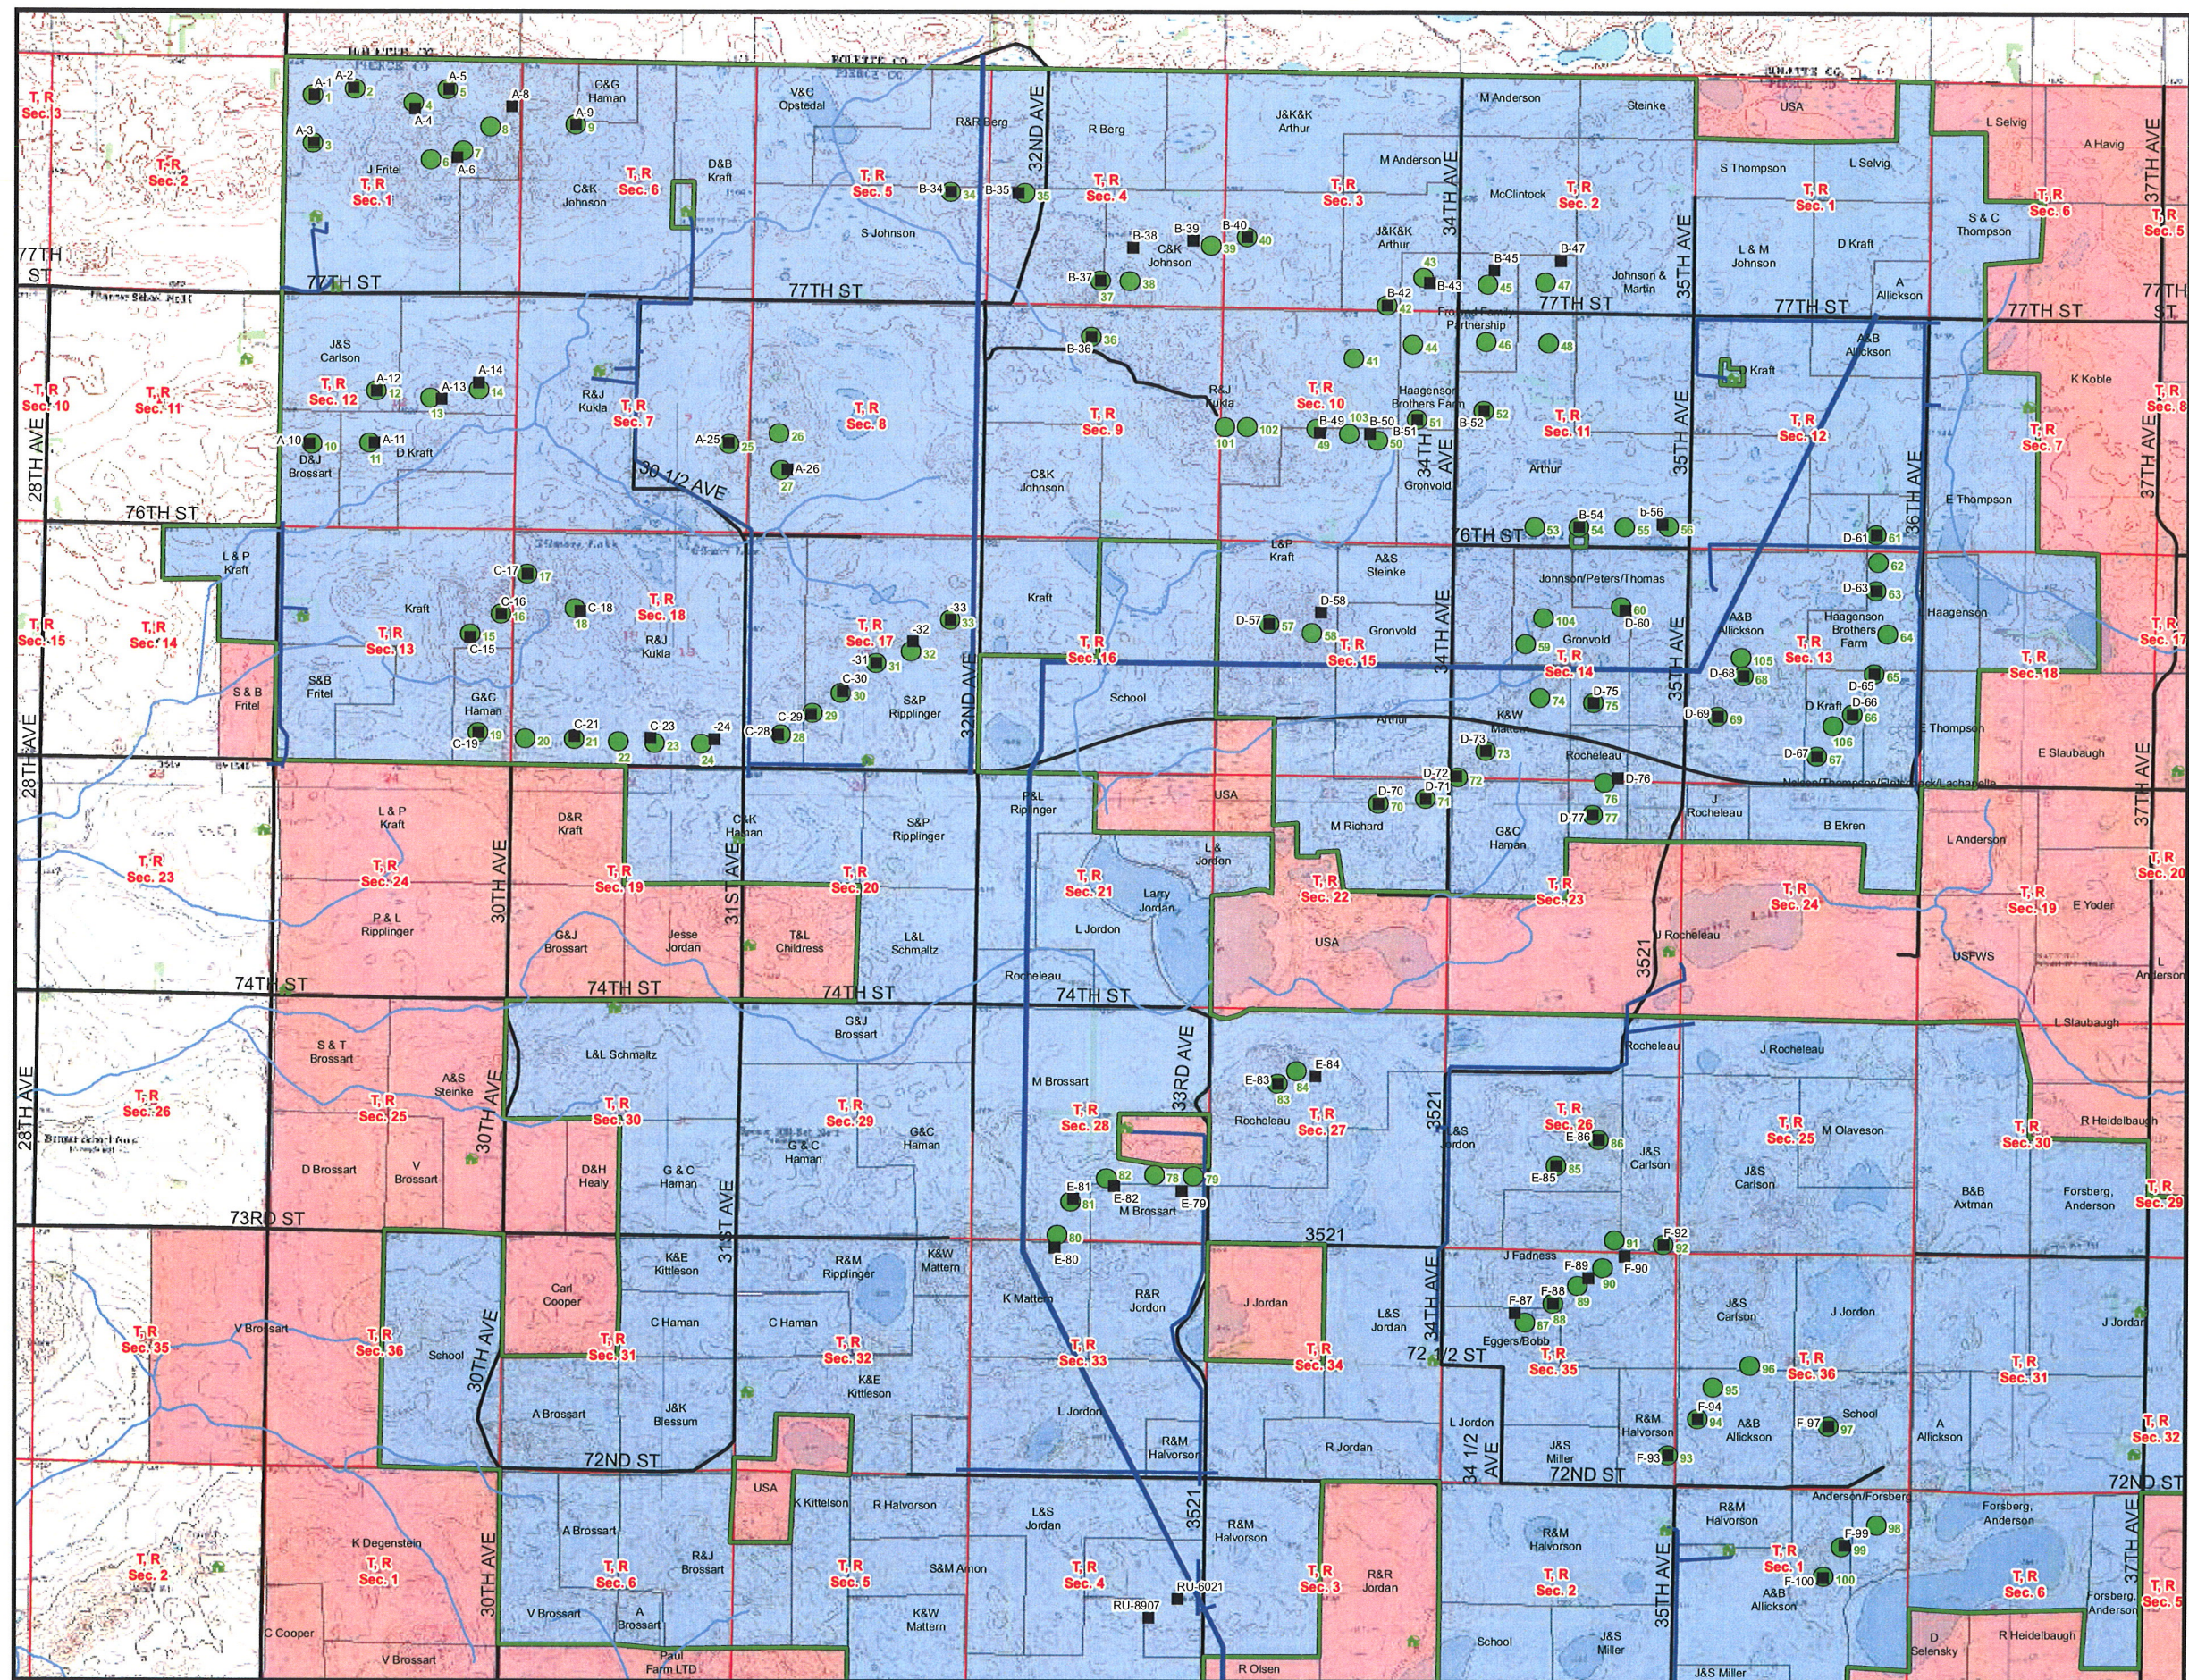