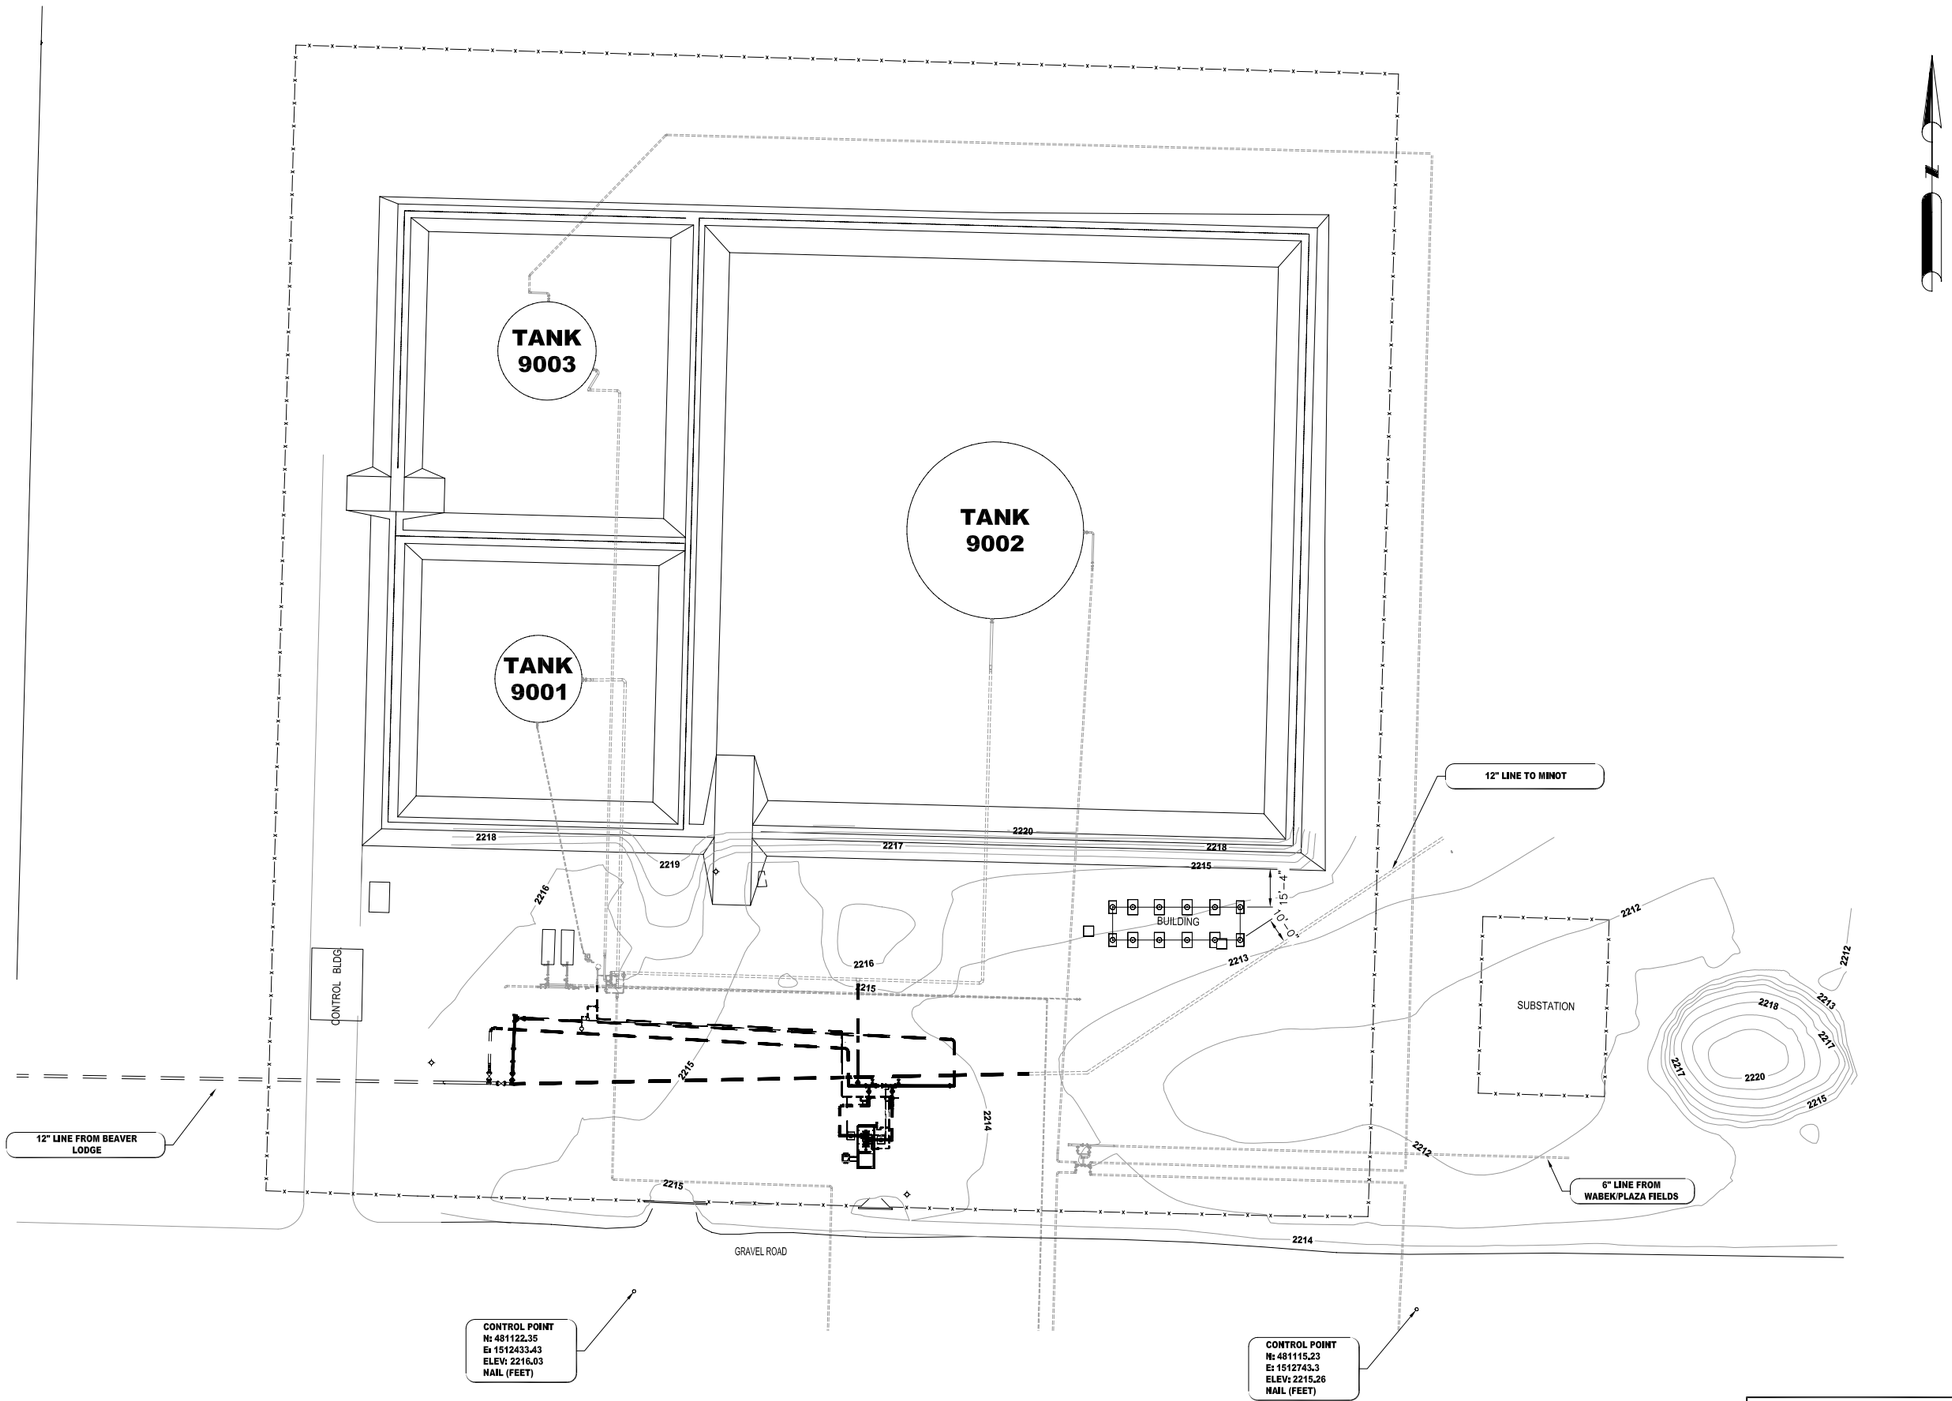

NO	REVISION	DATE	APPR	BY
1	AS-BUILT	2/28/08	EK	ADJ
0	ISSUED FOR CONSTRUCTION	11/13/06	EK	

ENBRIDGE PIPELINES (ND)

STANLEY (ND) STATION

SITE PLAN

PROJECT: ENBRIDGE ND EXPANSION PHASE III

SCALE: 1"=30'	DATE: 01/16/06	DRAWN: TML
CHECK: EJK	APPR: TDP	DATE: 01/27/06

DWG. NO. 2408-P-001

Rooney Engineering, Inc.
12201 E. Arapahoe Rd.
Centennial, CO 80112
(303) 792-5911