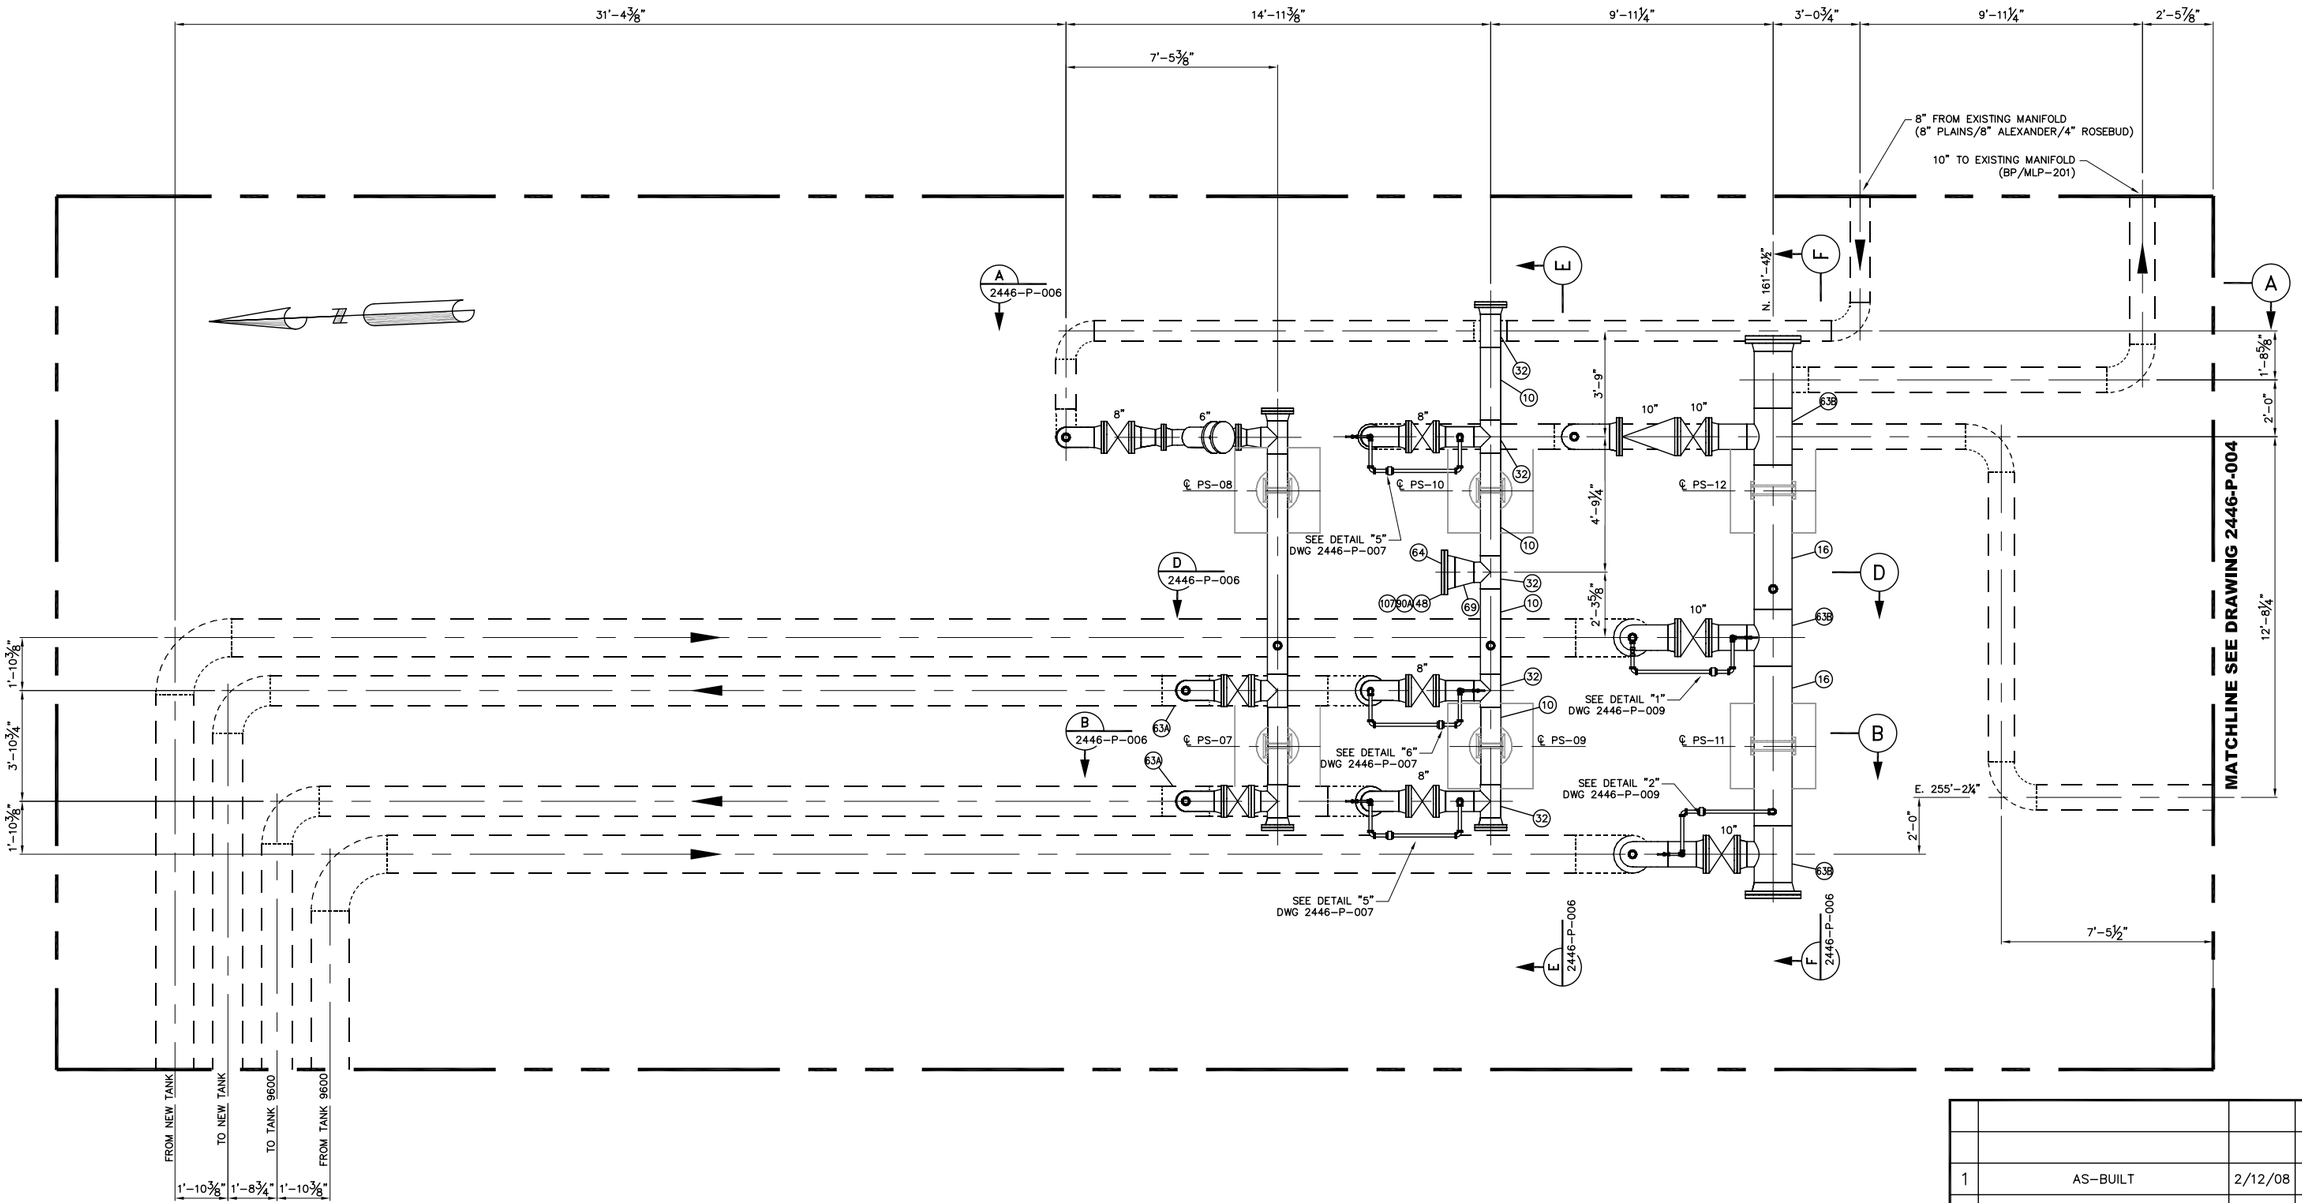

NO	REVISION	DATE	APPR	BY
1	AS-BUILT	2/12/08		
0	ISSUED FOR CONSTRUCTION	4/20/07		

ENBRIDGE PIPELINES (ND)

TRENTON (ND) STATION

PIPING PLAN
TANK MANIFOLD

PROJECT:

SCALE: 3/8"=1'-0"	DATE: 10/3/06	DRAWN: ADJ
CHECK:	APPR:	DATE:

DWG. NO. 2446-P-005

Rooney Engineering, Inc.
12201 E. Arapahoe Rd.
Centennial, CO 80112
(303) 792-5911