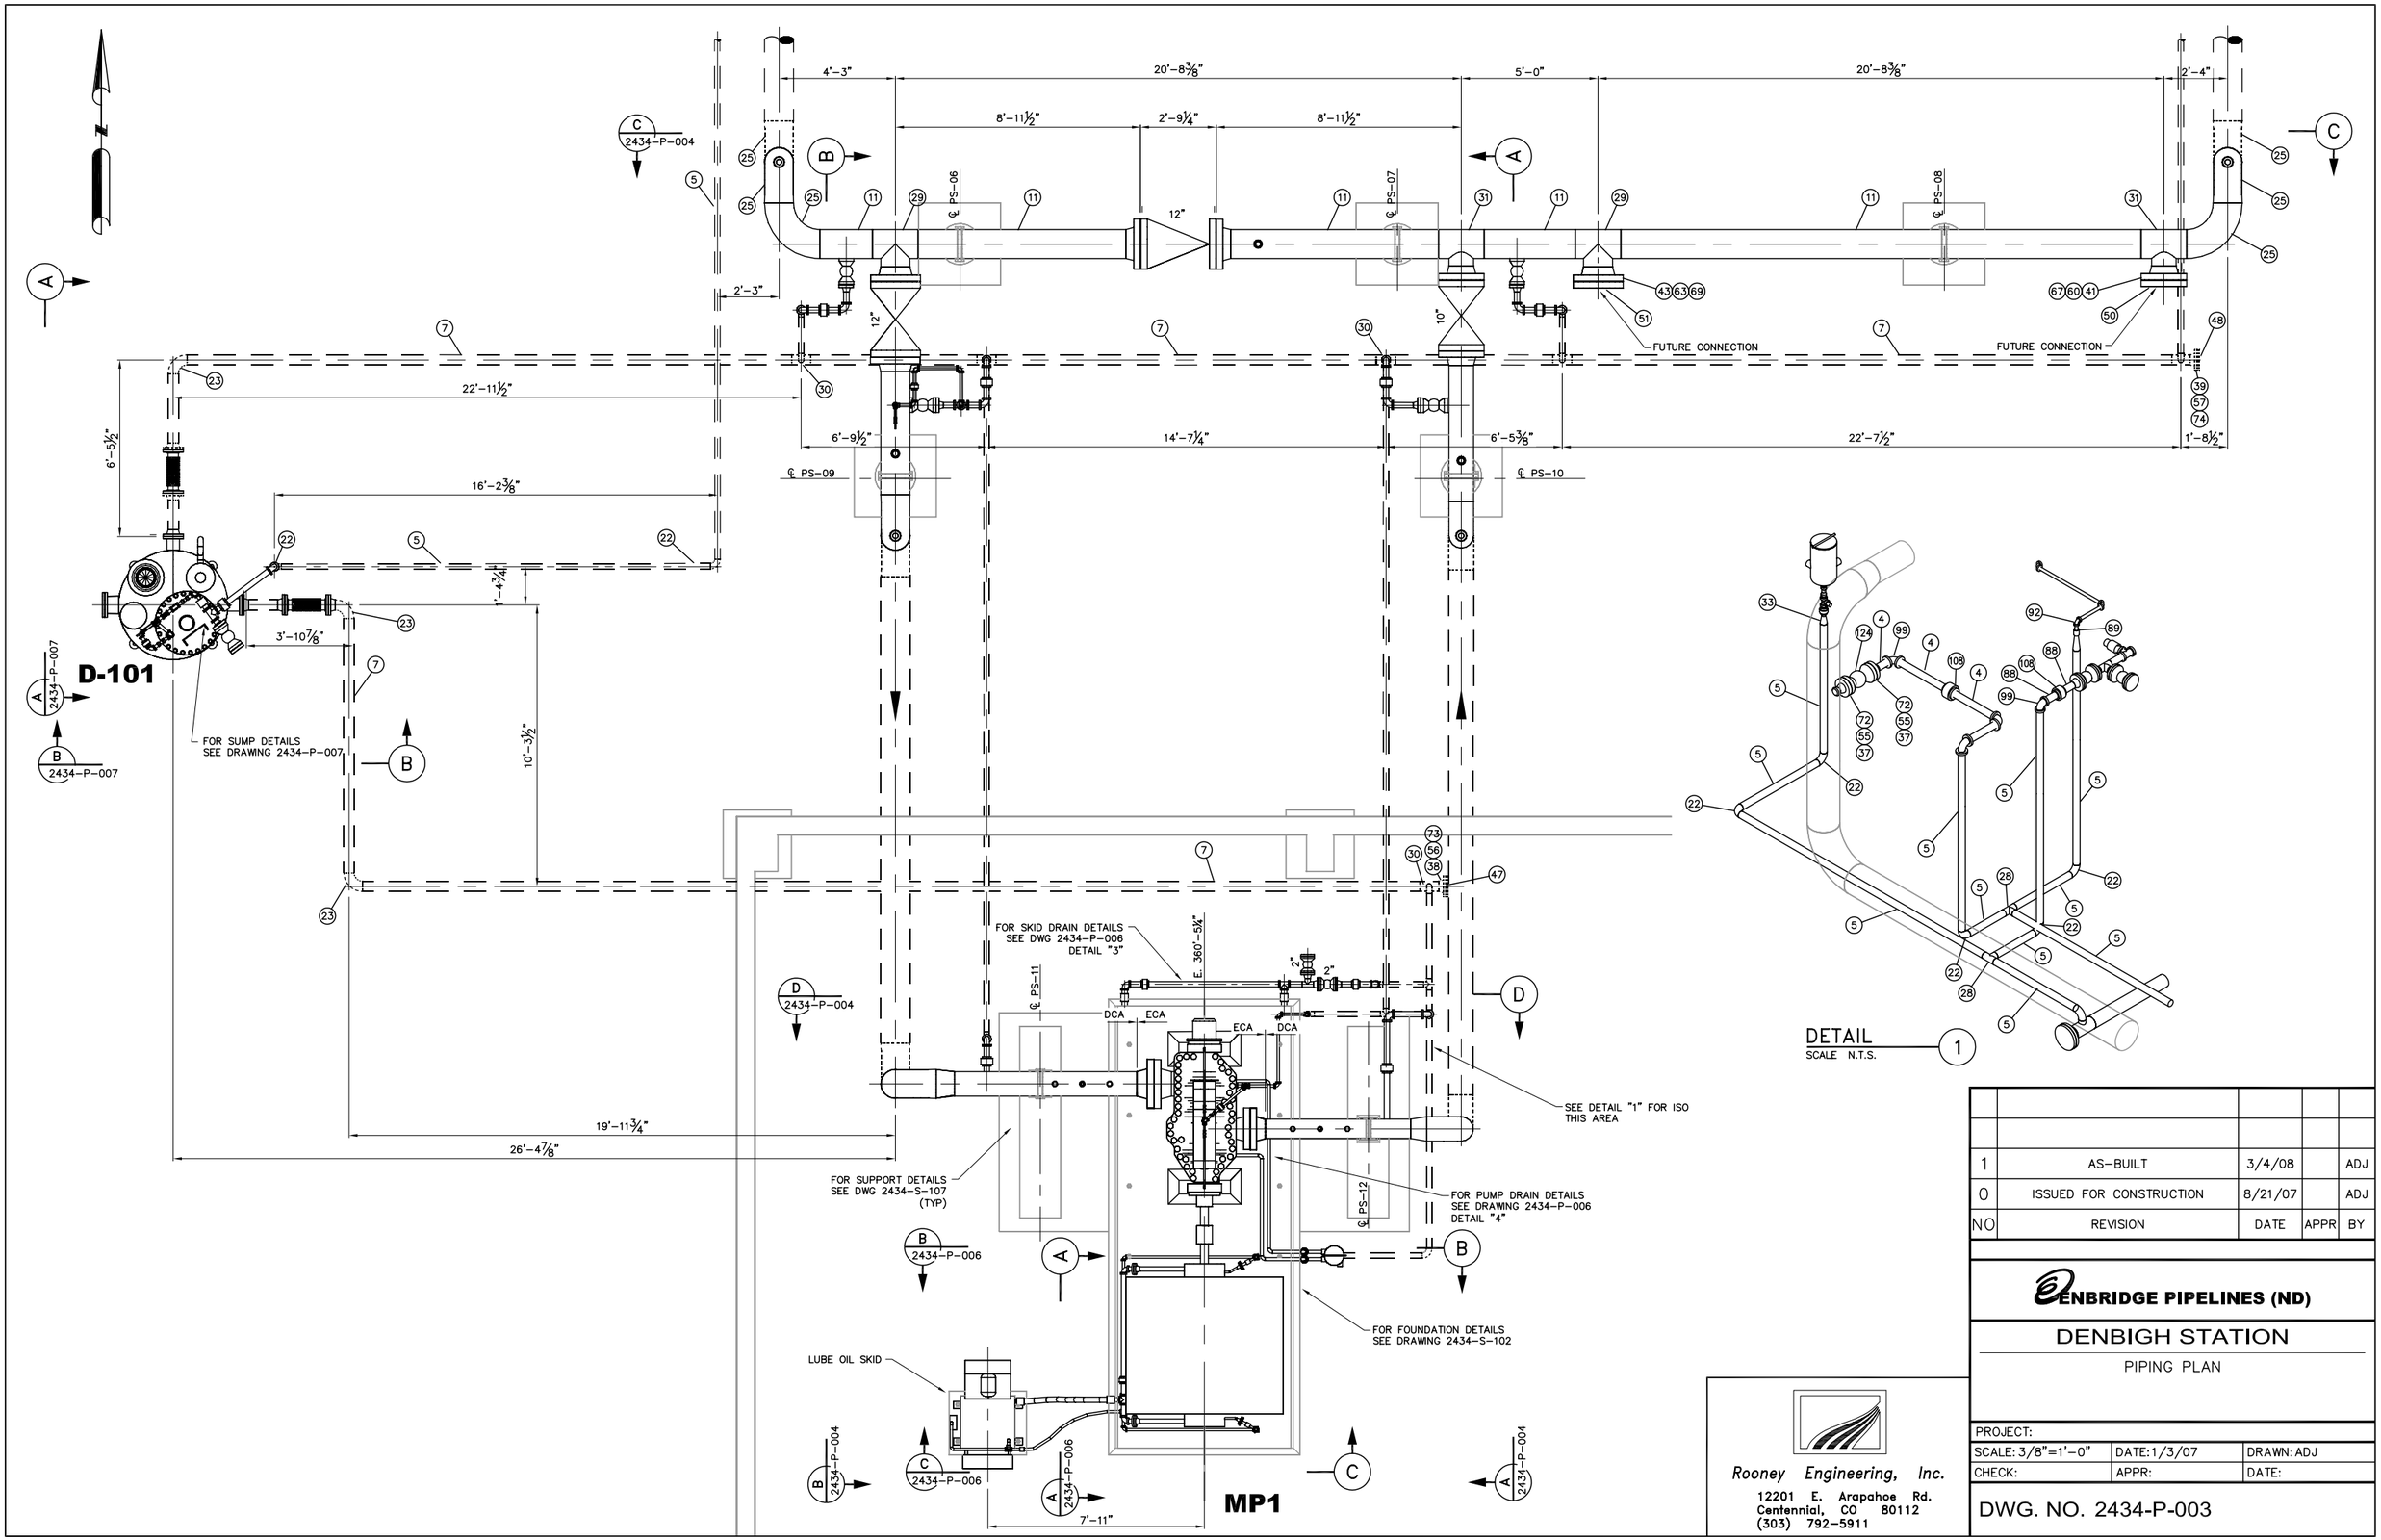

NO	REVISION	DATE	APPR	BY
1	AS-BUILT	3/4/08		ADJ
0	ISSUED FOR CONSTRUCTION	8/21/07		ADJ

ENBRIDGE PIPELINES (ND)

DENBIGH STATION

PIPING PLAN

PROJECT:

SCALE: 3/8"=1'-0"	DATE: 1/3/07	DRAWN: ADJ
CHECK:	APPR:	DATE:

DWG. NO. 2434-P-003

Rooney Engineering, Inc.
12201 E. Arapahoe Rd.
Centennial, CO 80112
(303) 792-5911