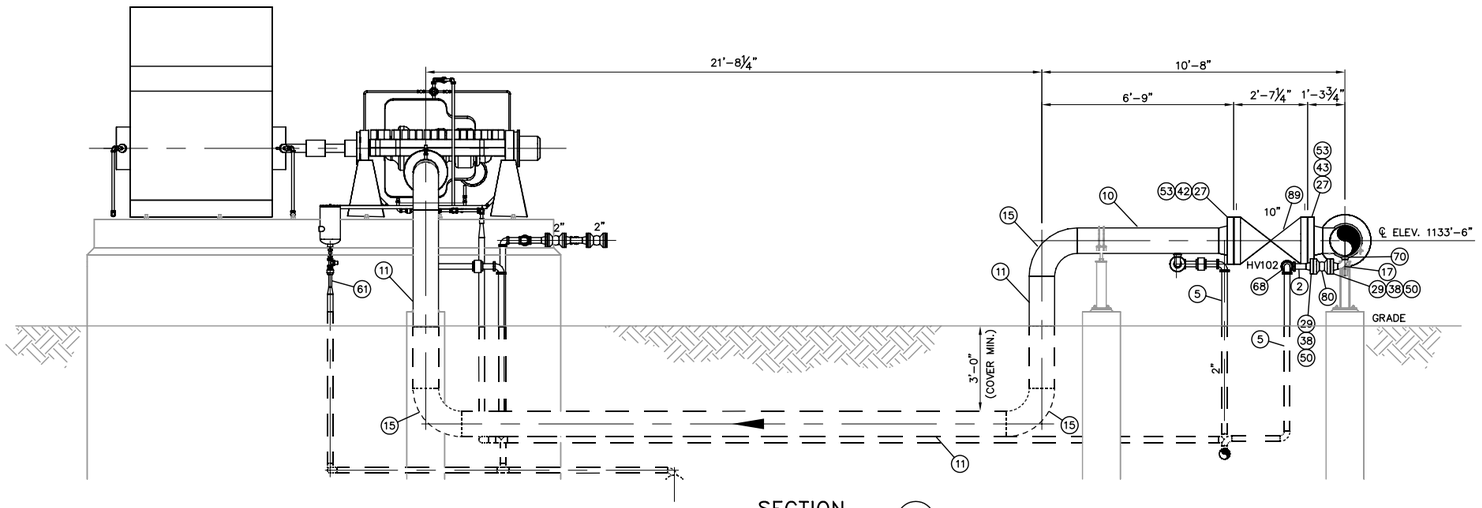

SECTION A
SCALE 3/8"=1'-0"

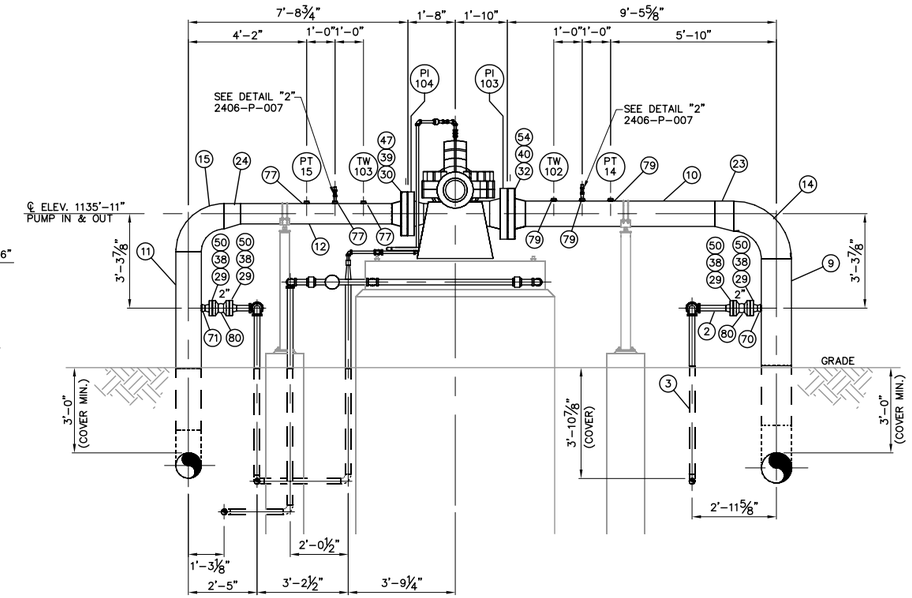

SECTION D
SCALE 3/8"=1'-0"

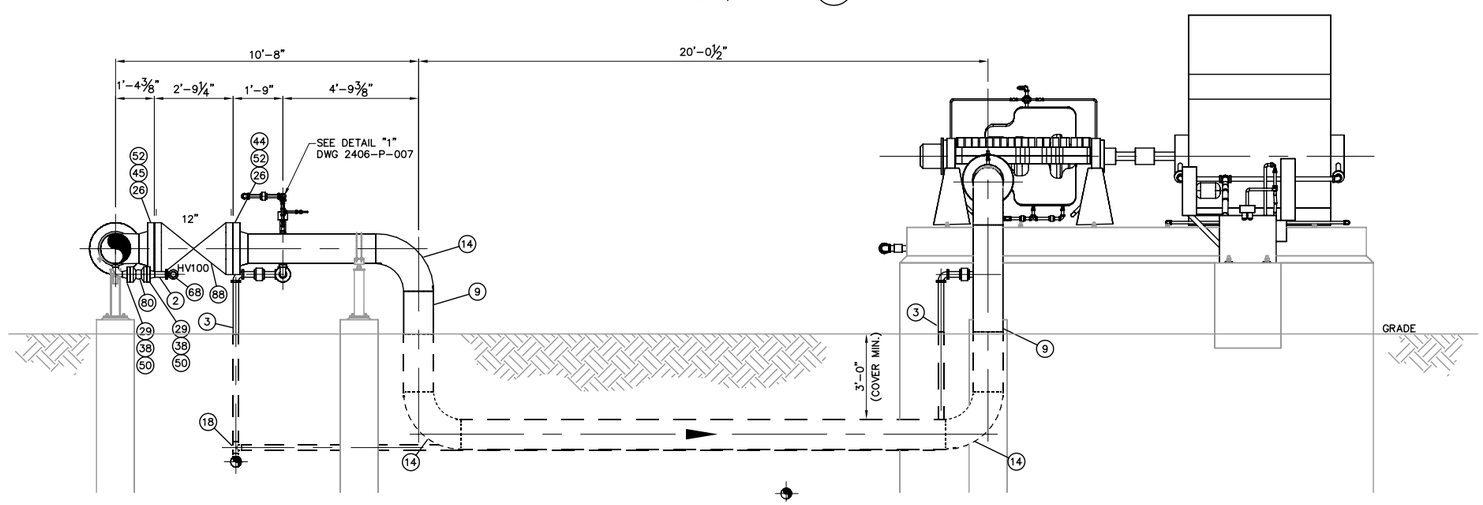

SECTION B
SCALE 3/8"=1'-0"

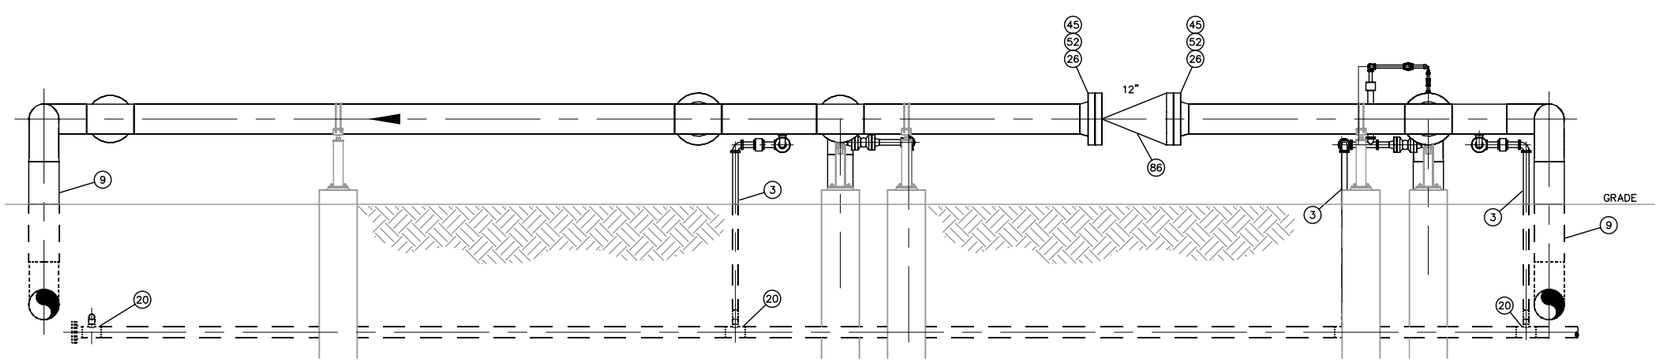

SECTION C
SCALE 3/8"=1'-0"

NO	REVISION	DATE	APPR	BY
1	AS-BUILT	12/18/07	EK	ADJ
0	ISSUED FOR CONSTRUCTION	3/28/07	EJK	ADJ

ENBRIDGE PIPELINES (ND)

LARIMORE STATION

PIPING SECTIONS

PROJECT:

SCALE: AS NOTED	DATE: 7/27/06	DRAWN: ADJ
CHECK:	APPR:	DATE:

DWG. NO. 2406-P-005

Rooney Engineering, Inc.
12201 E. Arapahoe Rd.
Centennial, CO 80112
(303) 792-5911