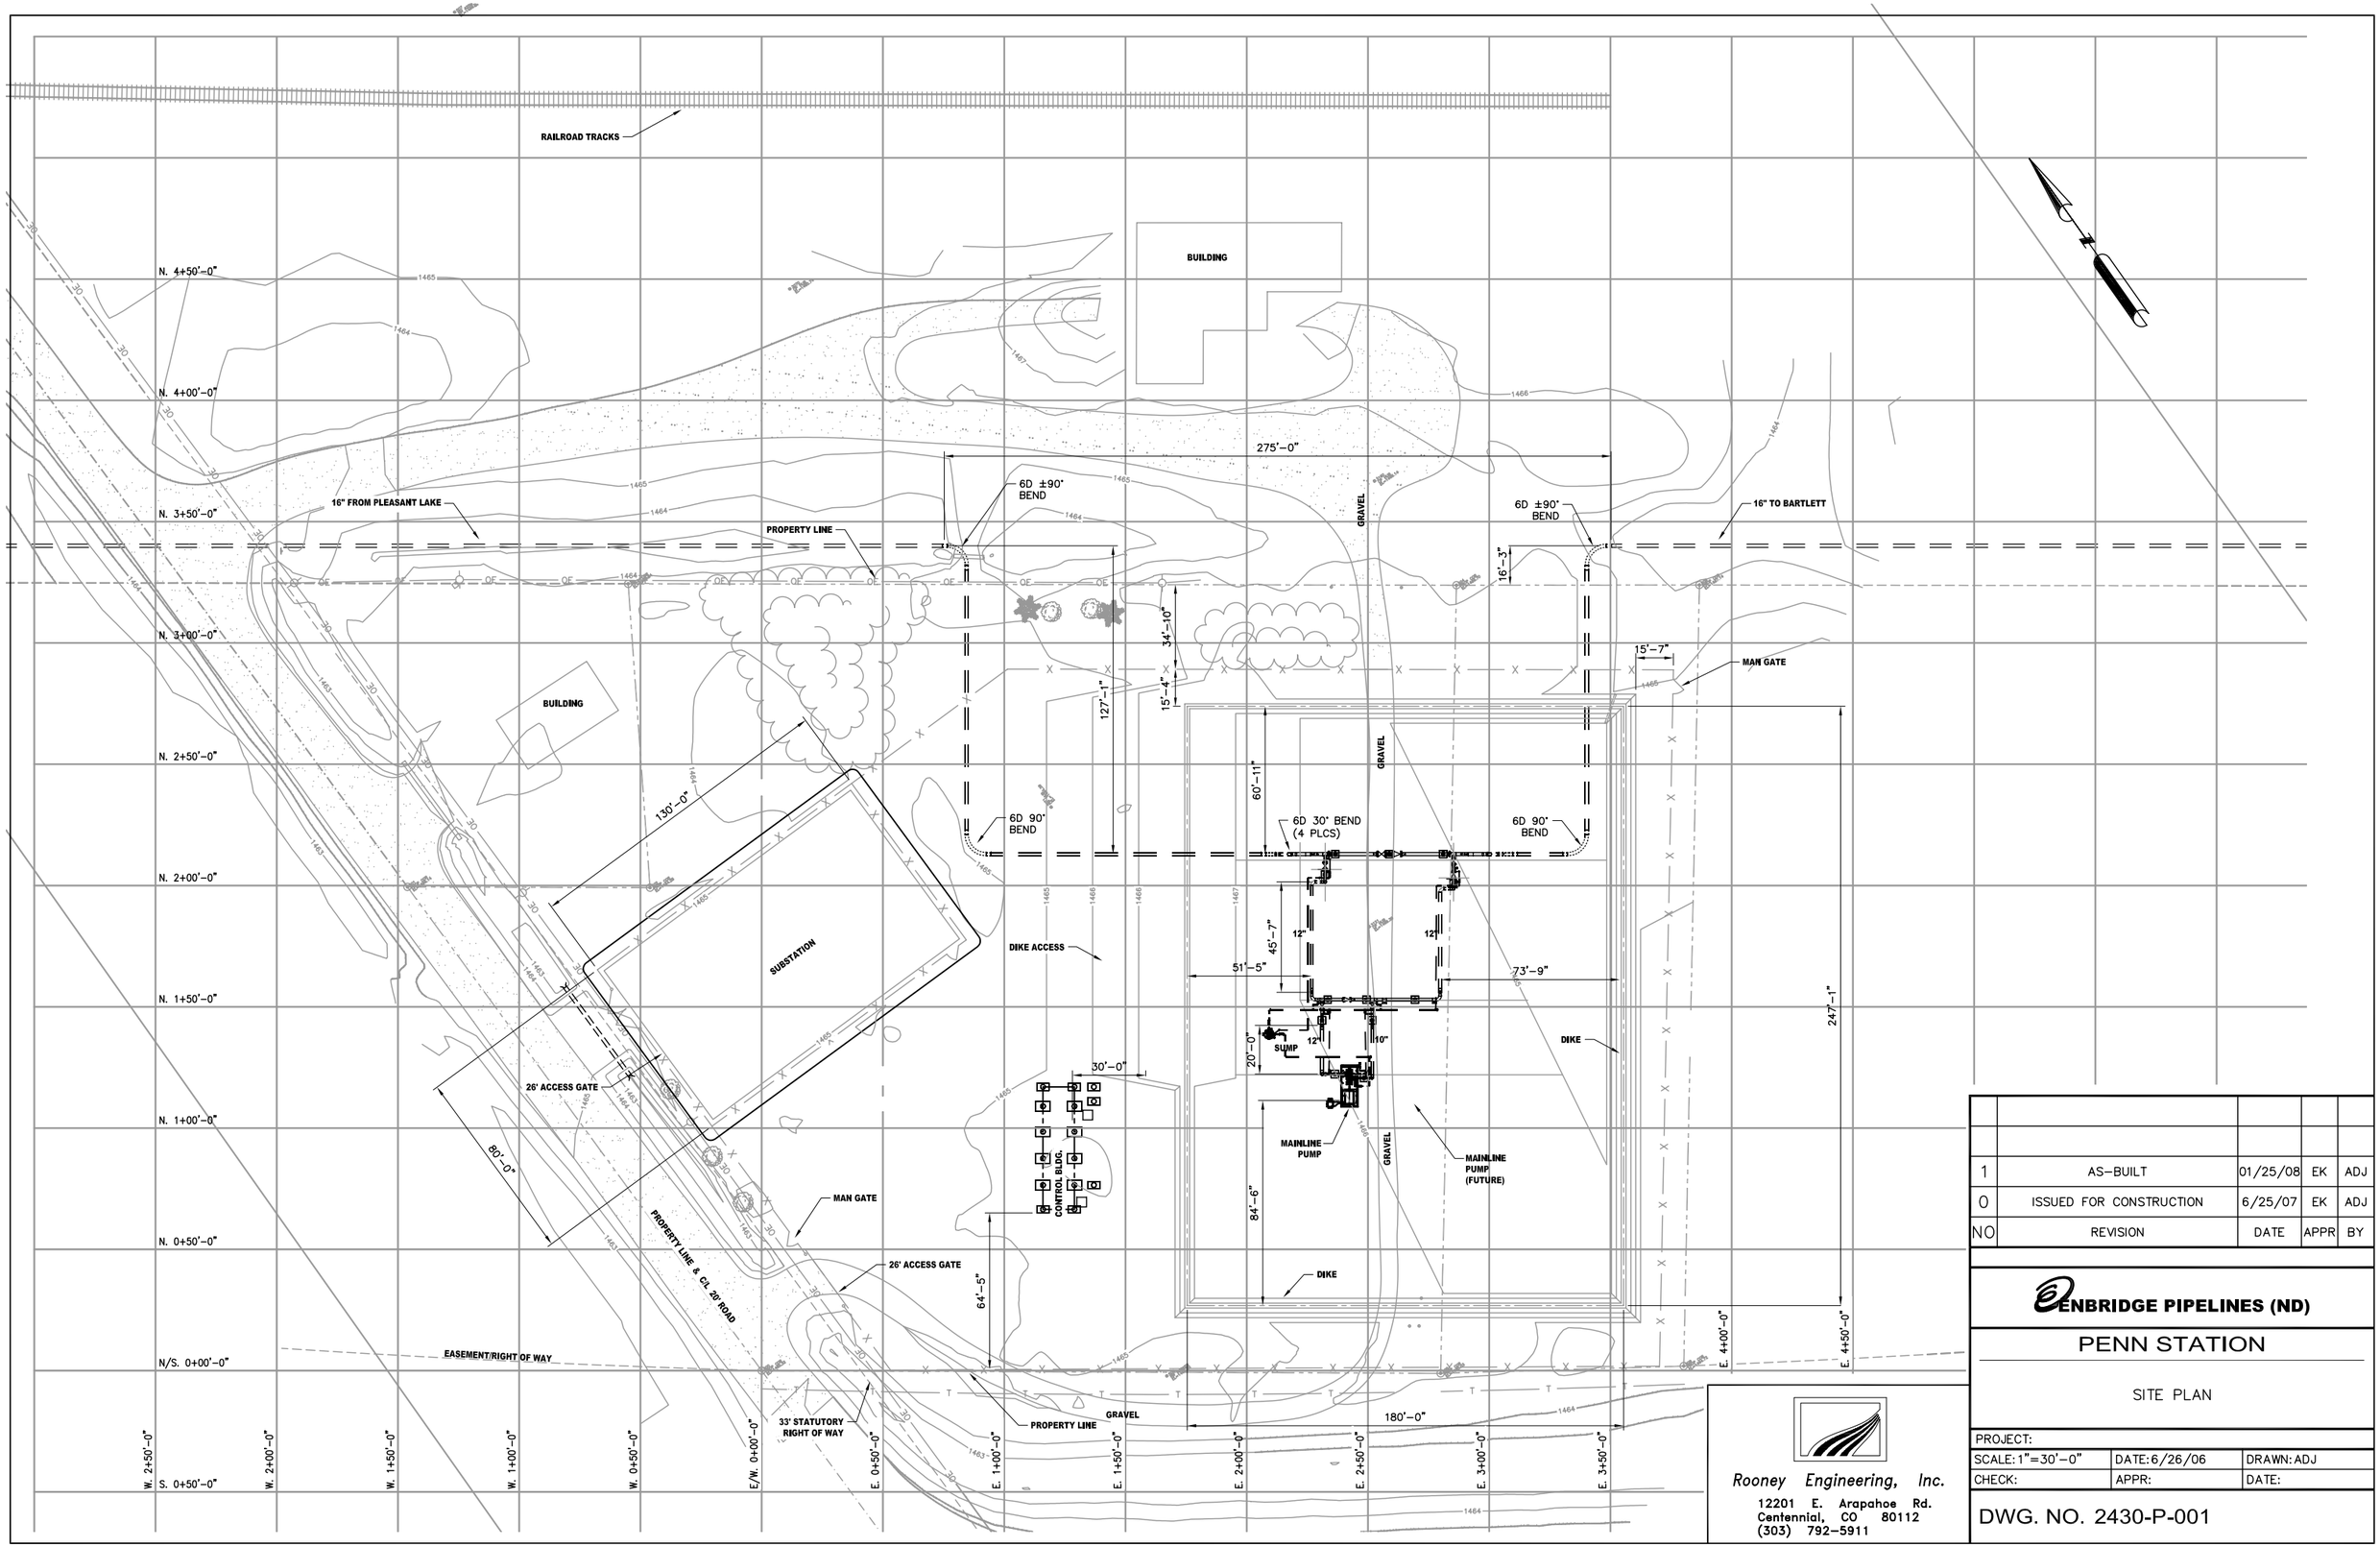

NO	REVISION	DATE	APPR	BY
1	AS-BUILT	01/25/08	EK	ADJ
0	ISSUED FOR CONSTRUCTION	6/25/07	EK	ADJ

ENBRIDGE PIPELINES (ND)

PENN STATION

SITE PLAN

PROJECT:

SCALE: 1"=30'-0" | DATE: 6/26/06 | DRAWN: ADJ

CHECK: | APPR: | DATE:

DWG. NO. 2430-P-001

Rooney Engineering, Inc.
12201 E. Arapahoe Rd.
Centennial, CO 80112
(303) 792-5911