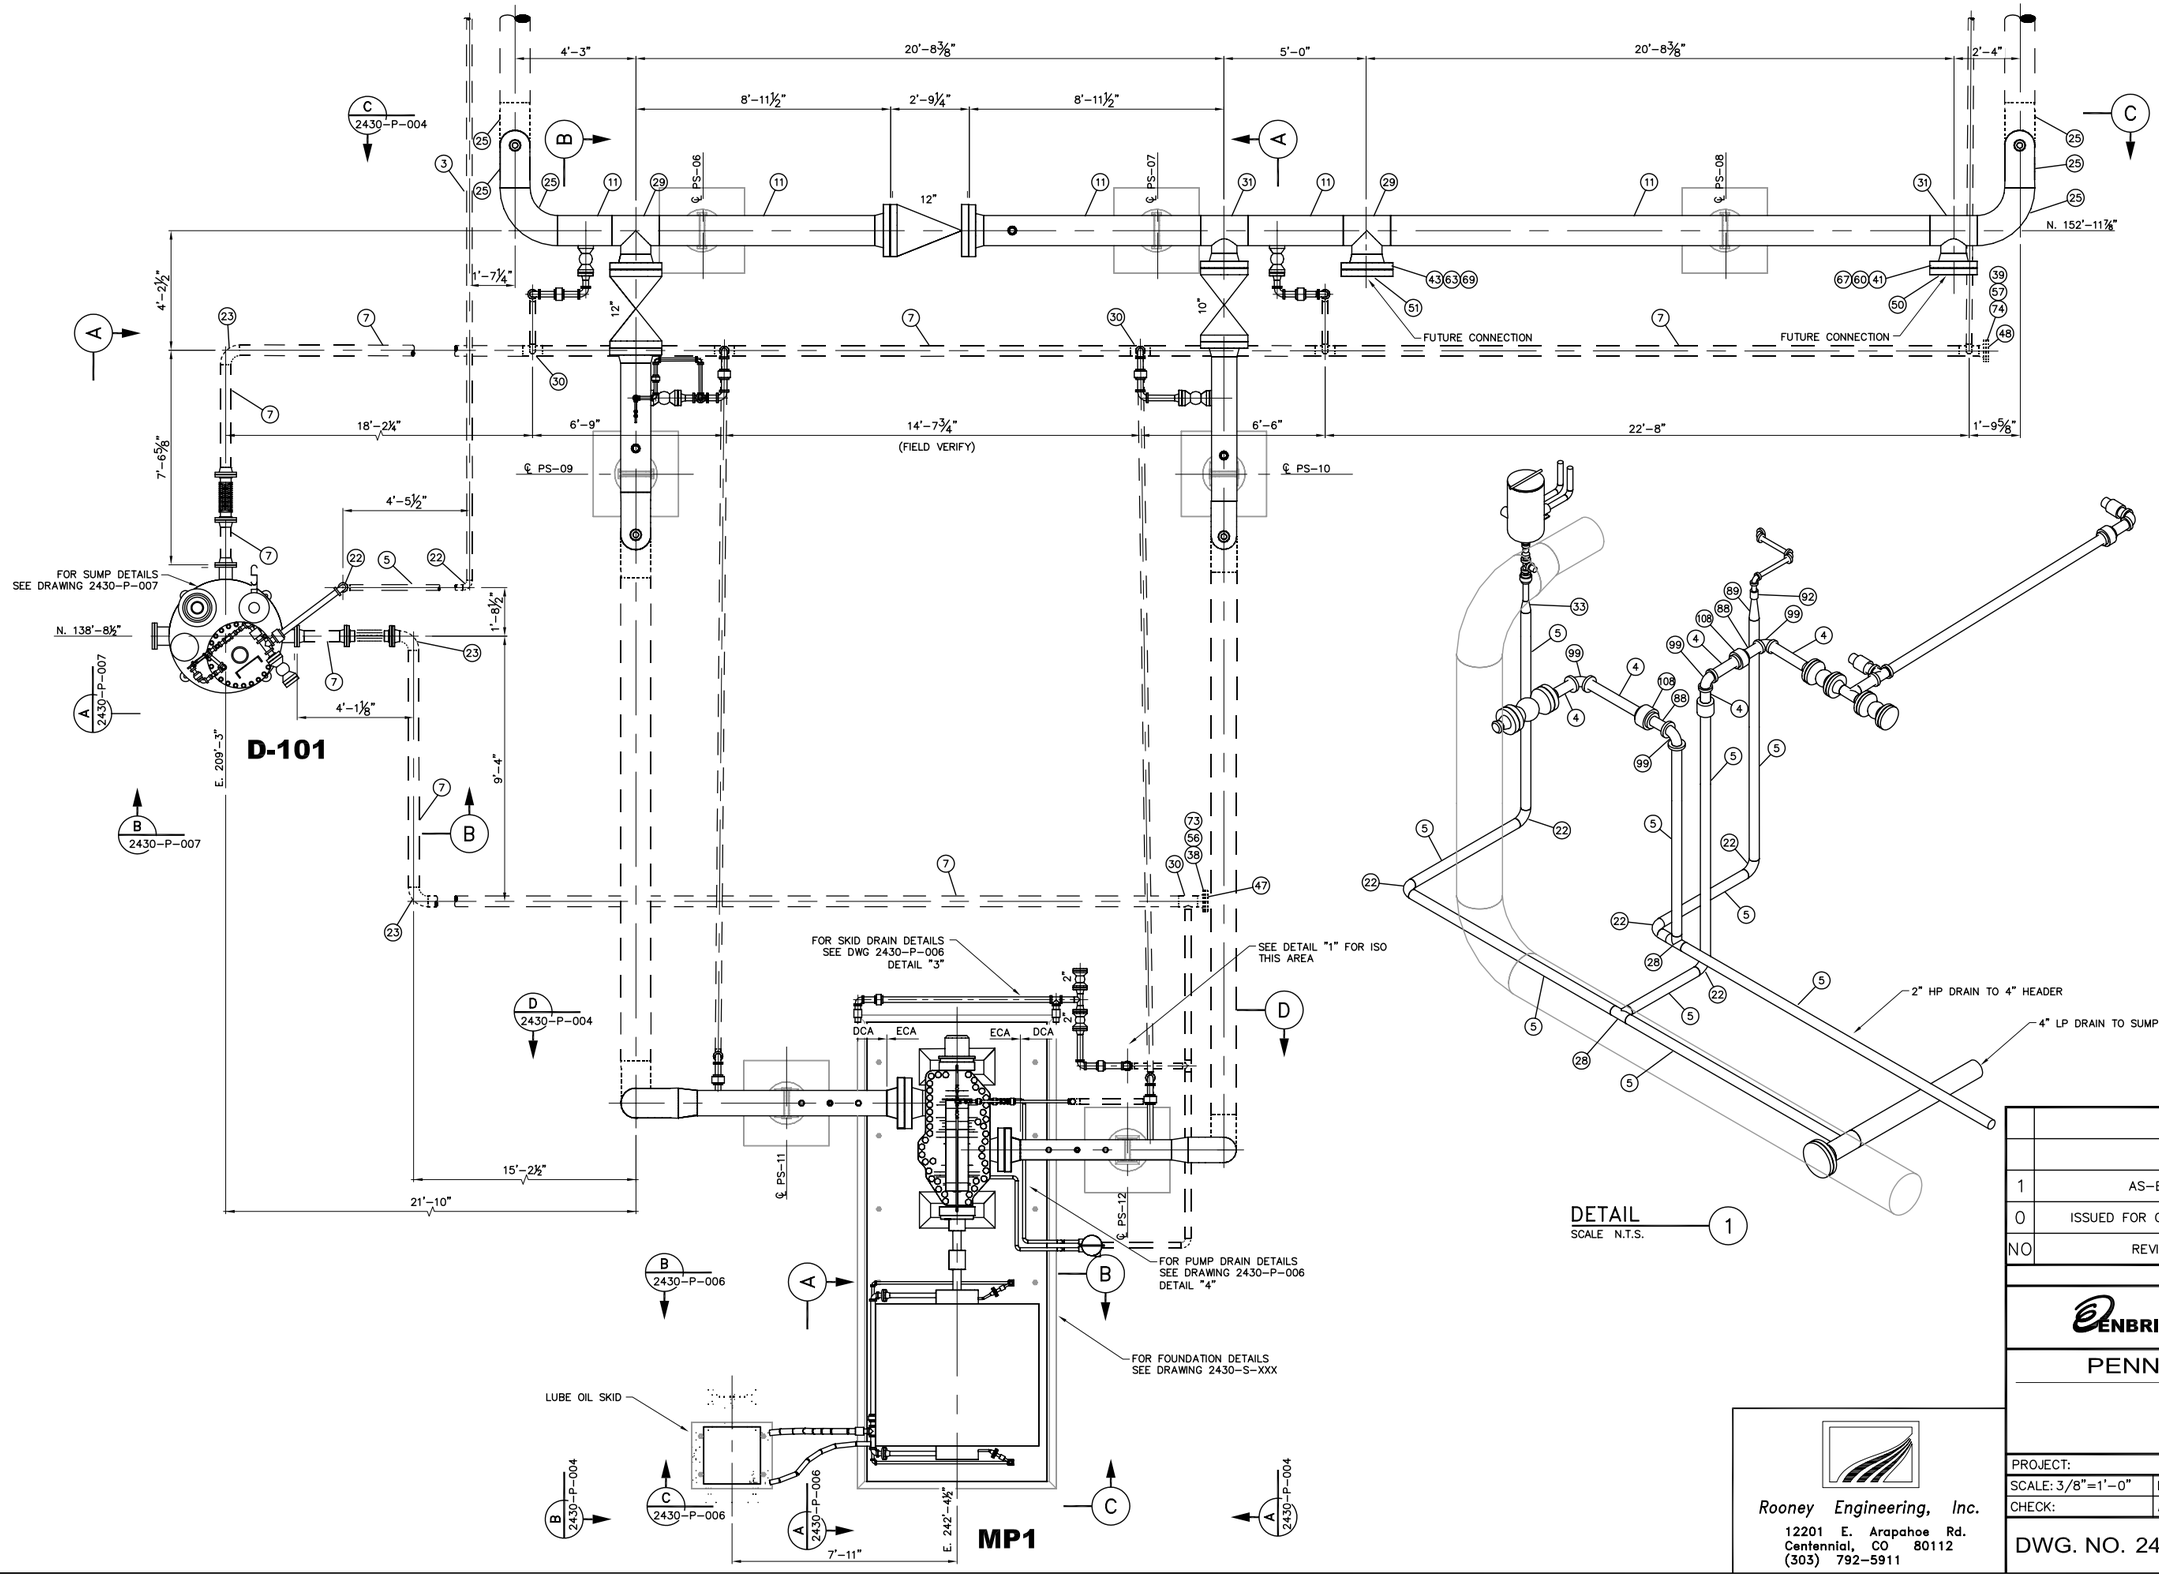


| NO | REVISION | DATE | APPR | BY |
|---|---|---|---|---|
| | | | | |
| | | | | |
| 1 | AS-BUILT | 01/25/08 | EK | ADJ |
| 0 | ISSUED FOR CONSTRUCTION | 6/25/07 | EK | ADJ |

ENBRIDGE PIPELINES (ND)

PENN (ND) STATION

PIPING PLAN

Rooney Engineering, Inc.
12201 E. Arapahoe Rd.
Centennial, CO 80112
(303) 792-5911

| | | |
|---|---|---|
| PROJECT: | | |
| SCALE: 3/8"=1'-0" | DATE: 1/18/07 | DRAWN: ADJ |
| CHECK: | APPR: | DATE: |

DWG. NO. 2430-P-003