


SECTION
SCALE 1/2"=1'-0" (A)

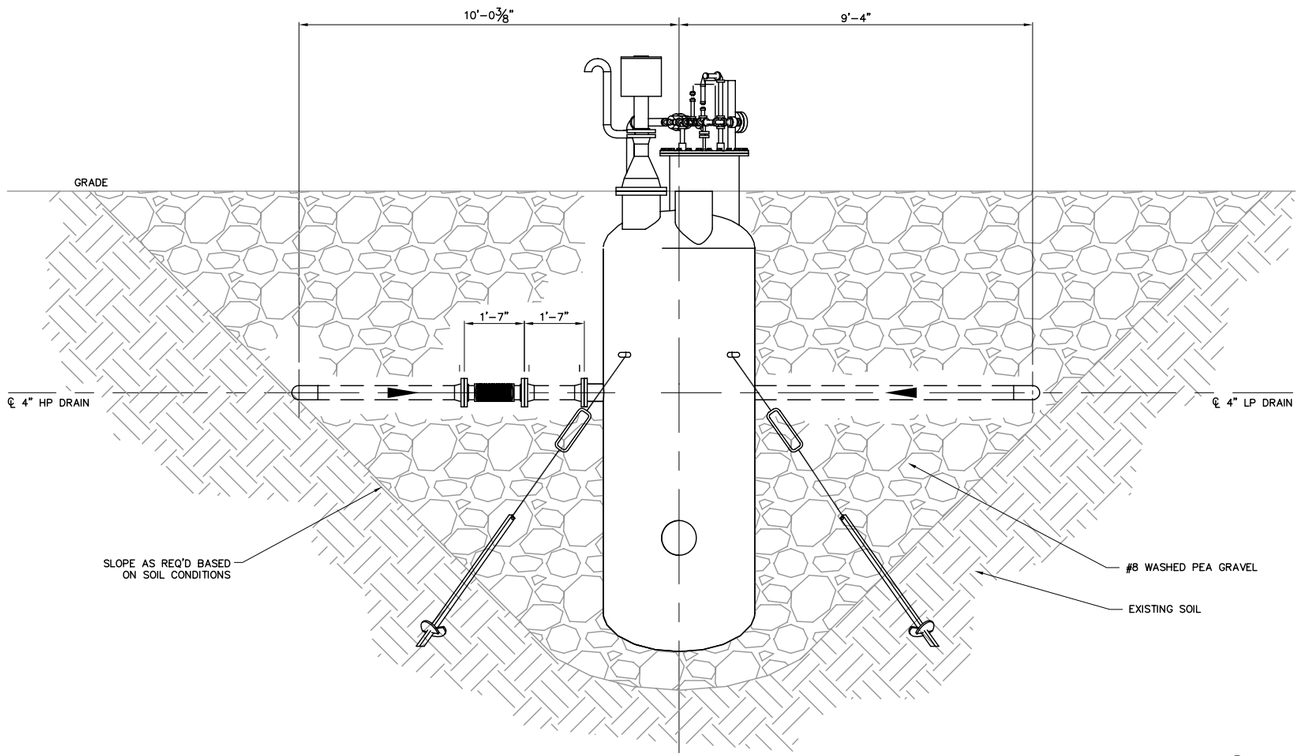


SECTION
SCALE 1/2"=1'-0" (B)




PLAN
SCALE 1/2"=1'-0"

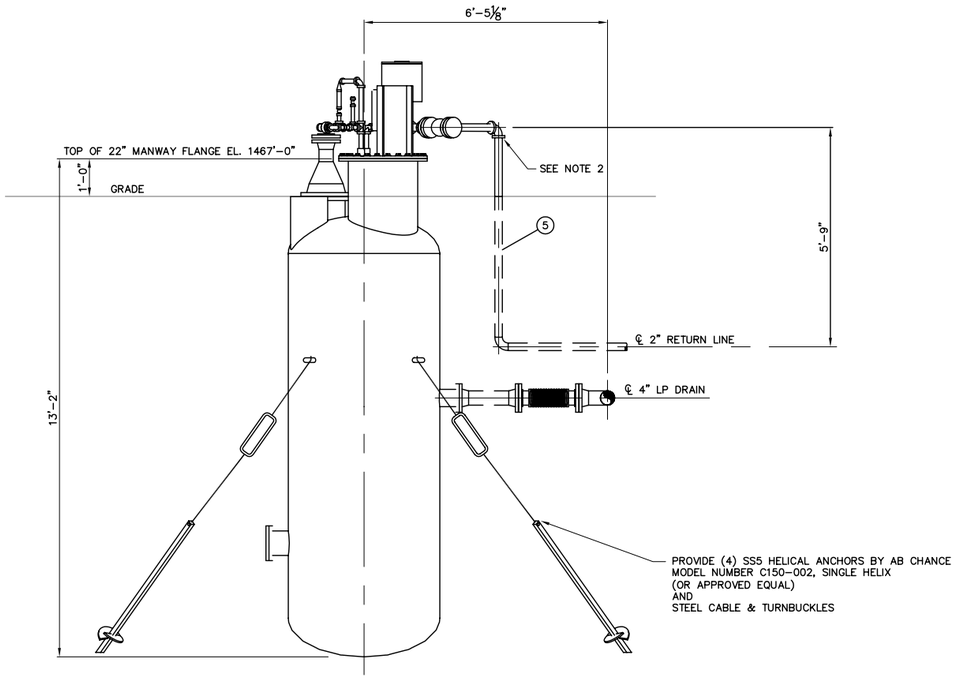


ISO
SCALE N.T.S.

NOTES:
1. MIN. TURNBUCKLE DIA AS FOLLOWS:
   HOOK-¾", JAW-½", EYE-½", WIRE ROPE-⅜" W/2 CLIPS.
2. PLEASE VERIFY W/EPND STOCK ANCHORS.
3. BACKFILL W/MIN 12" ND DOT CLASS 43 GRAVEL AROUND ENTIRE TANK. USE A NON METAL PROBE TO WORK BACKFILL MATERIAL UNDER THE TANK BODY DOME SO THE TANK IS FULLY SUPPORTED SO THAT THERE ARE NO VOIDS UNDER THE TANK.
4. CONTRACTOR TO THREAD PIPE WHERE TRANSITIONS REQ'D.
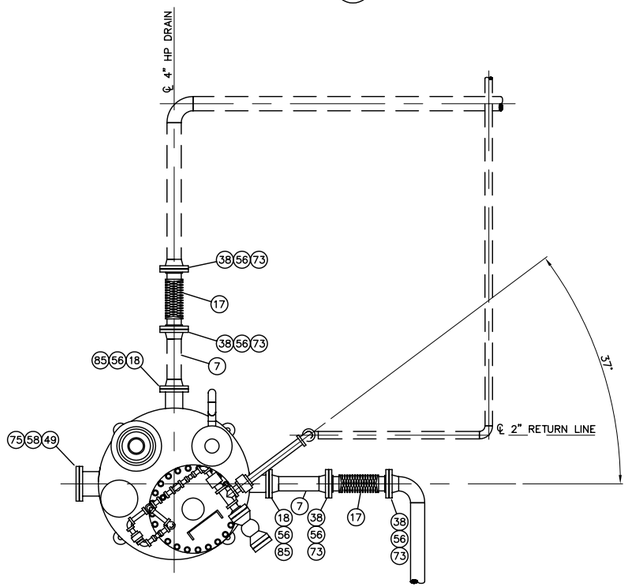
| NO | REVISION | DATE | APPR | BY |
|---|---|---|---|---|
| | | | | |
| | | | | |
| 1 | AS-BUILT | 01/25/08 | EK | ADJ |
| 0 | ISSUED FOR CONSTRUCTION | 6/25/07 | EK | ADJ |

ENBRIDGE PIPELINES (ND)
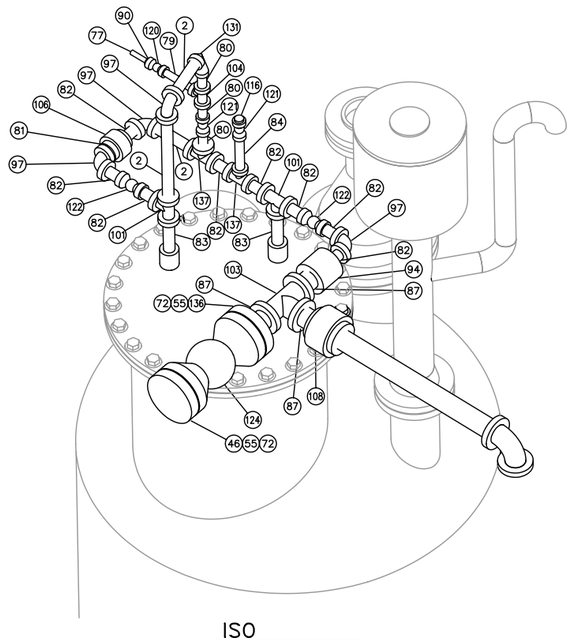
# PENN (ND) STATION

SUMP INSTALLATION
DETAILS AND SECTIONS

| | | |
|---|---|---|
| PROJECT: 02430 | | |
| SCALE: AS NOTED | DATE: 1/18/07 | DRAWN: ADJ |
| CHECK: | APPR: | DATE: |

DWG. NO. 2430-P-007


Rooney Engineering, Inc.
12201 E. Arapahoe Rd.
Centennial, CO 80112
(303) 792-5911