



Bures Route Variation

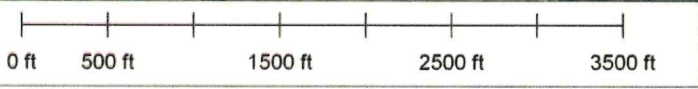

Red Line: Proposed Keystone CL [July 11, 2007] Blue Line: Proposed Keystone CL [September 7, 2006] Yellow Line: Proposed Re-Route

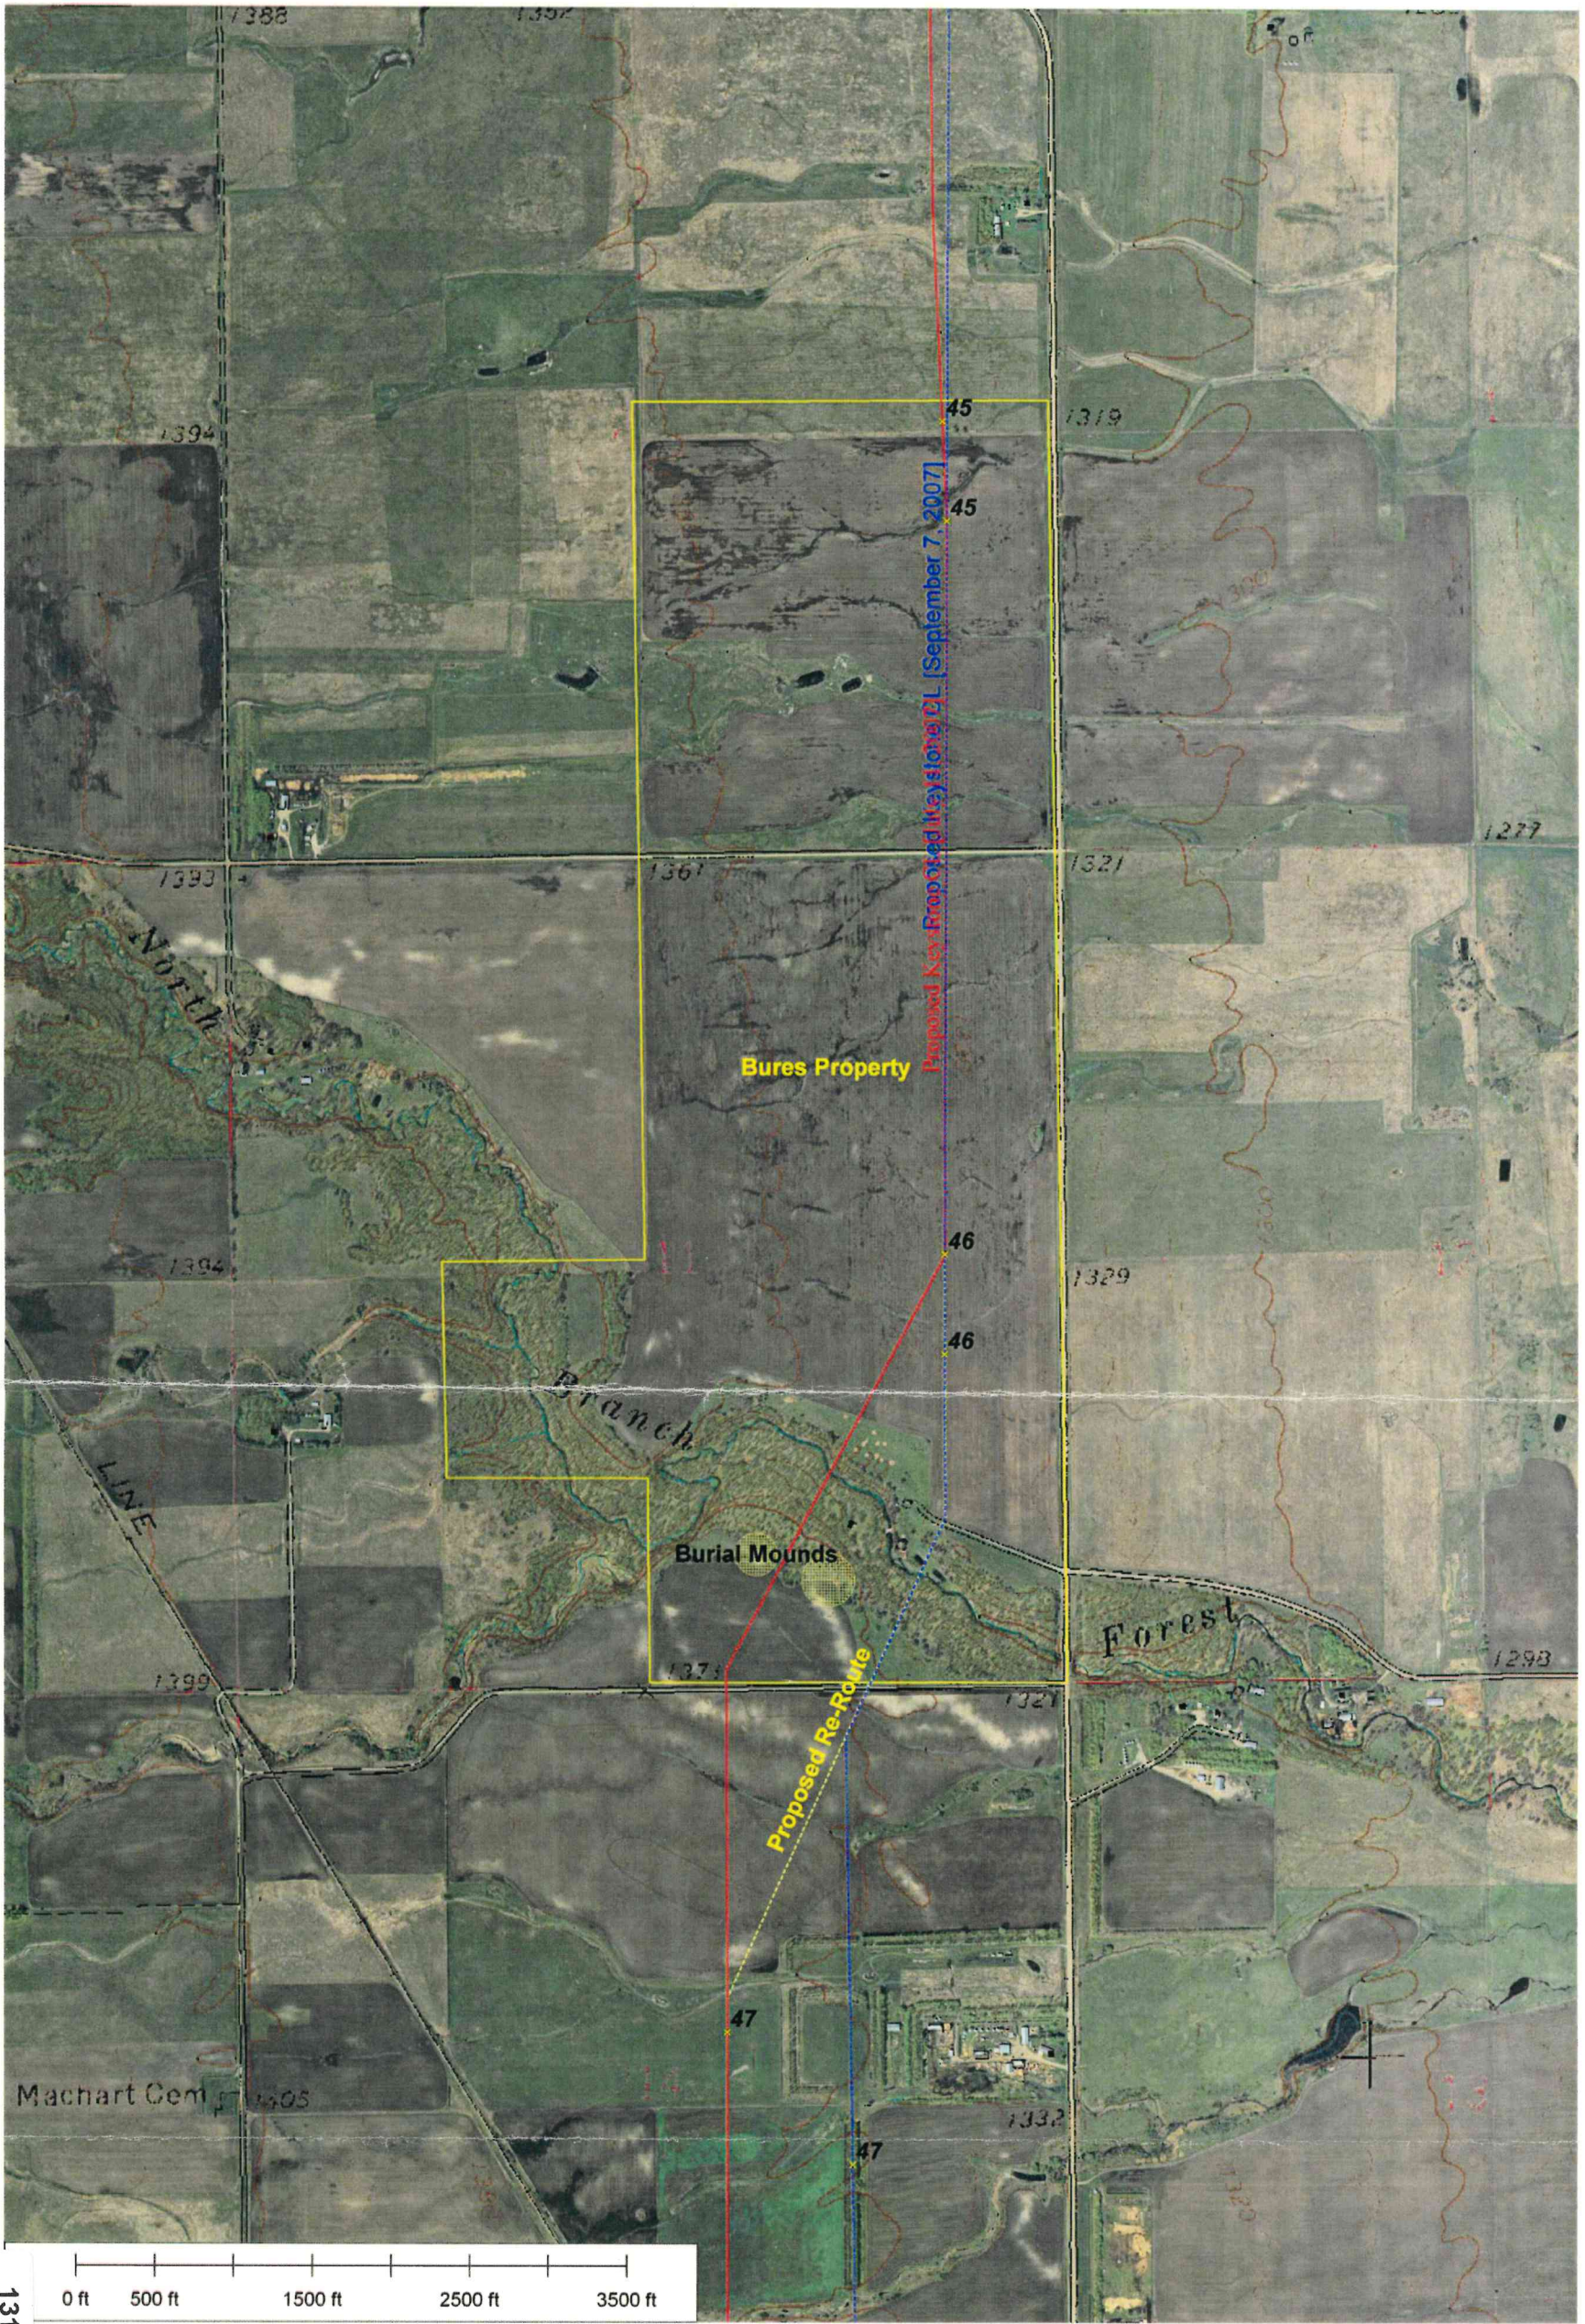