




Exhibit A – Belanus Route Deviation



JAMES BELANUS - TERESA BELANUS

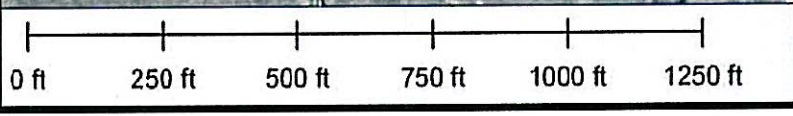

 TransCanada <i>In business to deliver</i>	TROW ENGINEERING CONSULTANTS INC. 1300 Metropolitan Blvd. Suite 200 Tallahassee, Florida 32308 Phone: 1-850-385-5441 Fax: 1-850-385-5523		
	TROW PROJ. No.: THES0050388S DRAWN BY: TB CHECKED BY: SS DATE: APRIL 28, 2008	KEYSTONE PIPELINE PROJECT ROUTE VARIATION: 354-ND-4.6-S.1-S	
	DRAWING No.: ND-354-1	REV. 0	